




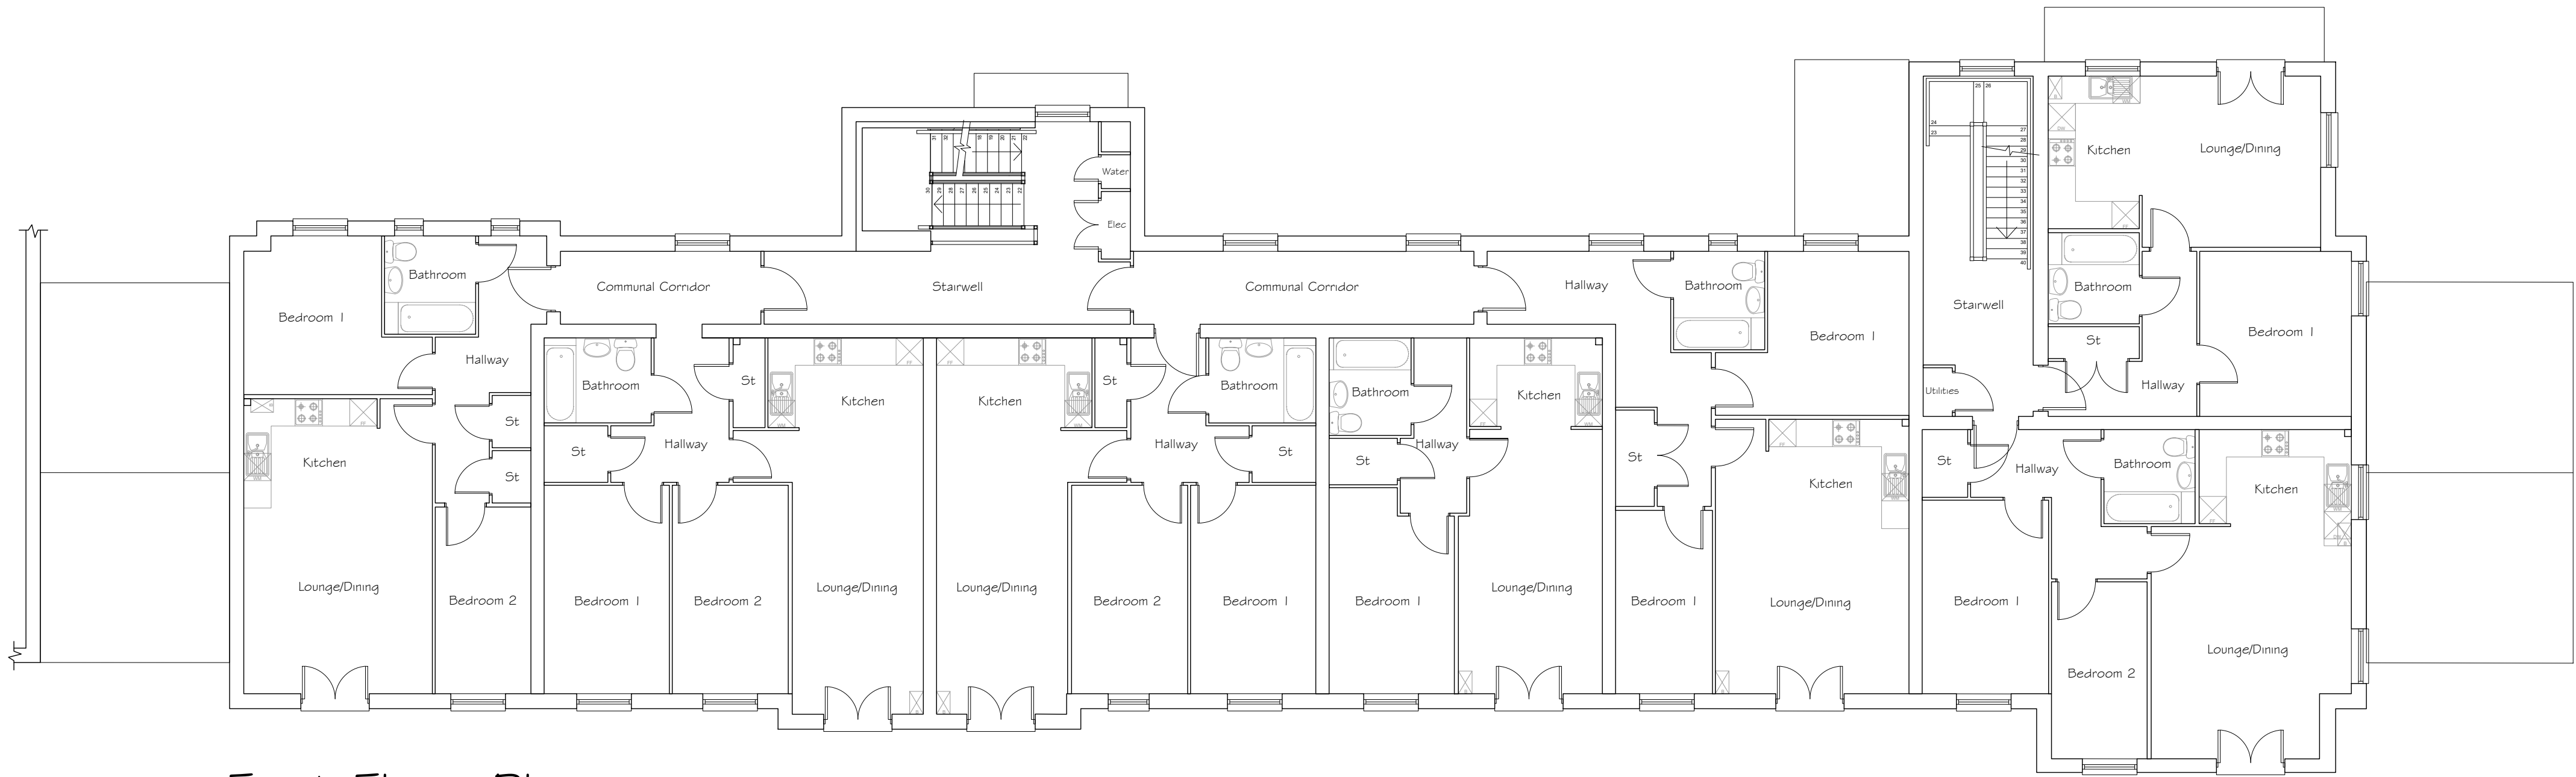

First Floor Plan

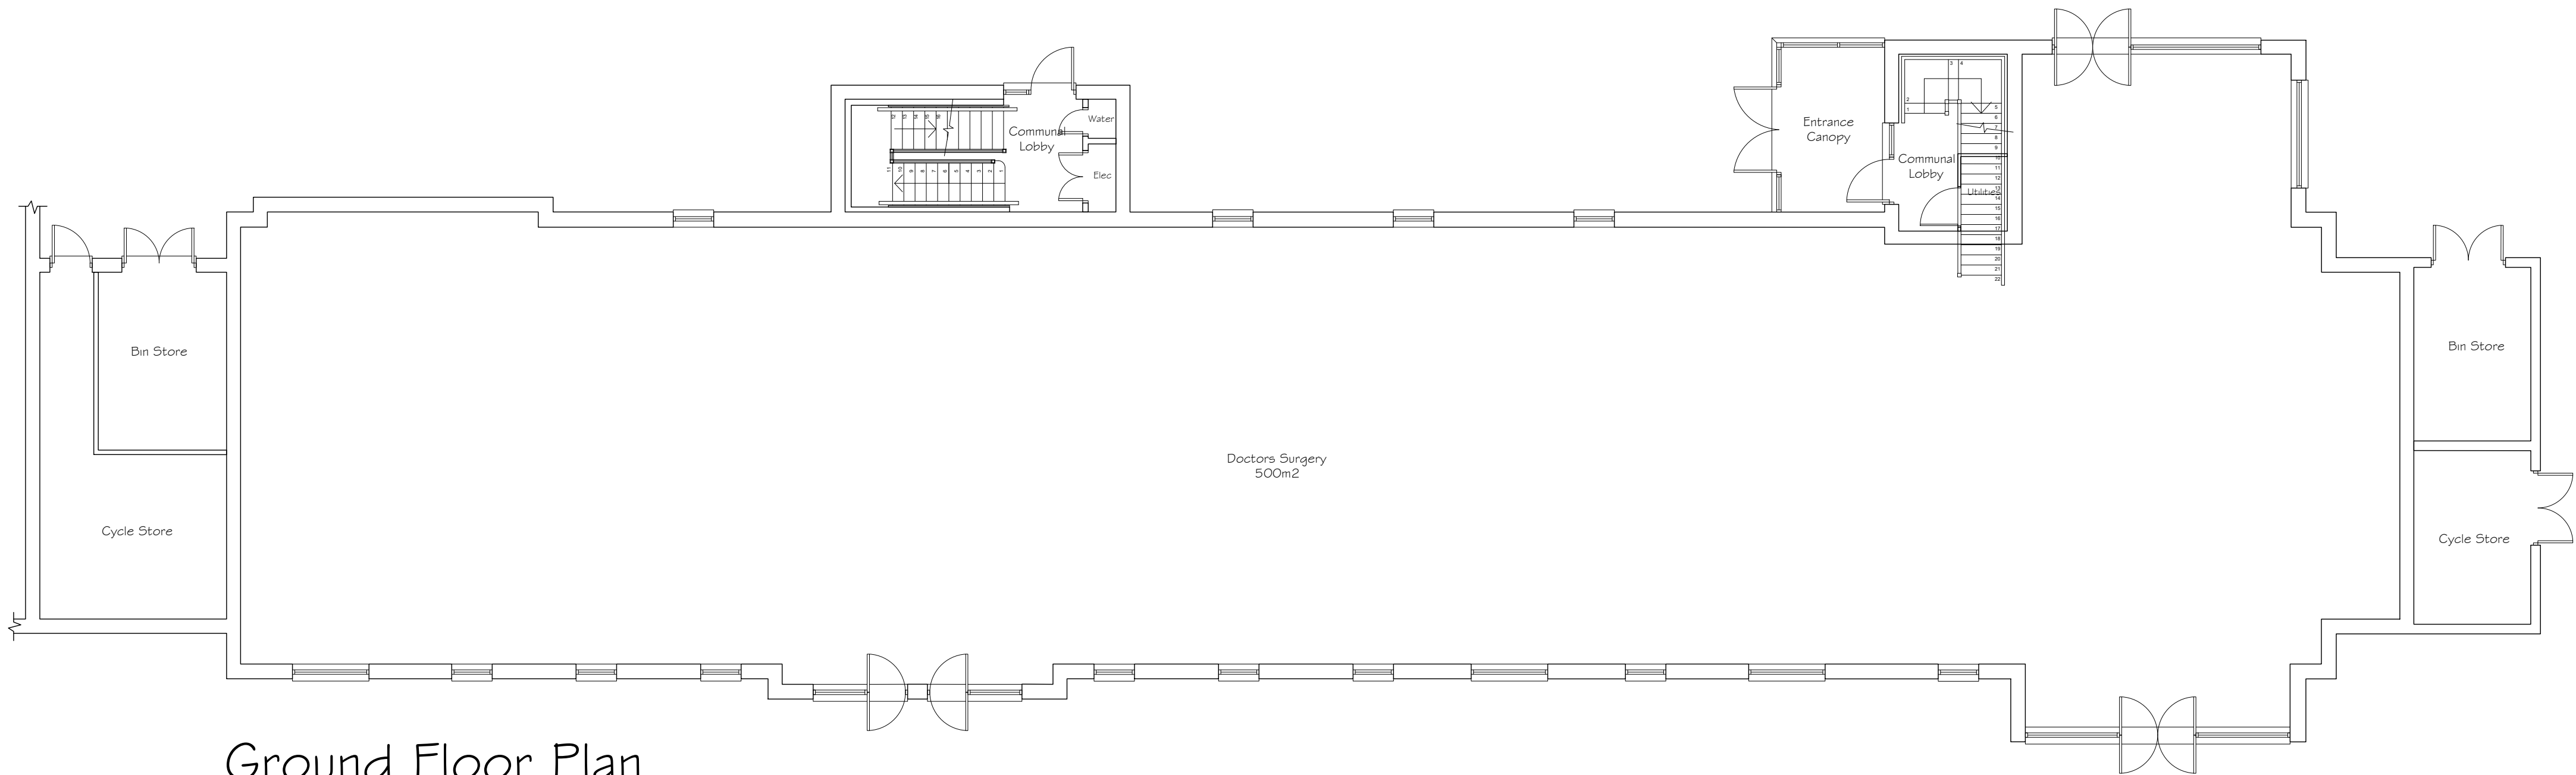

Ground Floor Plan
As Built

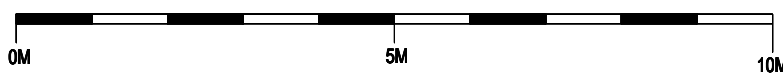

A Scale bar added.		27.05.21	AR
REVISIONS		DATE	BY
DRAWN	CHECKED	DATE	SCALE
AR	-	MAR'21	1:100@A1L
DWG NO.	149.120.1		REV
		A	
DRAWING TITLE			
APARTMENT BLOCK C - AS BUILT GROUND & FIRST FLOOR PLANS			
Persimmon Homes Wessex. All rights reserved. This drawing is the copyright of Persimmon Homes Developments Ltd. and has been produced for planning proposes only. Such drawings can be scaled but are not be used for construction or sales documents.			