



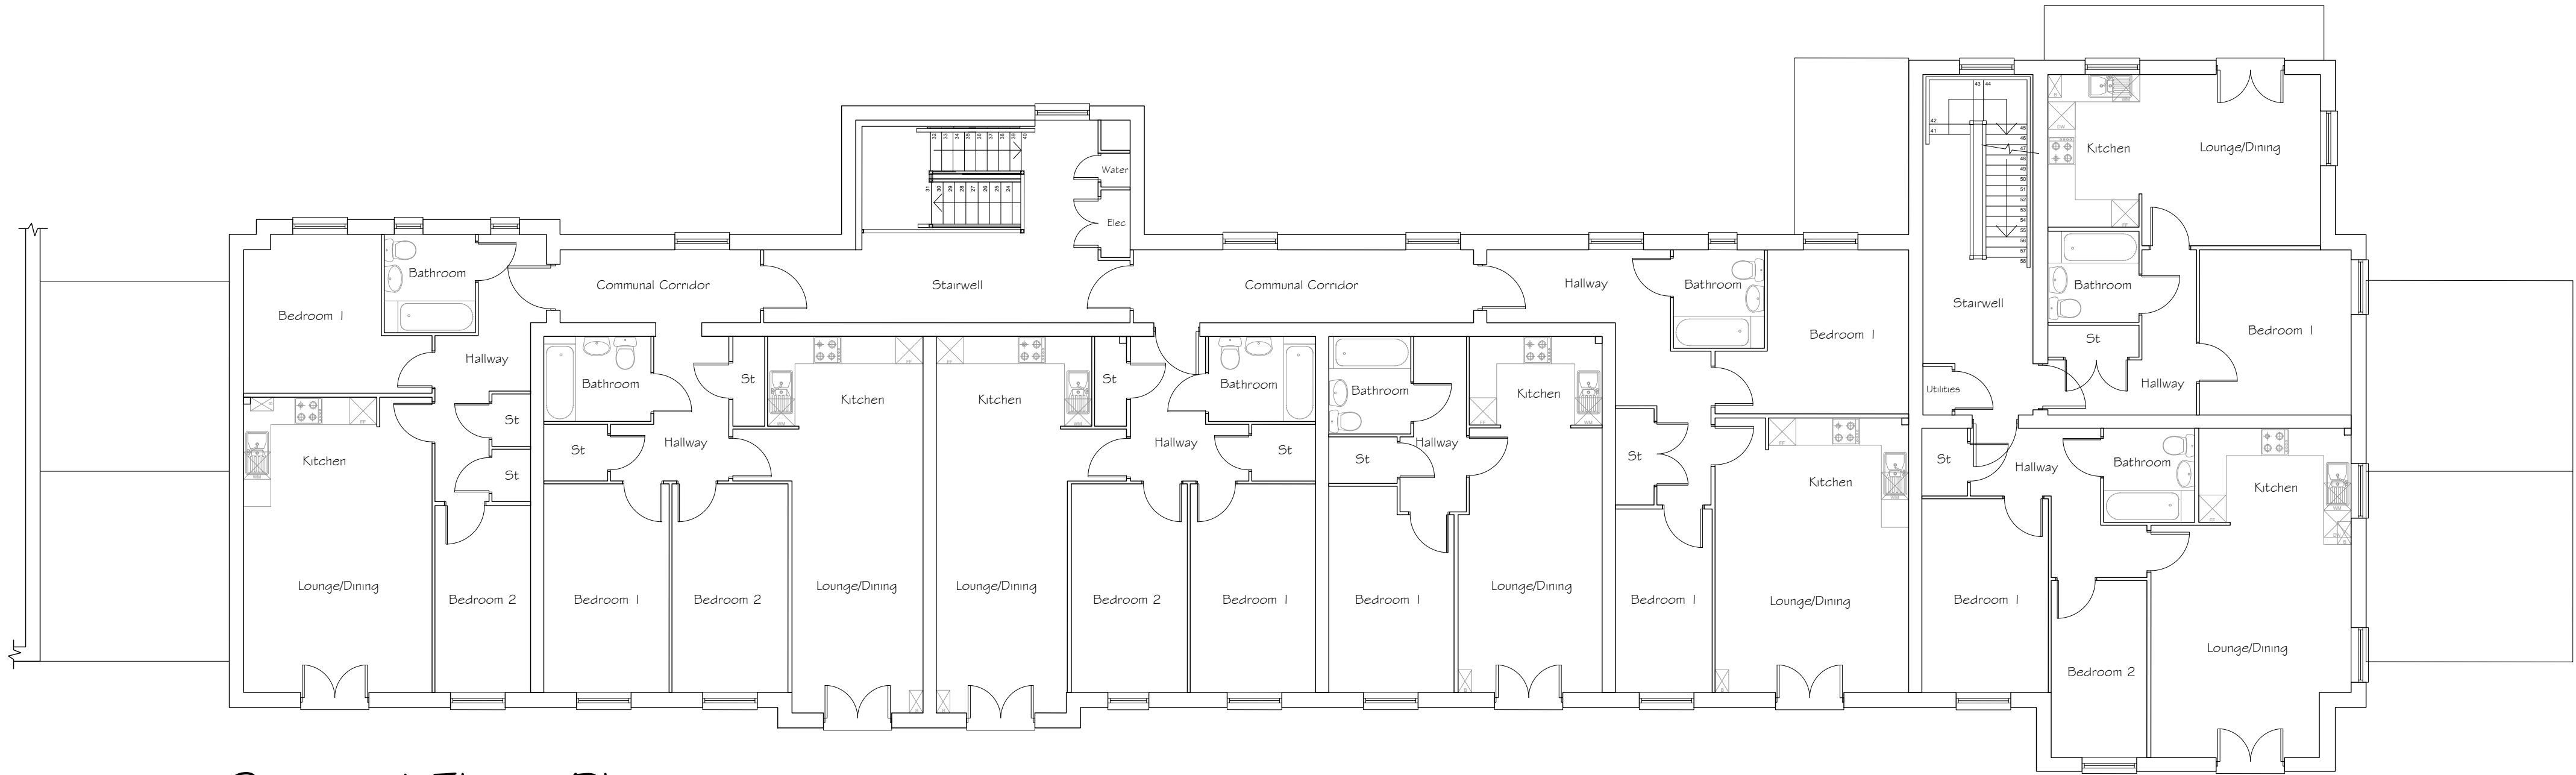

Second Floor Plan

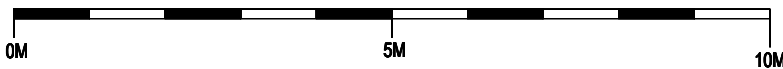

A		Scale bar added.		27.05.21	AR
REVISIONS				DATE	BY
DRAWN	CHECKED	DATE	SCALE		
AR	-	MAR'21	1:100@A1L		
DWG NO.	149.120.2			REV	A
DRAWING TITLE					
APARTMENT BLOCK C - AS BUILT SECOND FLOOR PLANS					
Persimmon Homes Wessex. All rights reserved. This drawing is the copyright of Persimmon Homes Developments Ltd. and has been produced for planning proposes only. Such drawings can be scaled but are not used for construction or sales documents.					