
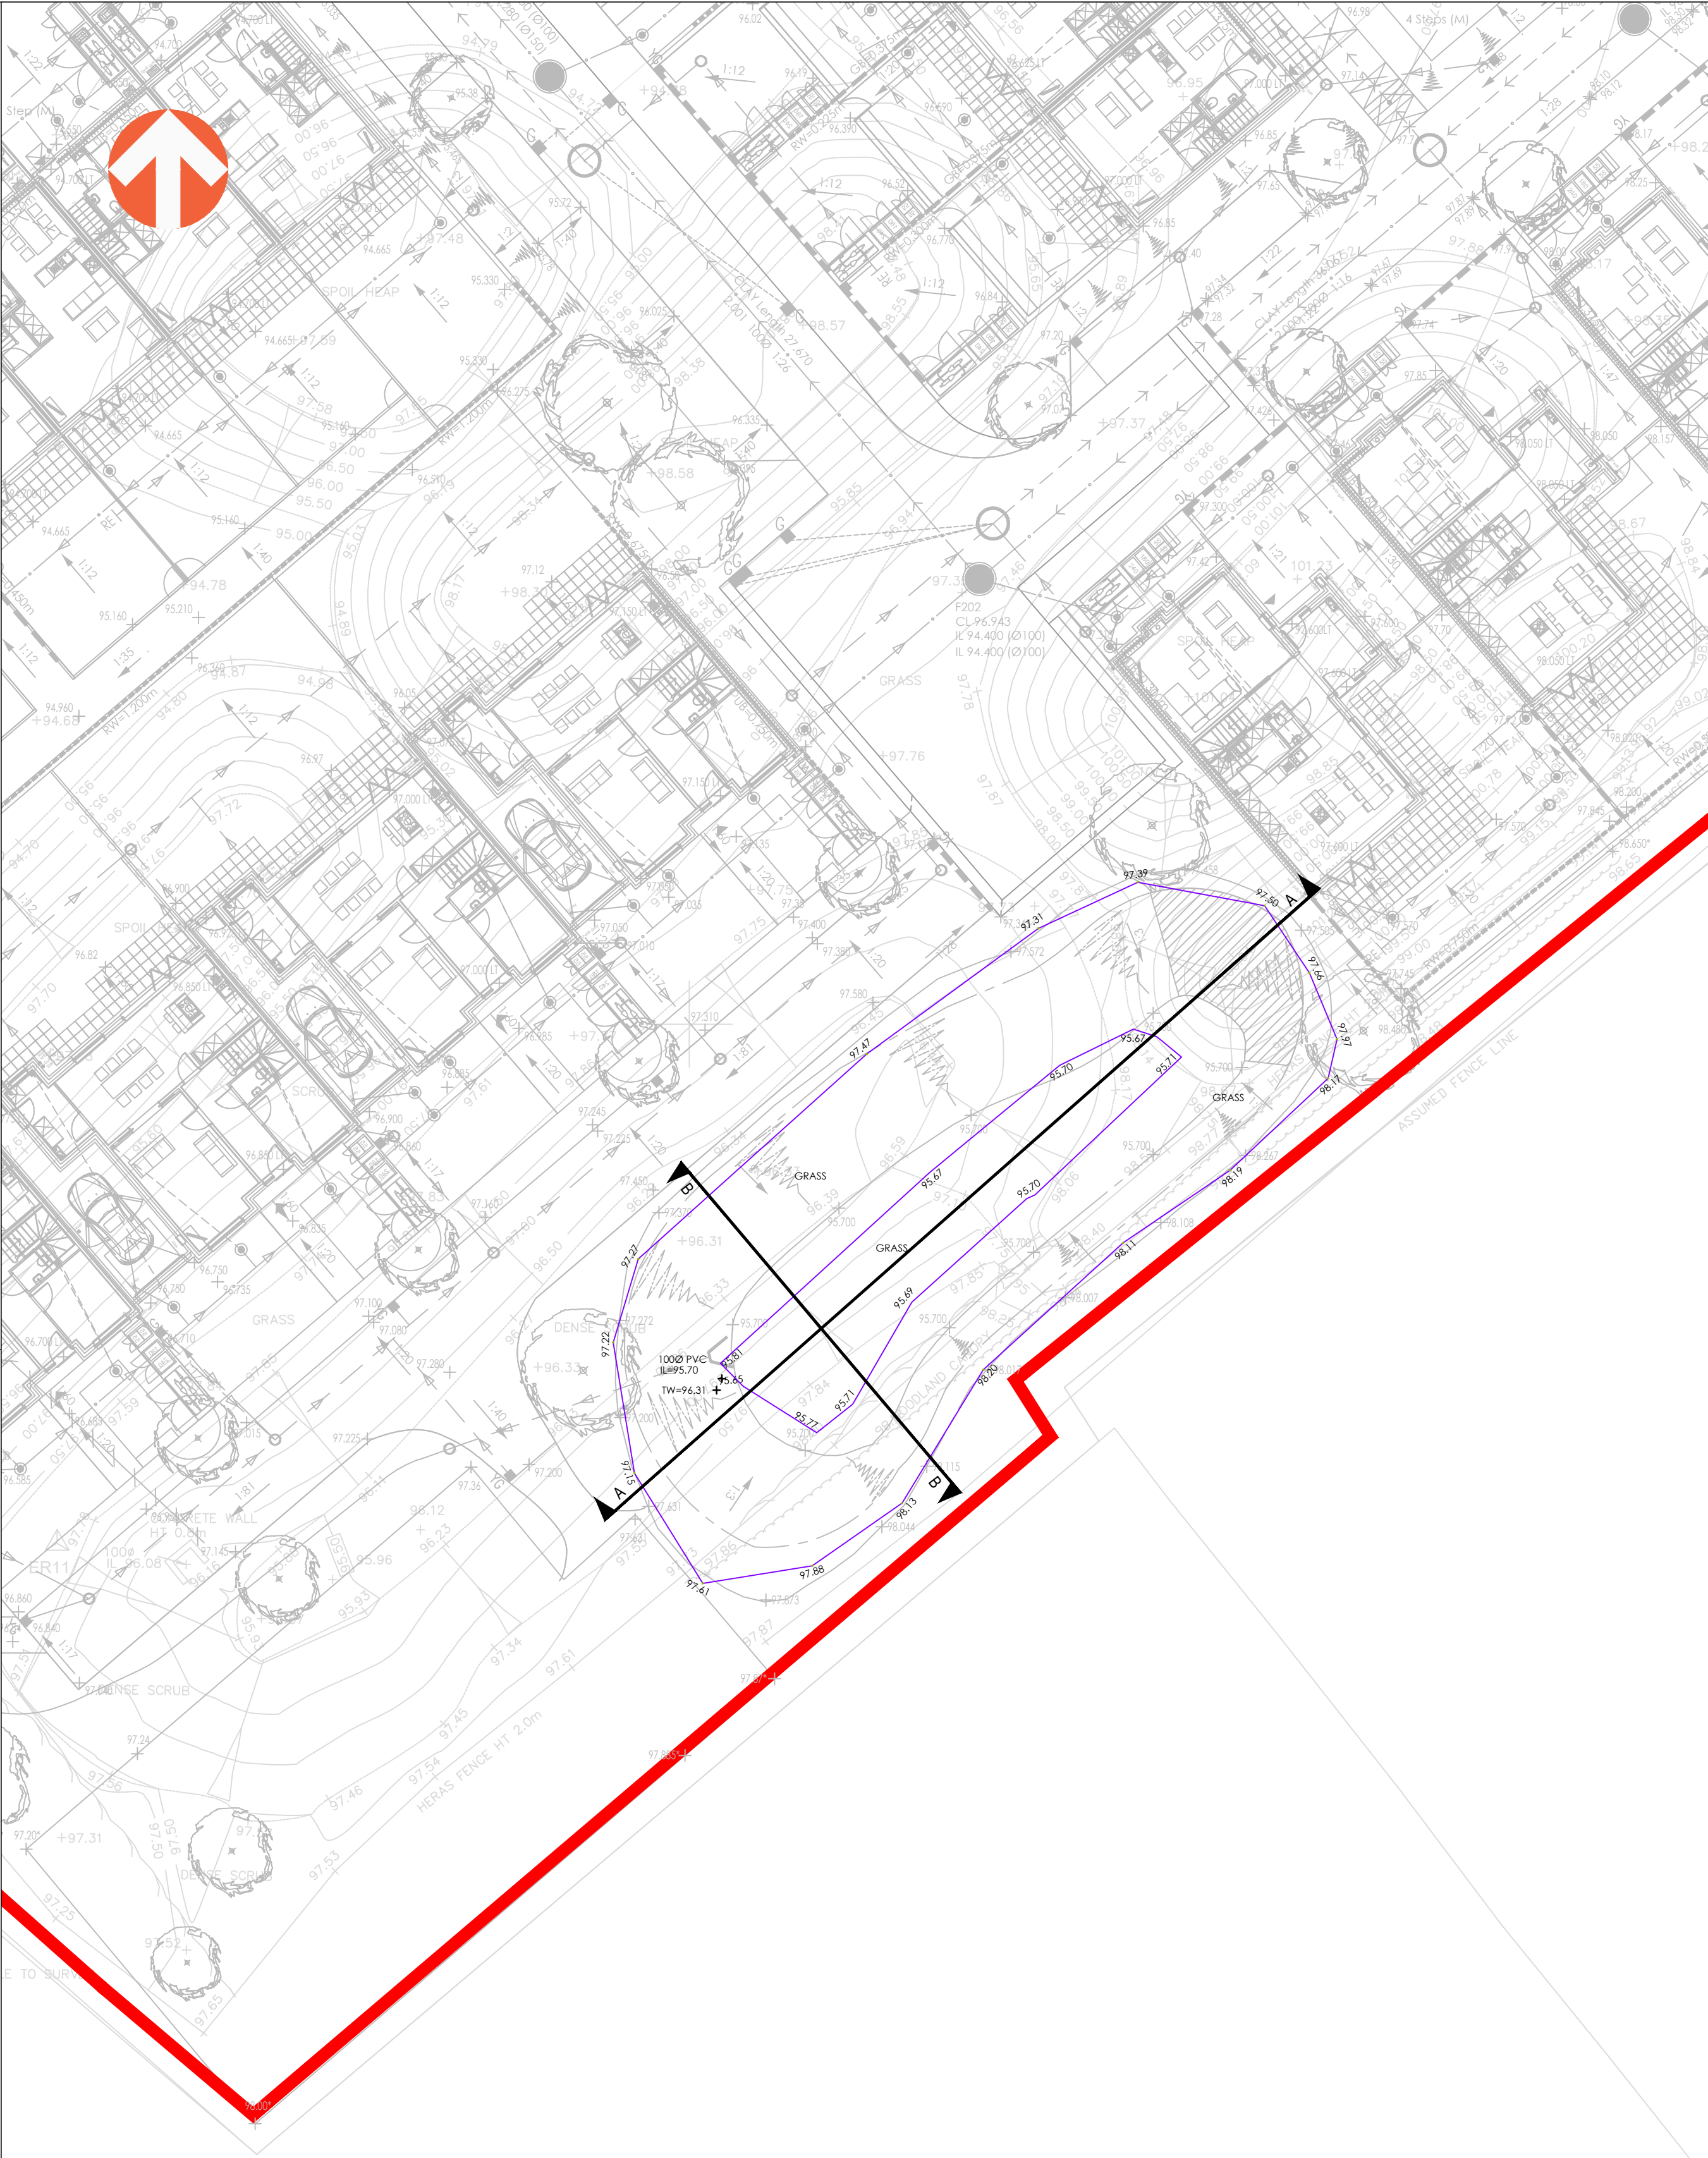
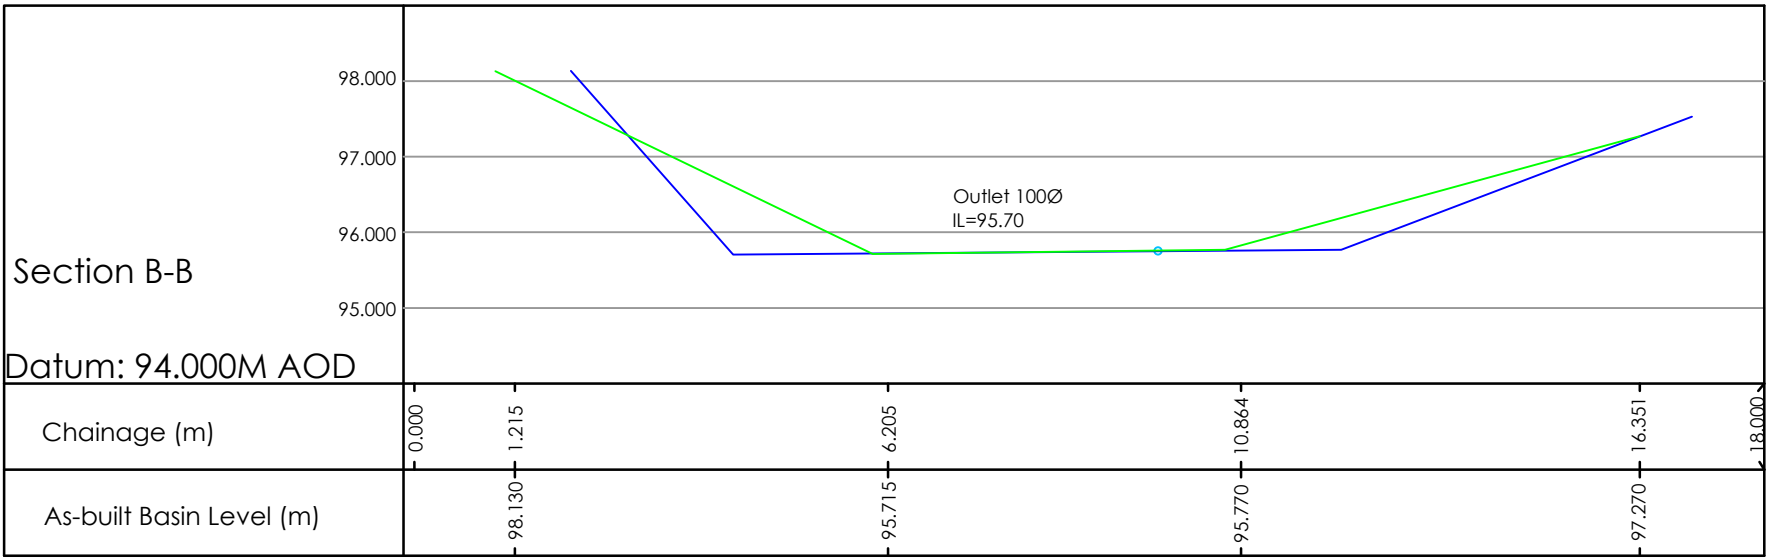


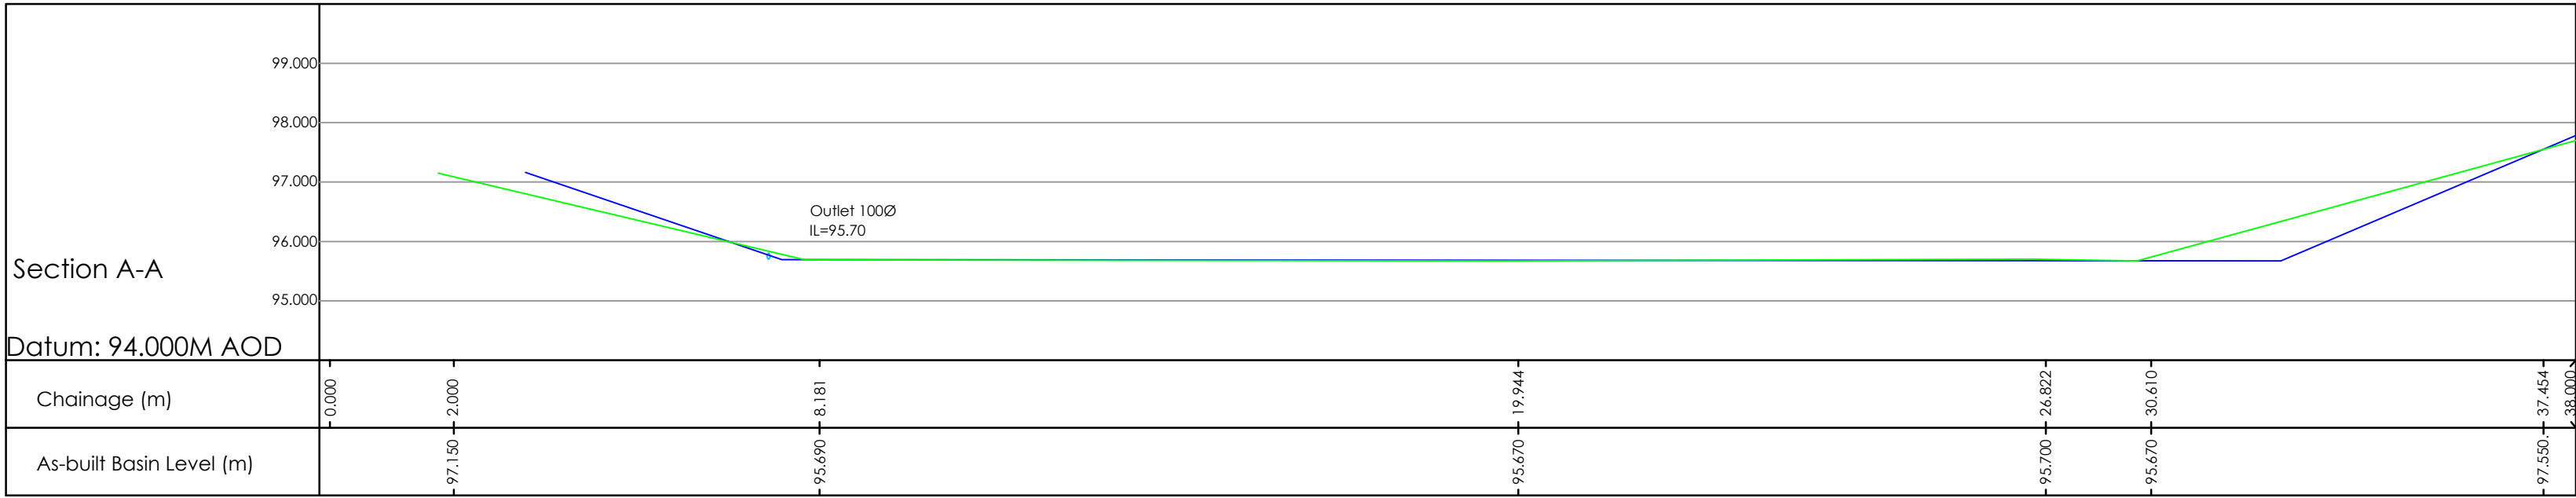

Key

As-built basin level

Proposed basin level

Proposed basin level "taken from as-built Coombs Land Survey Calloway Gardens all ponds"

0 1:100 5 metres

0 1:200 10 metres

PROJECT: WESTBURY HOSPITAL						DESIGN BY: 		
TITLE: BASIN CROSS SECTION PLAN								
CLIENT: BACKHOUSE HOUSING LTD						PROJECT No: 0654	DRAWING No: 03-SK-1101	REV: A
DRAWING STATUS: FOR INFORMATION ONLY						SCALE @ A1: AS SHOWN		

Awcock Ward Partnership, Ada House, Pynes Hill, Exeter, EX2 5TU
Tel: 01392 409007 Web: www.awpexeter.com