


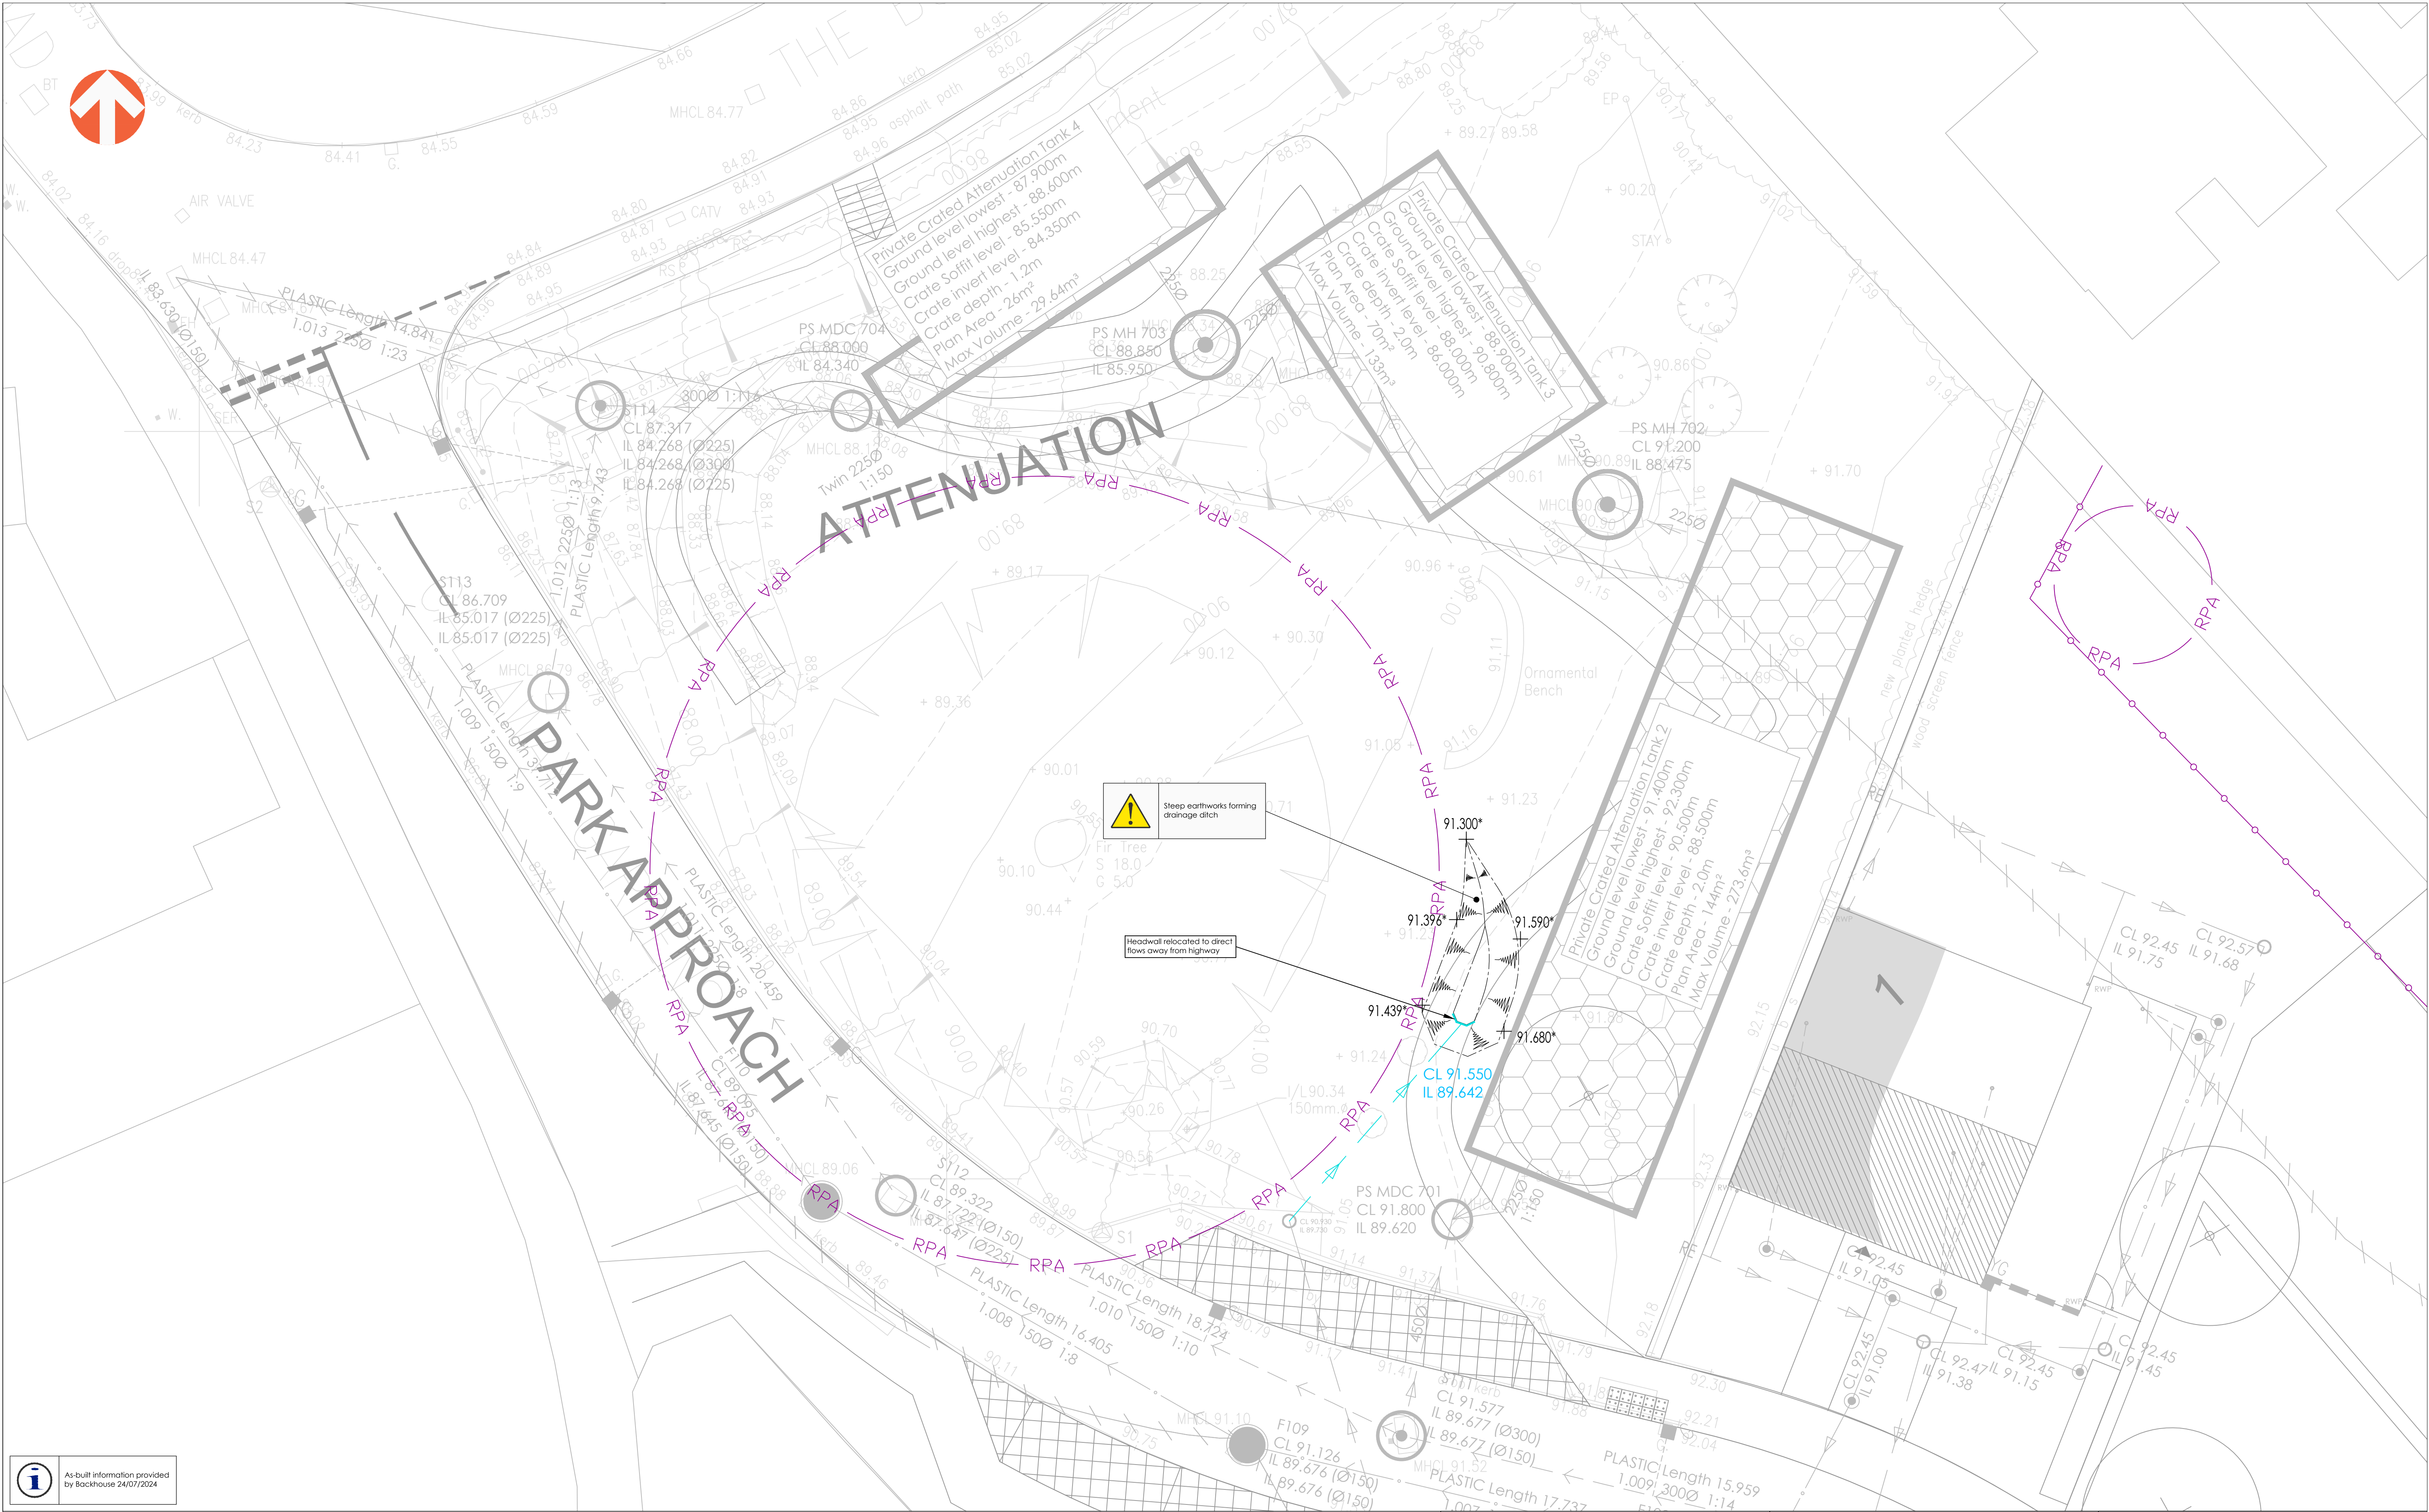

i As-built information provided by Backhouse 24/07/2024

Key
SITE INFORMATION

Site boundary

RPA Root protection area

PRIVATE SURFACE WATER DRAINAGE
(REFER TO PRIVATE DRAINAGE STANDARD DETAILS)

Surface water sewer

Althor headwall

EXTERNAL WORKS

Earthworks slope

A		30.07.2024	INITIAL ISSUE	JSH	JBE	GJM
REV	DATE		DESCRIPTION	BY	CHK	APD
CLIENT:						
BACKHOUSE HOUSING LTD						
DRAWING STATUS:						
ISSUED FOR CONSTRUCTION						

PROJECT: WESTBURY HOSPITAL		
TITLE: HEADWALL RELOCATION PLAN		
PROJECT No: 0654	DRAWING No: SK-301	REV: A
SCALE @ A1: 0 1:100 5 metres		

DESIGN BY:

awcockward partnership

Awcock Ward Partnership, Kensington Court, Woodwater Park, Pynes Hill, Exeter, EX2 5TY
Tel: 01392 409007 Web: www.awpexeter.com