




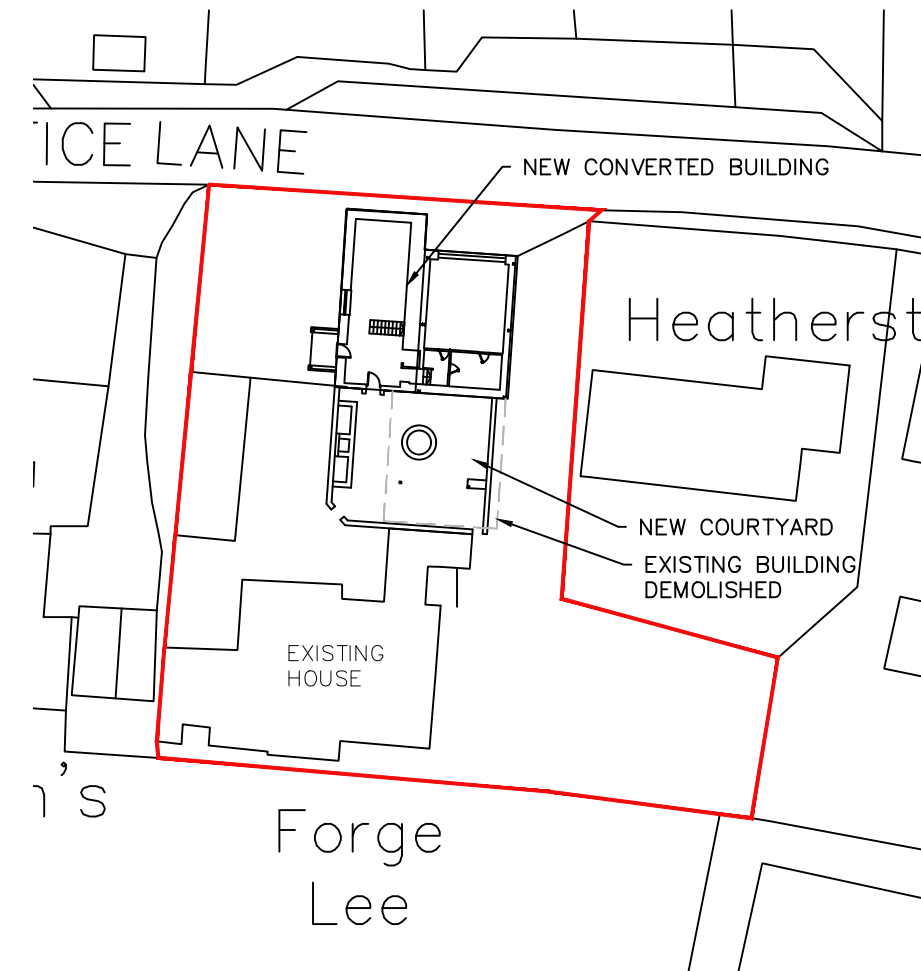

BLOCK PLAN 1-500 (AS BUILT)

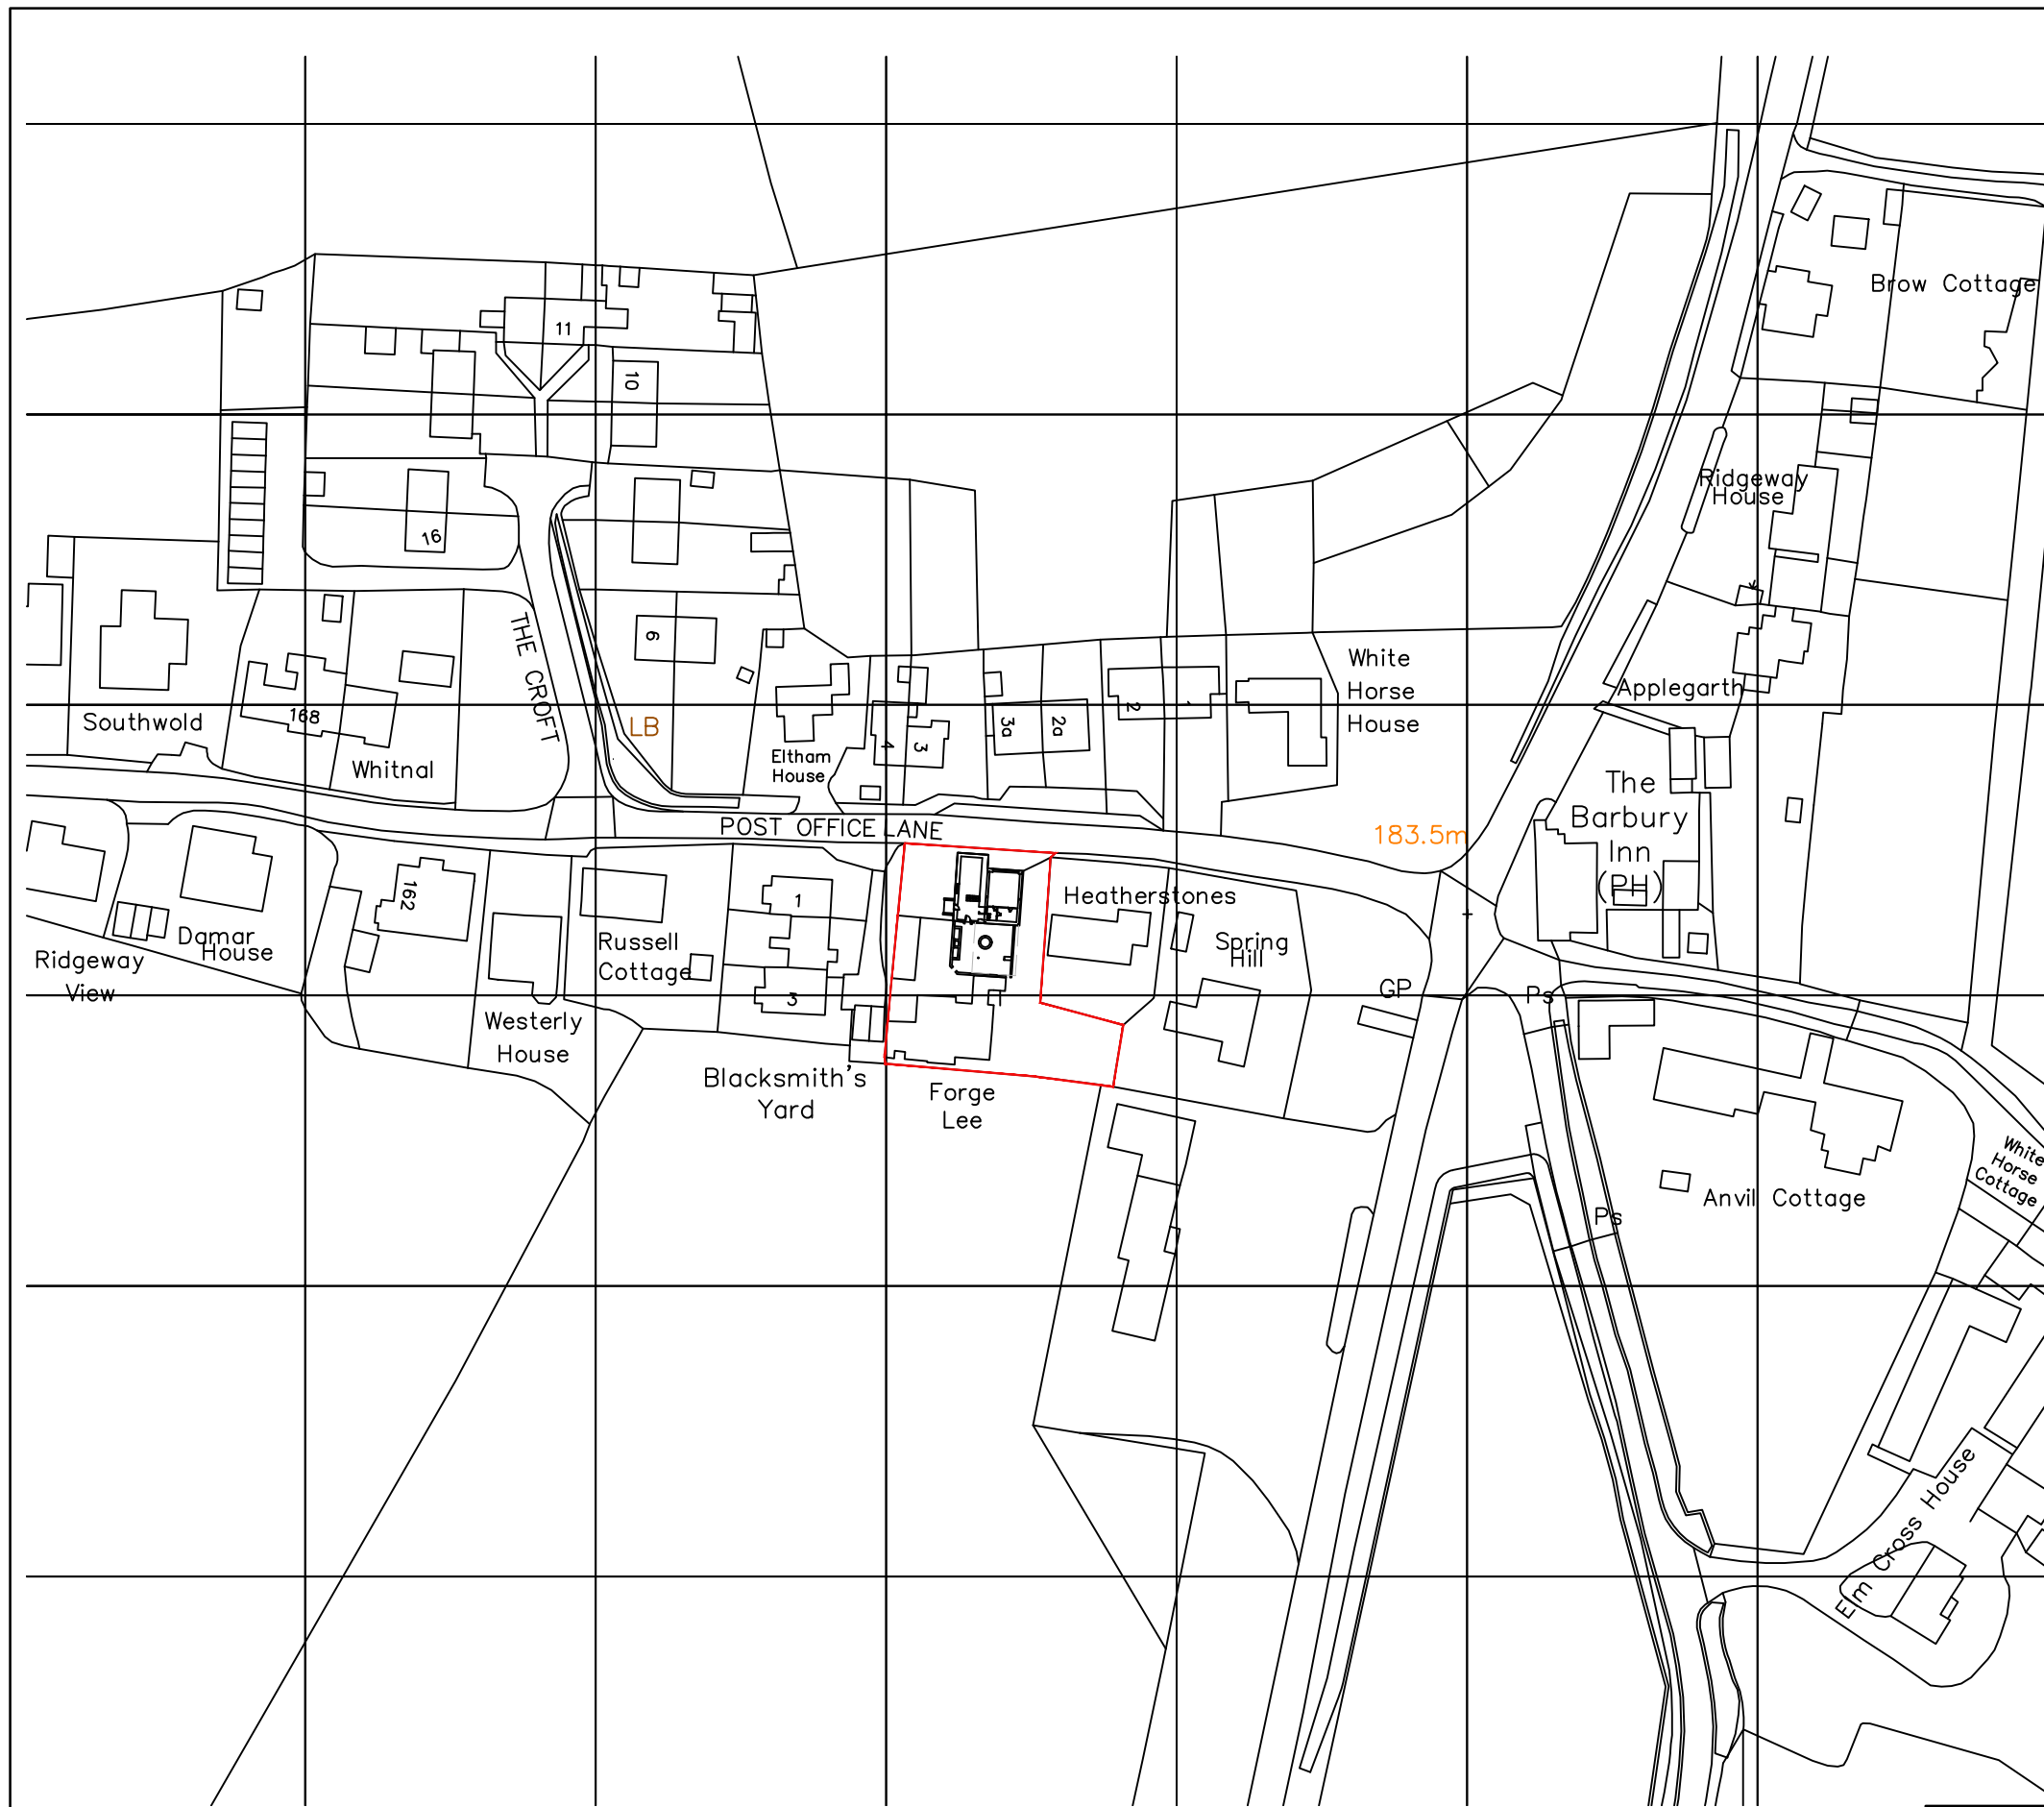


LOCATION PLAN 1-1250 (AS BUILT)

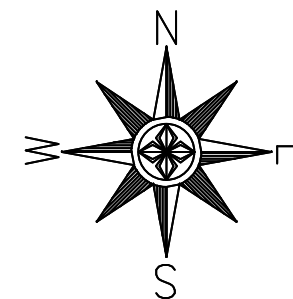

NUMBER - REV - CLIENT - PROJECT
00480-00 - A - Forge Lee - Broad Hinton

TITLE
Location & Block Plan (As Built)

DATE 23.10.24	SHEET 02	SCALE 1:1250&500
DRN BY CJB	CHK BY VW	PAPER SIZE A3

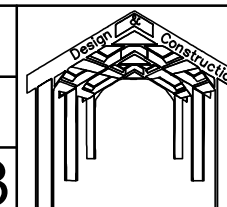

E&C Engineering Ltd
BOURNE WORKS
COLLINGBOURNE DUCIS
MARLBOROUGH
WILTSHIRE
SP8 3EH
Tel: 01264 850791
Email: vicwheeler75@gmail.com

Rev No.	Revision Note.	Date	Drawn	Checked