




Elevation A
1 : 700

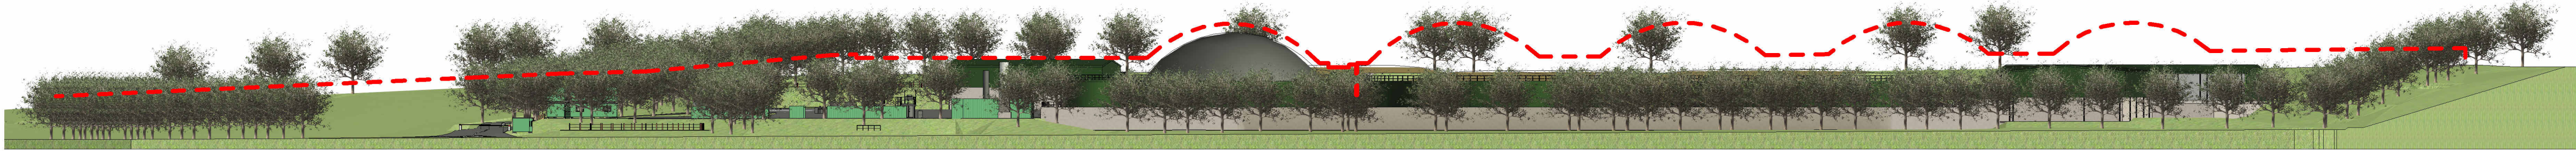


Elevation B
1 : 700

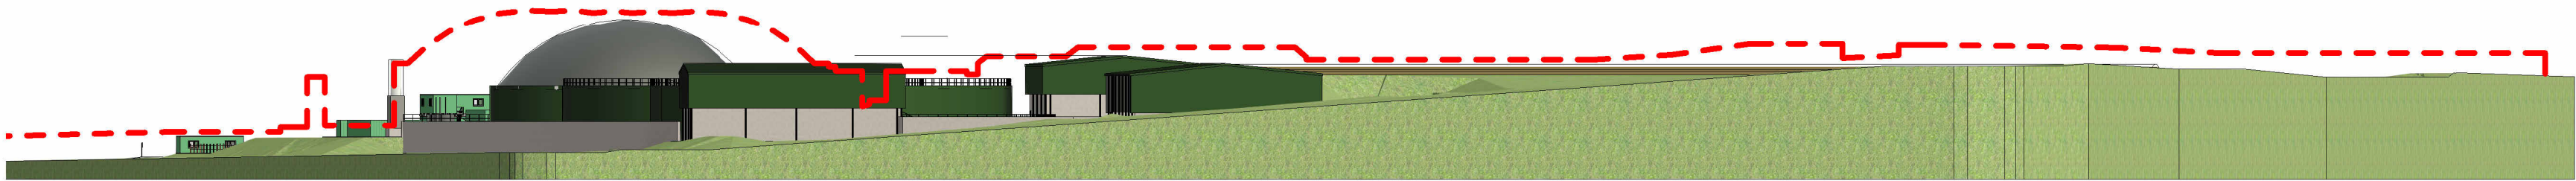

Elevation C
1 : 700

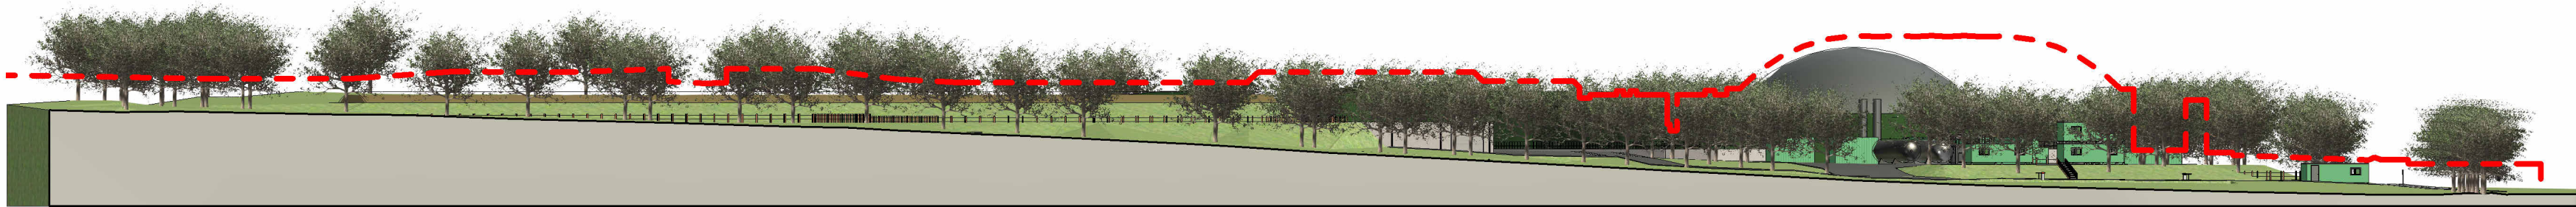

Elevation D
1 : 700

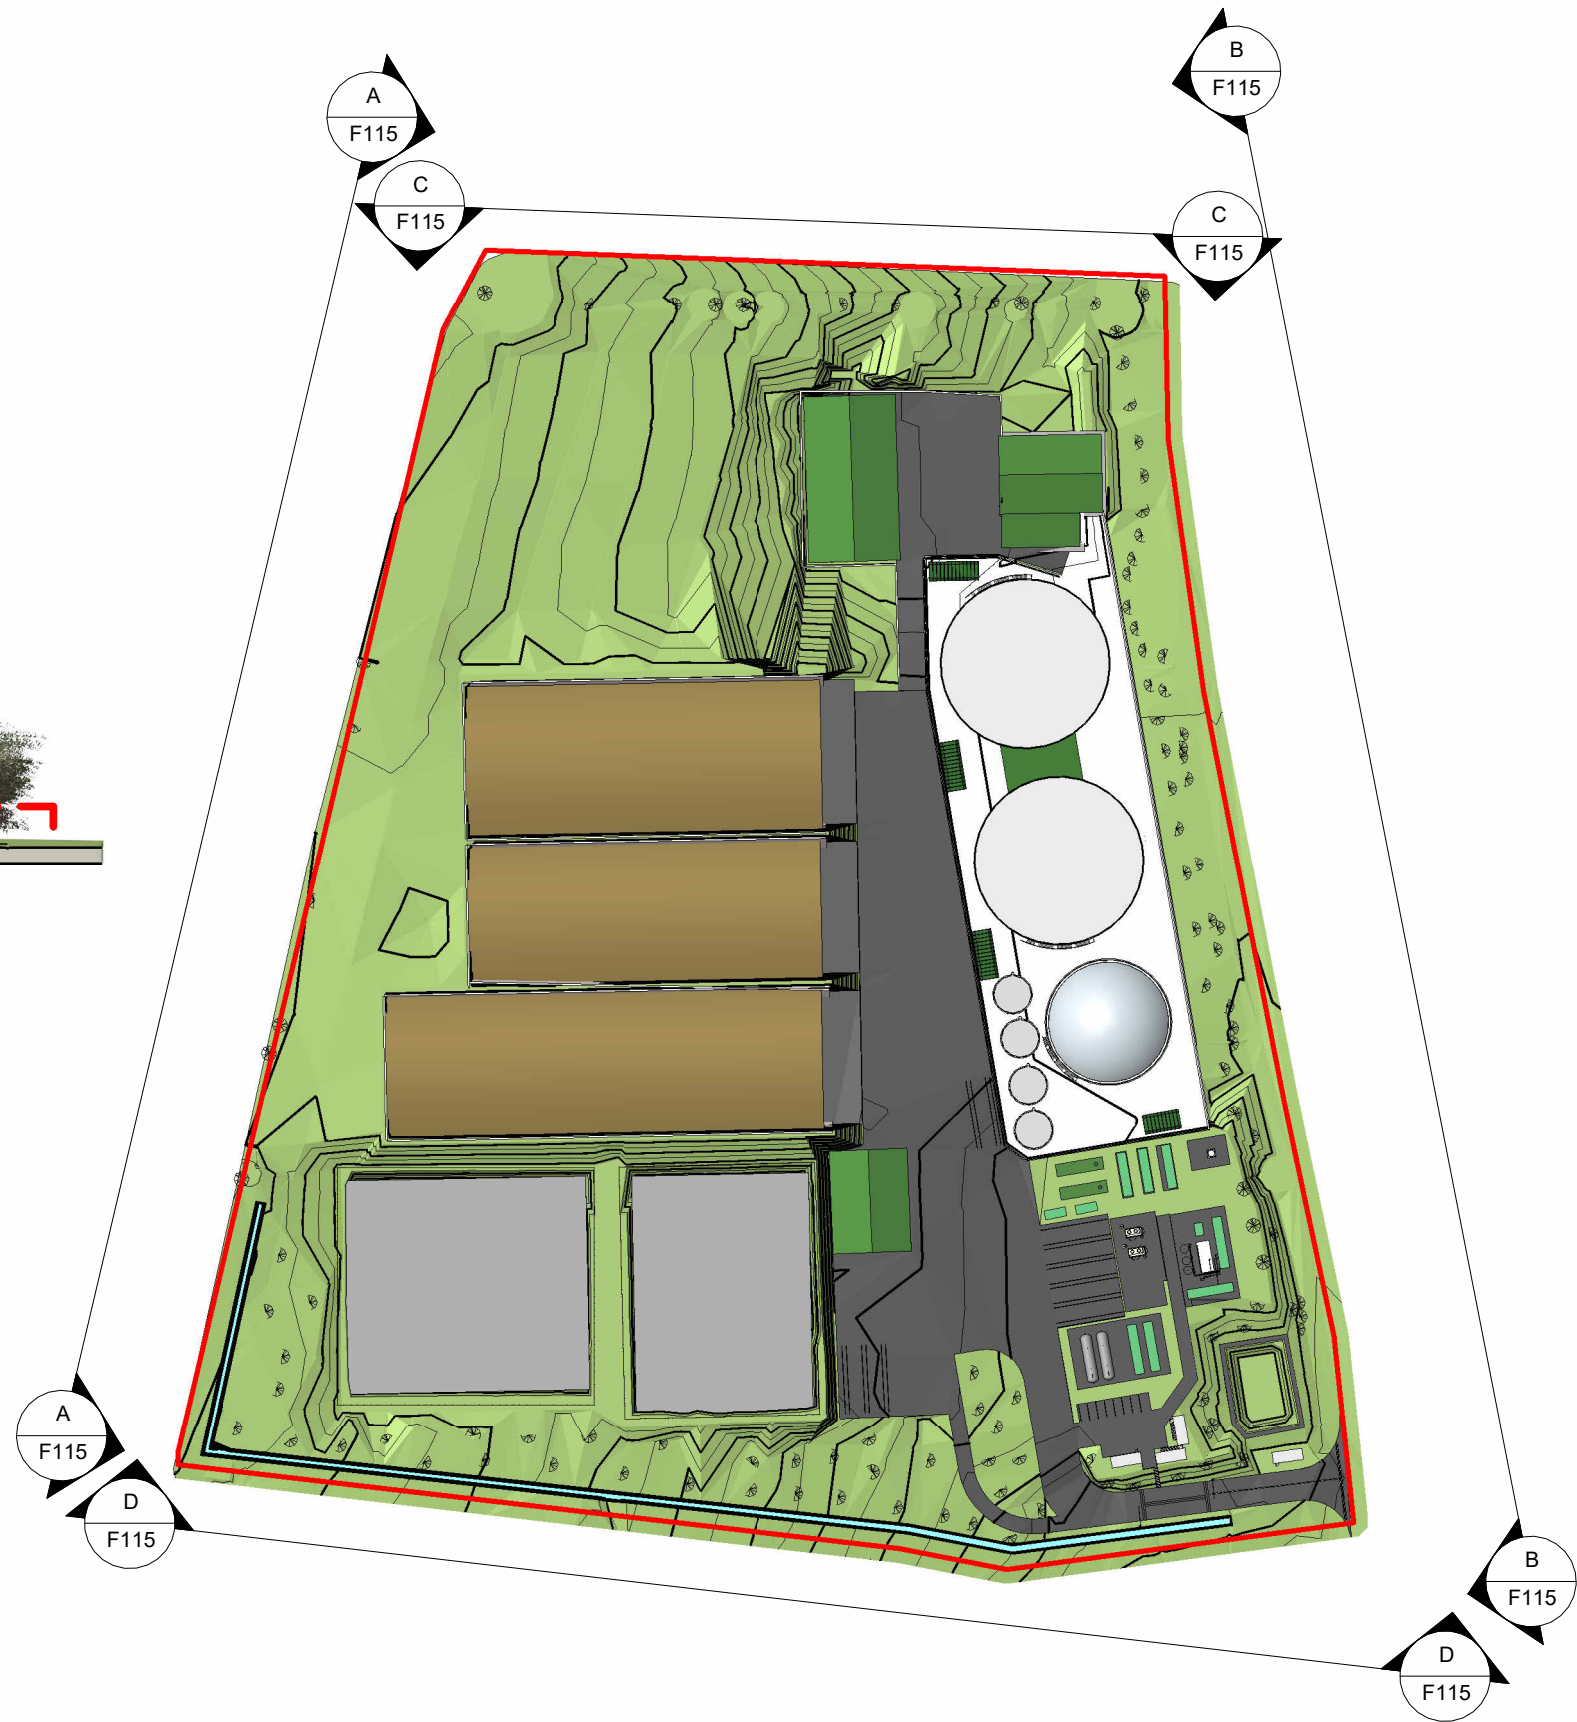

Elevation Key
1 : 2000

This drawing is to be used only for the purpose of the issue it was intended for.
For information relating to end use, maintenance, demolition, see Health & Safety files.
It is assumed that works will be undertaken by a competent Contractor to an approved method statement.
Legend / Notes

RED LINE INDICATES
PREVIOUS PLANNING
SCHEME DESIGN ON
ELEVATION.

0m 14m 28m 42m 56m 70m

VISUAL SCALE 1:700 @ A1

0m 40m 80m 120m 160m 200m

VISUAL SCALE 1:2000 @ A1

B	01/05/25	Issued for Planning	ASB	JC
A	25/02/25	Issued for Planning	ASB	JC
Rev	Date	Description	DR	CH
Status	Issued for Planning			Suitability



Contractor(s)



Project

ASHTON KEYNES AD Plant

Drawing Title

Elevation Views - Previous and New
Planning Scheme

Designed	J. Collins	Signed	Date	01/05/25
Drawn	A. Bruce	Signed	Date	01/05/25
Checked	L. Beaton	Signed	Date	01/05/25
Approved	J. Collins	Signed	Date	01/05/25

Scale(s)	As indicated @A1	ELR & Mileage
----------	------------------	---------------

Alternative Reference	Sheet
-----------------------	-------

Drawing Number	29419	of	Revision	B
----------------	-------	----	----------	---

ISSUED FOR PLANNING ONLY