
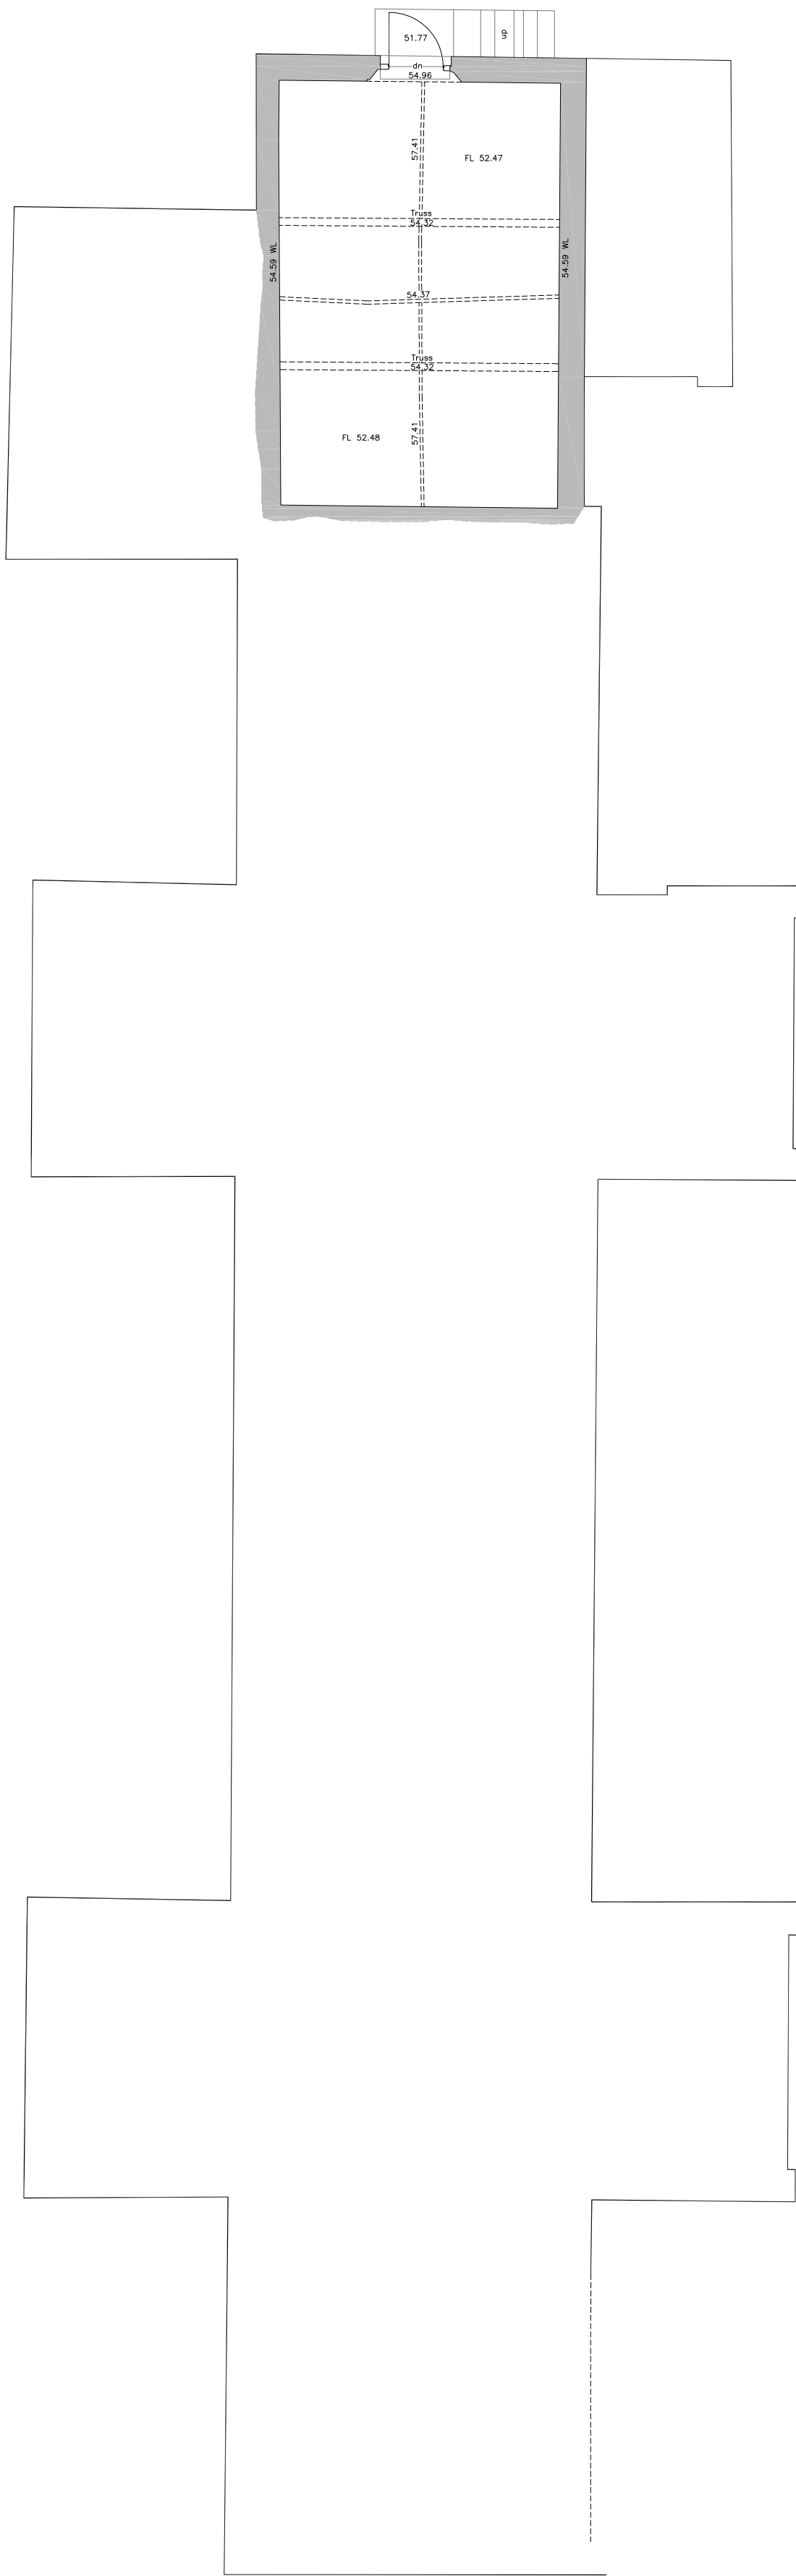


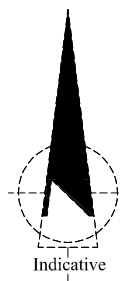

Scale 1 : 100

D&H

Surveys

Ltd

The Manor Stables, Great Sonnerford, Chippenham

Wiltshire, SN15 5EH.

Email: admin@dhsurveys.co.uk

Website: www.dhsurveys.co.uk

Tel (01249) 720545

Fax (01249) 721124

Topographic Surveys

Elevation Surveys

Floor Plan Surveys

Volumetric Surveys

As Built Drainage Surveys

Co-ordination Of Site Layouts

Rectified Photo Elevations

C.A.D Plotting Bureau

Project Name:

Shrub Farm Barn

Castle Combe SN14

Drawing Title:

Barn First Floor Plan

Client:

Mr Munnings

Agent:

LDPC

Date:

Oct 2025

Scale:

A1 @ 1:100

Drawn

Surveyor

Dwg No

Revision

KJH

GH

FP 02

Site Datum

TBM GFL 50.00m

OSBM Ref

Grid Orientation

Arbitrary

Sheet ID

LDPC-Castle Combe Shrub Farm

Disclaimer

D & H Surveys will Guarantee that this

Survey Data & Station Coords are Correct to the Indicated Scale ONLY

Copyright of this Drawing Remains With D & H Surveys.