


no.2 Norton Dr.


Duty of care: The design, so far as is reasonably practicable, has been created so that the construction is carried out and managed without risks to the health or safety of those who build, use and maintain them.

This drawing is copyright and is not to be reproduced. The contractor will be held responsible for the accuracy of works involving the setting out and checking of all dimensions on the drawing and on site. Dimensions must not be scaled from this drawing.



Unless for planning purposes

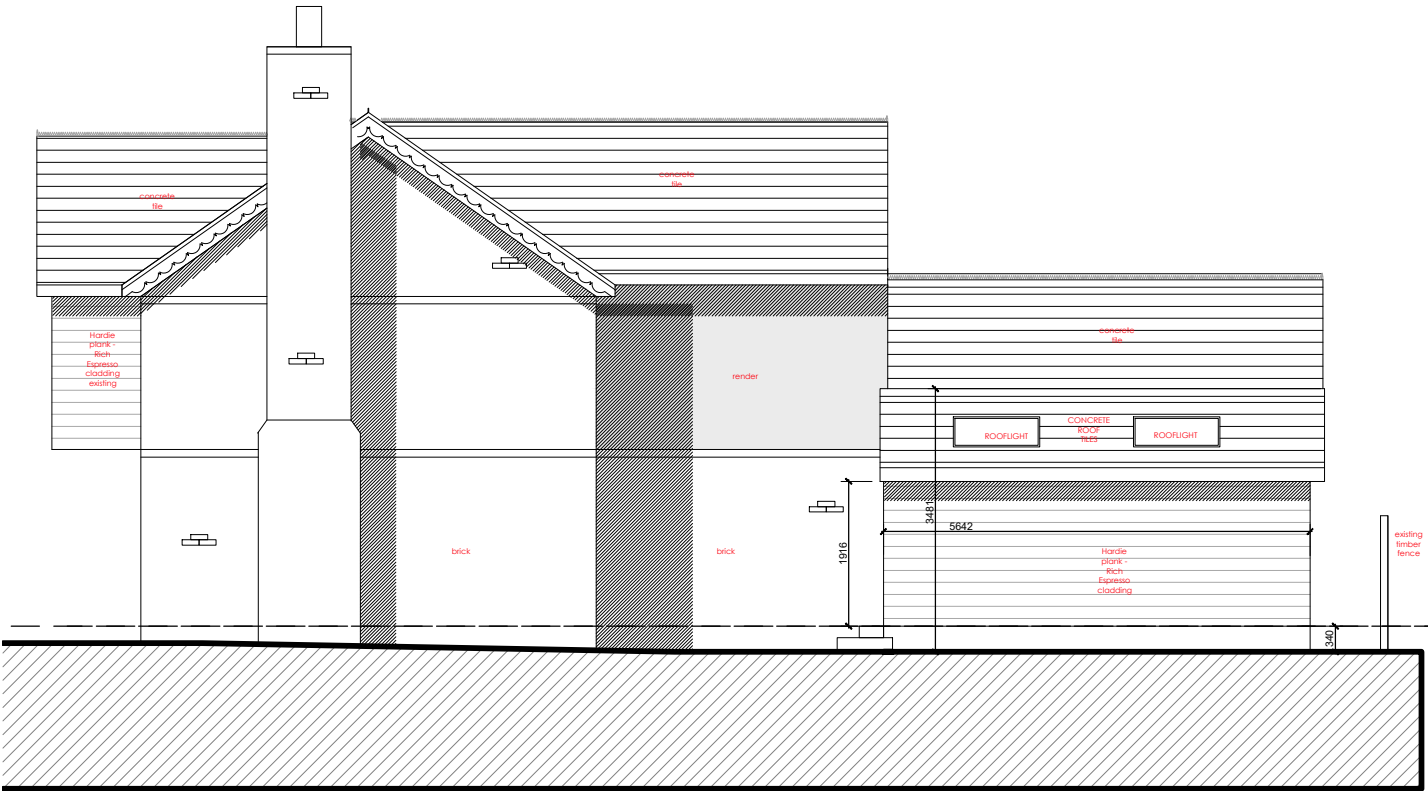

As built Elevation 02 1:100

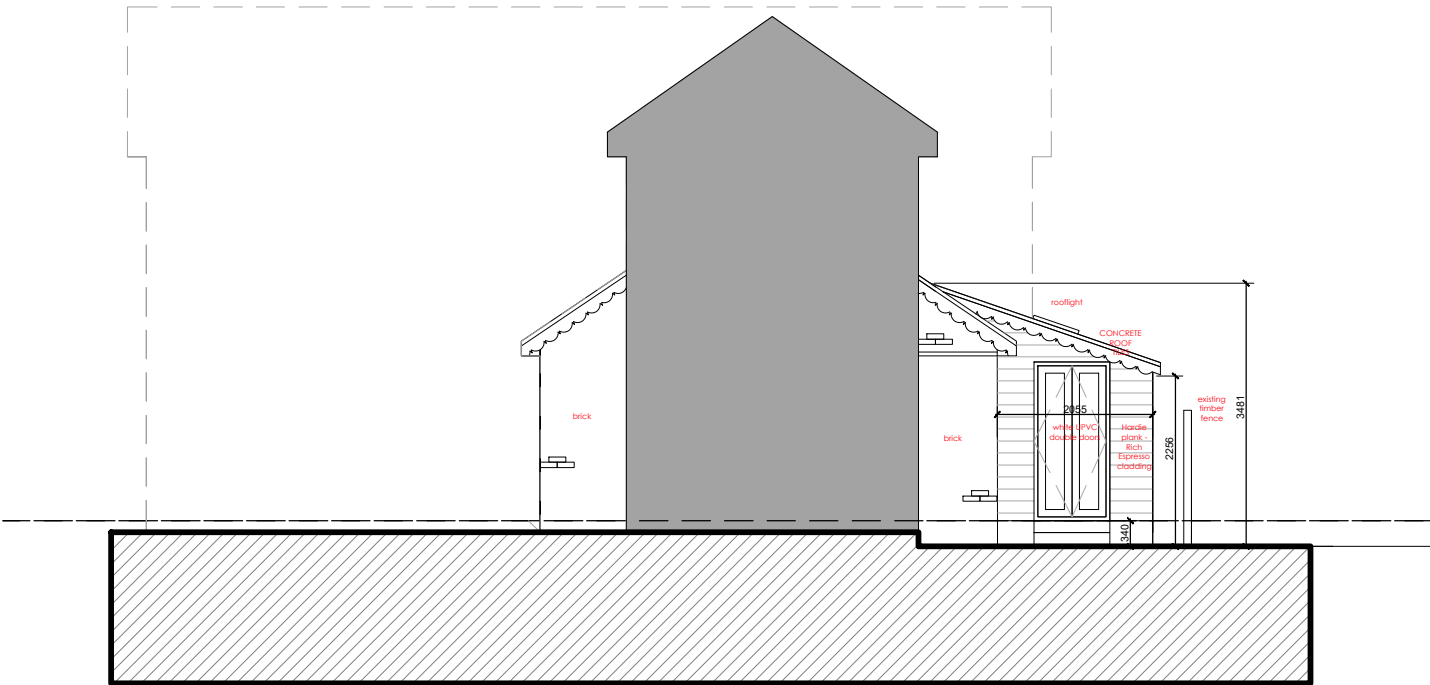

As built Section 05 1:100

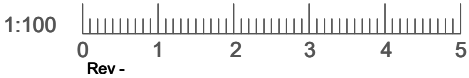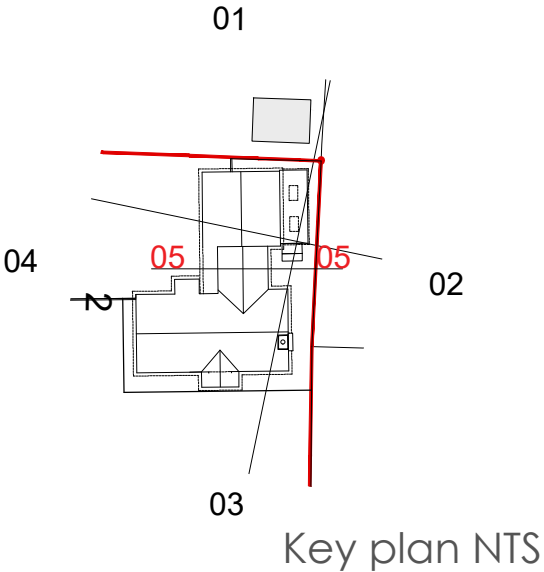

Client: Mr and Mrs Miller		Planning App.	
Project: 2 Norton drive, Ford, Salisbury, SP4 6DA		Drawing No: 0545-02-018	Revision:
Title: As built elevations	Drawn: sb Check: NB	Scale: 1:100 @a3	First Issue: Nov. 2025

bircharchitects
Lambourne, Grove Lane, Redlynch, Salisbury, Wilts, SP5 2NR
T: +44 (0)1725 510407
e: info@bircharchitects.co.uk