




North Elevation

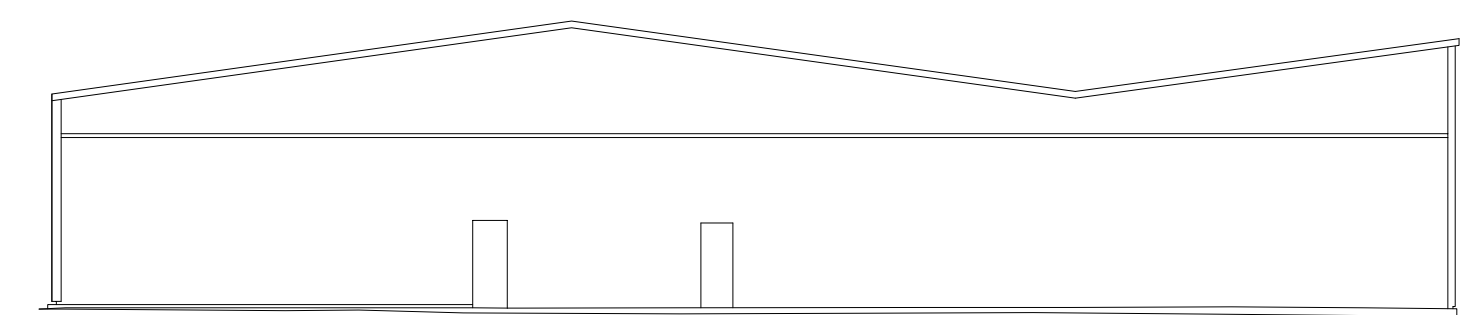


West Elevation

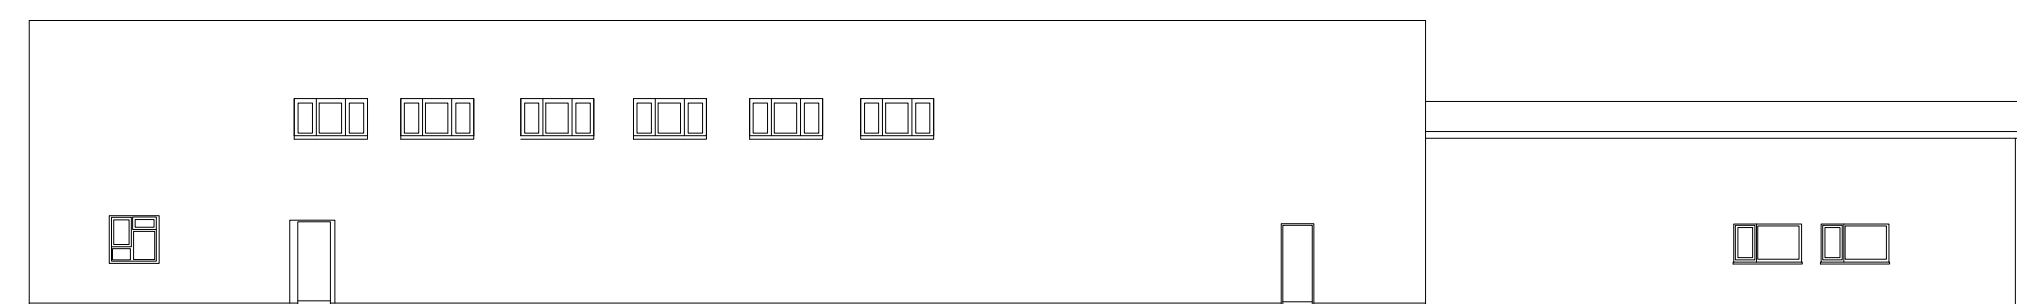

South Elevation

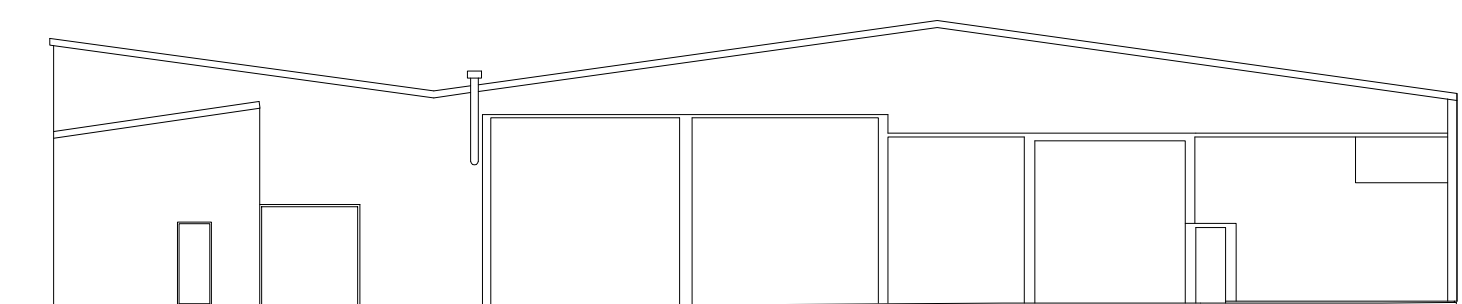

East Elevation

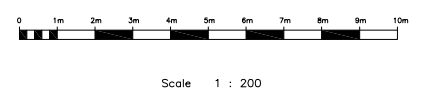

|                                                                                                                                                                                              |                            |                                                                                                                   |                 |
|----------------------------------------------------------------------------------------------------------------------------------------------------------------------------------------------|----------------------------|-------------------------------------------------------------------------------------------------------------------|-----------------|
| <h1 style="margin: 0;">D&amp;H Surveys Ltd</h1> <p style="margin: 0;">The Manor Stables, Great Somerford, Chippenham<br/>Wiltshire, SN15 5EH.</p>                                            |                            |                                                                                                                   |                 |
| Email: <a href="mailto:admin@dsurveys.co.uk">admin@dsurveys.co.uk</a><br>Website: <a href="http://www.dhsurveys.co.uk">www.dhsurveys.co.uk</a>                                               |                            | Tel (01249) 720545<br>Fax (01249) 721124                                                                          |                 |
| Topographic Surveys<br>Elevation Surveys<br>Floor Plan Surveys<br>Volumetric Surveys                                                                                                         |                            | As Built Drainage Surveys<br>Co-ordination Of Site Layouts<br>Rectified Photo Elevations<br>C.A.D Plotting Bureau |                 |
| <div style="border: 1px solid black; padding: 5px;"> <b>Project Name:</b><br/>         Dreamworks<br/>         Brook Lane, Westbury       </div>                                             |                            |                                                                                                                   |                 |
| <b>Drawing Title:</b><br>Elevations                                                                                                                                                          |                            |                                                                                                                   |                 |
| <b>Client:</b><br>Woolley & Wallis<br>Agent:                                                                                                                                                 |                            |                                                                                                                   |                 |
| <b>Date:</b><br>Nov 2025                                                                                                                                                                     |                            | <b>Scale:</b><br>A1 @ 1:200                                                                                       |                 |
| <b>Drawn</b><br><br>K.J.H                                                                                                                                                                    | <b>Surveyor</b><br><br>G.H | <b>Dwg No</b><br><br>EL 01                                                                                        | <b>Revision</b> |
| <b>Site Datum</b><br>Ordnance Survey                                                                                                                                                         |                            | <b>OSBM Ref</b><br>OS15                                                                                           |                 |
| <b>Grid Orientation</b><br>N/A                                                                                                                                                               |                            | <b>Sheet ID</b><br>Woolley-Wallis-Dreamworks2                                                                     |                 |
| <b>Disclaimer</b><br>D & H Surveys will Guarantee that this<br>Survey Data & Station Coords are Correct to the Indicated Scale ONLY<br>Copyright of this Drawing Remains With D & H Surveys. |                            |                                                                                                                   |                 |