


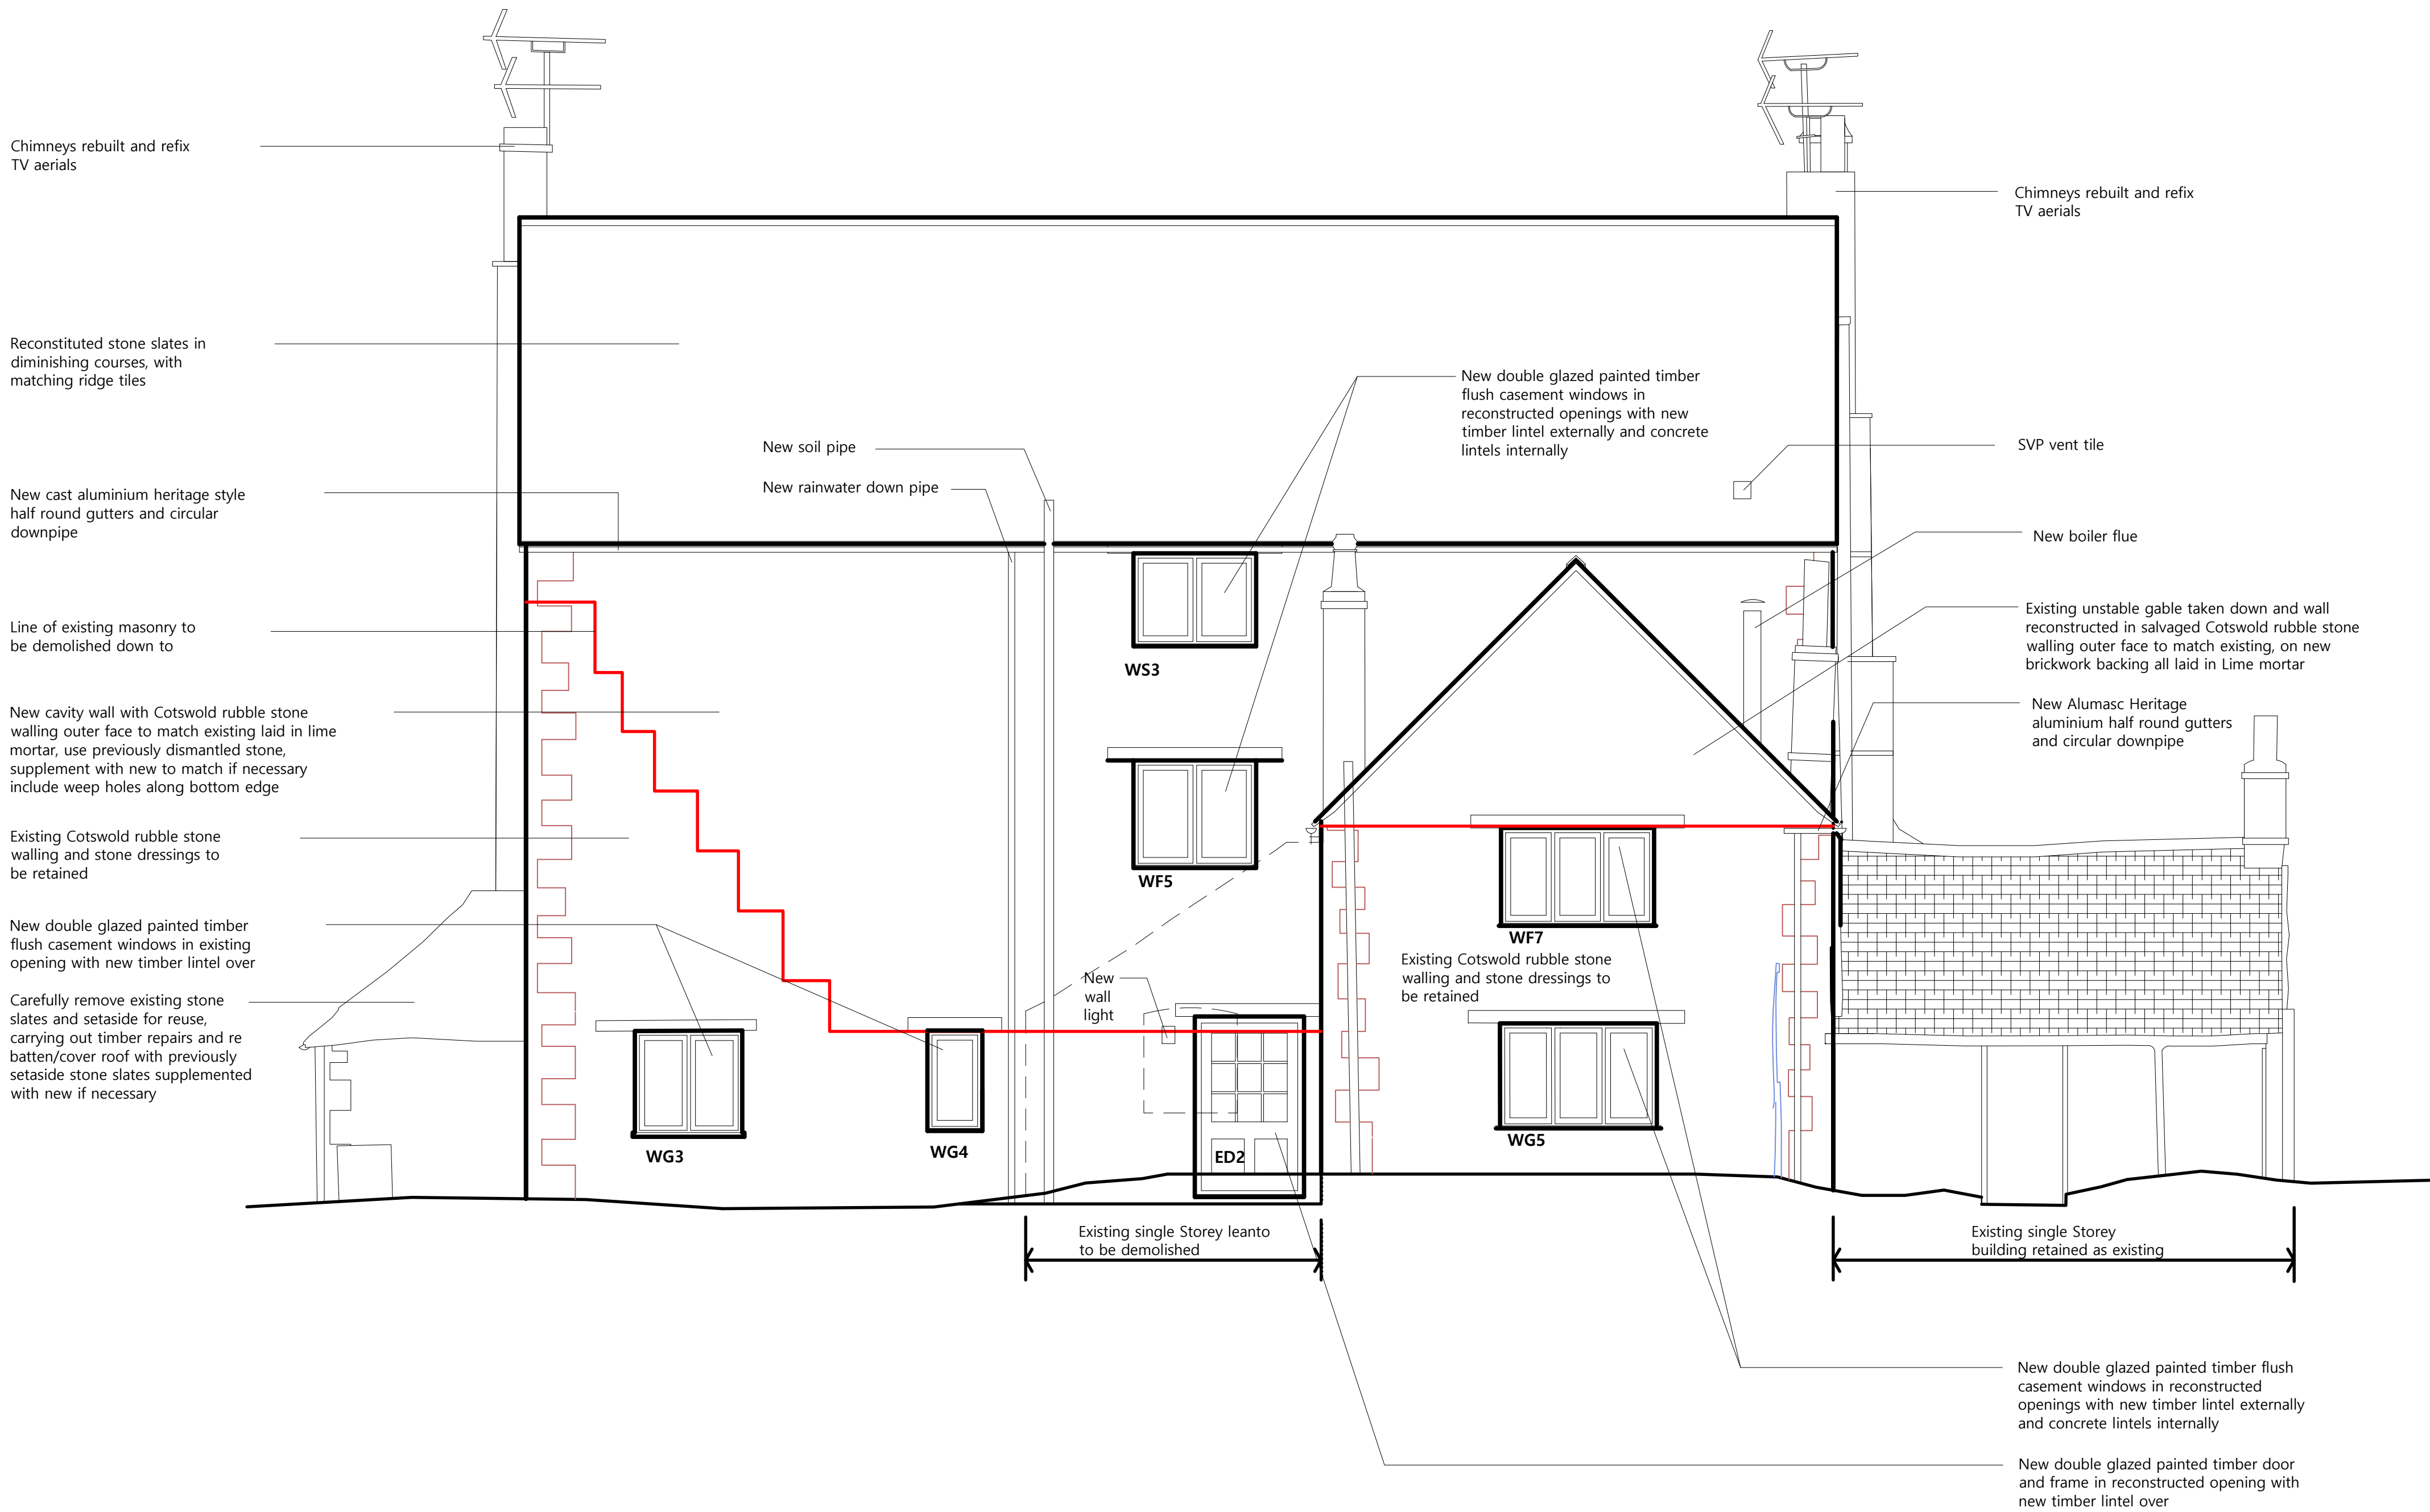


Under previously approved planning applications PL/2025/06917 and PL/2025/07144 it has been approved that the existing building will be reduced down ground floor window head height. It is hoped that it will be possible to retain more of the existing walling as indicated by the redline shown, however if for structural or safety reasons its not possible to achieve this, then the previously approved reduced levels shown on approved drawings 23079-SFK-01-XX-DR-S-0011 P2, 23079-SFK-01-XX-DR-S-0012 P1, 23079-SFK-01-XX-DR-S-0013 P1 & 23079-SFK-01-XX-DR-S-0014 P1 will be the fall back position

NOTES

Drawings are based on survey data and may not accurately represent what is physically present. Scale for planning purposes only. All dimensions are to be verified on site before proceeding with the work.

All dimensions are in millimeters unless noted otherwise.

James Mackintosh Architects shall be notified in writing of any discrepancies.

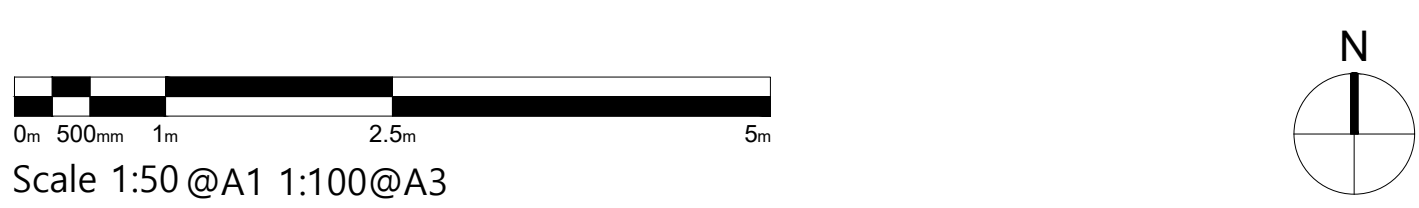

A	8/12/25	RB	Notes added
-	Nov 25	RB	First issue
ISSUE	DATE	DRAWN	CHECKEDDESCRIPTION

JAMES MACKINTOSH ARCHITECTS

DESIGN / CONSERVATION / HISTORIC INTERIORS

E. studio@jmackintosh.com
T. 01608 692310 W. www.jamesmackintosharchitects.com

PROJECT	IDOVER DEMESNE FARM	DRG TITLE	Proposed North Elevation
CLIENT	Vaughan Consultancy	JOB/DRG No.	381/220
DRAWING STATUS	Planning/LBC	SCALE	1:50@A1 1:100@A3 REVISION A