
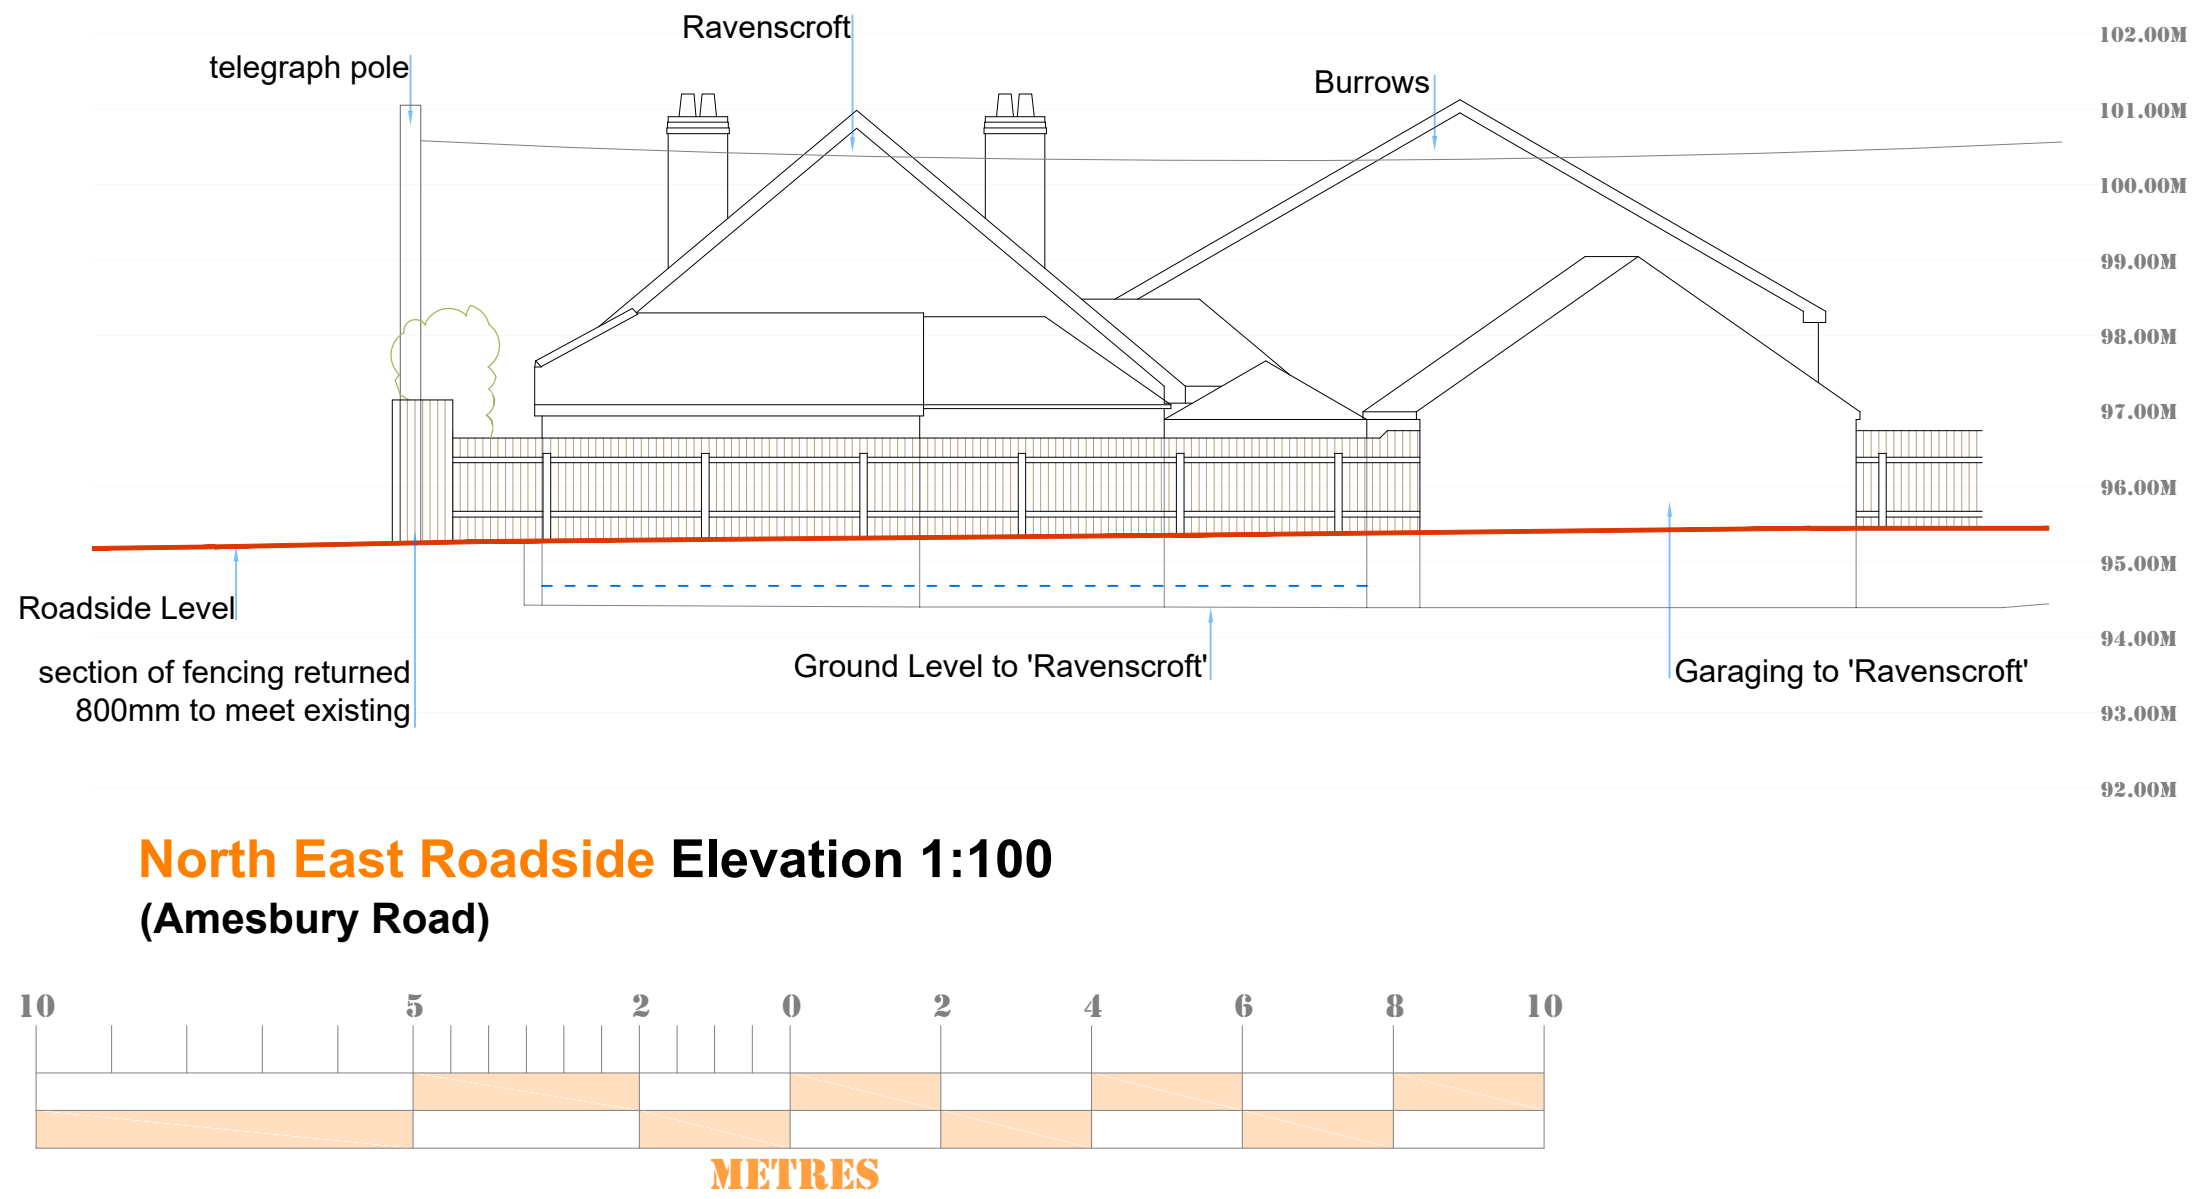
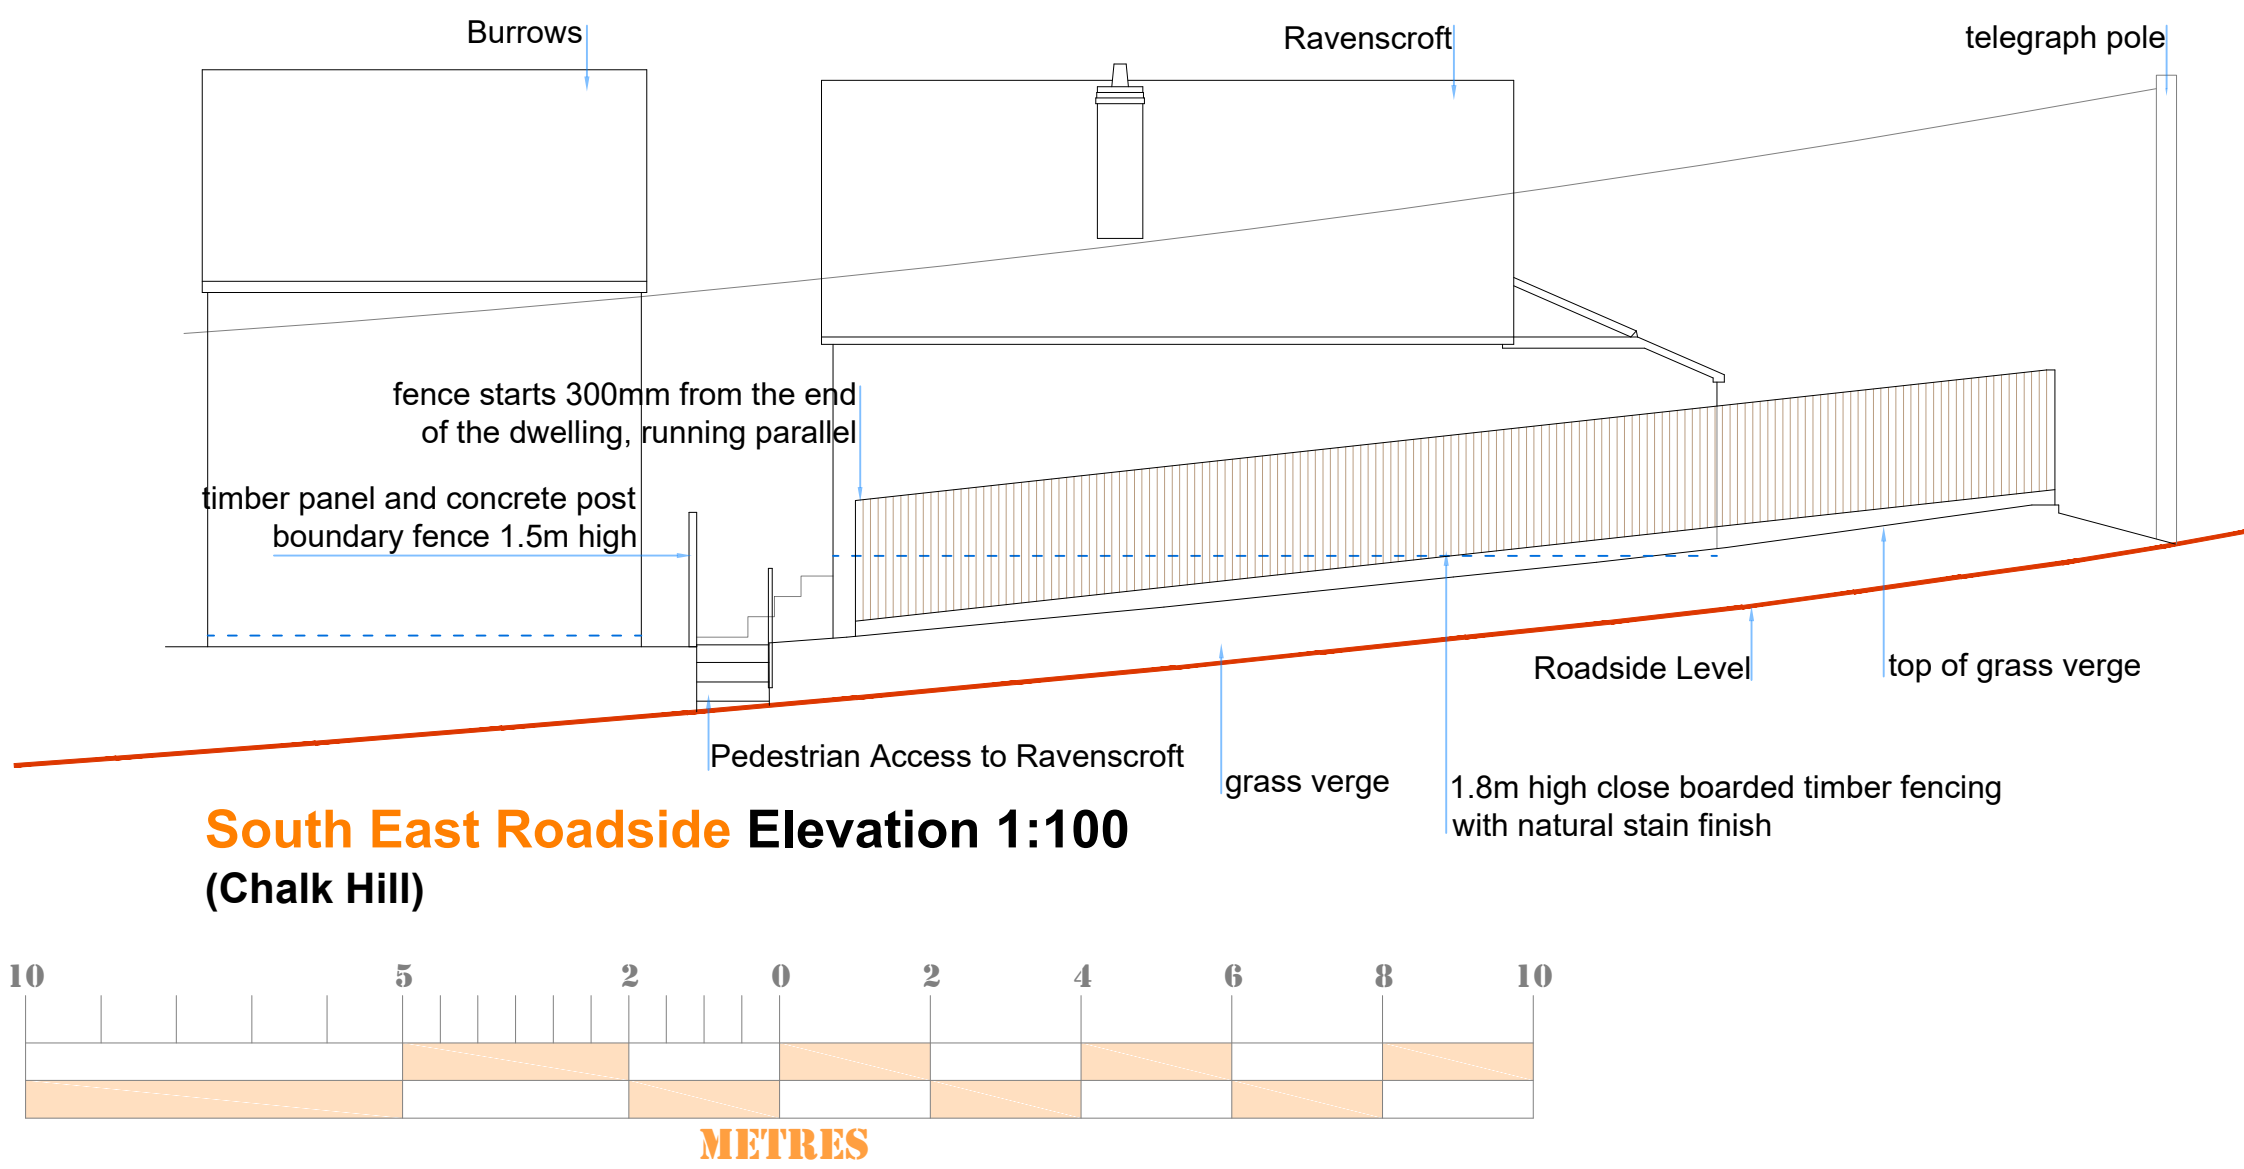


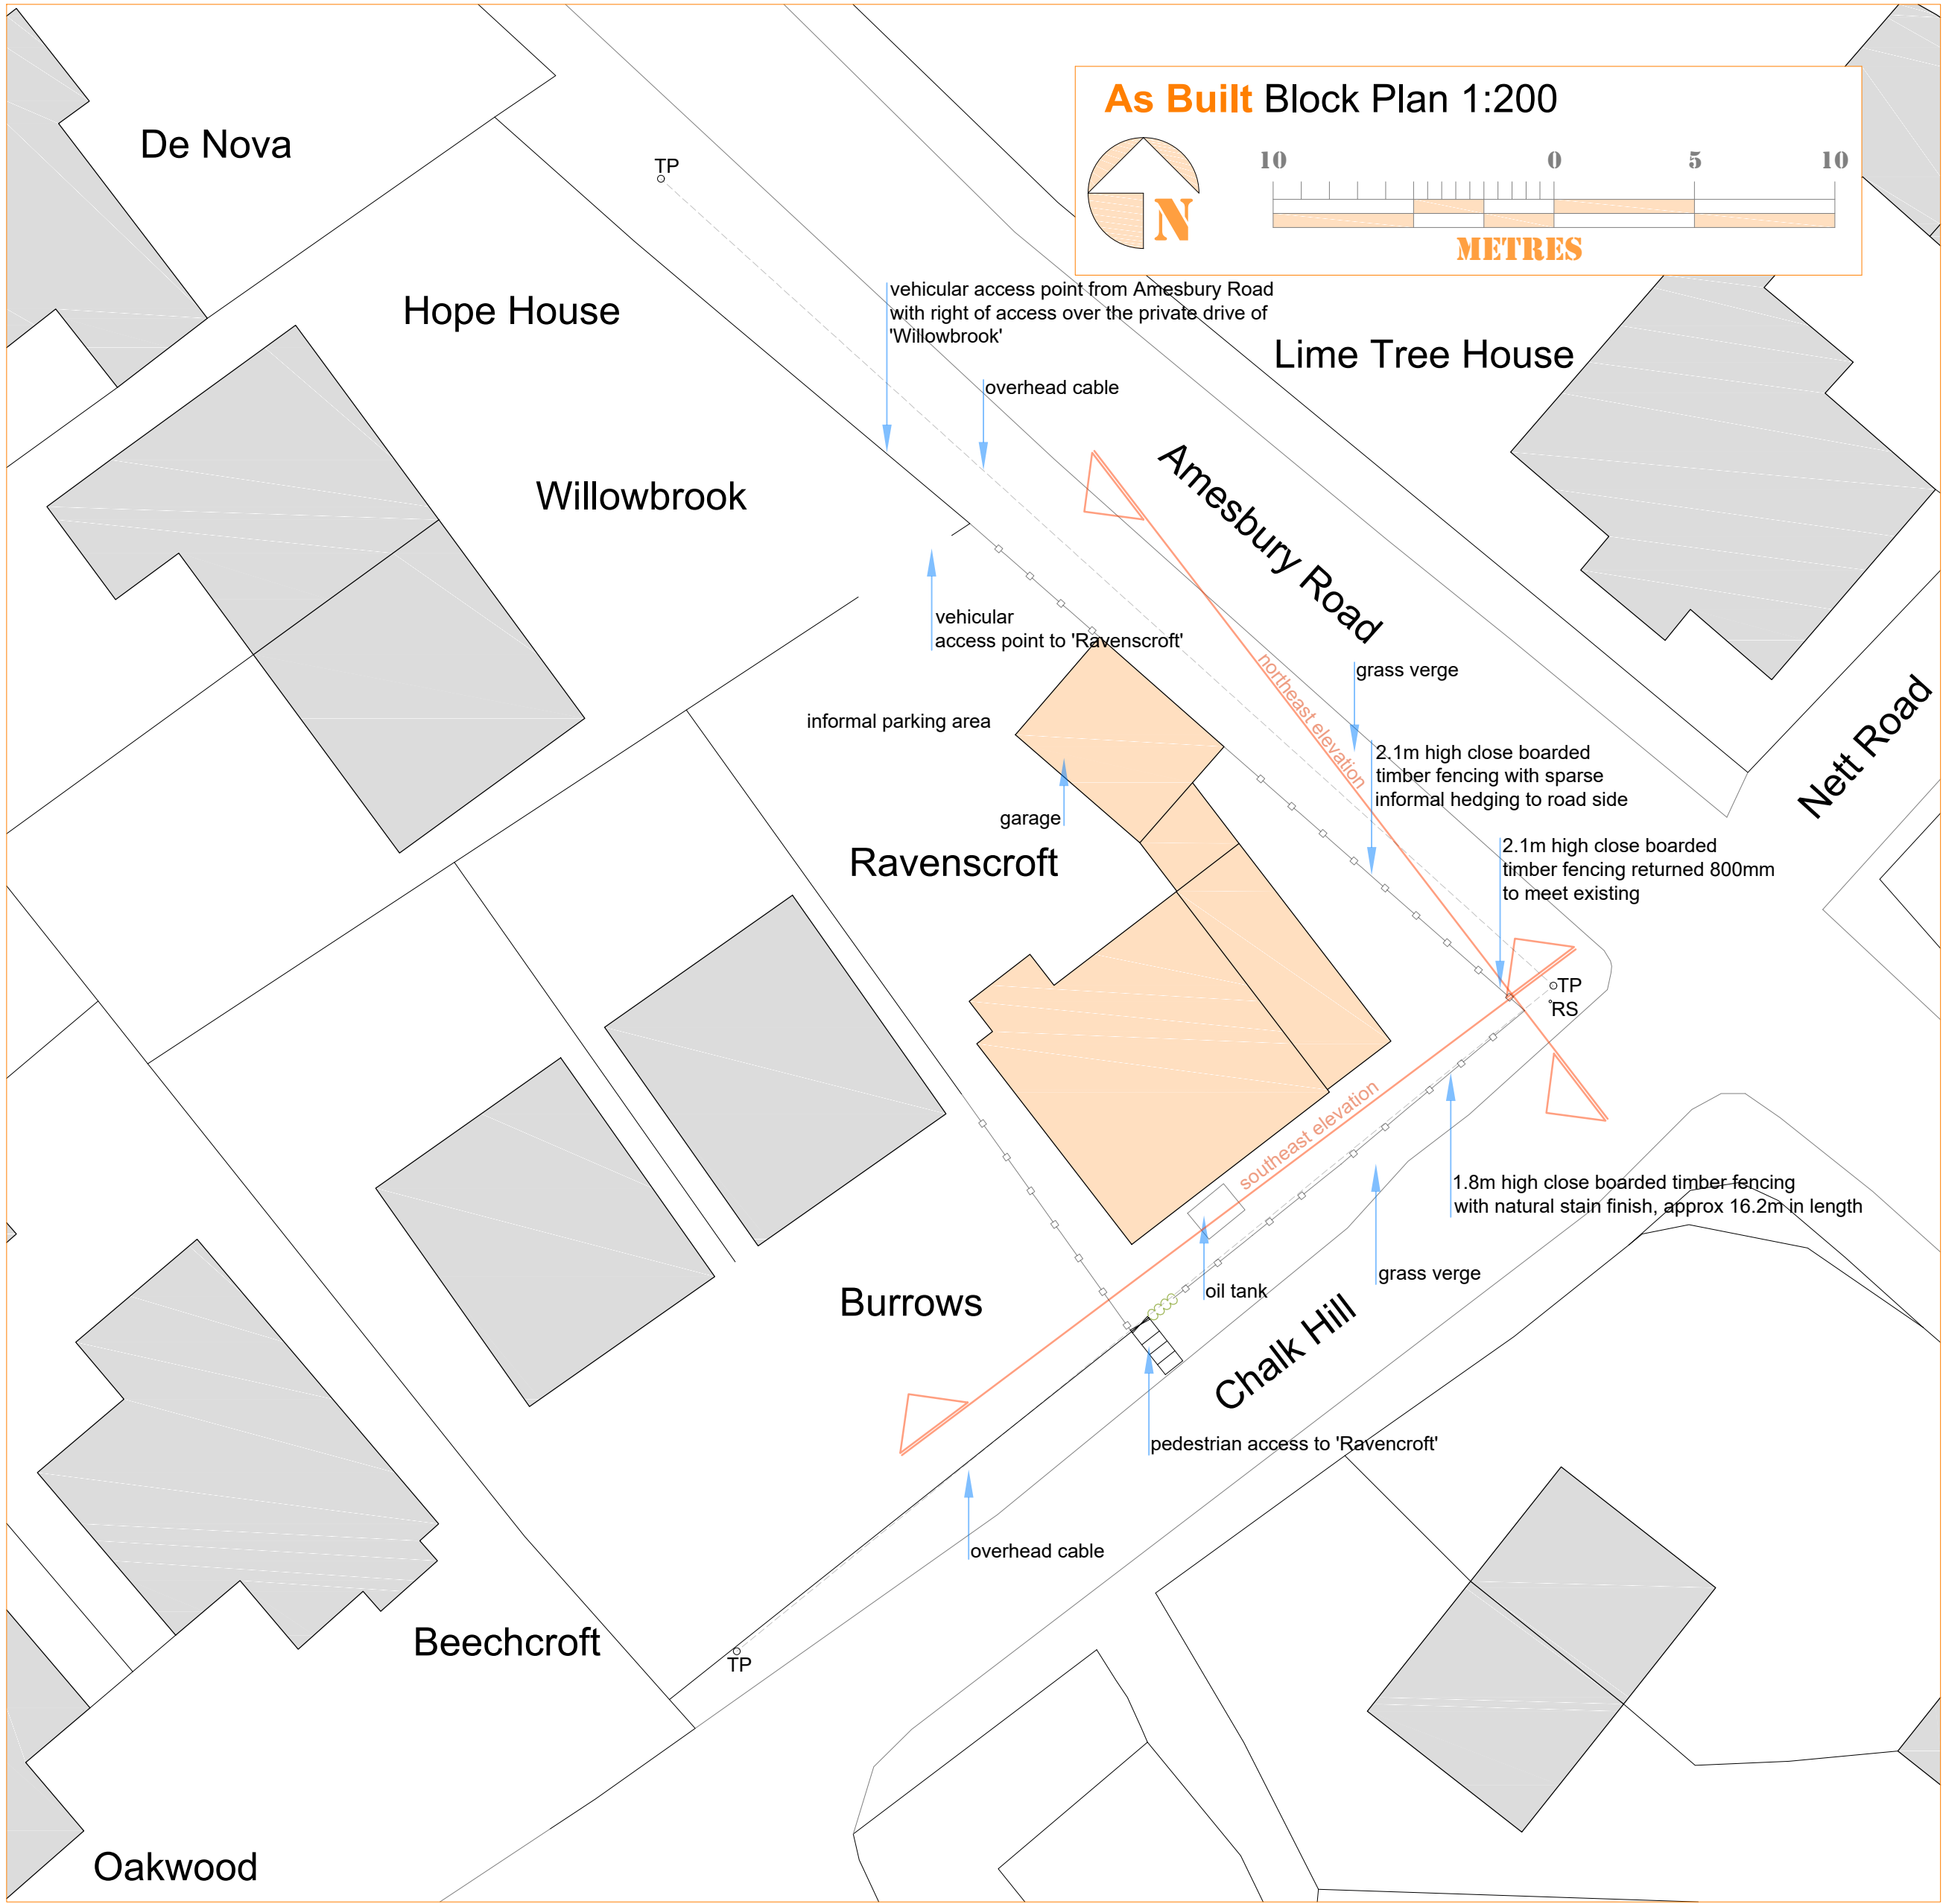

All details and layouts to be checked on site prior to commencement.
If in any doubt, contact to discuss in further detail.
Do not scale from drawing, all dimensions to be checked on site.
Copyright of the drawings remains with ARQ and distribution is only intended for the project commissioned.
Further use of these plans from third parties is breach of UK Copyright laws, if in doubt contact the originator of the plans.

Revisions:

A	addition of scale bar to elevations
B	

Date

19JAN26

Scale: as noted

Date: 07JAN26

Drawn: TA

Issue: Planning Application

Project: Retrospective Planning Application to retain southern boundary fence 'Ravenscroft', Chalk Hill, Shrewton, Salisbury. SP3 4EU.

Client: Mr & Mrs G Martin

Drawing Title: As Built Arrangements

Revision: A Paper Size: A1 Drawing No: ARQ/1222/03



Tel: 07842 105707
email: arqdes@outlook.com