




© THIS DRAWING IS THE COPYRIGHT OF
MICHAEL LYONS ARCHITECTURE AND
MUST NOT BE COPIED, USED OR
DISCLOSED WITHOUT PRIOR PERMISSION.

THIS DRAWING MUST NOT BE SCALED.
ALL DIMENSIONS ARE TO BE CHECKED ON
SITE BEFORE WORK IS COMMENCED. ANY
DISCREPANCIES ARE TO BE REPORTED
IMMEDIATELY TO THE CONSULTANTS.

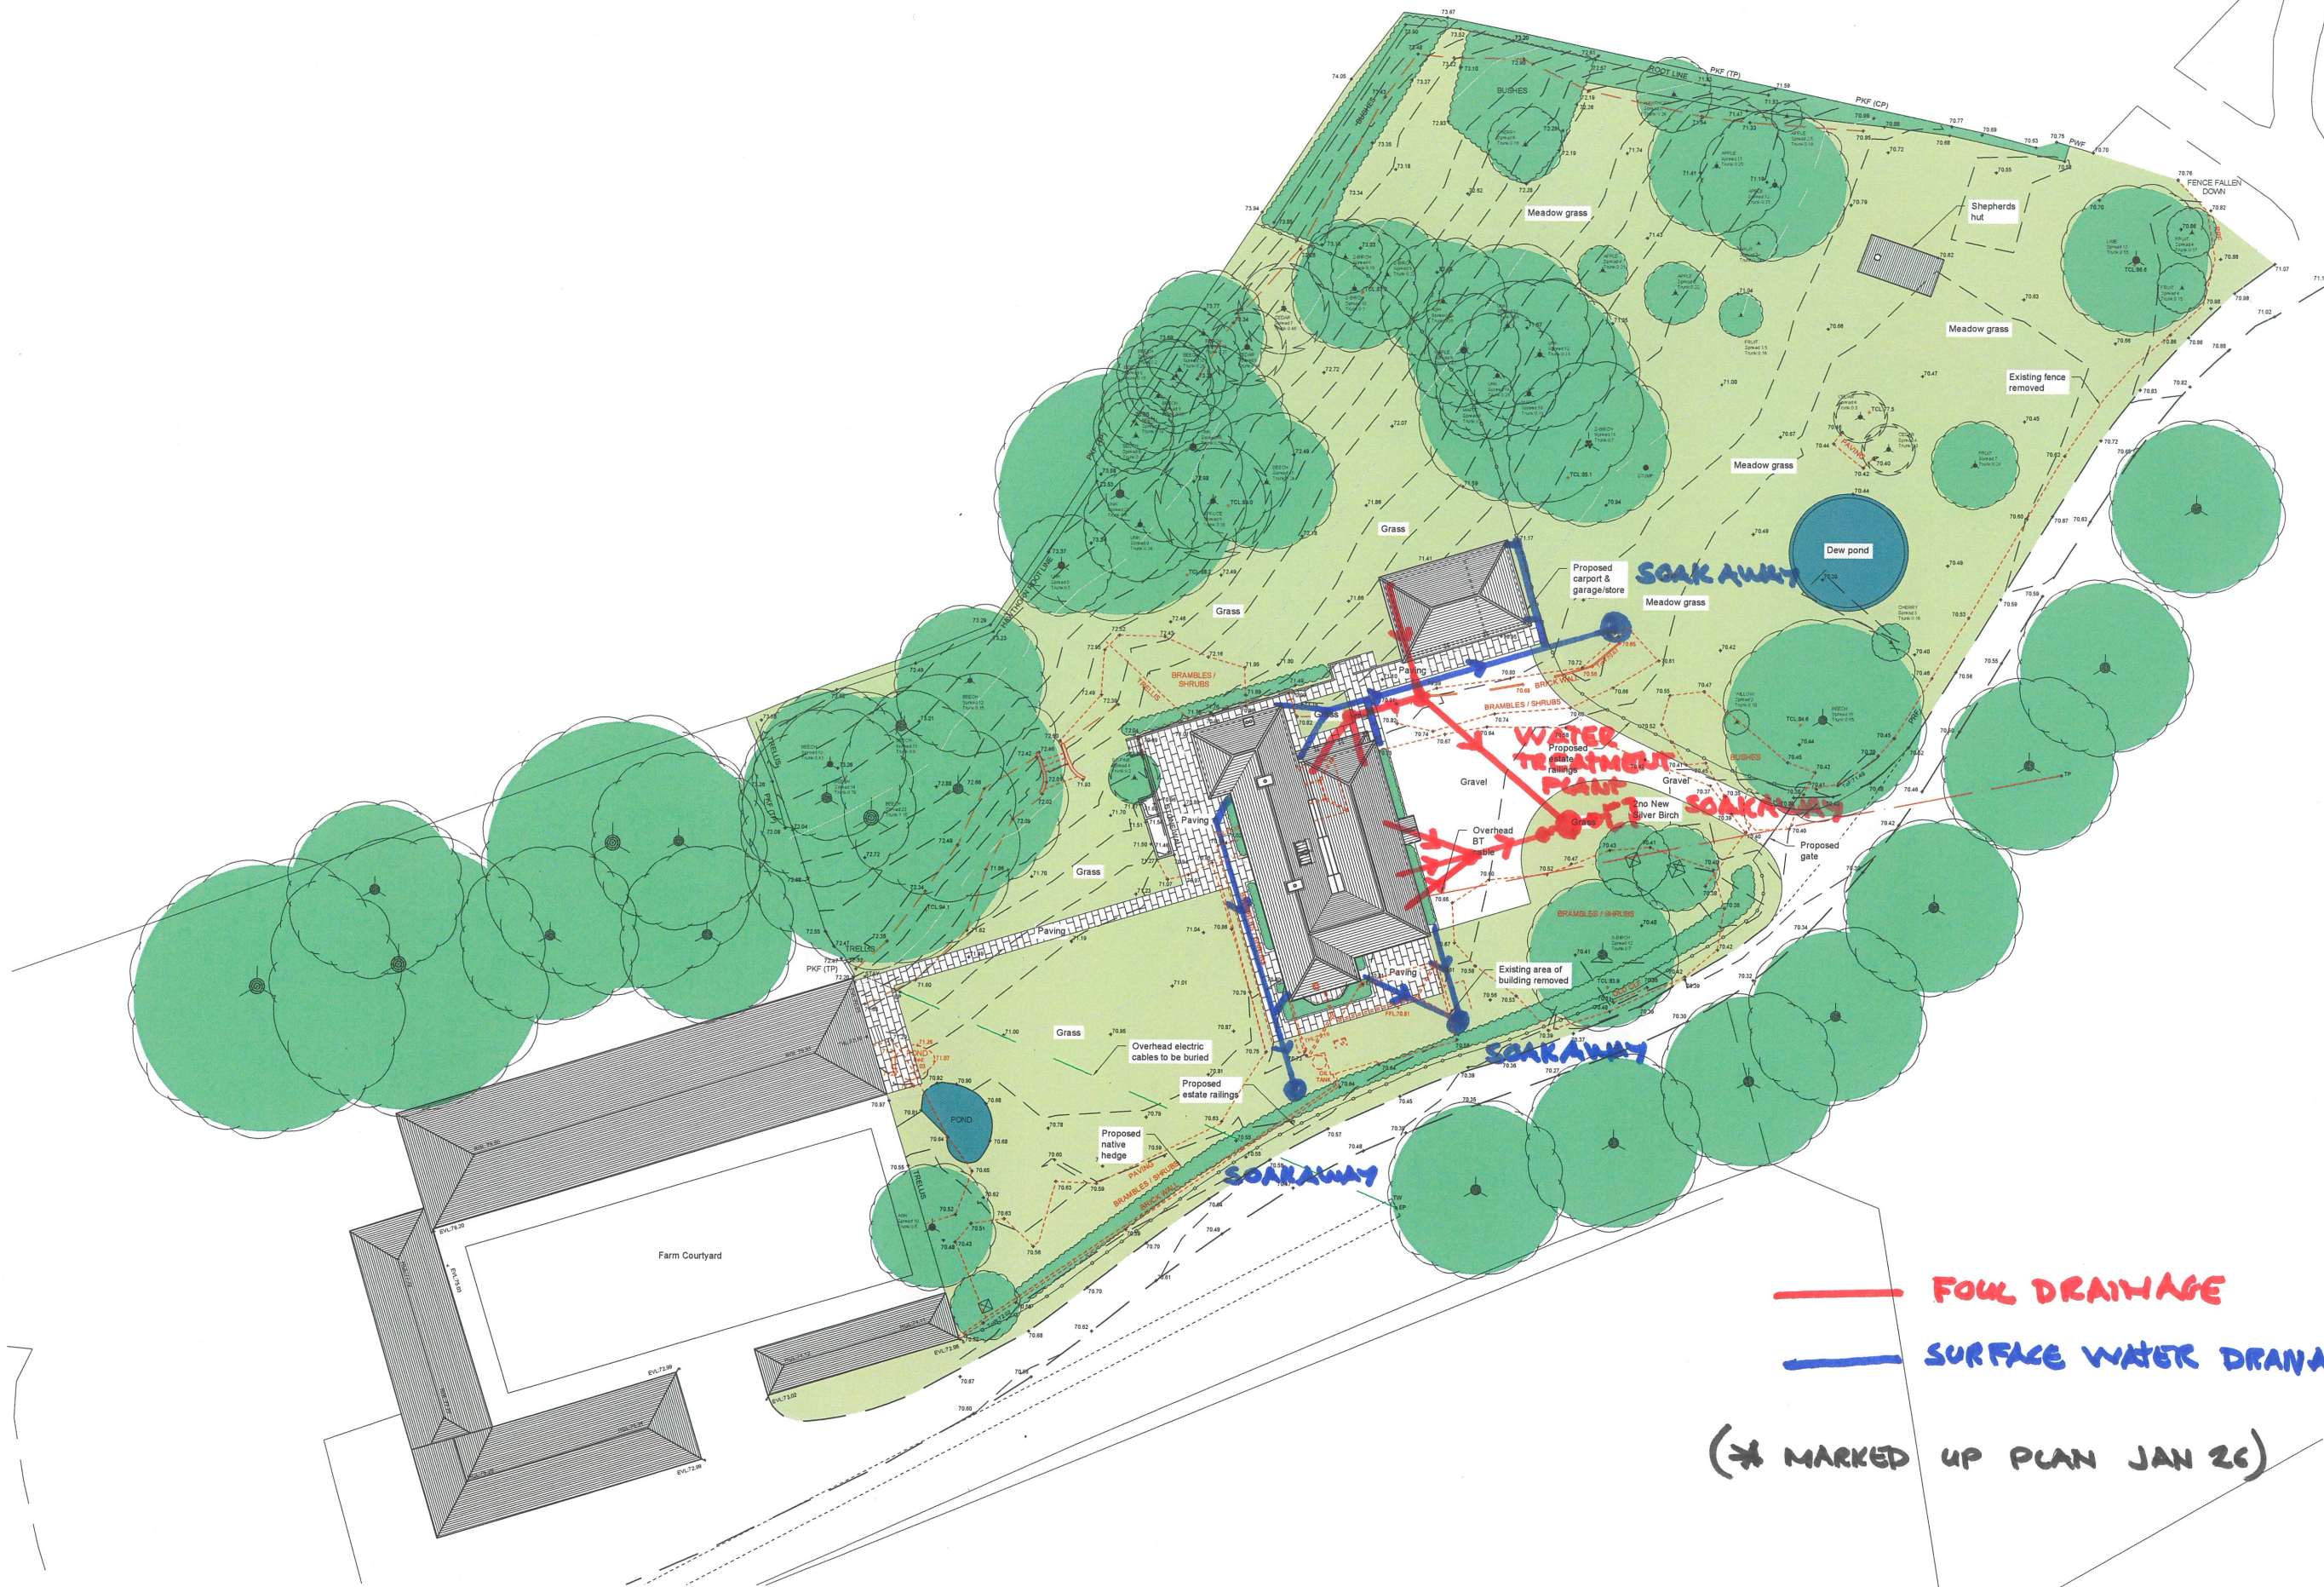

Proposed Site Location Plan

Revisions

Michael Lyons Architecture
1 Manor Farm Barns
Burcombe Lane, Burcombe
Salisbury, SP2 0EJ
Tel: 01722 743186
info@mlarchitecture.co.uk

Project:
Springbottom Farm
Wilsford Cum Lake
Salisbury, SP4 7BY

Drawing:
Site
Proposed Site Location Plan

Drawing No: 636/S.03

Scale: 1:250 @ A1
1:500 @ A3

Origination Date: October 2025

Drawn by: ALE
Issued by:
Approved by: ML

- | | |
|--|--|
| ☐ For Approval | ☐ For Comment |
| ☐ For Information | ☒ Tender |
| ☐ Construction | ☐ As Built |

FOUL DRAINAGE
SURFACE WATER DRAINAGE
(*) MARKED UP PLAN JAN 26

© THIS DRAWING IS THE COPYRIGHT OF
MICHAEL LYONS ARCHITECTURE AND
MUST NOT BE COPIED, USED OR
DISCLOSED WITHOUT PRIOR PERMISSION.

THIS DRAWING MUST NOT BE SCALED.
ALL DIMENSIONS ARE TO BE CHECKED ON
SITE BEFORE WORK IS COMMENCED. ANY
DISCREPANCIES ARE TO BE REPORTED
IMMEDIATELY TO THE CONSULTANTS.

