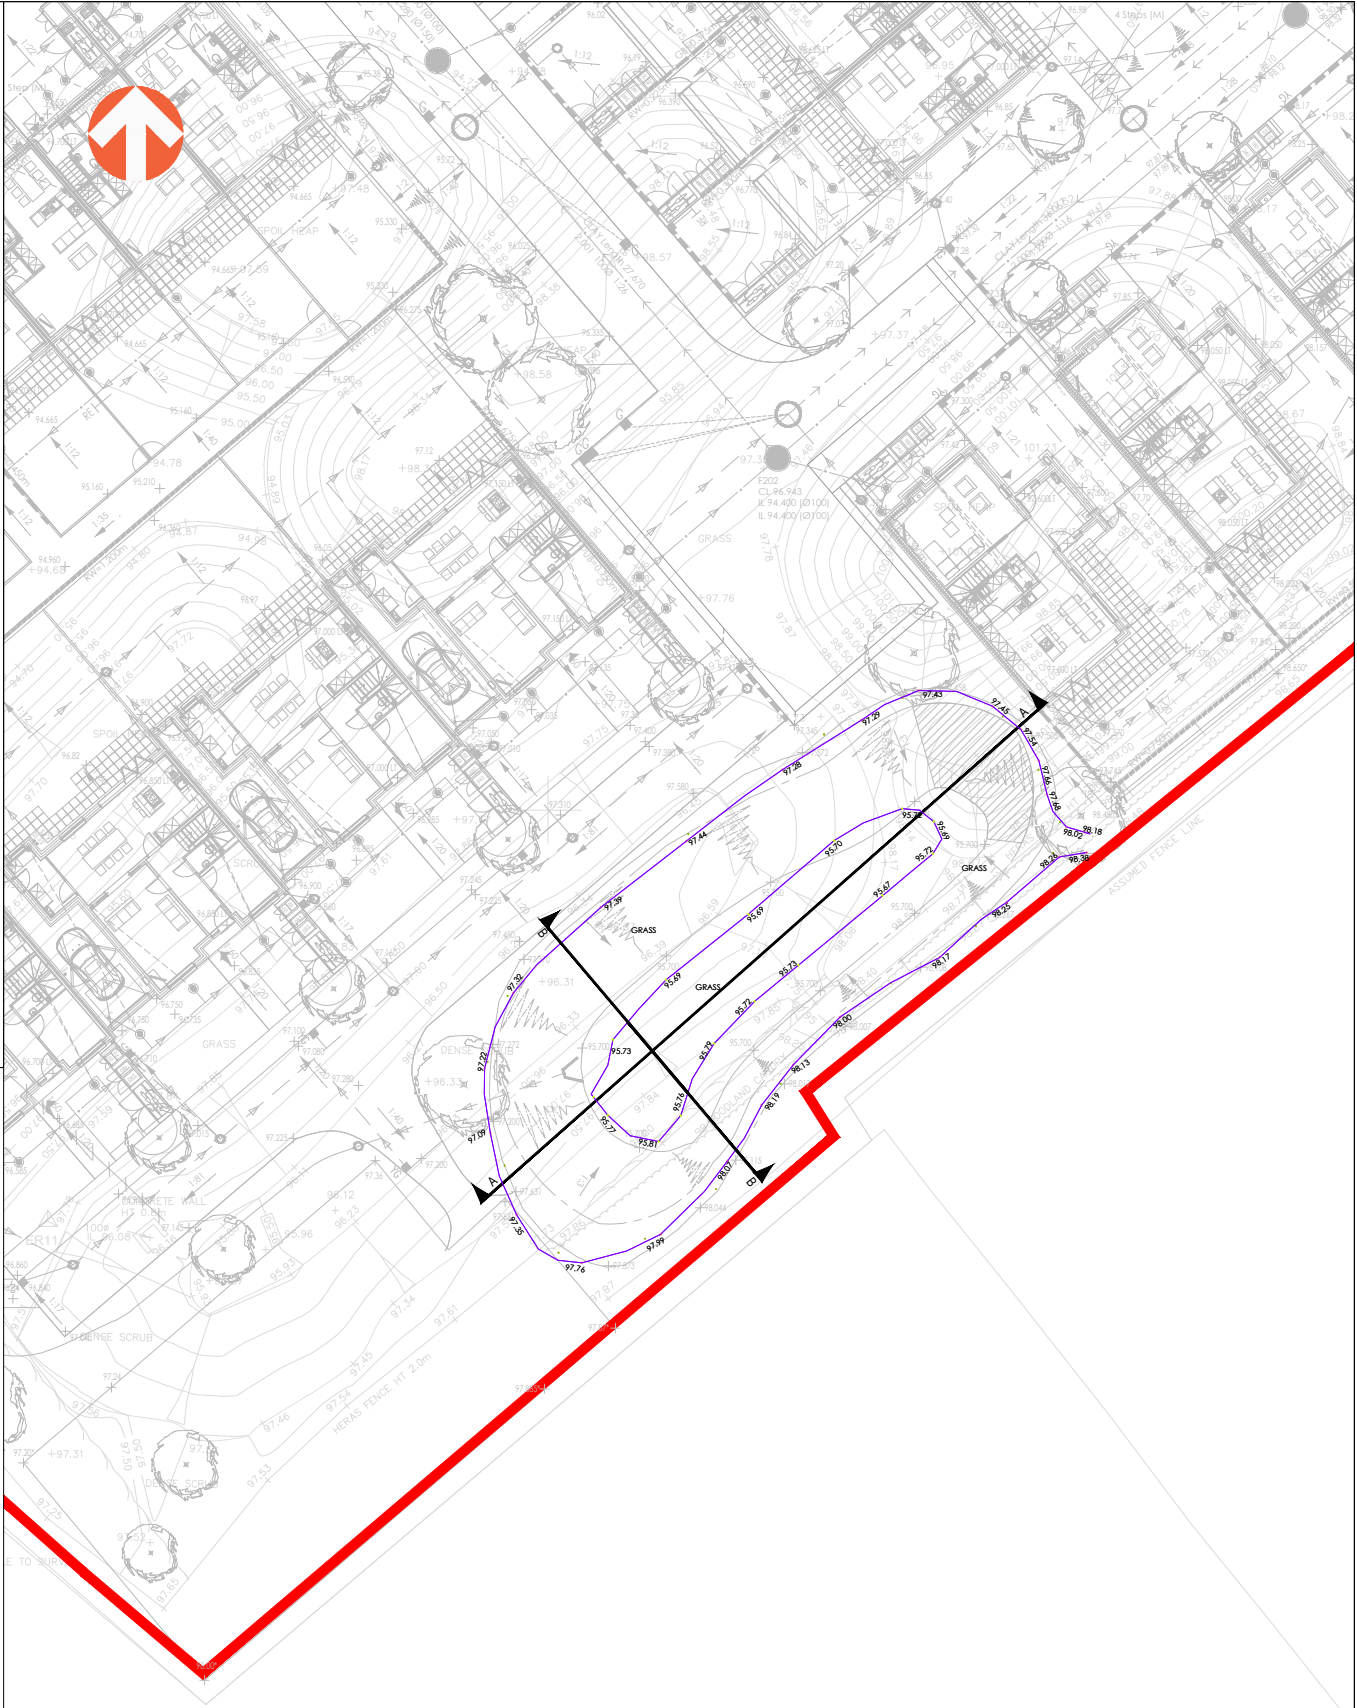
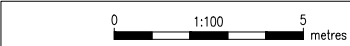
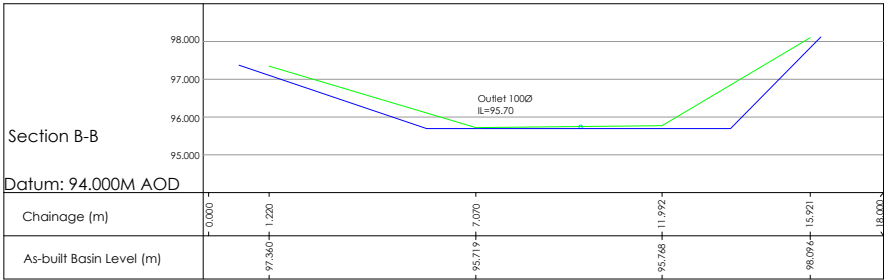
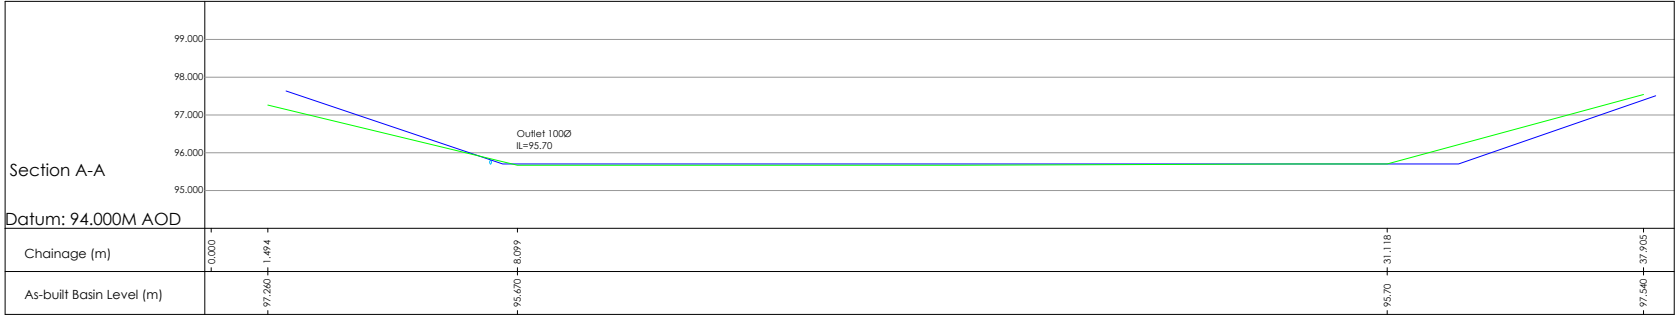


Key

- As-built basin level
- Original design agreed under conditions 5 and 6 of outline planning permission 15/11604/OUT

Proposed basin level taken from as-built Coombs Land Survey Calloway Gardens all ponds

REV	DATE	DESCRIPTION	BY	CHK	APD
C	20.01.2026	KEY UPDATED TO SUIT LATEST COMMENT	JC	CPY	CPY
B	09.01.2026	SECTIONS UPDATED TO SUIT LATEST AS-BUILT	TJS	JBE	GJM
A	07.05.2024	INITIAL ISSUE	MDA	JBE	GJM

CUSTOMER:	BACKHOUSE HOUSING LTD
DRAWING STATUS:	FOR INFORMATION ONLY

PROJECT:	WESTBURY HOSPITAL
TITLE:	BASIN CROSS SECTION PLAN
PROJECT No:	0654
DRAWING No:	03-SK-1101
REV:	C
SCALE @ A1:	AS SHOWN

DESIGN BY:

Awcock Ward Partnership, Ada House, Pynes Hill, Exeter, EX2 5TU
Tel: 01392 409007 Web: www.awpexeter.com