


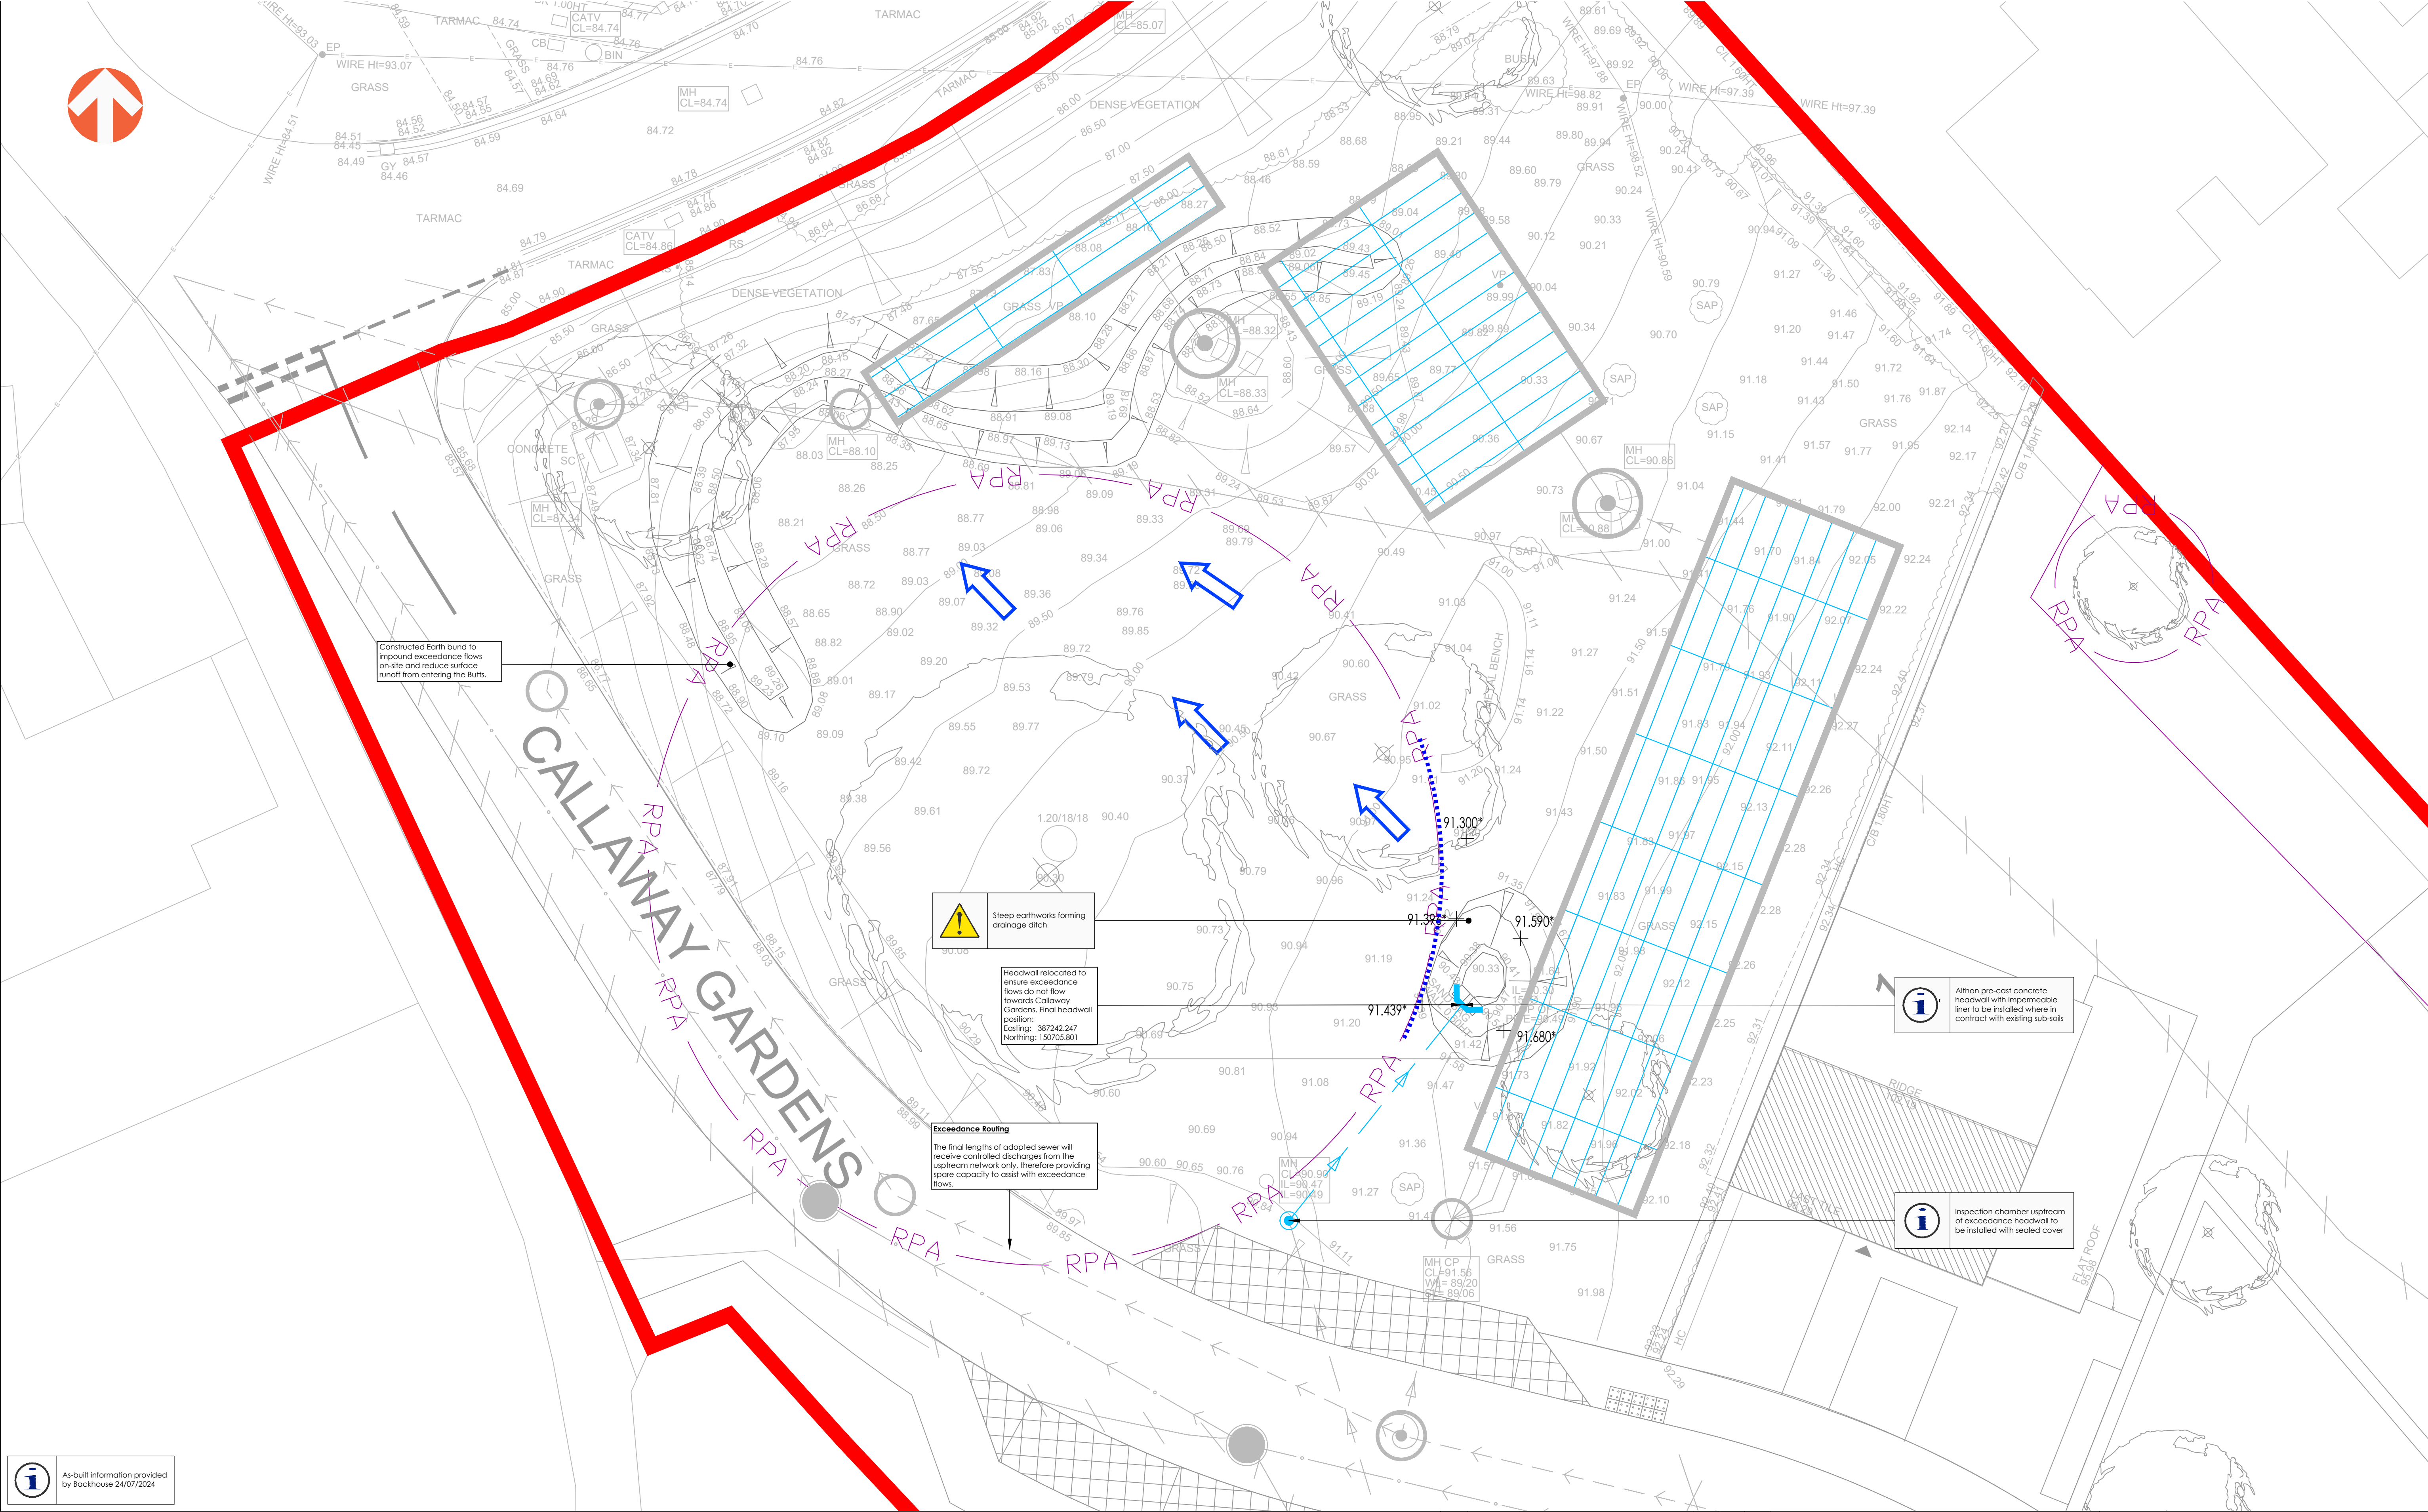

As-built information provided by Backhouse 24/07/2024

Key

SITE INFORMATION

Site boundary

RPA

Roof protection area

EXTERNAL WORKS

Earthworks slope

Root barrier

PRIVATE SURFACE WATER DRAINAGE
(REFER TO PRIVATE DRAINAGE STANDARD DETAILS)

Surface water sewer

Althon headwall

Overland exceedance flood flow rate arrow

D	27.11.2025	MINOR UPDATES	ZC	CPY	CPY	PROJECT:	WESTBURY HOSPITAL			DESIGN BY:	 Awcock Ward Partnership, Kensington Court, Woodwater Park, Pynes Hill, Exeter, EX2 5TY Tel: 01392 409007 Web: www.awppartnership.com	
C	17.02.2025	HEADWALL EASTING & NORTHING COORDINATES ADDED TO DRAWING	MDA	JBE	GJM	TITLE:	HEADWALL RELOCATION PLAN					
B	12.08.2024	UPDATES TO SUIT AN EMAIL RECEIVED FROM BACKHOUSE 06/08/2024	JSH	JBE	GJM	PROJECT No:	0654	DRAWING No:	SK-301	REV:		D
REV	DATE	DESCRIPTION	BY	CHK	APD	CLIENT:			SCALE @ A1:			
						BACKHOUSE HOUSING LTD			0 1:100 5 metres			
DRAWING STATUS:						ISSUED FOR CONSTRUCTION						