




007 - BARN 1 - Existing Elevations

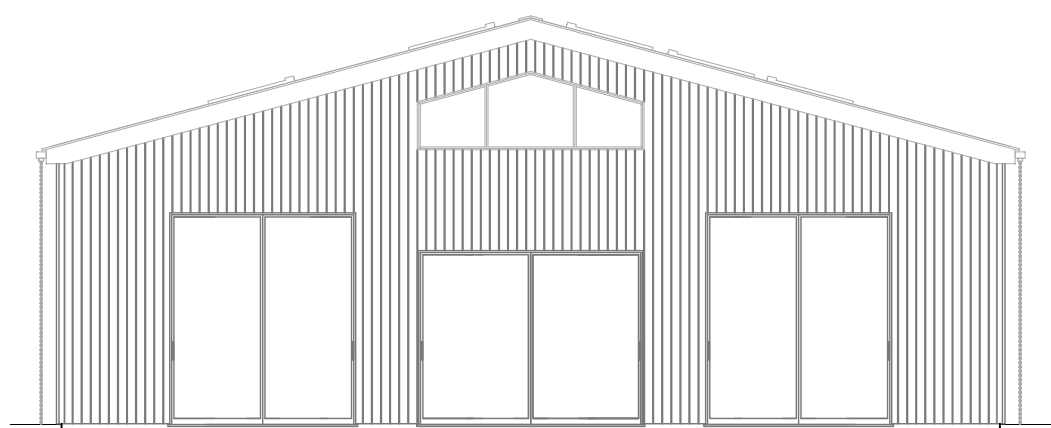


East Elevation

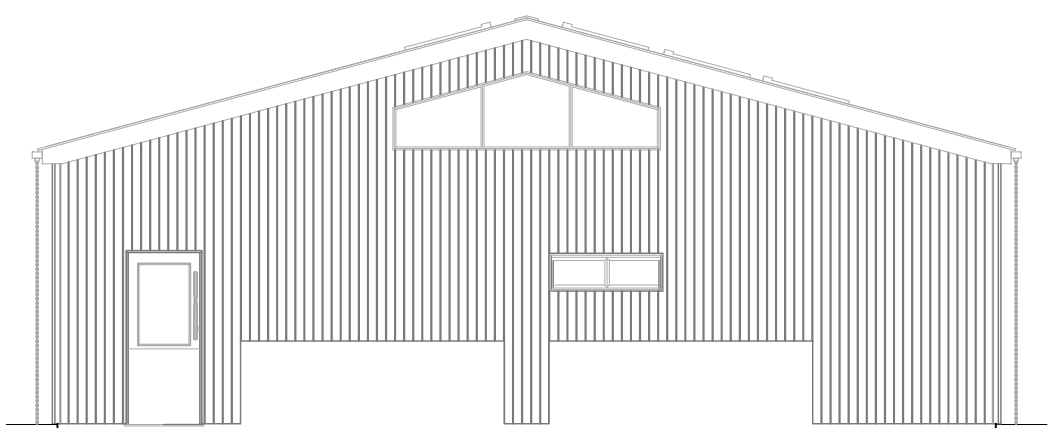


West Elevation

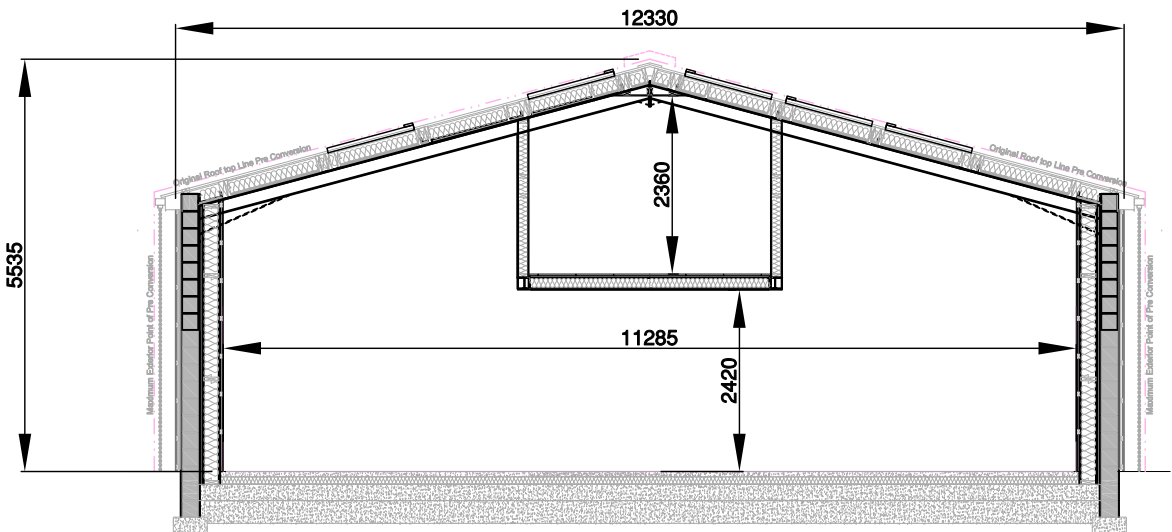


Section Through East End of Building

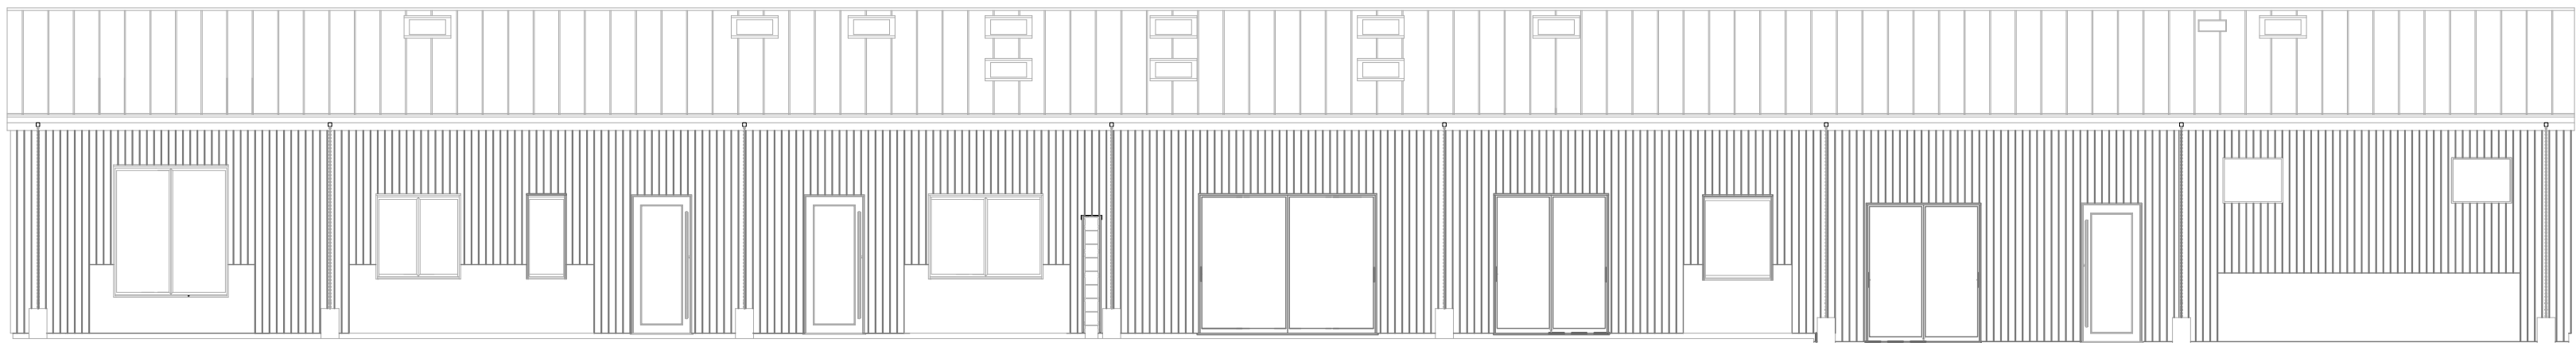

South Elevation

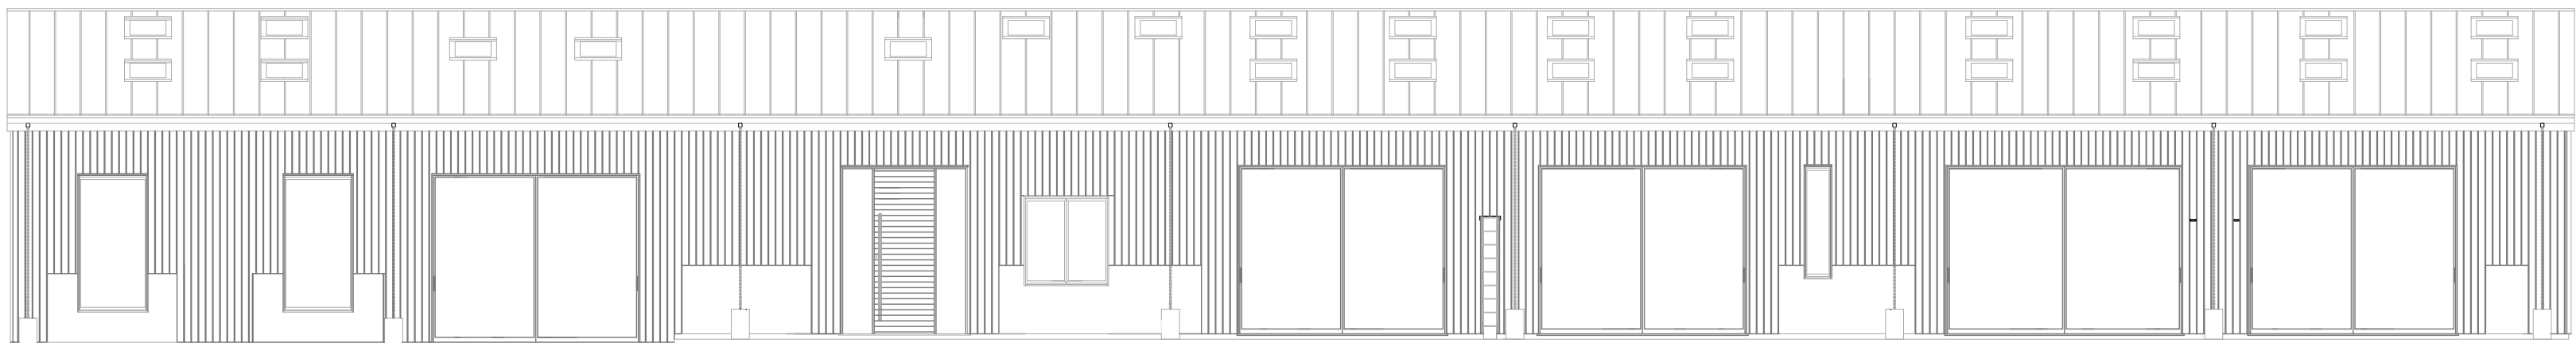

North Elevation

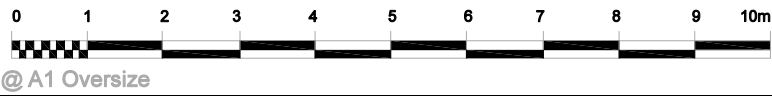

@ A1 Oversize

ABA Construction Limited			
Unit Chestnut, Dixons Buildings, Membury Airfield Industrial Estate, Lambourn Woodlands, Berkshire, RG17 7 T.J. Email: david@ard-ltd.co.uk tel: 07798 687306			
Site Address: Fairholme Farm, Dog Trap Lane, Upper Minety, Wiltshire, SN16 9PW			
Drawing Title: Elevation Views to Barn 1 - Units 1 to 3 - As Built			Scale: 1 to 50
DA	Drawn By:	Issue:	Date:
		1	07/07/2023
		2	14/11/2023
Notes: Detail showing exact sizes Plots 1 to 3 Minor amendments after remeasure.			