


BARN 1 - Ground Floor Internal Plan - As Built - Unit 3




Unit 3- Floor Area 270.3 Mtr Sqr

010 - Unit 3
Proposed Ground Floor Layout

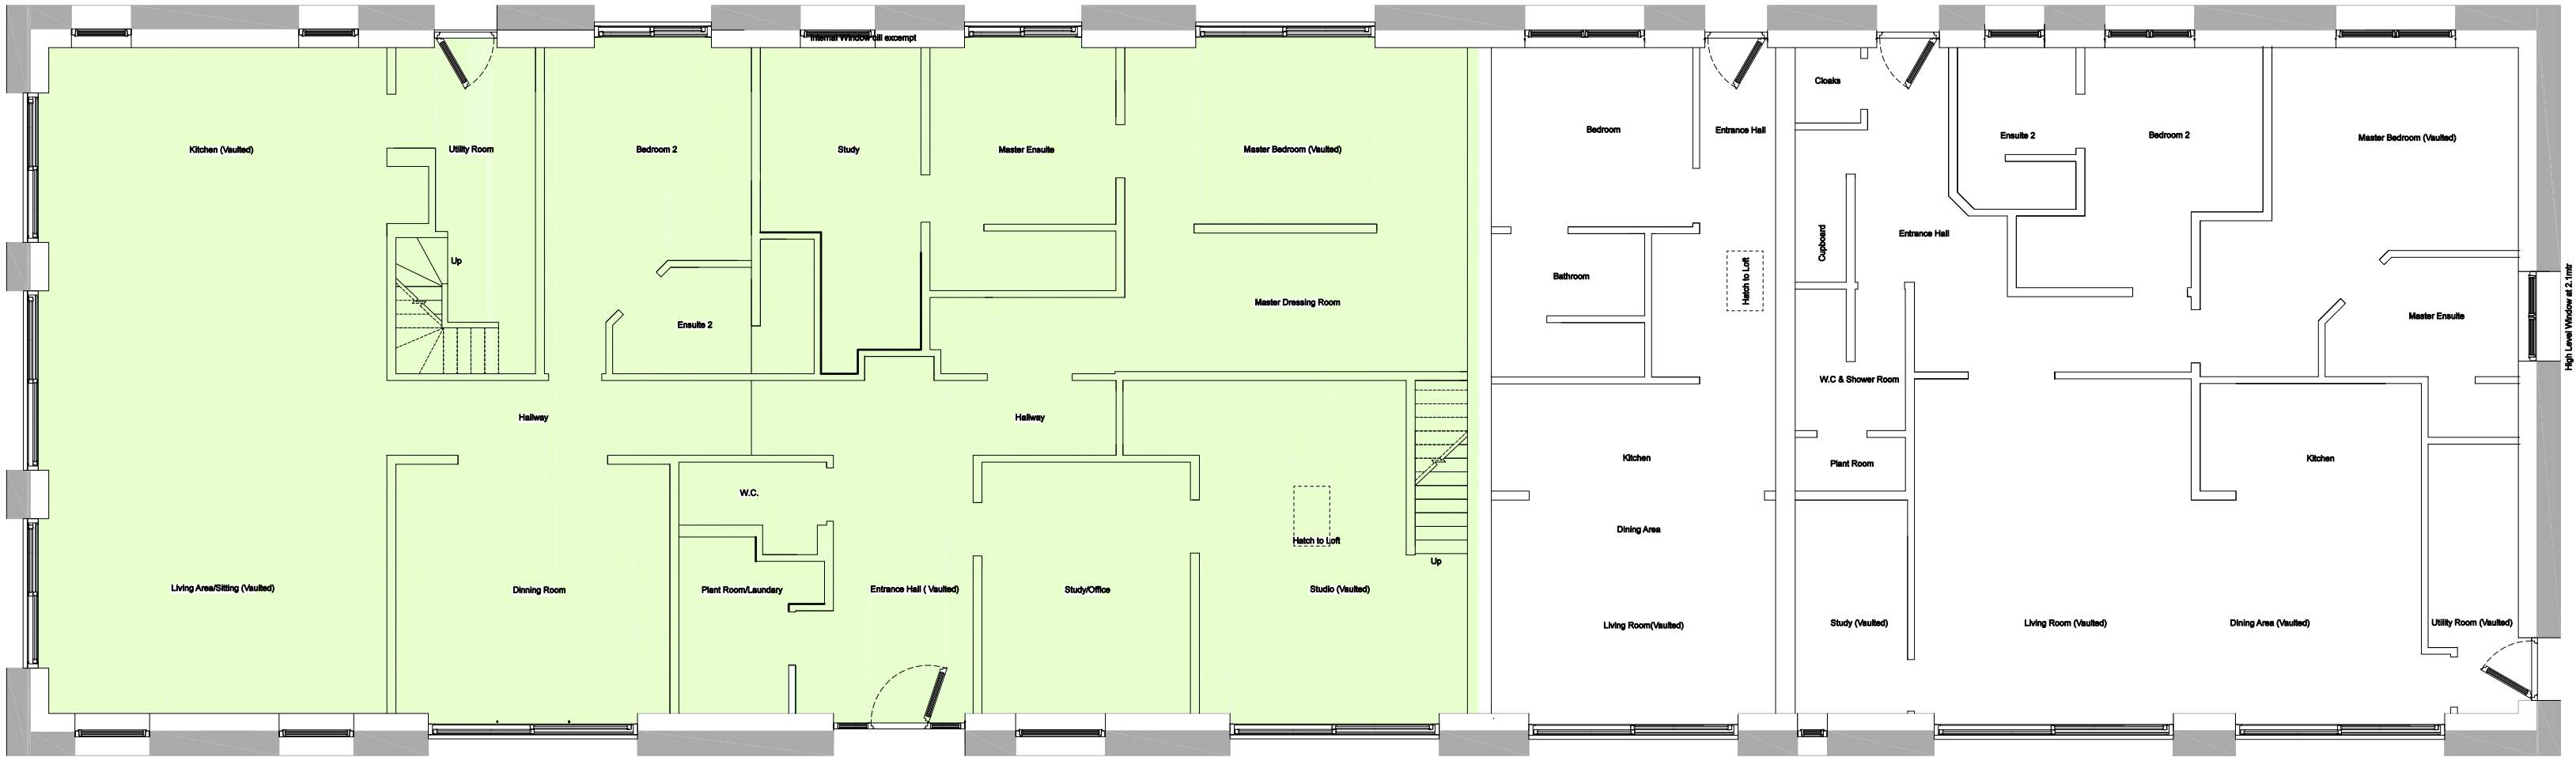


All measurments taken in strict accordance with RICS Code of Measuring Practice - 6th Edition

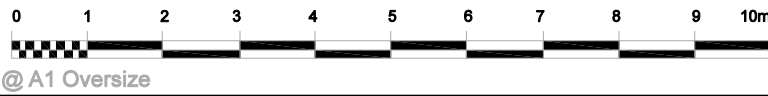

@ A1 Oversize

ABA Construction Limited			
Unit Chestnut, Dixons Buildings, Membury Airfield Industrial Estate, Lambourn Woodlands, Berkshire, RG17 7 T.J. Email: david@ard-ltd.co.uk tel: 07798 687306			
Site Address: Fairholme Farm, Dog Trap Lane, Upper Minety, Wiltshire, SN16 9PW			
Drawing Title: 003 - Ground Floor As Built to Barn 1 - Units 3			Scale: 1 to 50
DA	Issue:	Date:	Notes: Detail showing exact sizes Plots 1 to 3 Minor amendments after remeasure.
	1	07/07/2023	
	2	14/11/2023	


BARN 1 Proposed Mezzaine Internal Plan - Unit 3

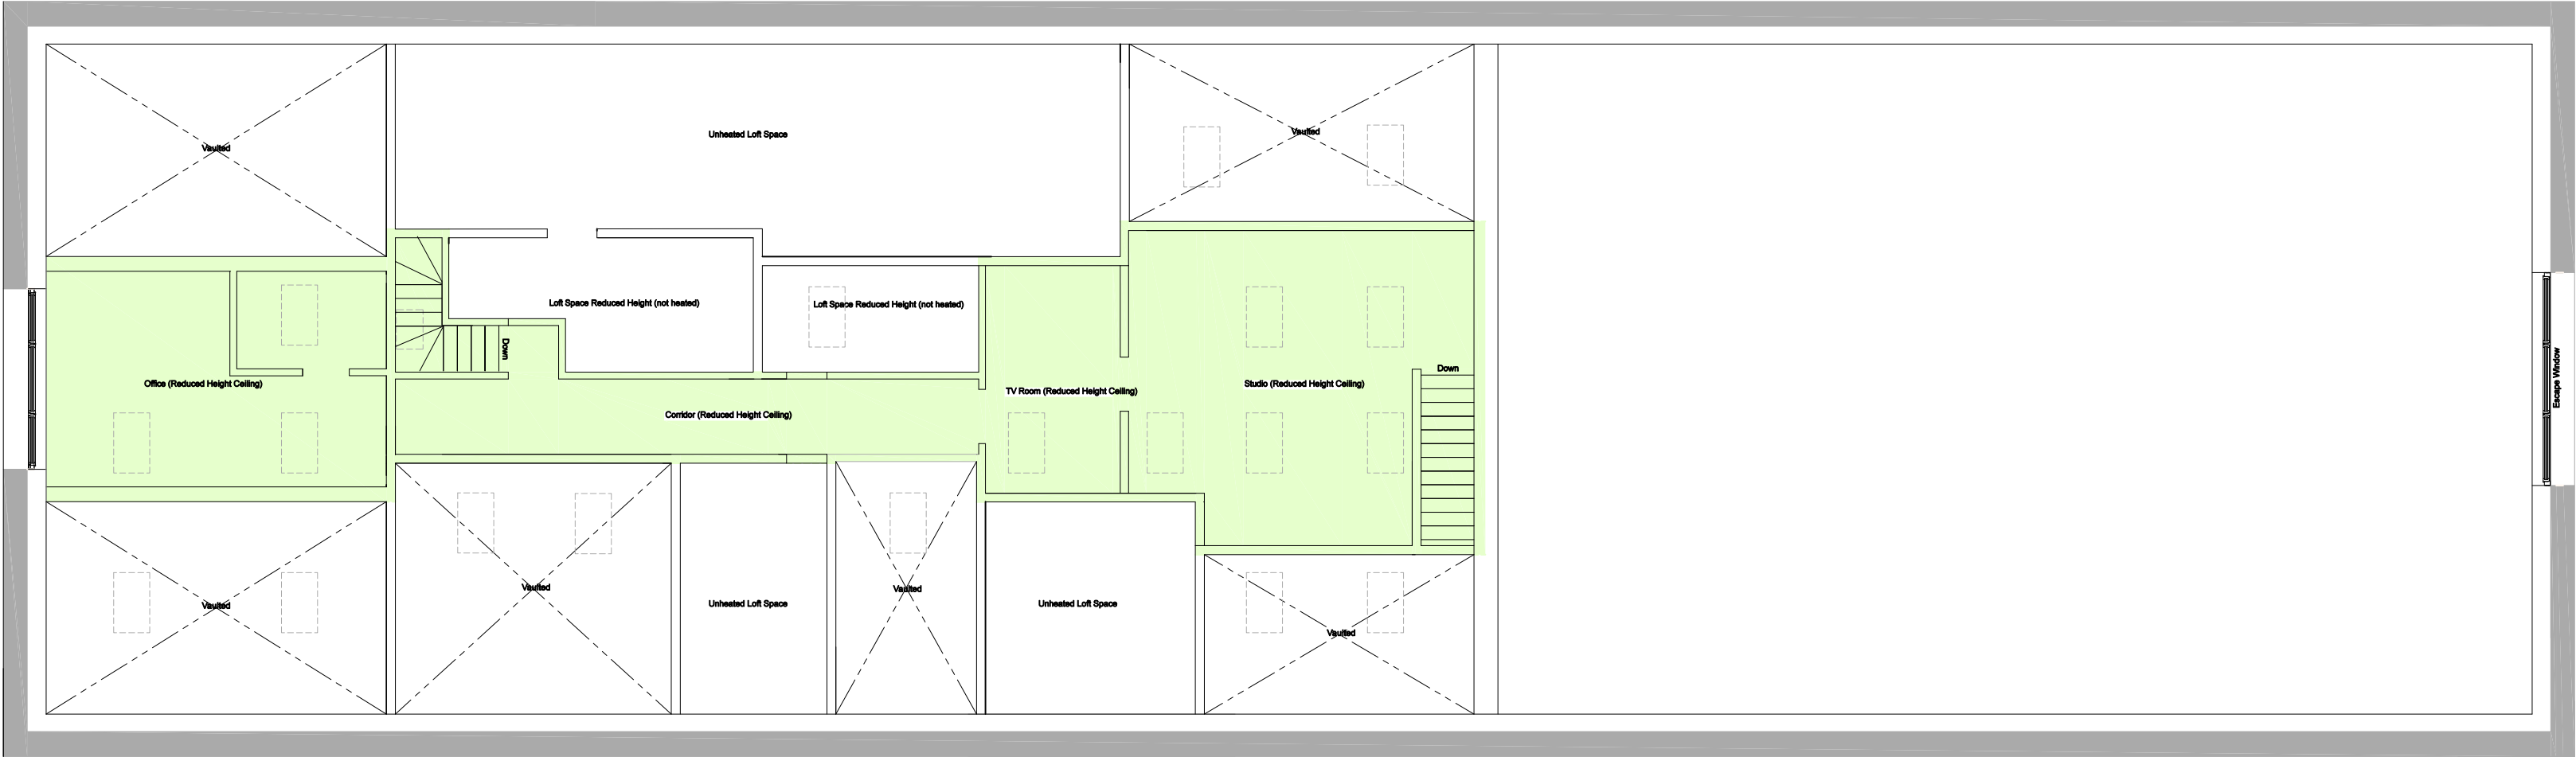

Unit 3 Mezzanine GIA 84.1 Mtr Sqr
Window Surface Area (inc Rooflights) = 8.5mtr² - 10 %

011 - Unit 3
Proposed First Floor Layout


All measurments taken in strict accordance with RICS Code of Measuring Practice - 6th Edition

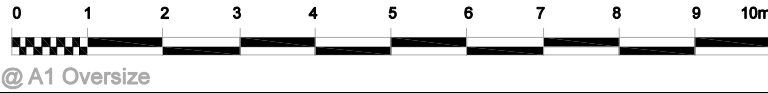

@ A1 Oversize

ABA Construction Limited			
Unit Chestnut, Dixons Buildings, Membury Airfield Industrial Estate, Lambourn Woodlands, Berkshire, RG17 7 T.J. Email: david@ard-ltd.co.uk tel: 07798 687306			
Site Address: Fairholme Farm, Dog Trap Lane, Upper Minety, Wiltshire, SN16 9PW			
Drawing Title: G A - Proposed Mezzanine floor Plan to Barn 1 - Unit 3			Scale: 1 to 50
DA	Issue:	Date:	Notes:
	1	07/07/2023	Detail showing exact sizes Plots 1 to 3
	2	14/11/2023	Minor amendments after remeasure.