


NOTES
All dimensions must be checked on site and not scaled from this drawing.

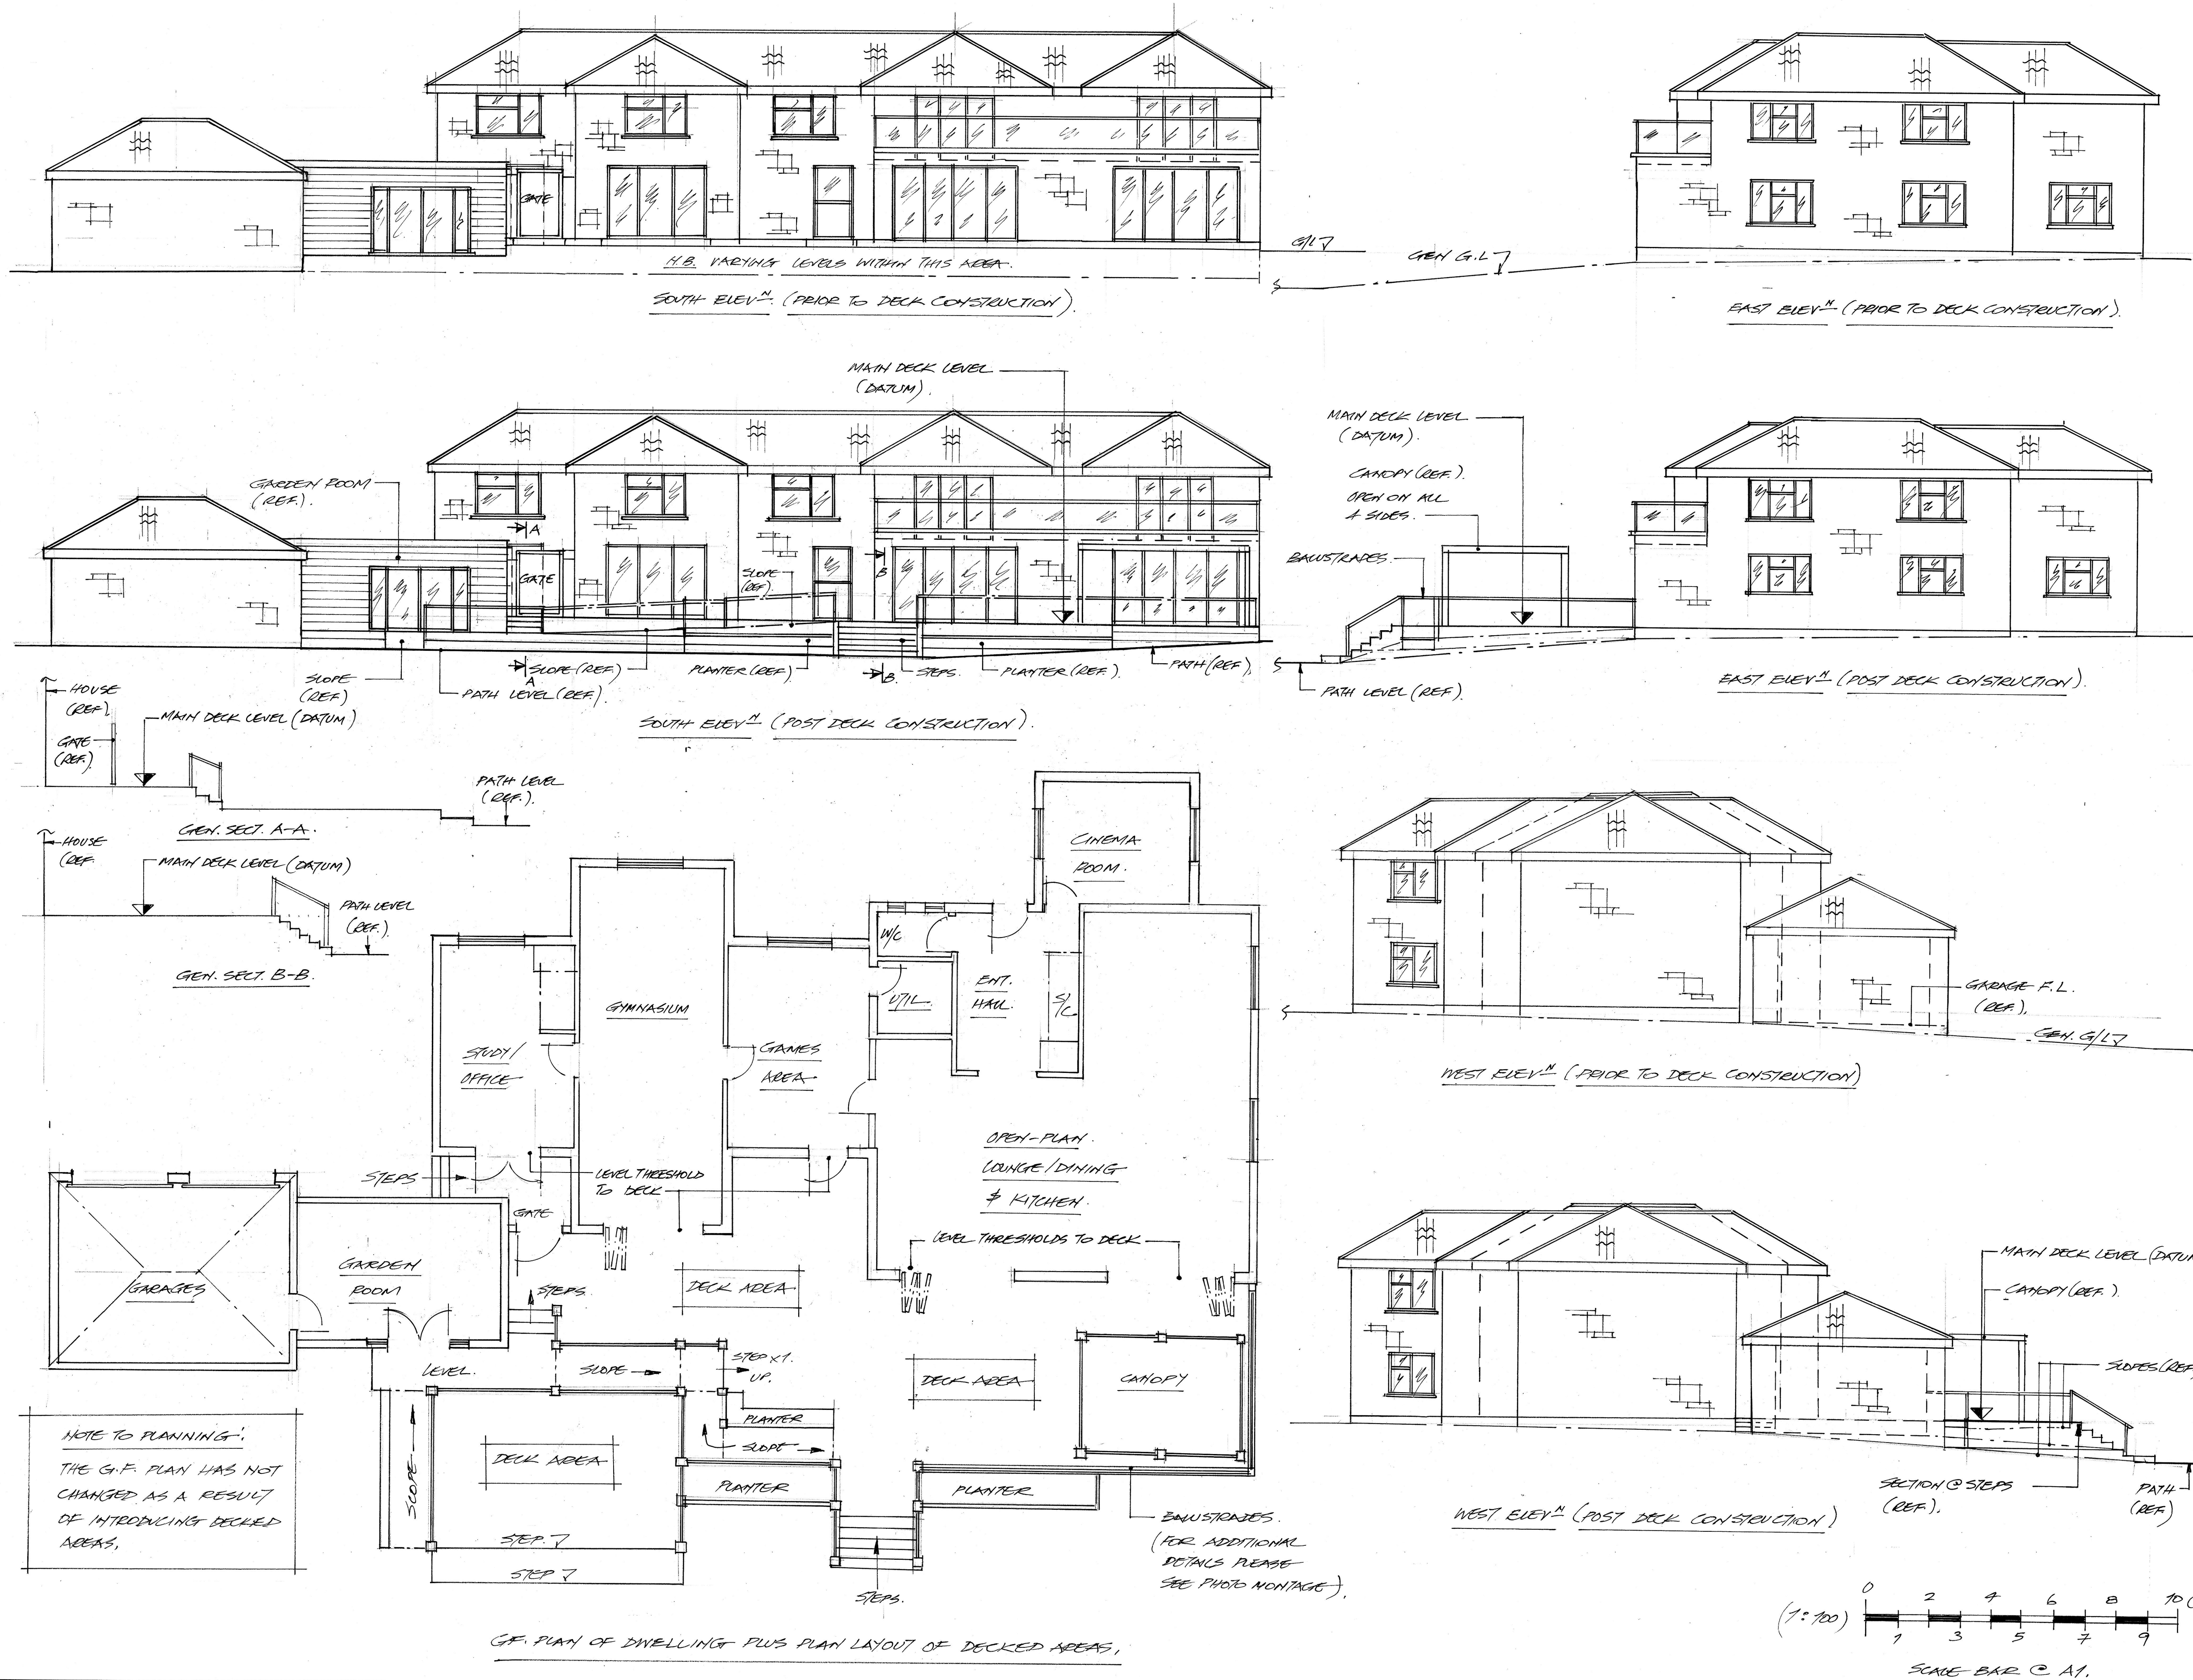

E	Date	Revisions
D		
C		
B		
A		

© copyright
PLANNING NOTE:
THIS DRAWING HAS BEEN PREPARED TO SEEK REGULARISATION FOR THE DECKED AREA & CANOPY AS CONSTRUCTED AT THE SUBJECT PROPERTY.

Client
MR. P. CARTER.

Job Title
PLANNING REGULARISATION FOR DECKED AREA TO REAR OF PROPERTY KNOWN AS: 'THE RECTORY' BRINKNORTH WILTSHIRE SN15 5AF.

Drawing Title
• ELEVATIONS & PLAN LAYOUT
• GEN. SECTIONS.

Scale
1:100.

Date
FEB 2026

Drawn by
DJC

Drg. No.
DCD 26/02/10

Rev.
—