


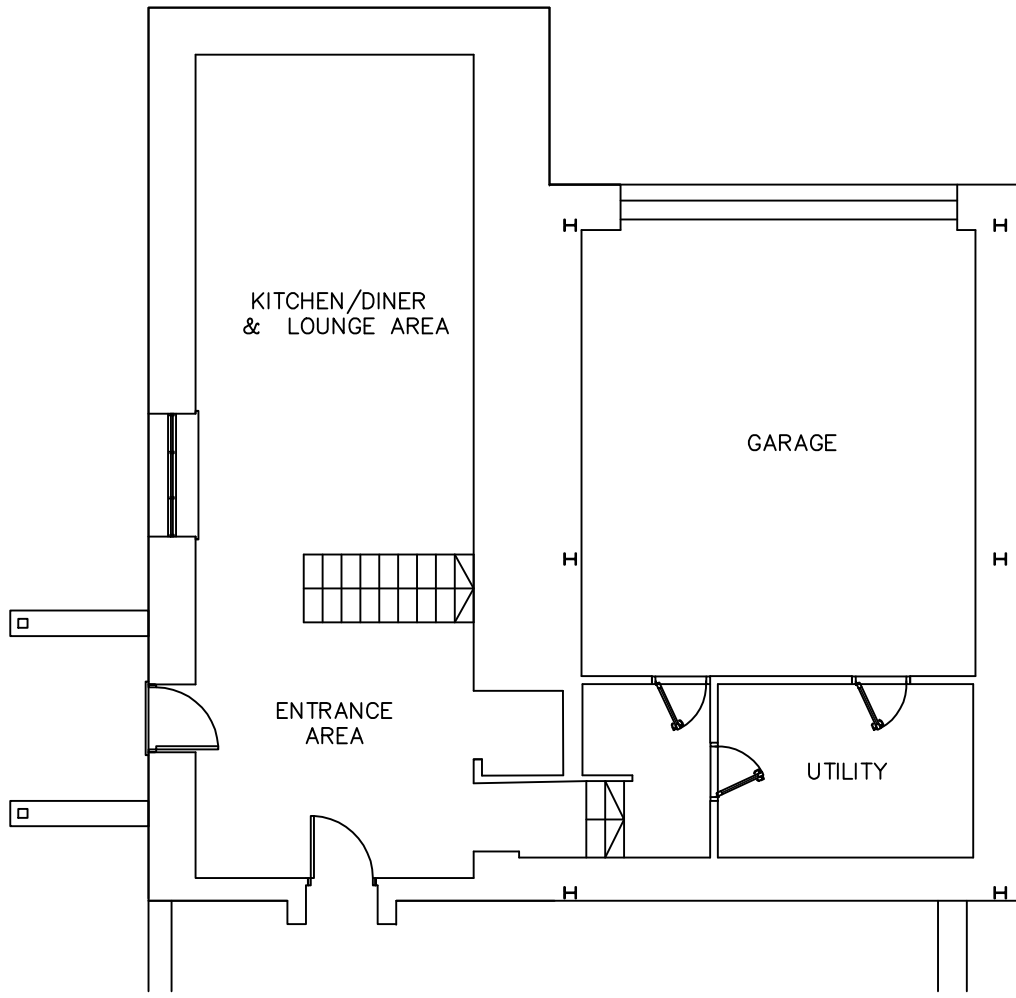
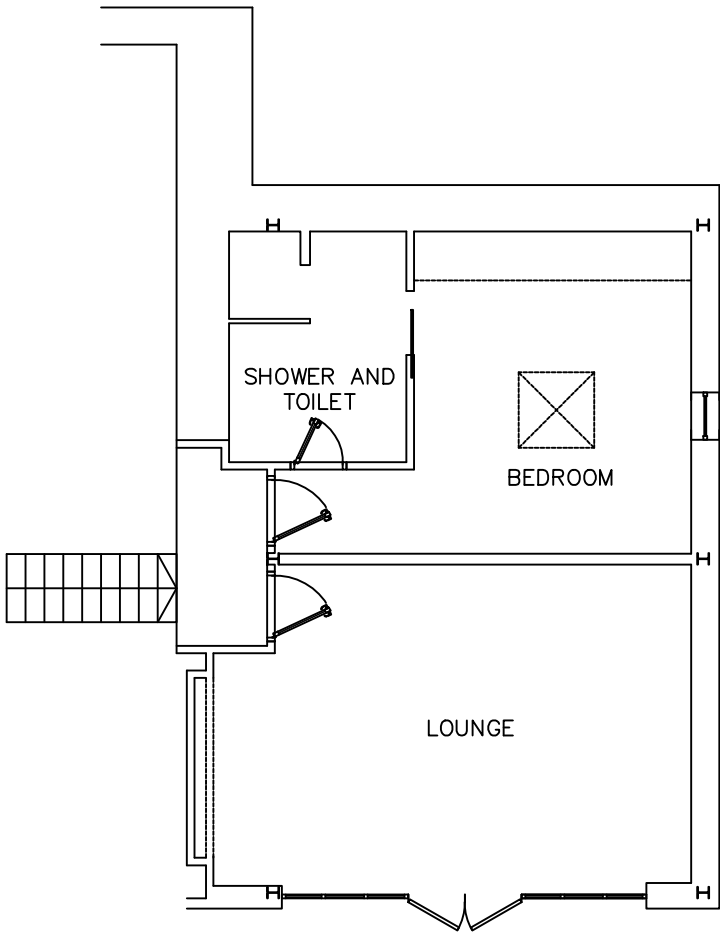
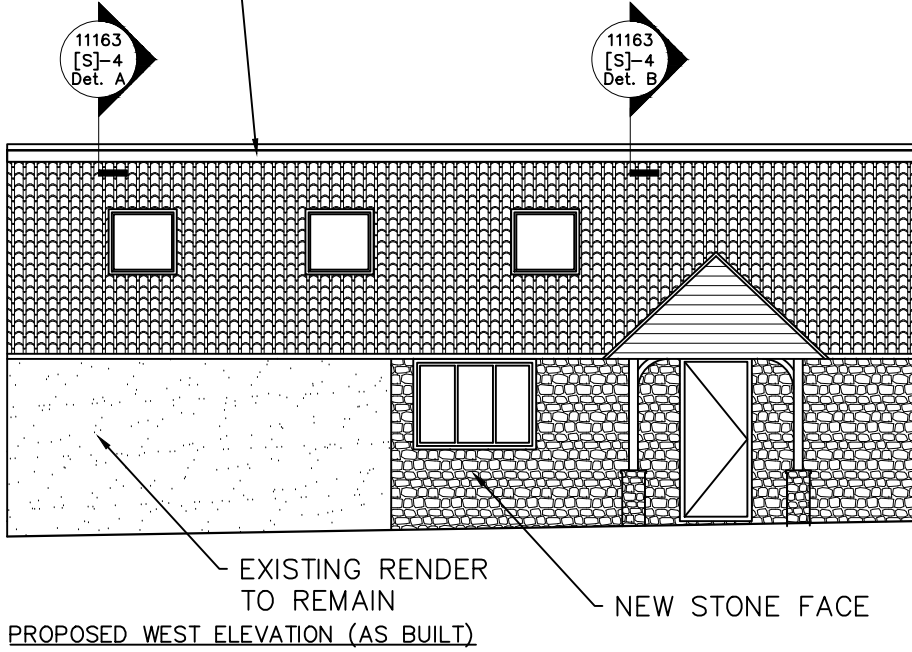


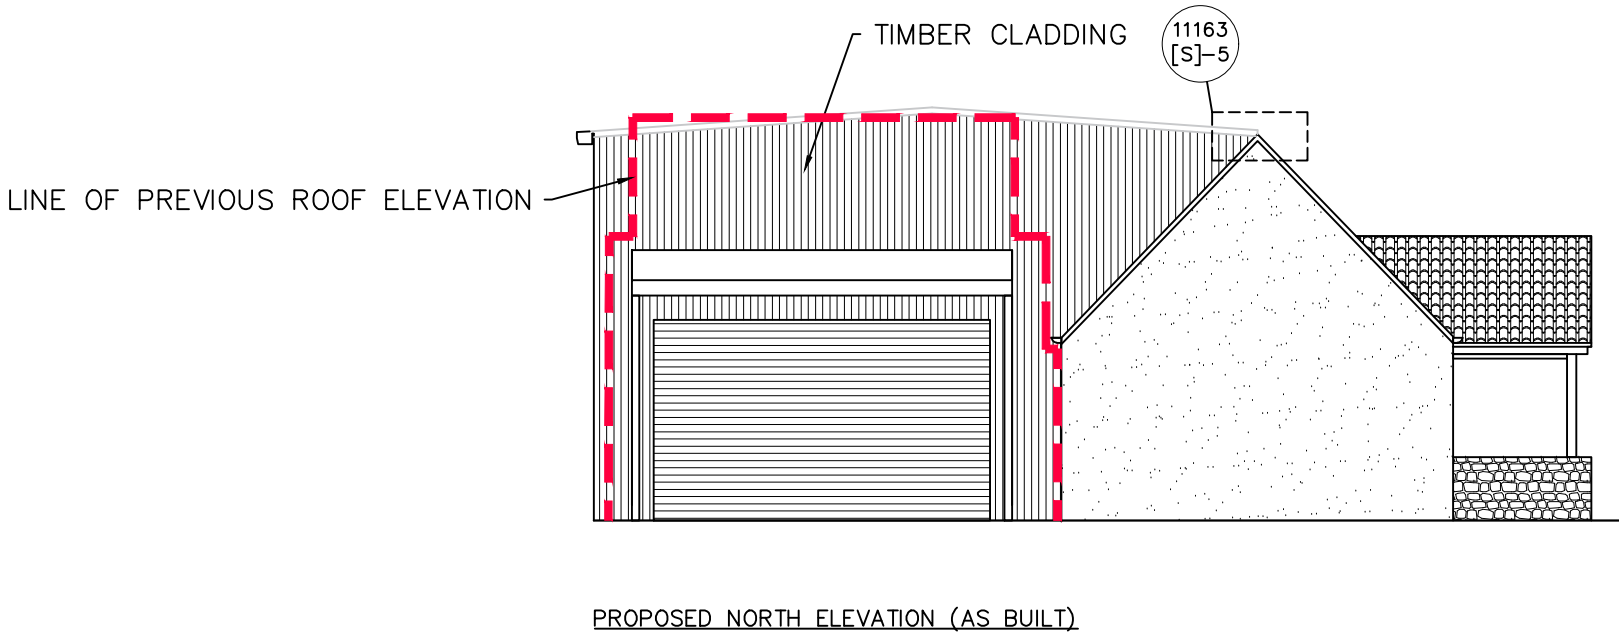

GROUND FLOOR PLAN (AS BUILT)

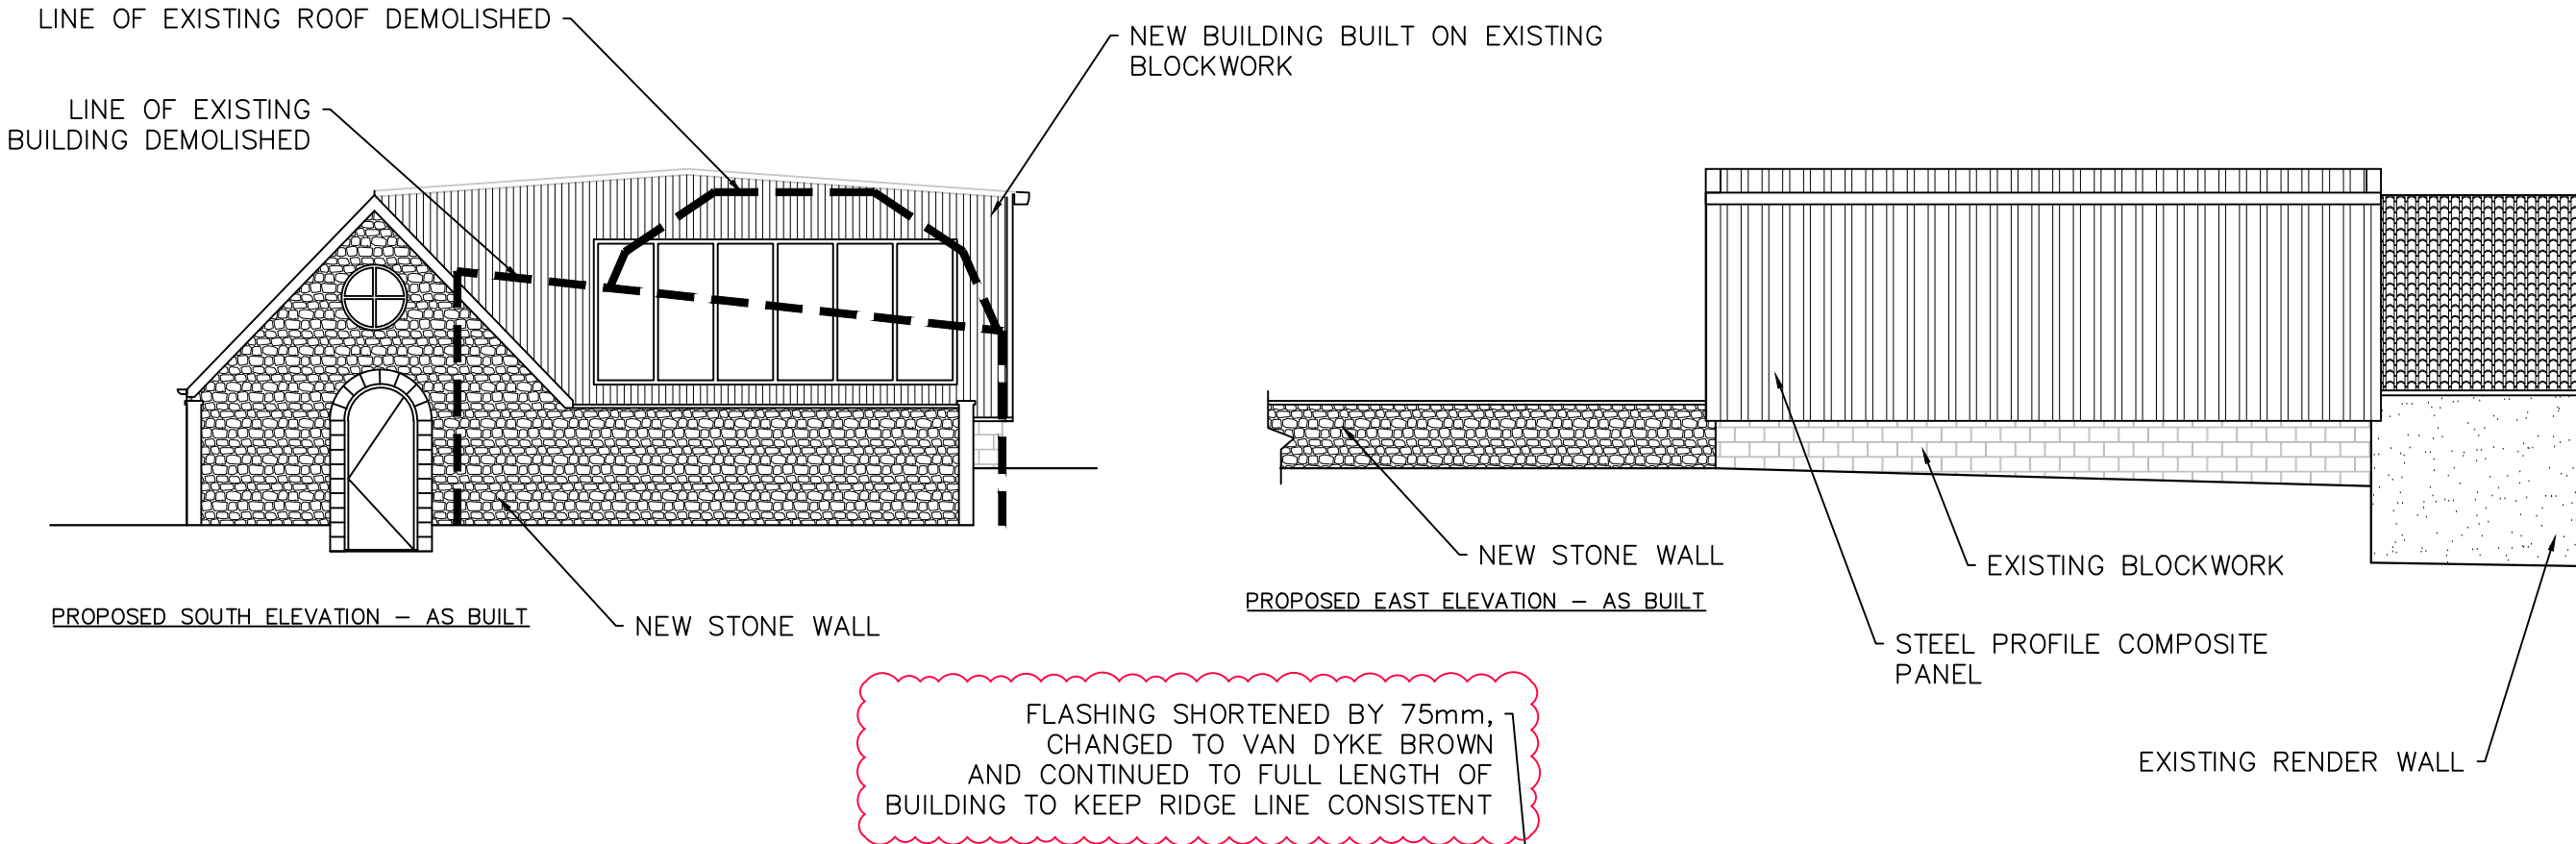

FIRST FLOOR PLAN (AS BUILT)

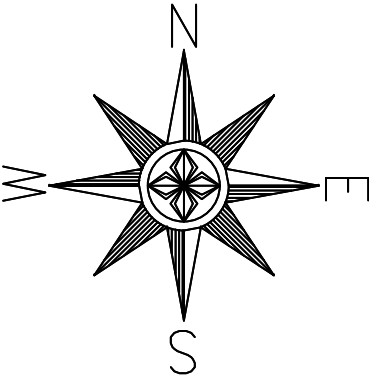

Rev No.	Revision Note.	Date	Drawn	Checked

NUMBER - REV - CLIENT - PROJECT
00480-01 - F - Forge Lee - Conversion

TITLE
Plans & Elevations - As Built

DATE
20.10.24

SHEET
02

SCALE
1:100

DRN BY
CJB

CHK BY
VW

PAPER SIZE
A2

E&C Engineering Ltd
BOURNE WORKS
COLLINGBOURNE DUCIS
MARLBOROUGH
WILTSHIRE
SP8 3EH
Tel: 01264 850791
Email: vicwheeler75@gmail.com