




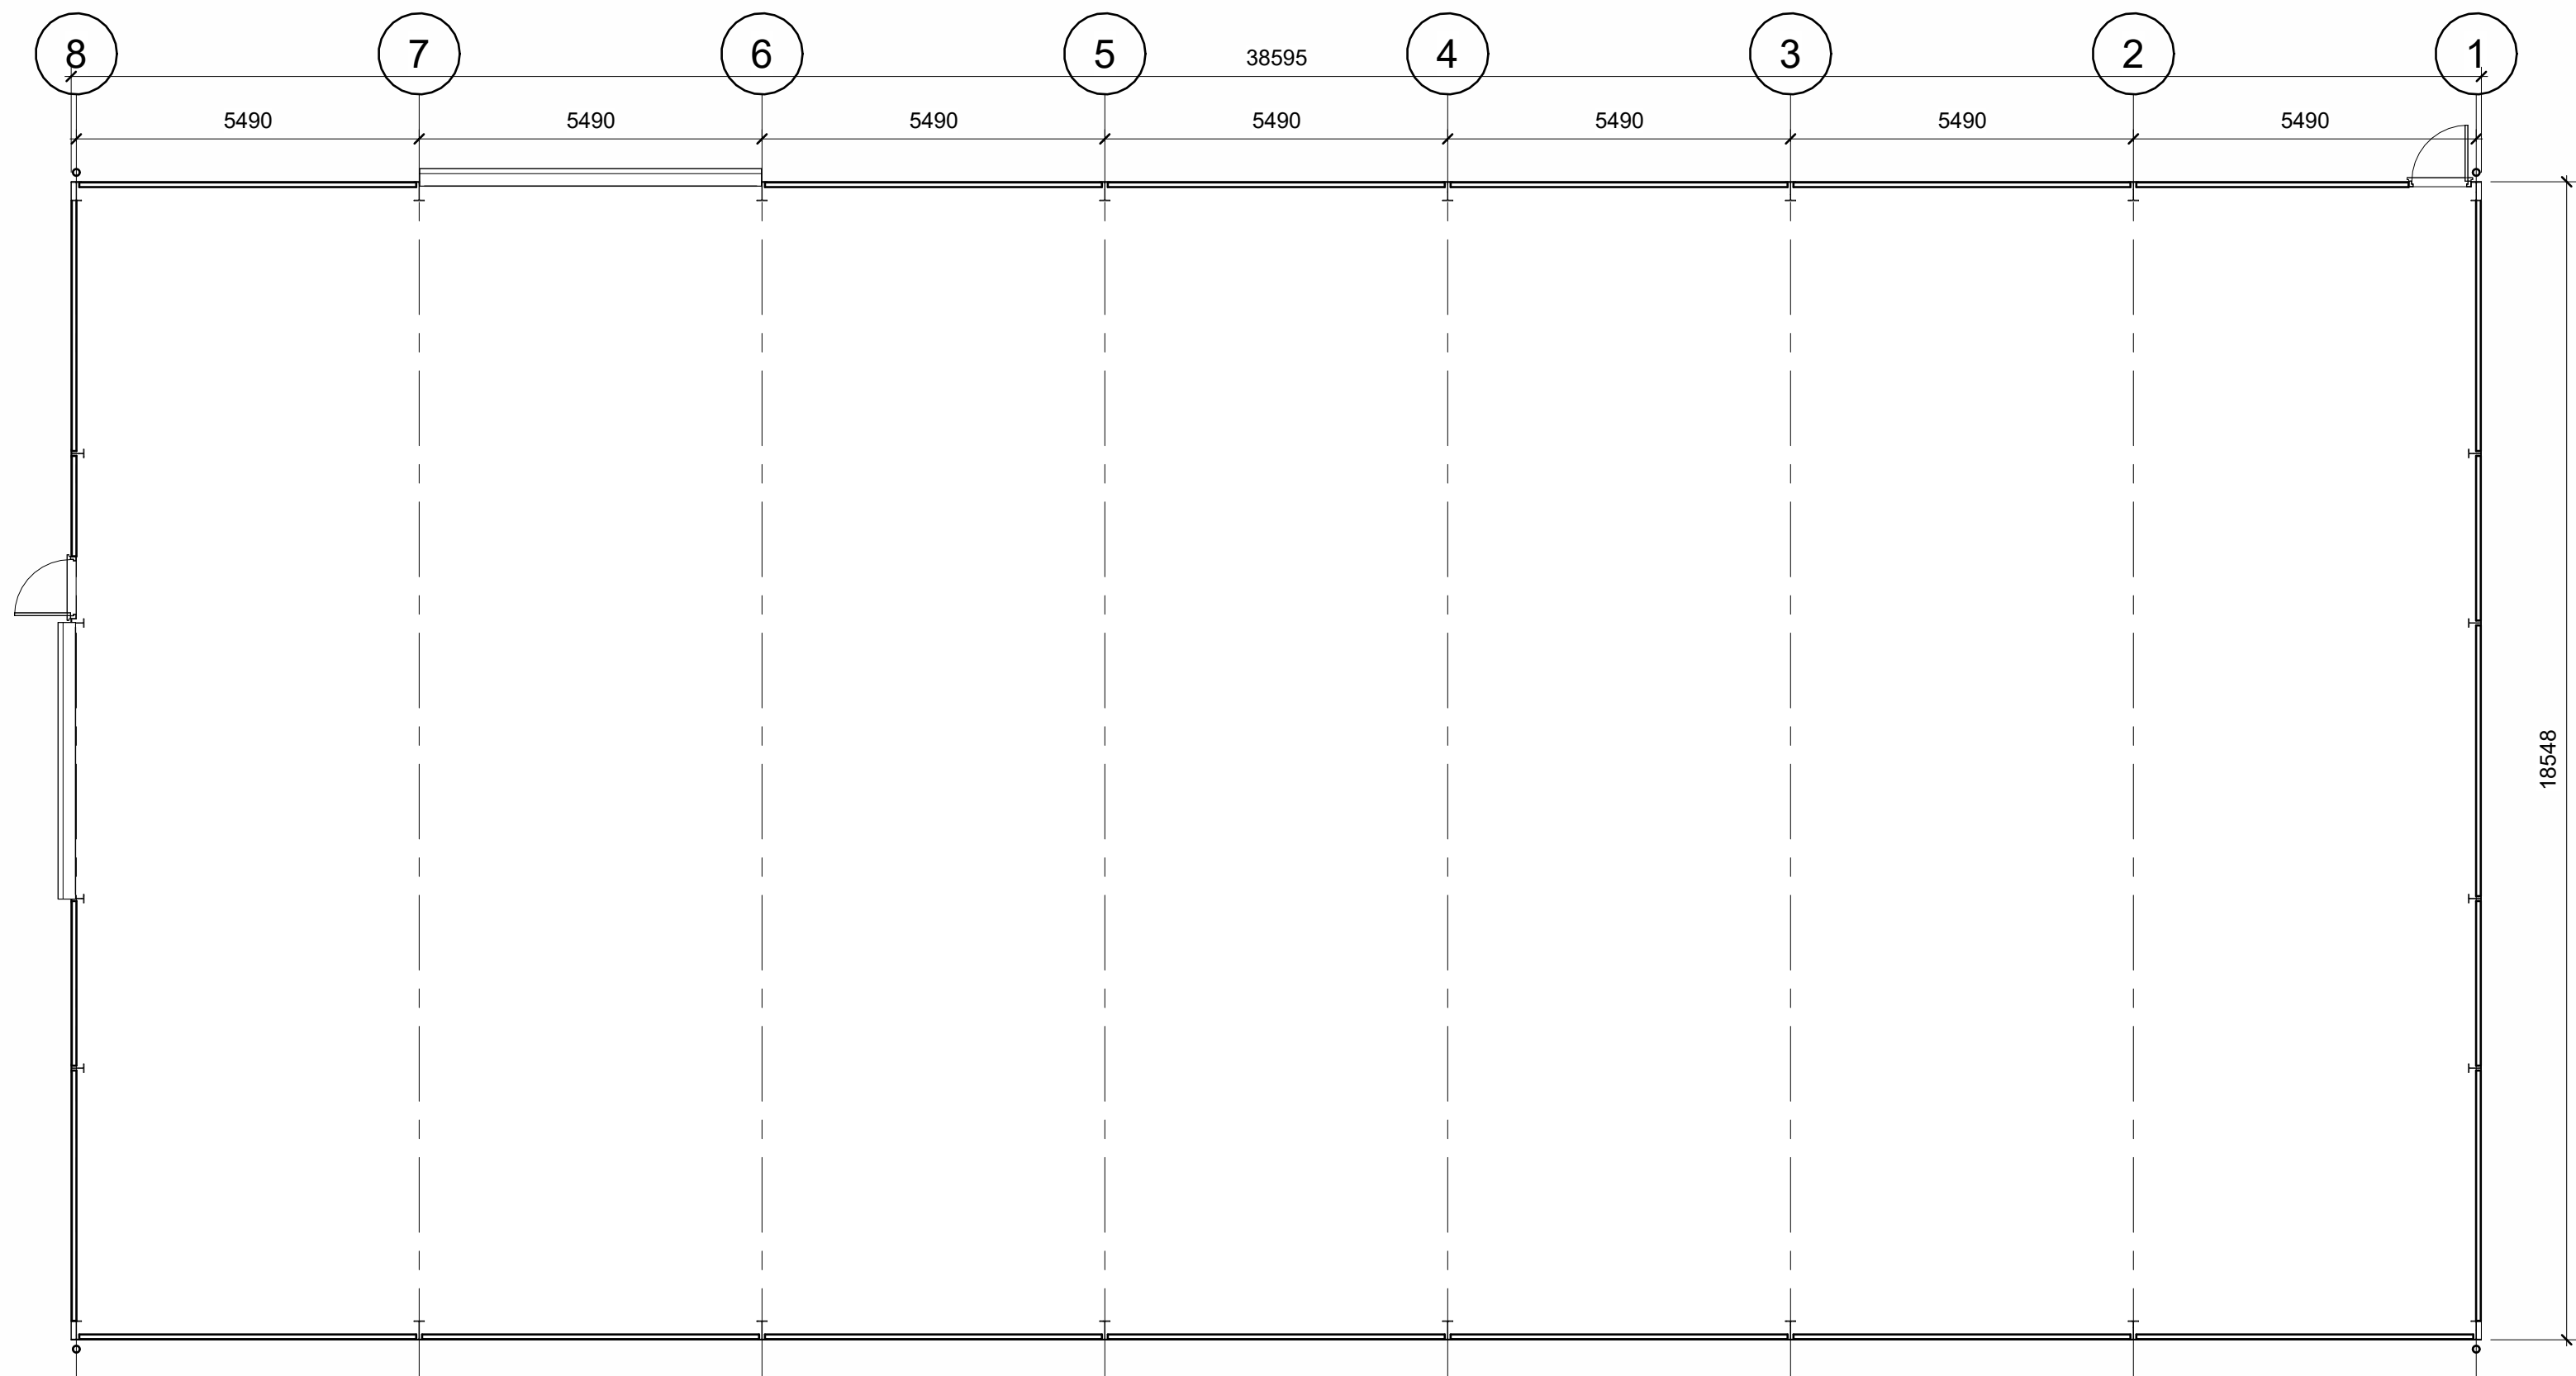

Level 1 - Ground Floor - Existing
1 : 100

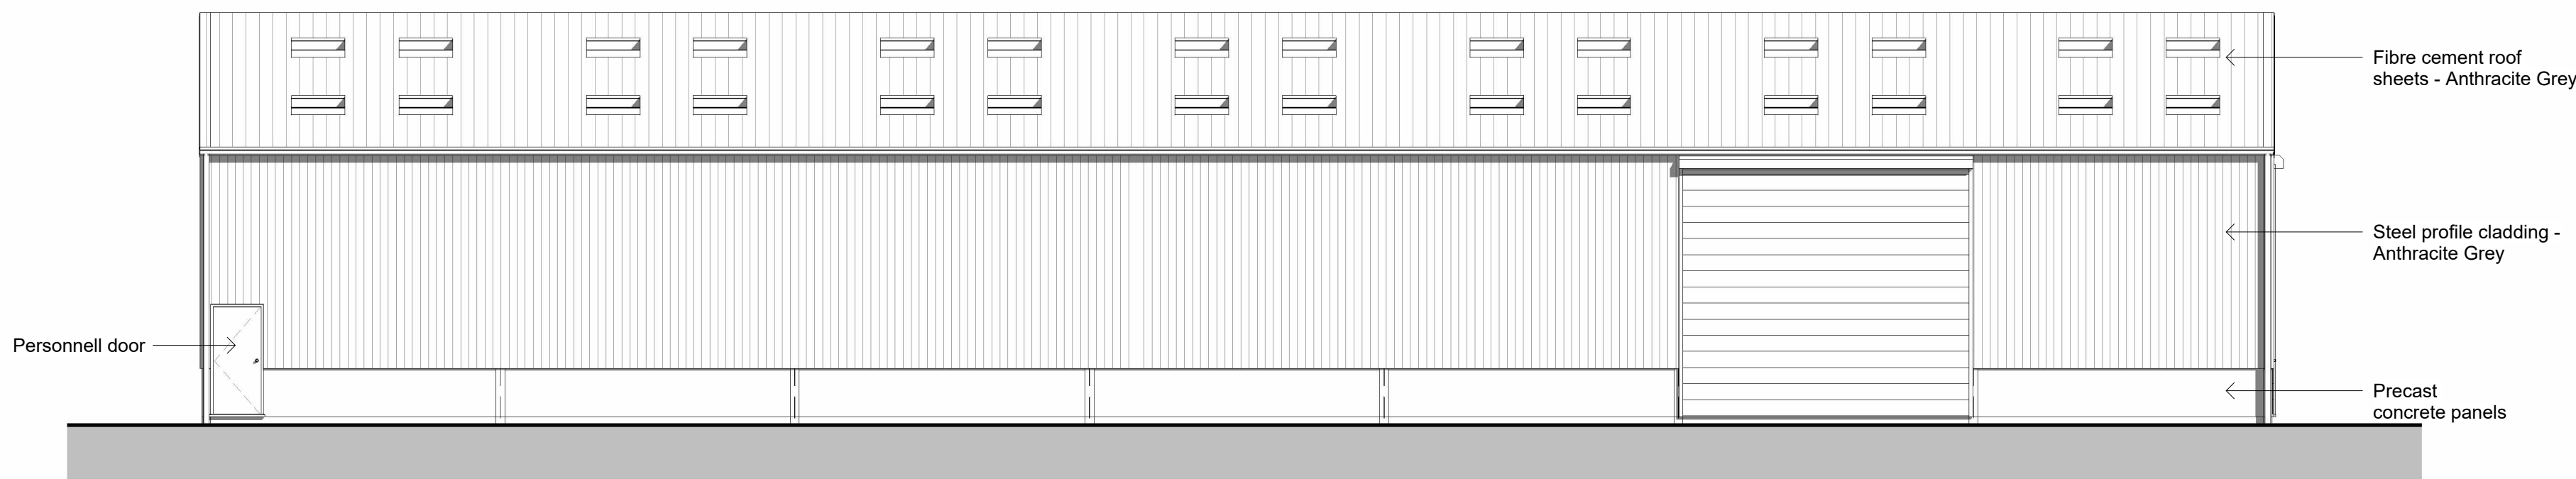


North - Existing
1 : 100

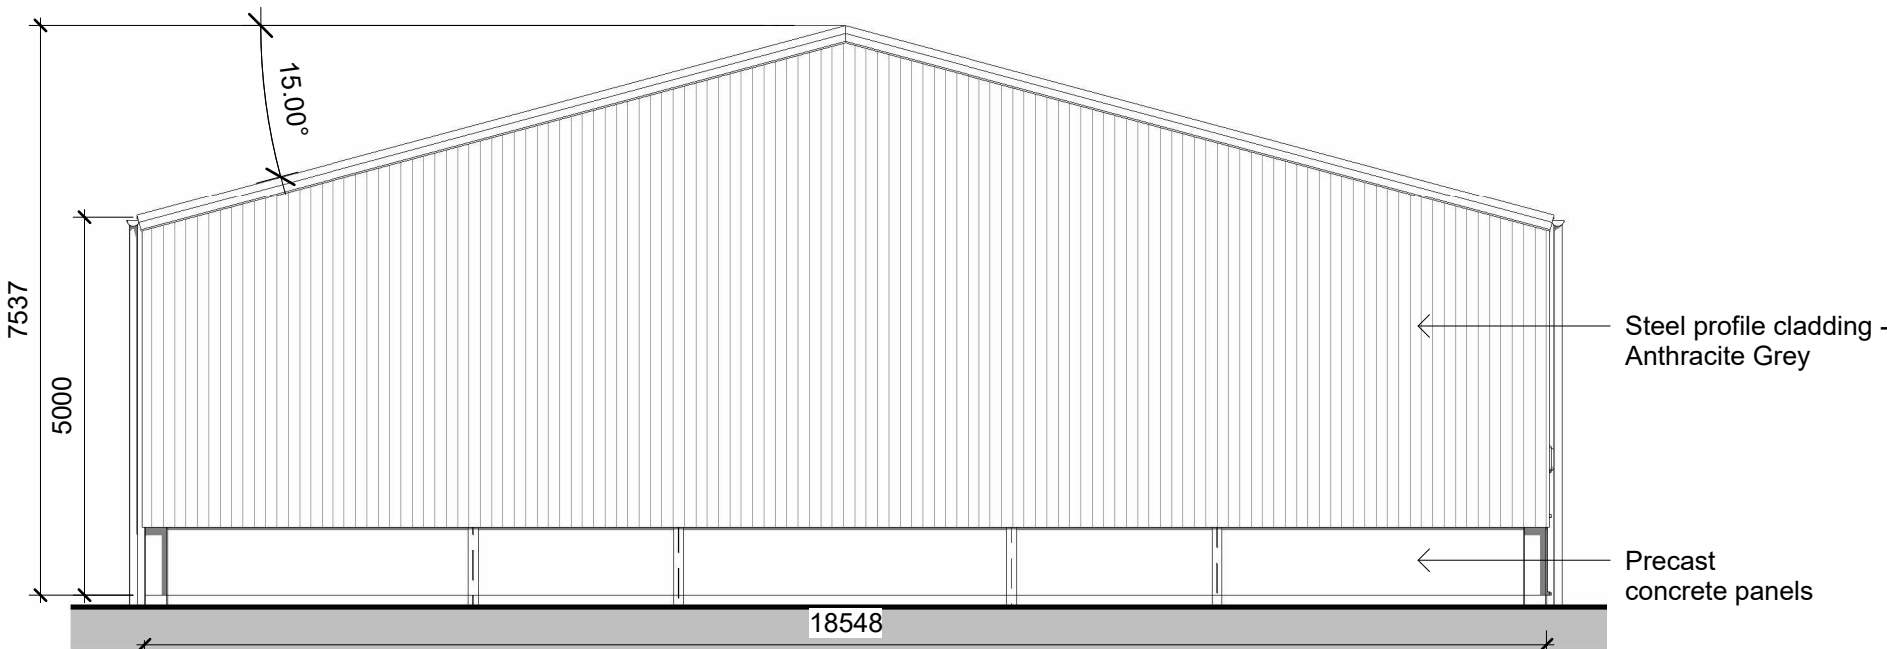


East - Existing
1 : 100



South - Existing
1 : 100

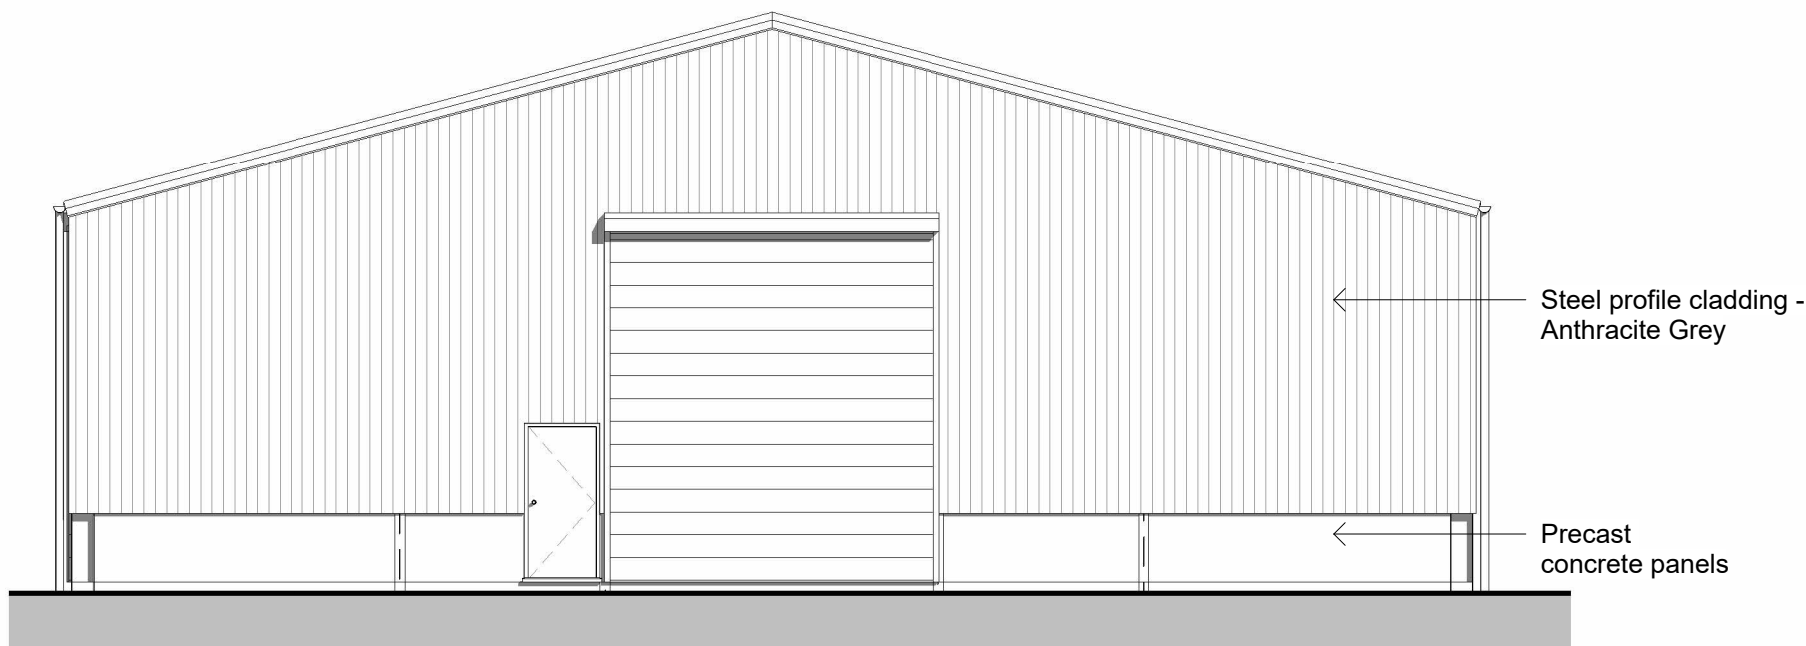

West - Existing
1 : 100

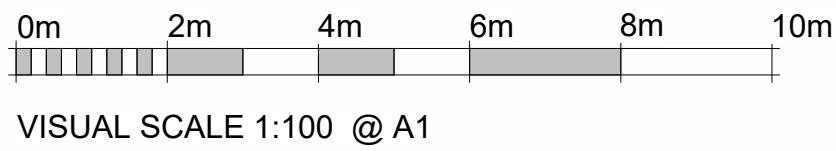

Rev No.	Revision Note.	Date	Drawn	Checked
C	As Built Drawings	26.01.26	AW	AW

Project number	Client	Project
01971-04	Stockton Dairy	Former Hay Barn
Title		
Existing Plan & Elevations		
Date	Sheet	Scale
26.01.26	01	1 : 100
Drawn by	Checked by	Paper Size
AW	AW	A1
Project		
ANDOVER LANE FARM FABERSTOWN ANDOVER HAMPSHIRE SP11 9PE Tel: 01264 850159 Email: info@bournevalley.co.uk		

