


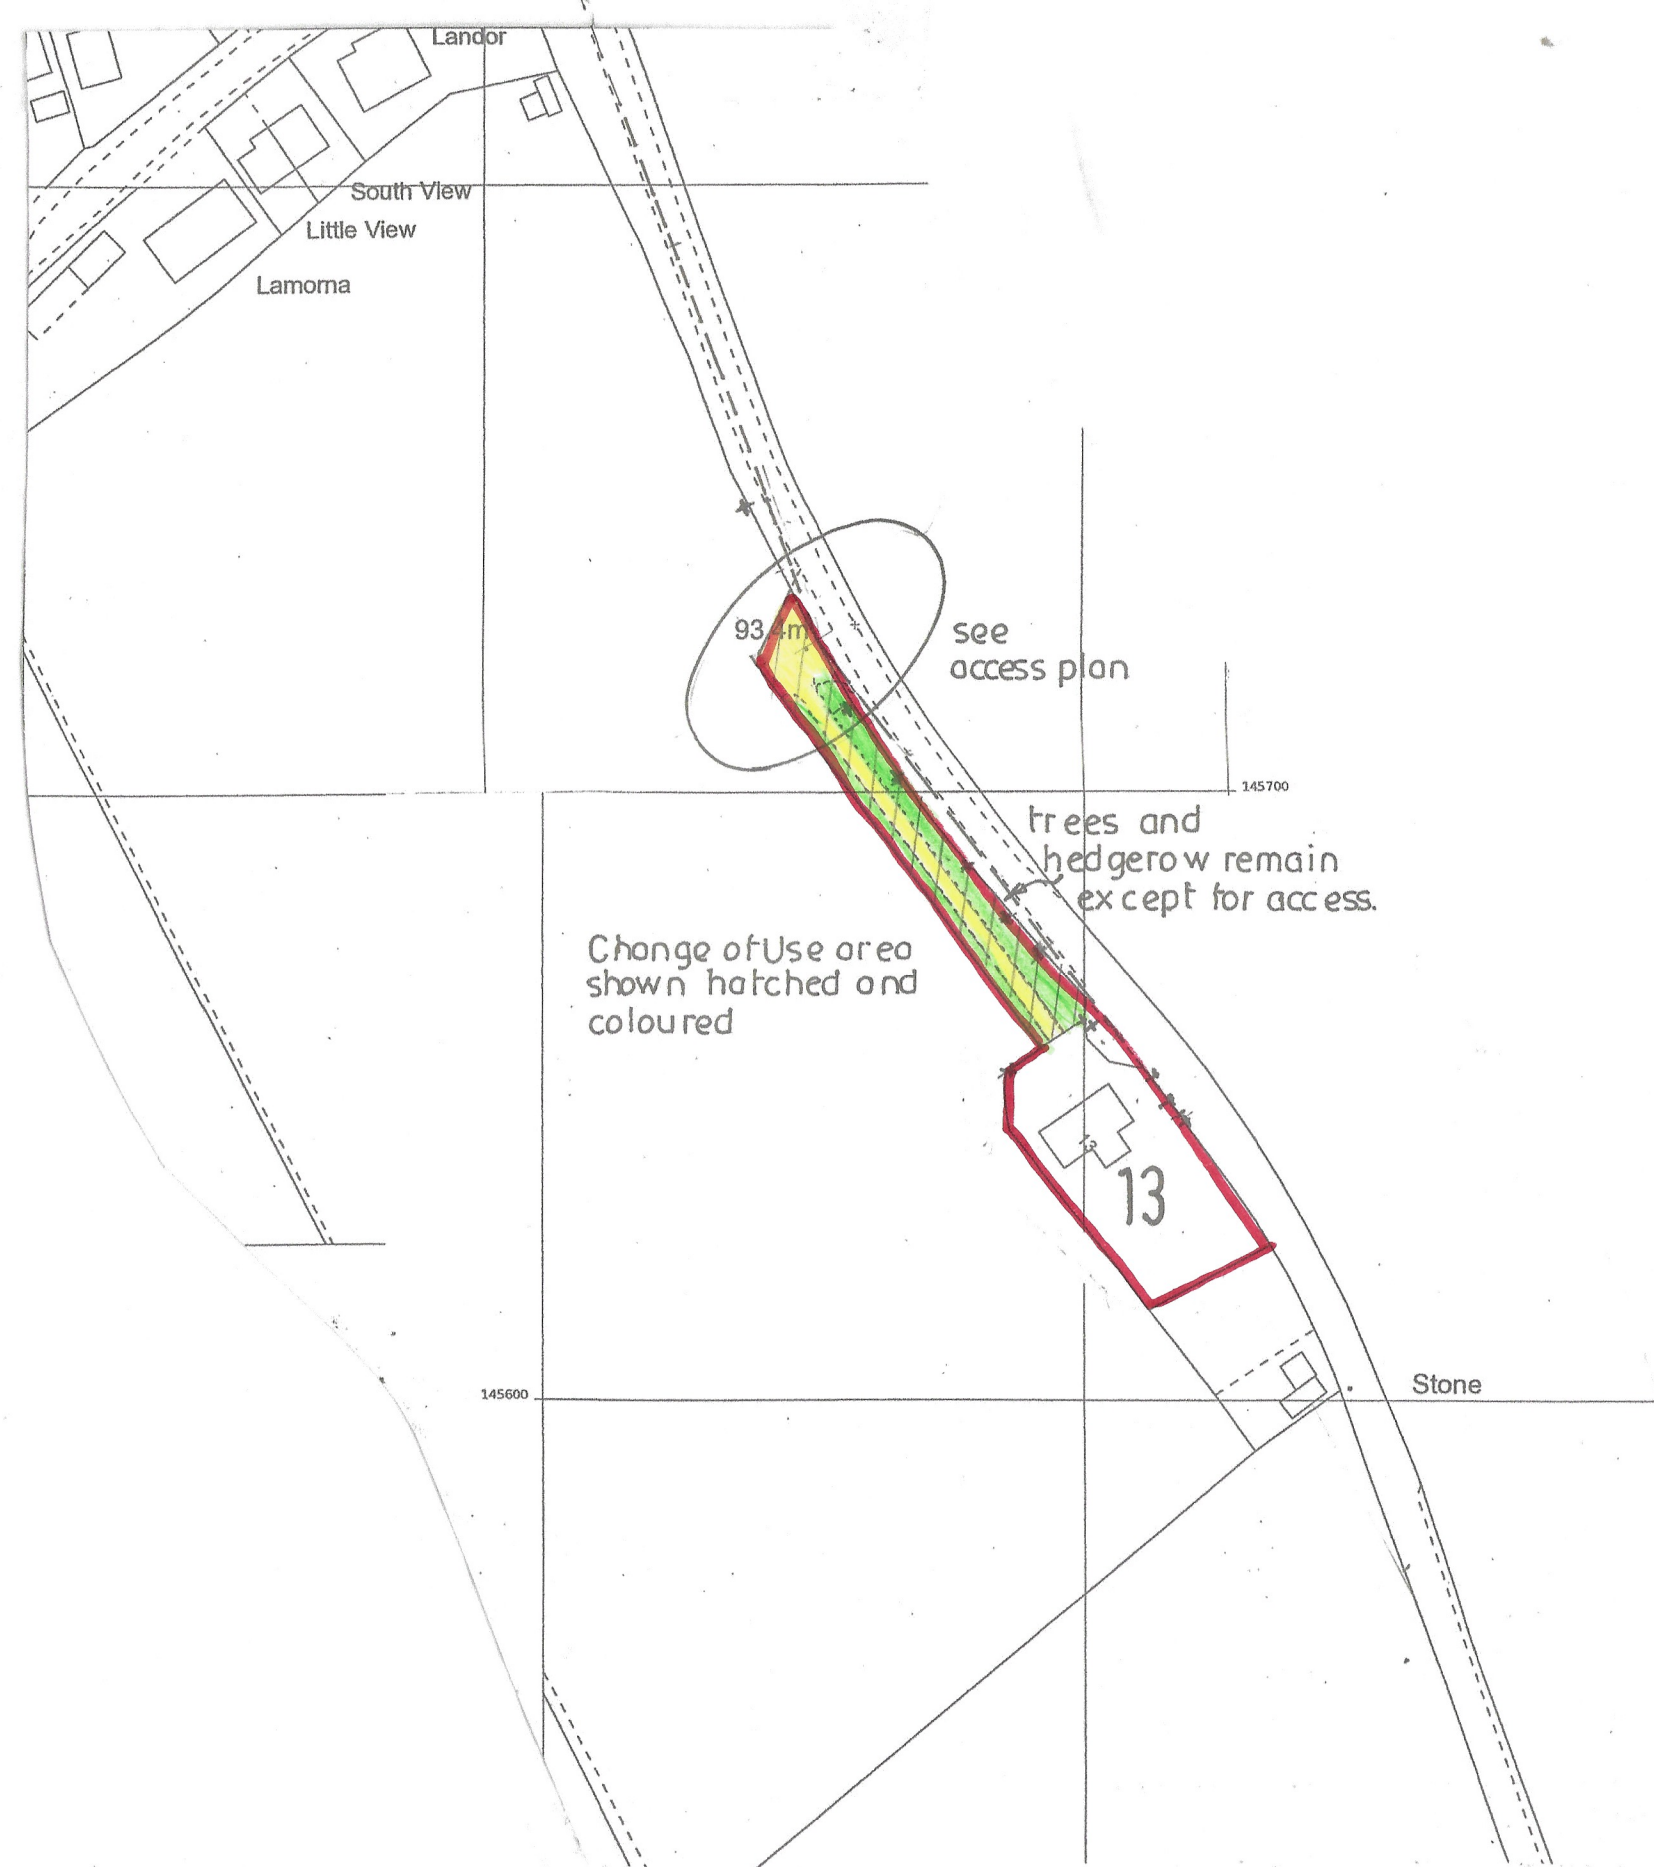


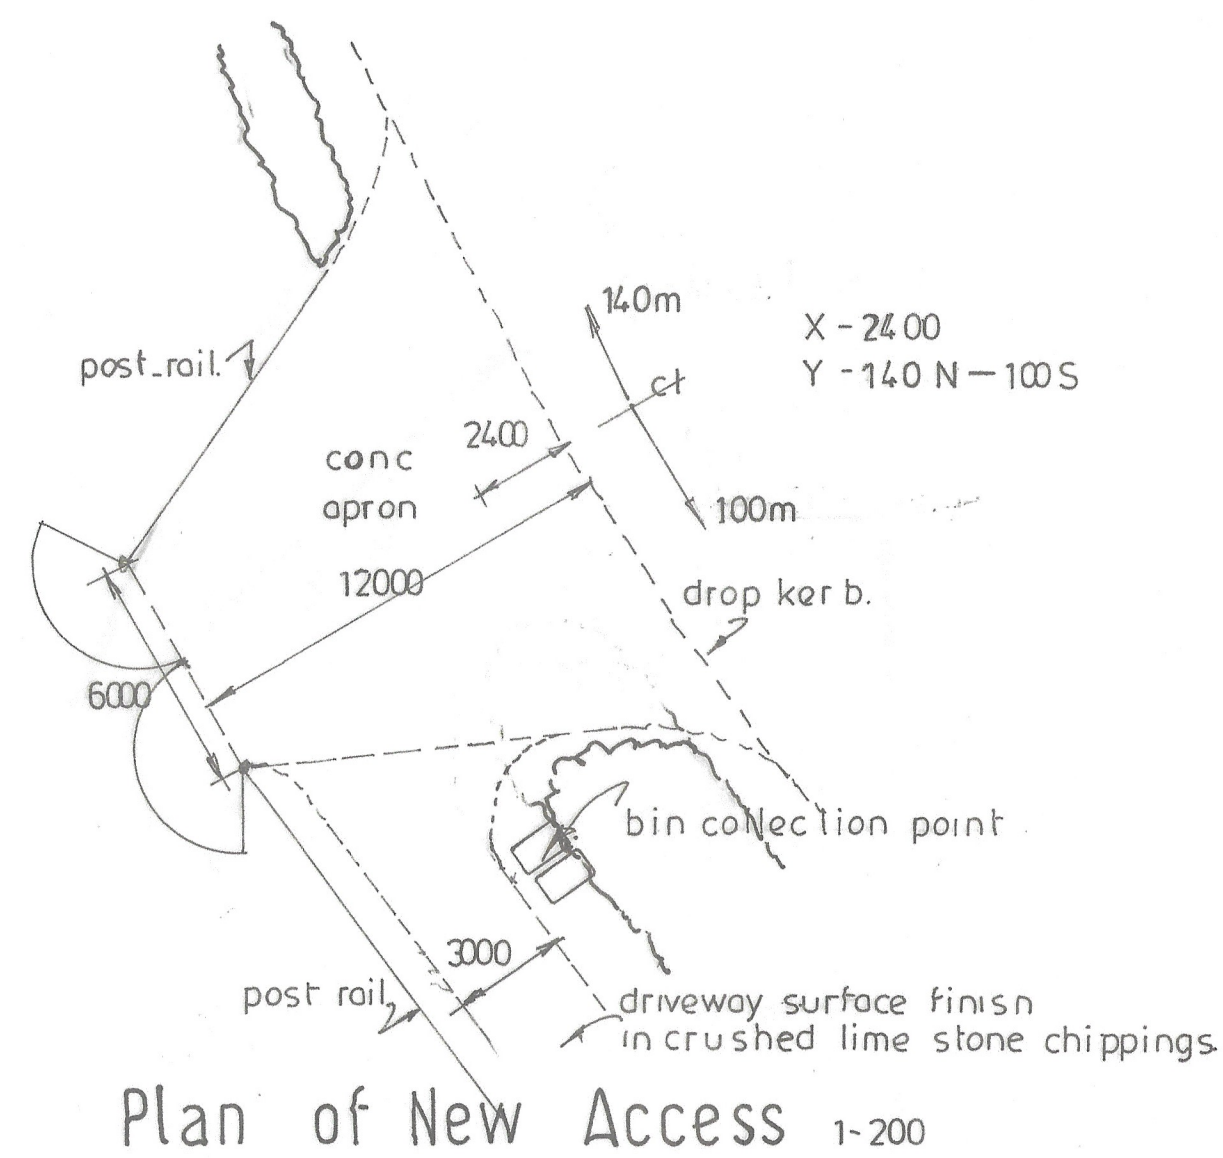


0 20 40 60m -1-1250 & A1

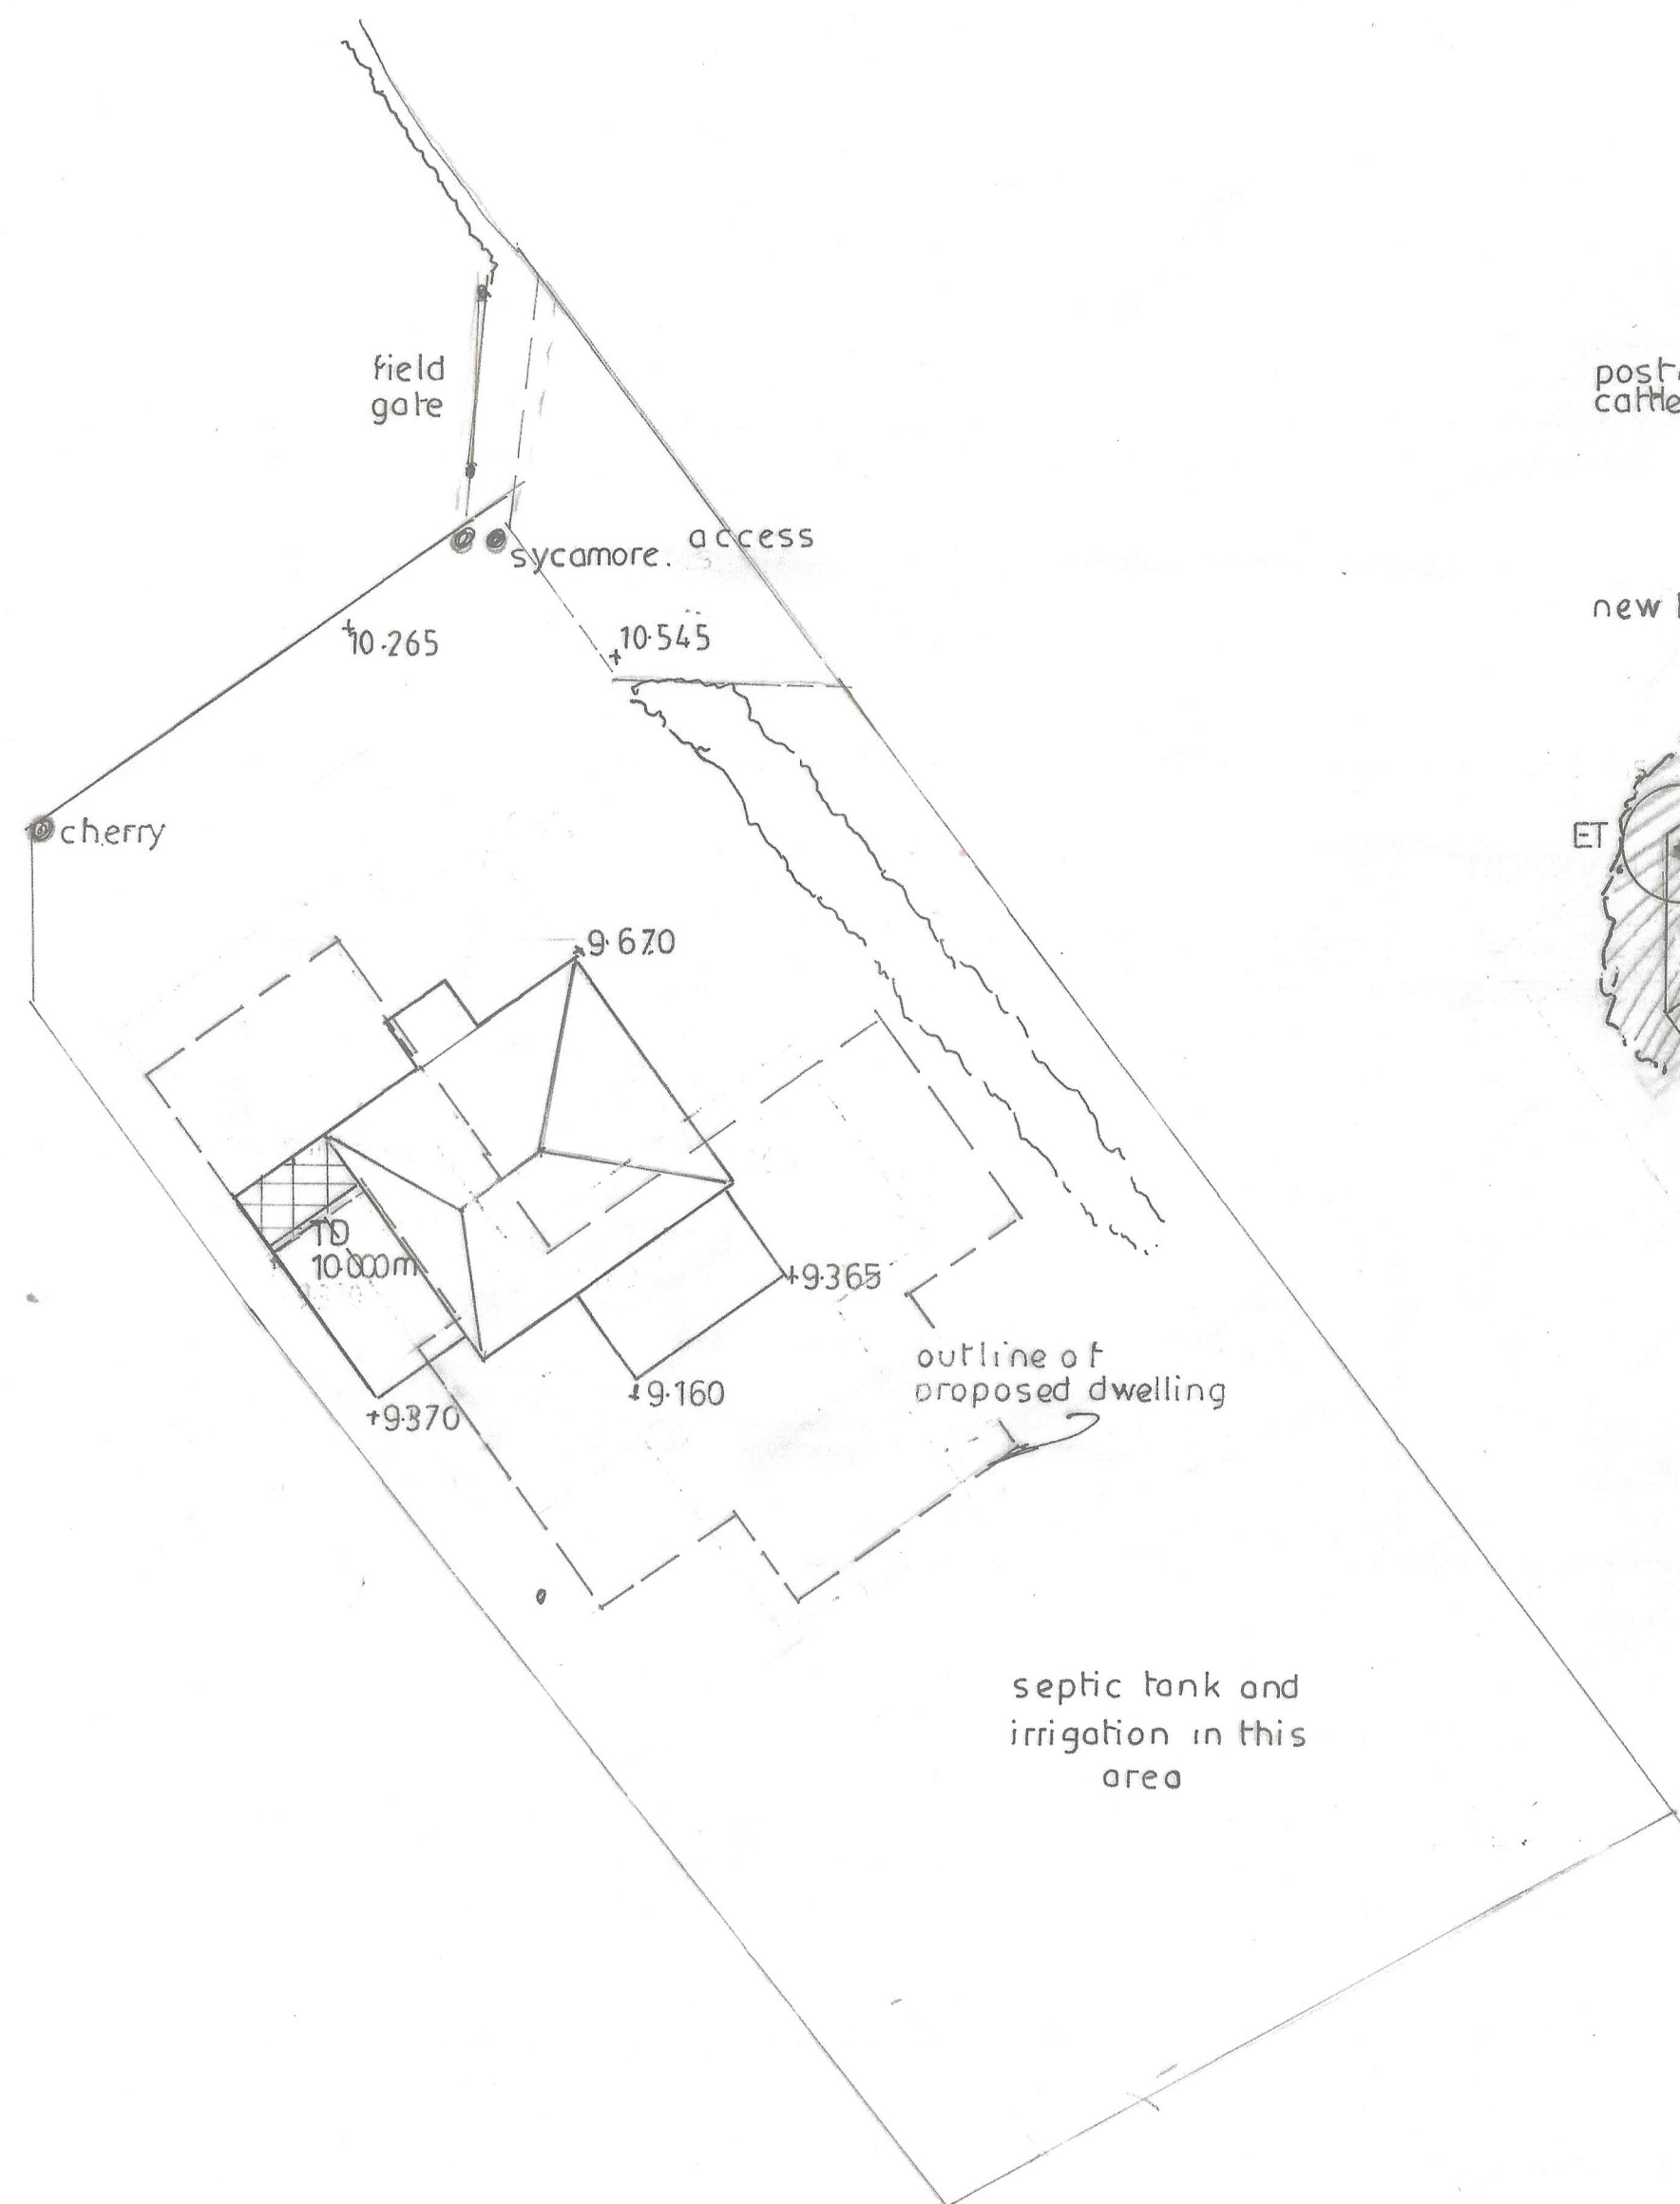


Site Layout As Existing 1-200

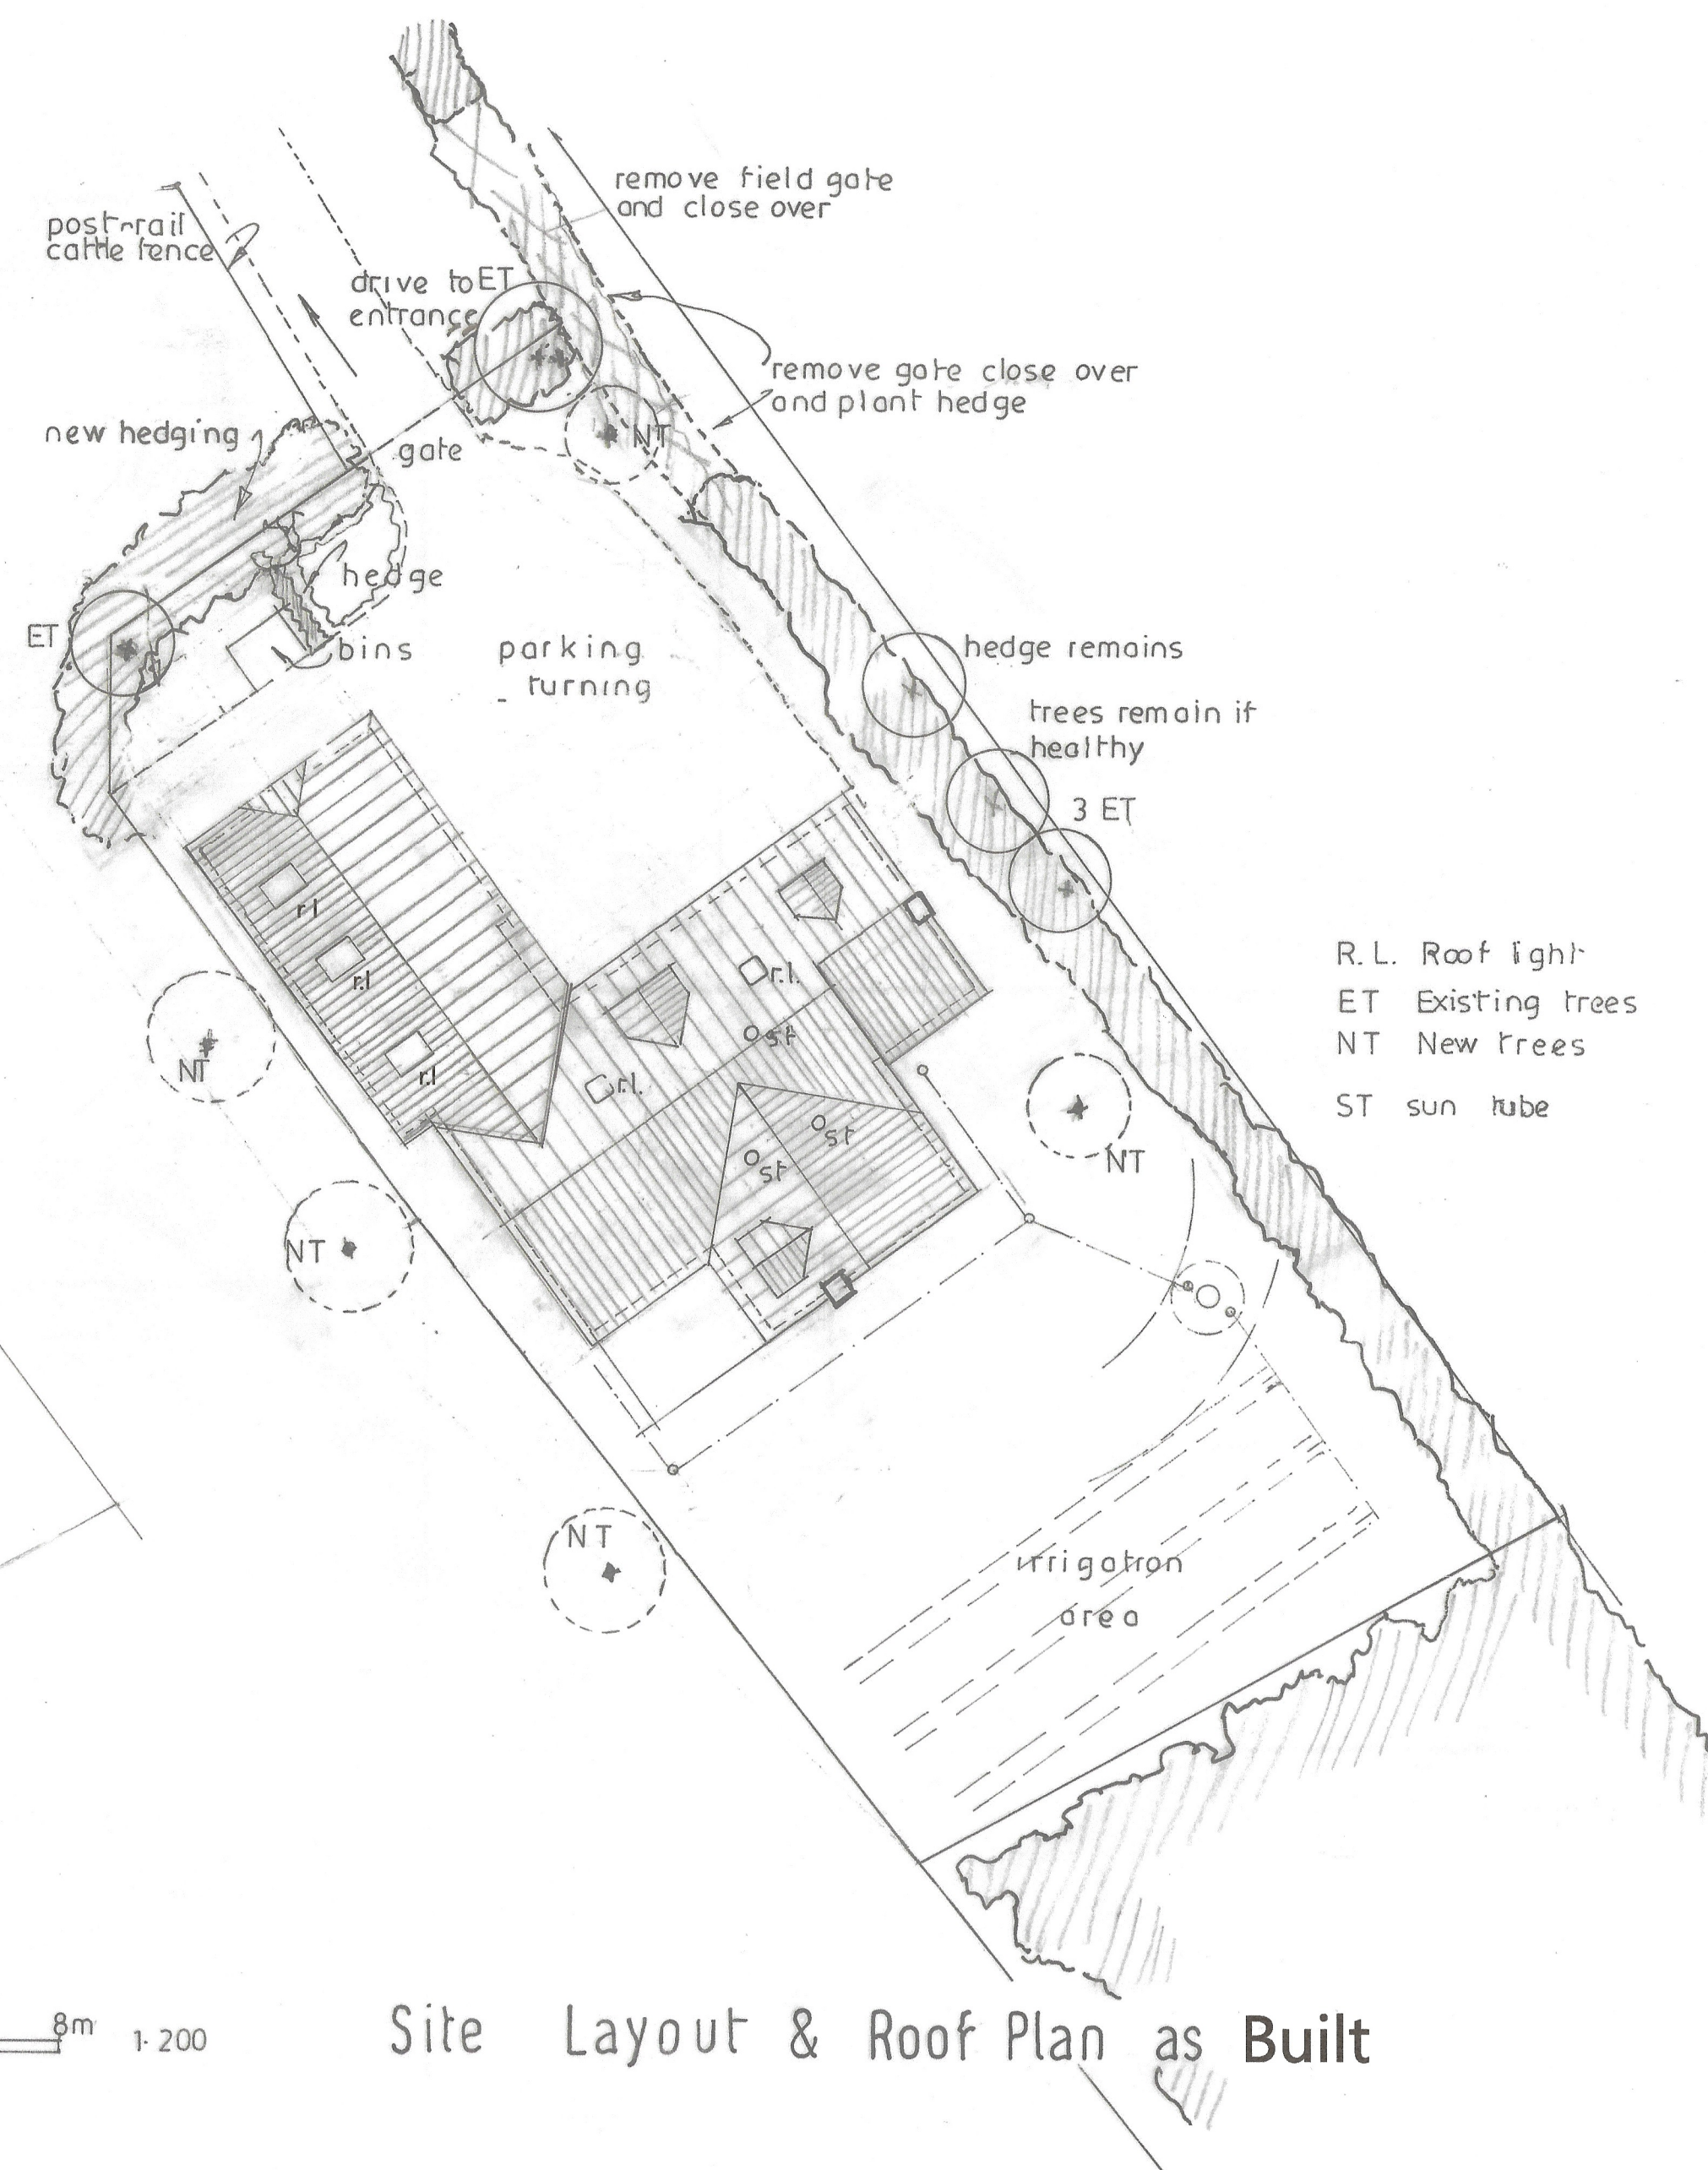

Site Layout & Roof Plan as Built

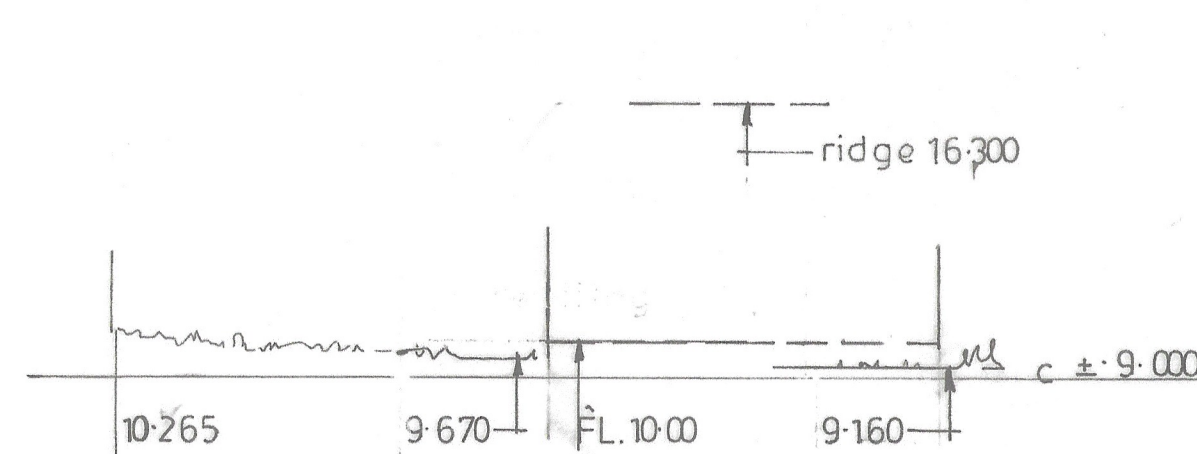

Section as Existing 1-200

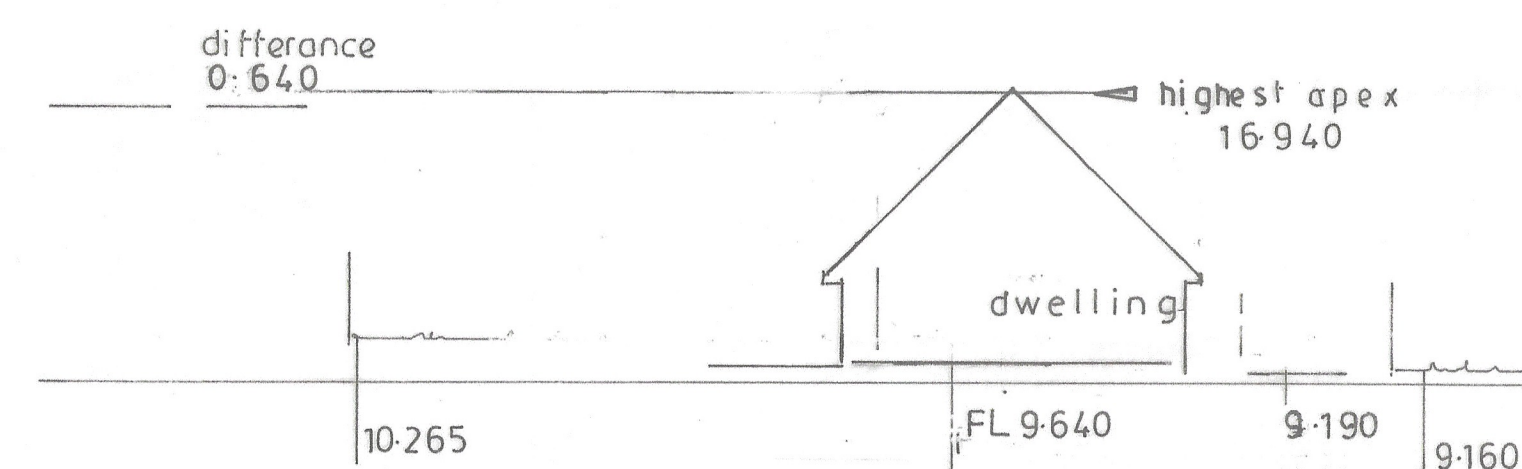

Section as Proposed 1-200

DA **Damen Associates Ltd**
Architectural Services

Kingsdown Studio
Back Drove
West Winterslow
Salisbury, Wiltshire SP5 1SX
Tel: 01980 863191
Email: burrows.damen@btconnect.com

Mr & Mrs G. RAWLINS
13 Brimmerston
Durrington
Salisbury SP4 8JB

REPLACEMENT DWELLING
As Built

Scale as given

Date 6 February 2026

Drwg. no. 01725

2

Rev.

This plan is the Surveyors
COPYRIGHT

PN