


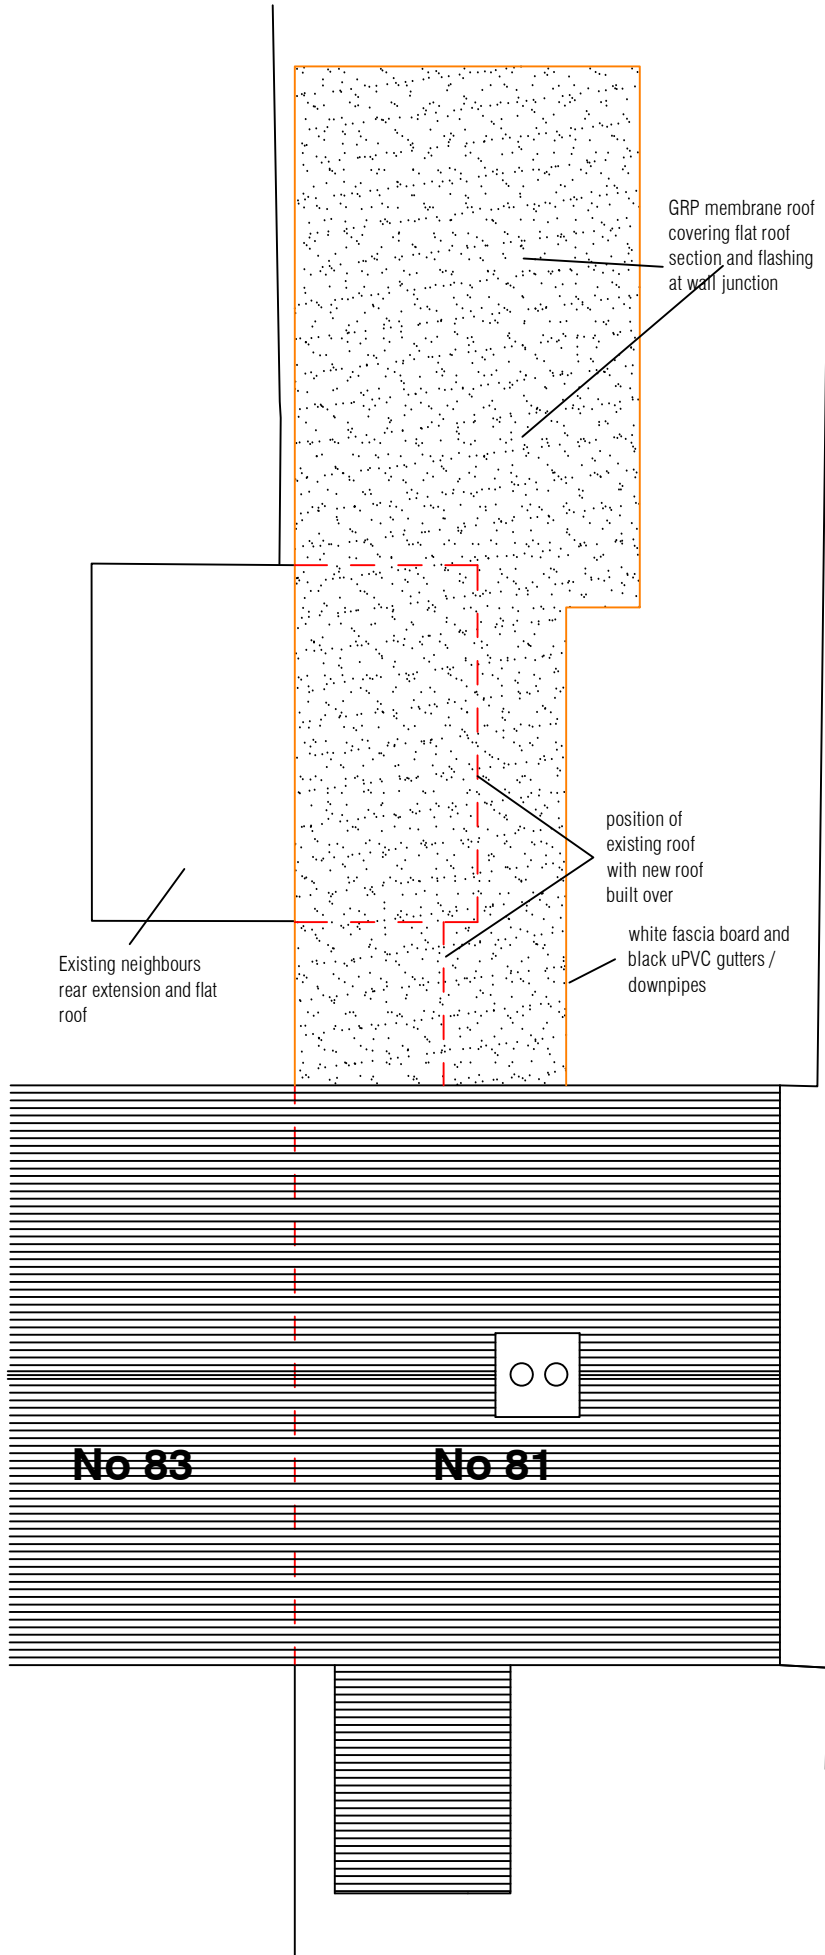


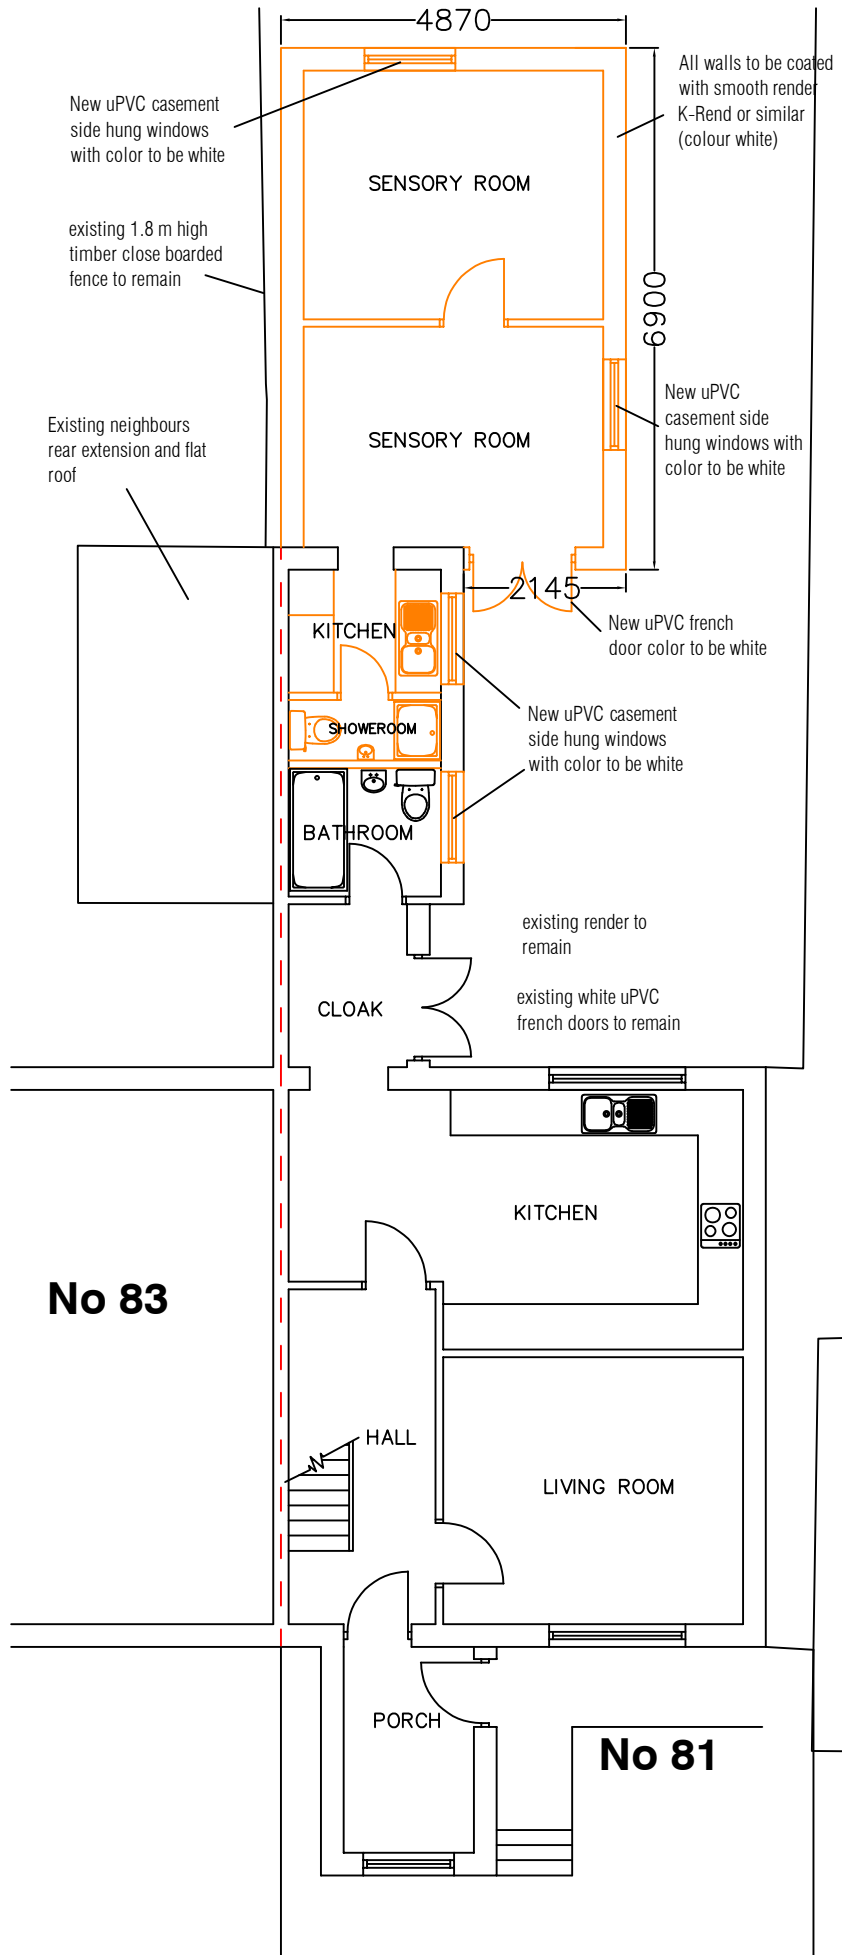

AS BUILT ROOF PLAN, 1:100

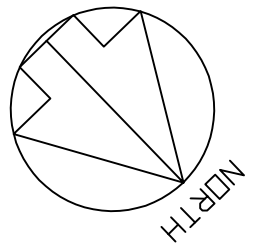

AS BUILT GROUND FLOOR PLAN, 1:100

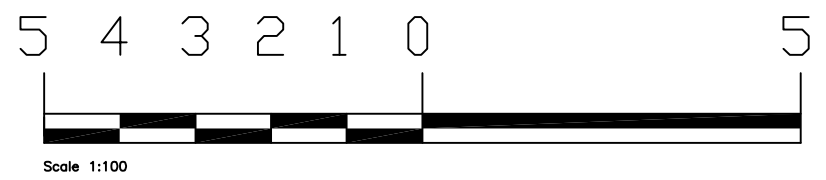

STUDIO CHARRETTE
A: The Clubhouse, 50 Grosvenor Hill, London, W1K 3QT
W: www.studiocharrette.co.uk

Client
Vicky Rose

Project Title
**81 Antrobus Road,
Amesbury, Salisbury
SP4 7ND**

Drawing Title
retrospective rear extension
As built floor and roof plans

Drawing No. SC / 25 / 597 - 201	Rev
Scale 1:100 @ A3	Planning
Date - Feb 2026	Building Control
Created By A Mc	Client
Check By	Sketch
	Information

This drawing and the copyright, design rights and all other intellectual property rights in it belong to Studio Charrette Ltd. No licence or assignment of any such rights is granted hereunder. This drawing is not to be copied or divulged to a third party without written permission.