

Studio Charrette will not be responsible for any principal designer duties under CDM 2015.  
No site work is to be carried out until permissions are in place. Site searches to carried out before any works to site.  
All structural elemental/associated calculations to be confirmed and provided by structural engineer.

**NOTES:**

This drawing is not a working drawing, and is only for the purpose of the following:-

A- Planning Submission



The main contractor is responsible for Informing the lead designer of any discrepancy on, or between, this drawing and any other relevant document.

All existing walls, foundations and lintels or other structural items are to be confirmed load bearing and adequate for increased loading where relevant prior to work commencing.


Any existing walls to be removed are to be confirmed non - loadbearing prior to removal.

Boundaries, angles, and dimensions are to be checked by the main contractor prior to work commencing.


Written dimenions only to be used from this drawing. If in doubt consult the lead designer for clarification.

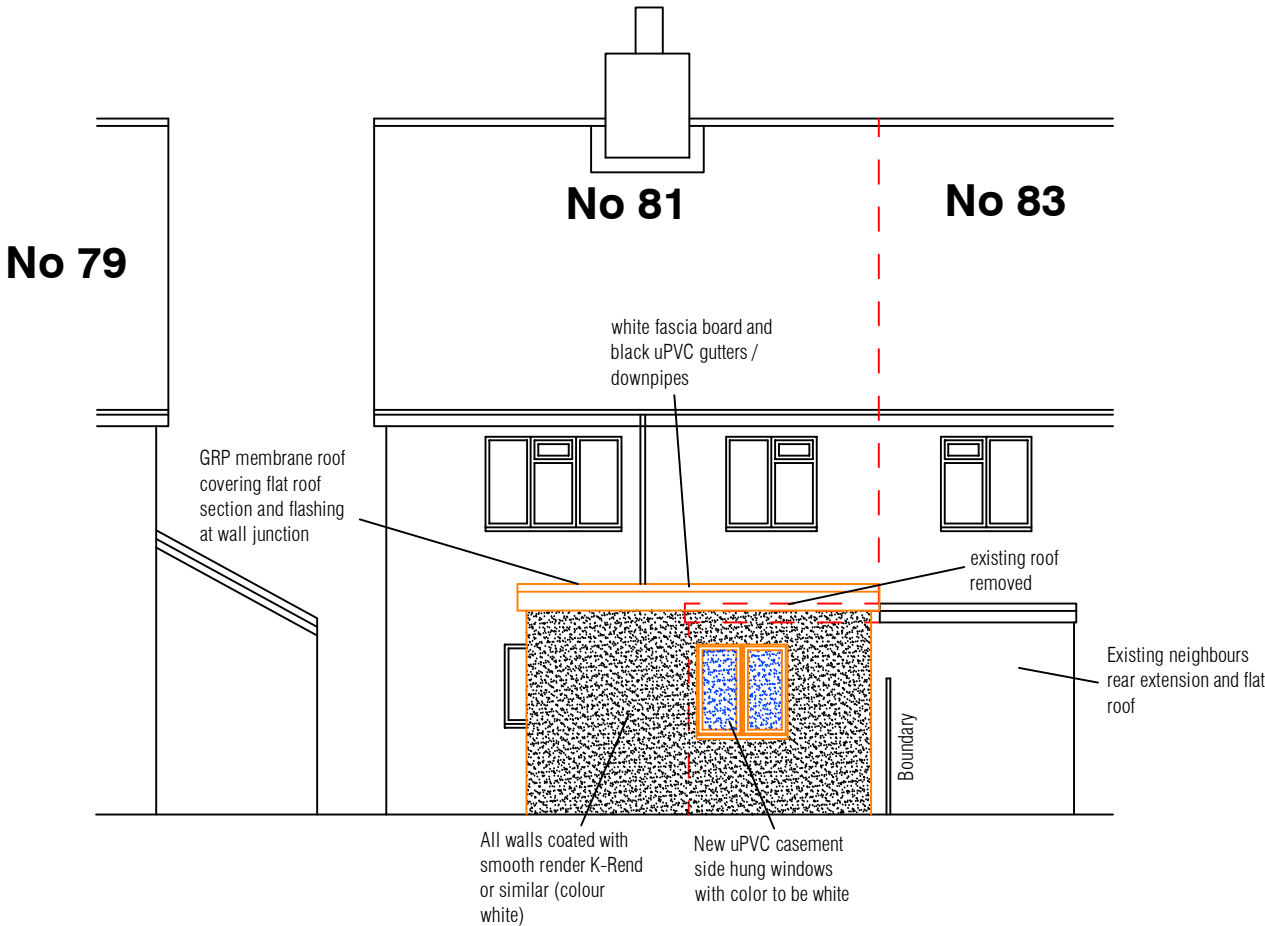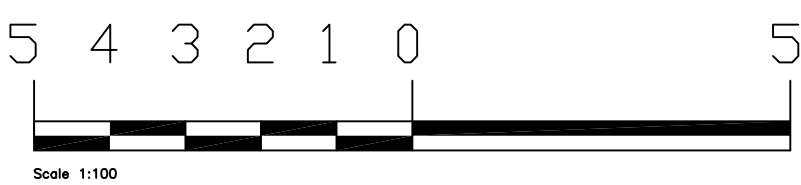

AS BUILT REAR ELEVATION, 1:100

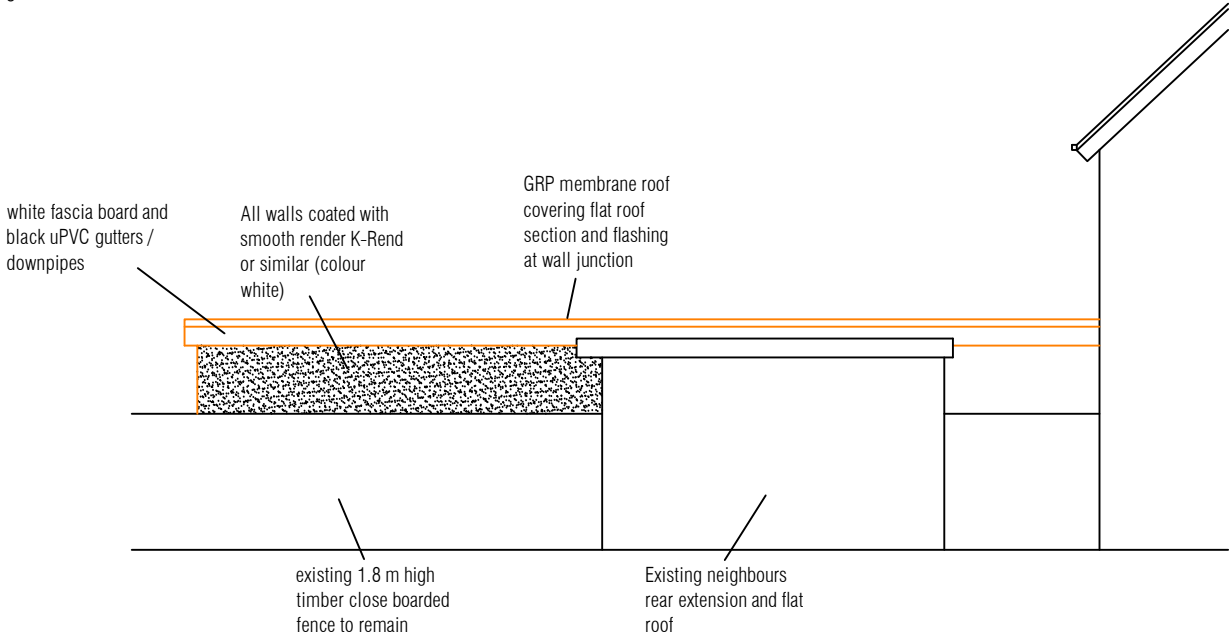

AS BUILT SIDE ELEVATION, 1:100

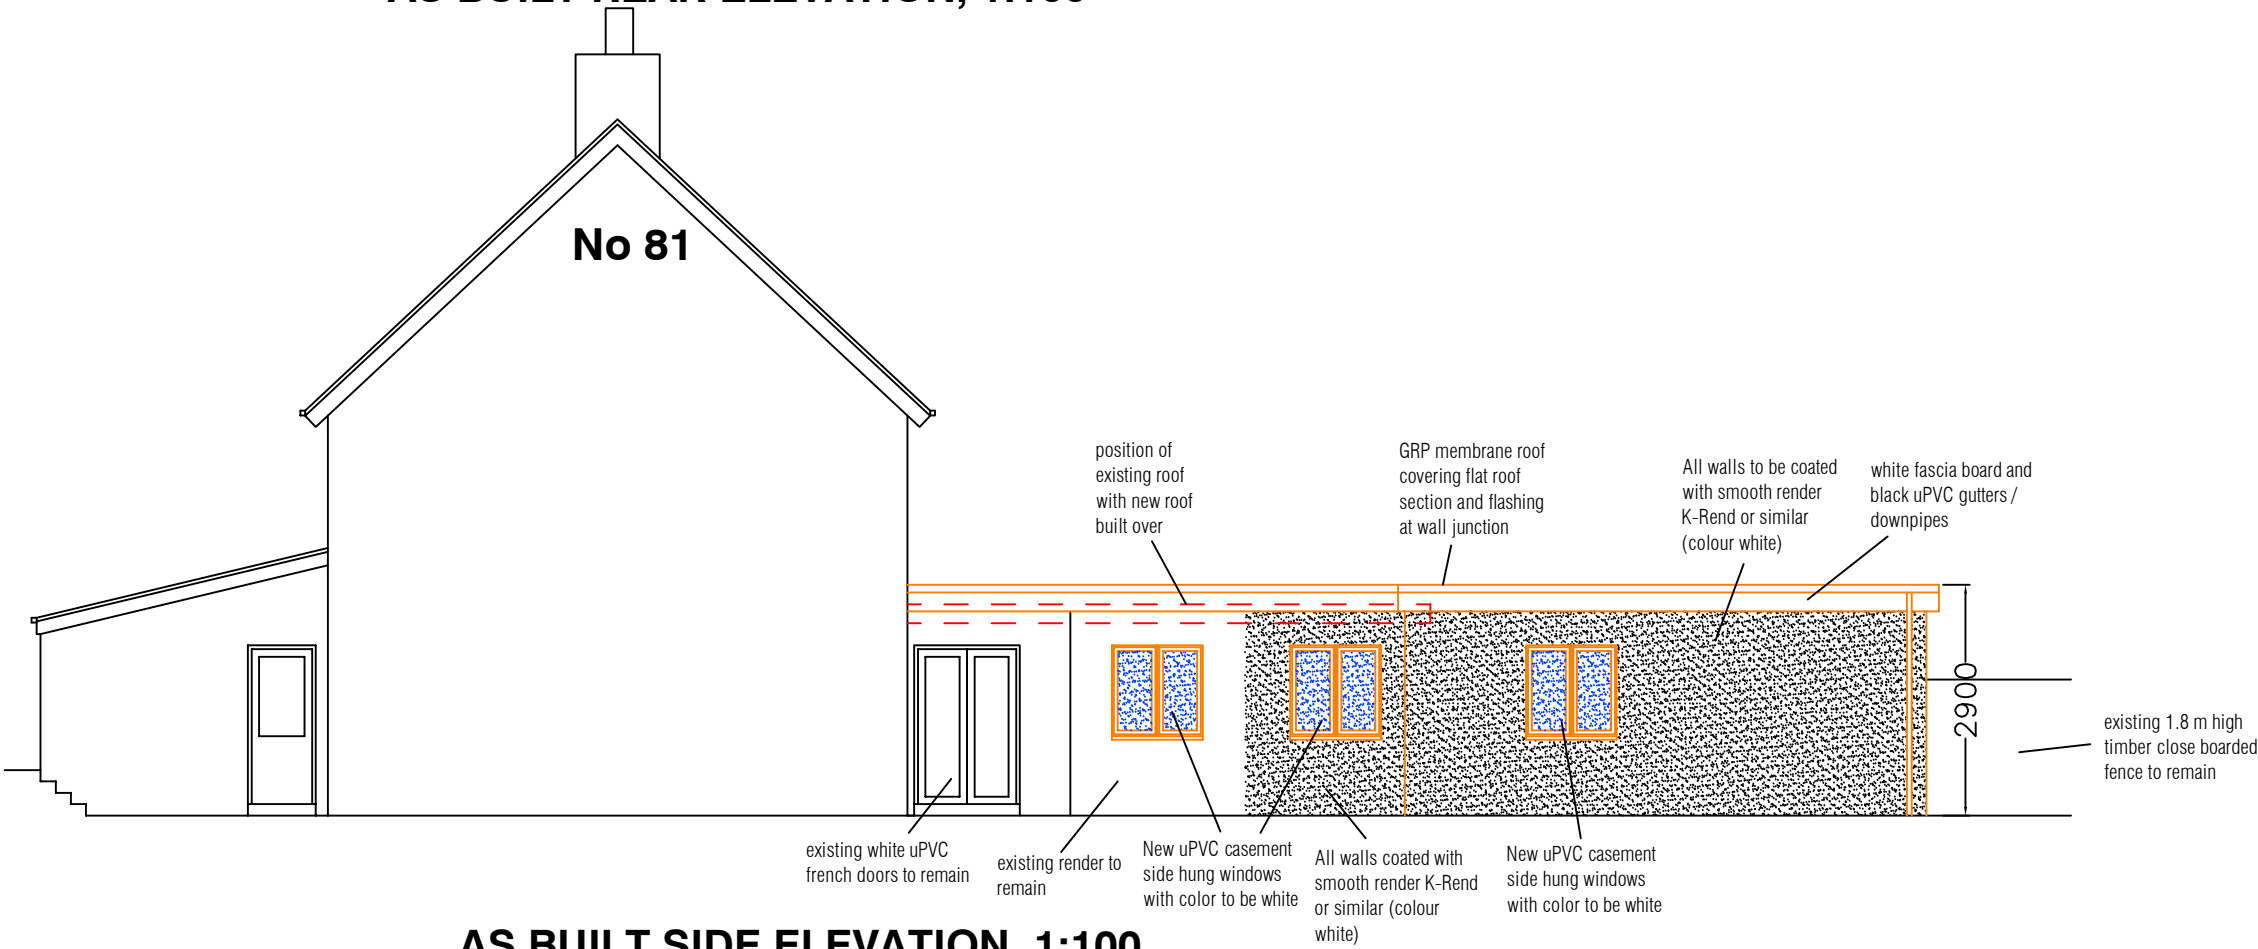

AS BUILT SIDE ELEVATION, 1:100

STUDIO  
CHARRETTE

A: The Clubhouse, 50 Grosvenor Hill, London, W1K 3QT  
W: [www.studiocharrette.co.uk](http://www.studiocharrette.co.uk)

Client

Vicky Rose

Project Title

81 Antrobus Road,  
Amesbury, Salisbury  
SP4 7ND

Drawing Title

retrospective rear extension

As built elevations

Drawing No.  
SC / 25 / 597 - 202

Scale  
1:100, @ A3

Date - Feb 2026

Created By  
A Mc

Check By

Rev

|                  |  |
|------------------|--|
| Planning         |  |
| Building Control |  |
| Client           |  |
| Sketch           |  |
| Information      |  |

This drawing and the copyright, design rights and all other intellectual property rights in it belong to Studio Charrette Ltd. No licence or assignment of any such rights is granted hereunder. This drawing is not to be copied or divulged to a third party without written permission.