
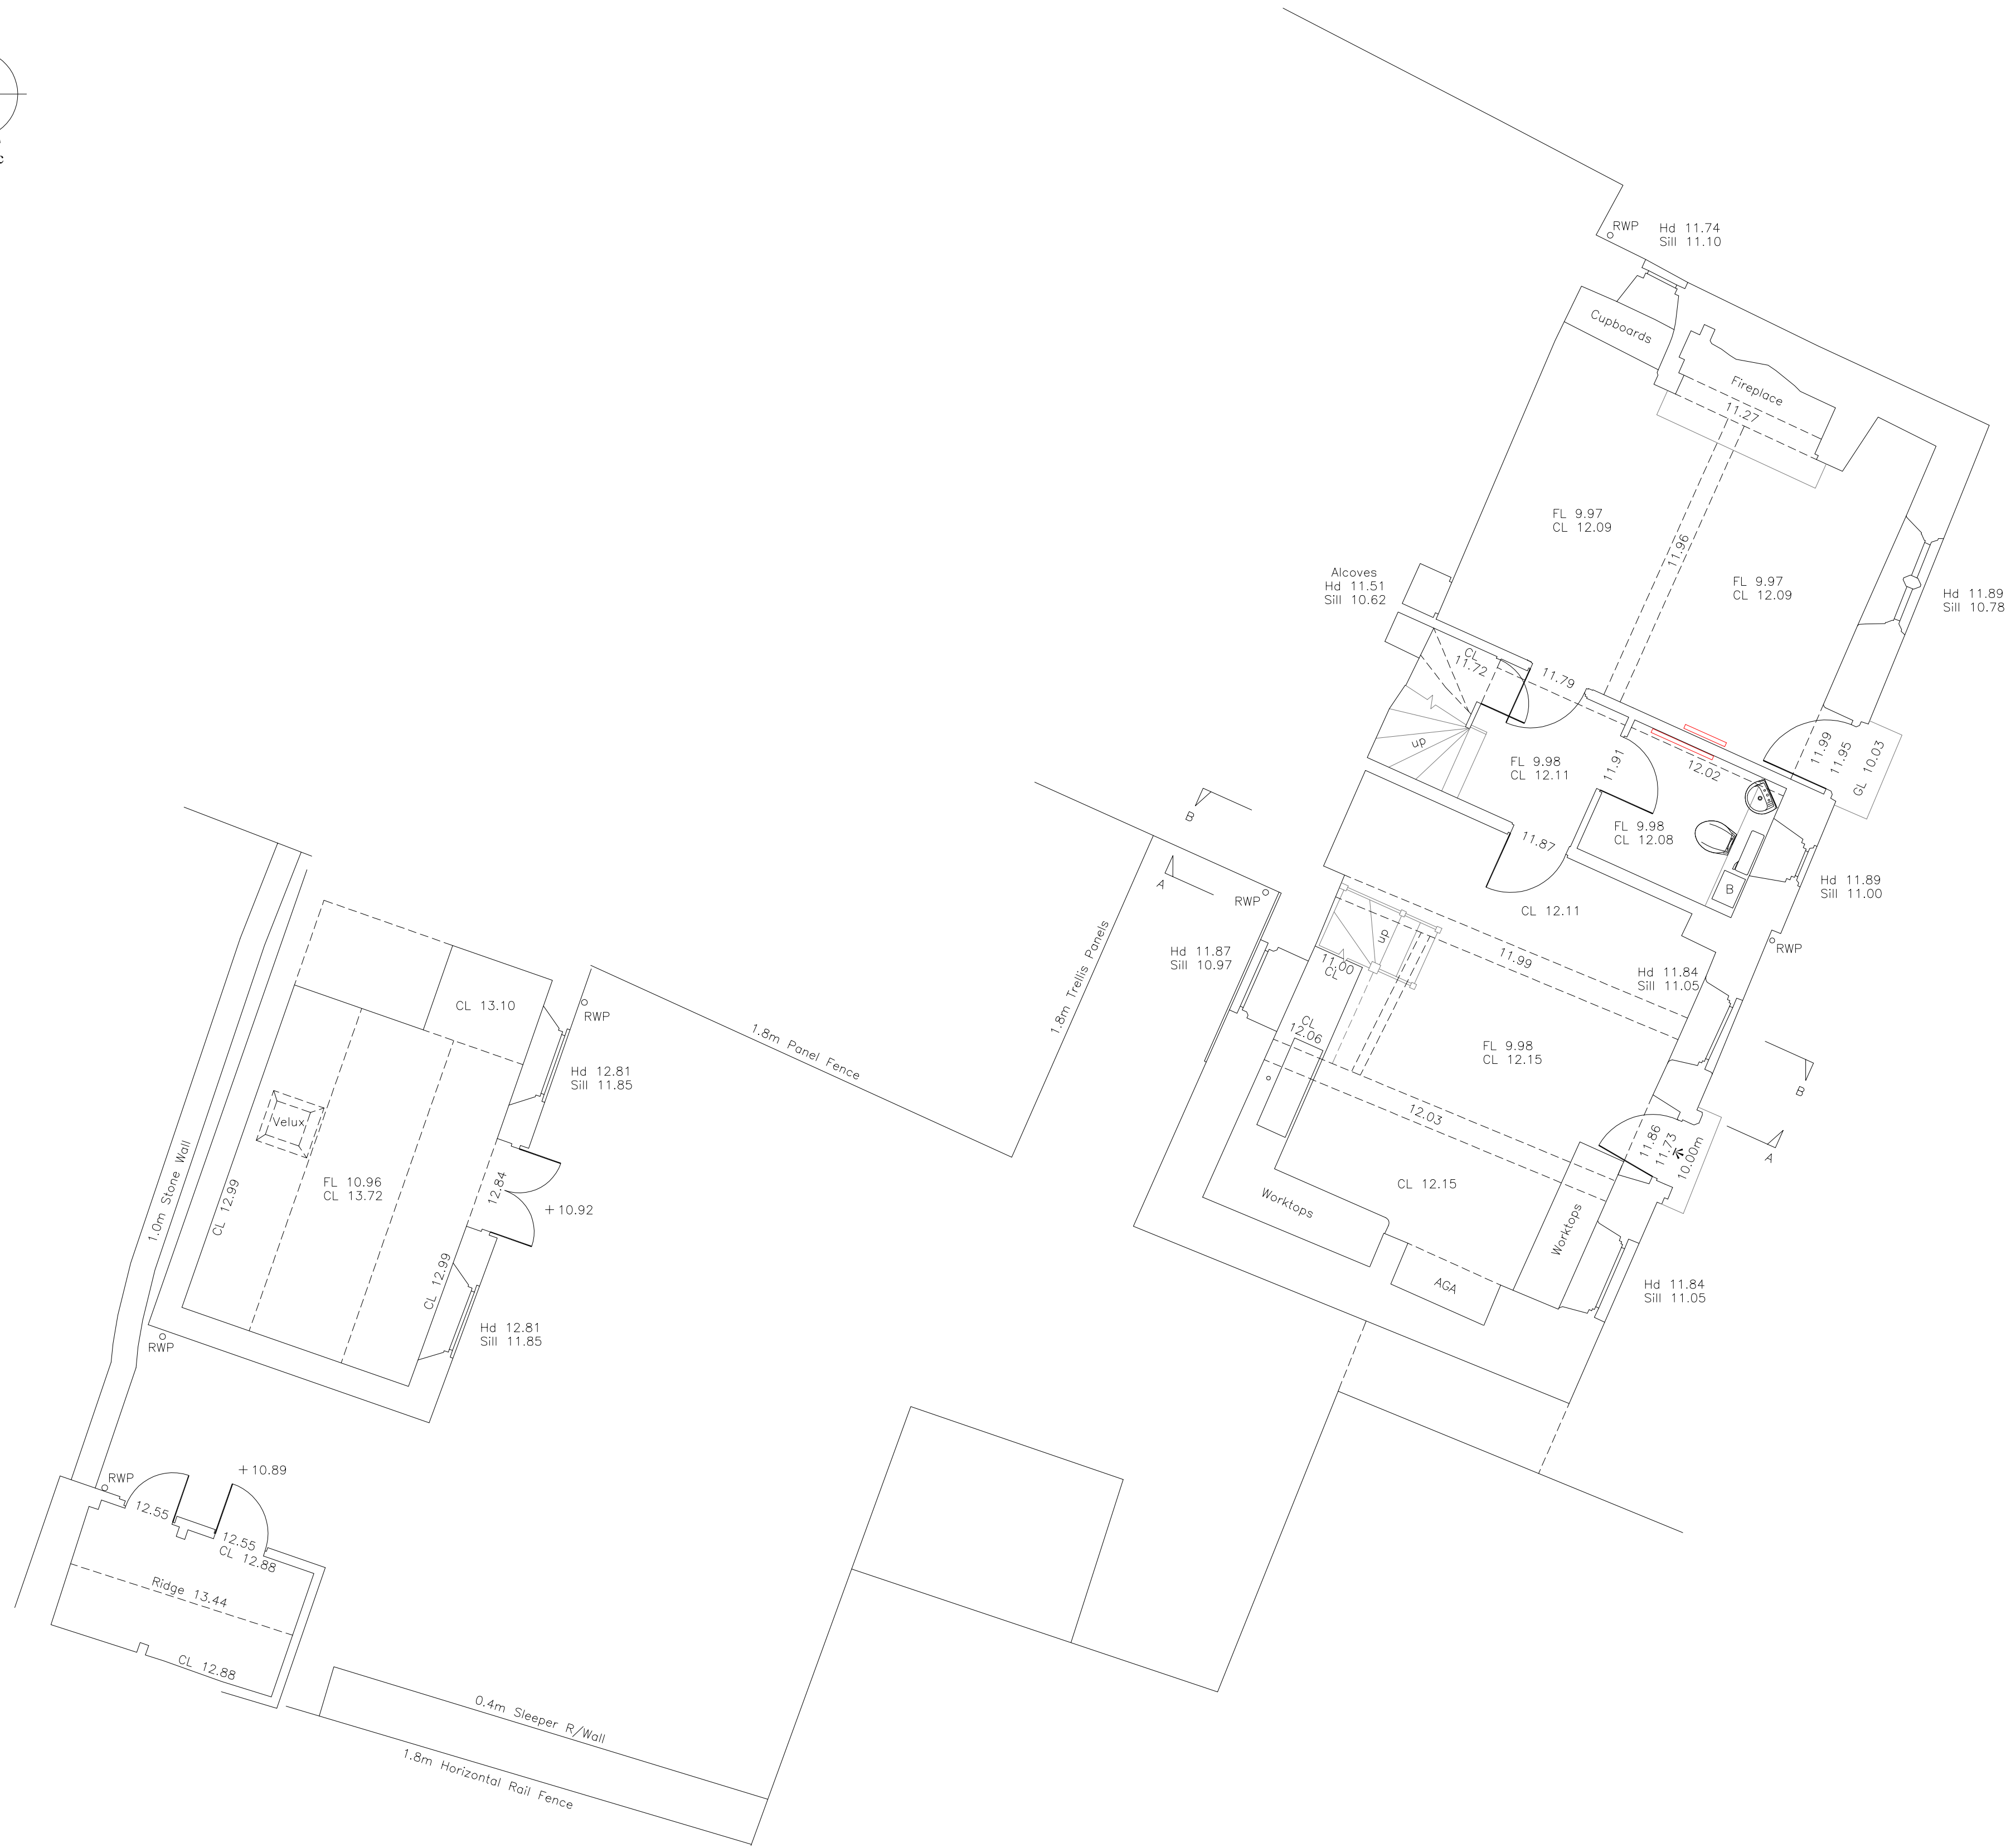


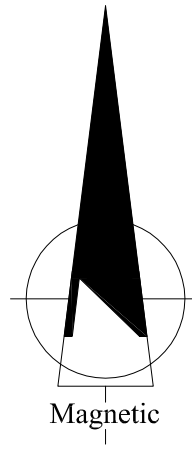

D&H Surveys Ltd

The Manor Stables, Great Sonnerford, Chippenham
Wiltshire, SN15 5EH

Email: admin@dhsurveys.co.uk
Website: www.dhsurveys.co.uk

Topographic Surveys
Elevation Surveys
Floor Plan Surveys
Volumetric Surveys

As Built Drainage Surveys
Co-ordination Of Site Layouts
Rectified Photo Elevations
C.A.D Plotting Bureau

Tel (01249) 720545
Fax (01249) 721124

Project Name:
2-3 Bences Lane
Corsham SN13 0DD

Drawing Title:
Ground Floor Plans

Client:
Zoe England
Agent:
Nick Matthews Surveying Ltd

Date:
Jan 2026

Scale:
A1 @ 1:50

Drawn	Surveyor	Dwg No	Revision
KJH	SCB	FP 01	

Site Datum
TBM Entrance 10.00m

OSBM Ref

Grid Orientation
Arbitrary (Magnetic North)

Sheet ID
MATTHEWS-Corsham-Bences Lane

Disclaimer
D & H Surveys will Guarantee that this
Survey Data & Station Coords are Correct to the Indicated Scale ONLY
Copyright of this Drawing Remains With D & H Surveys.