





Main House

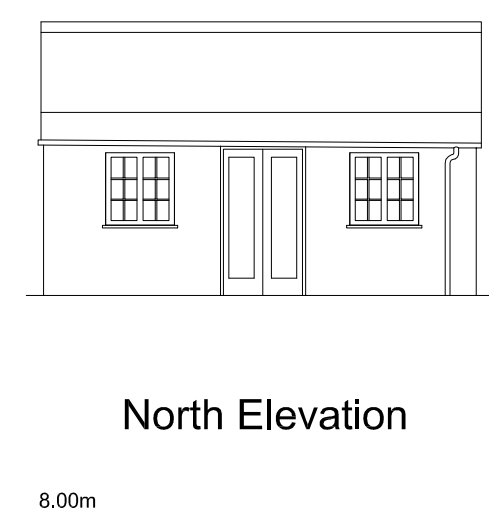



Large Outbuilding

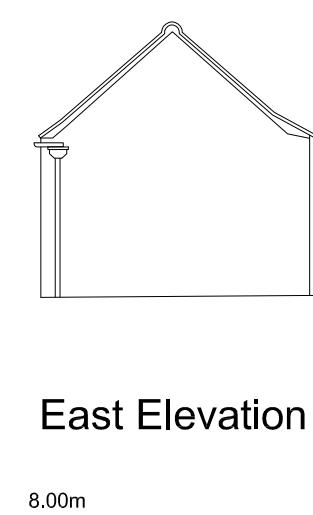

Small Outbuilding

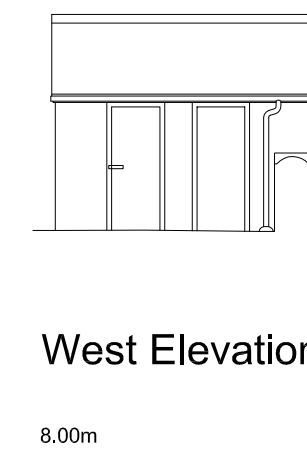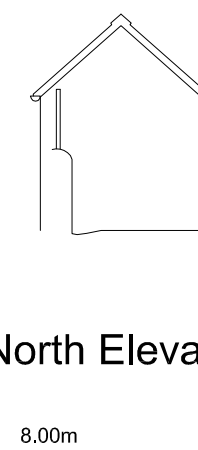


Sections

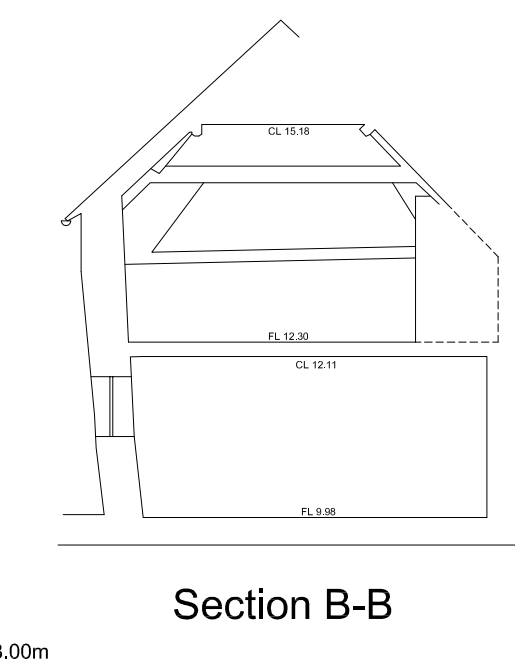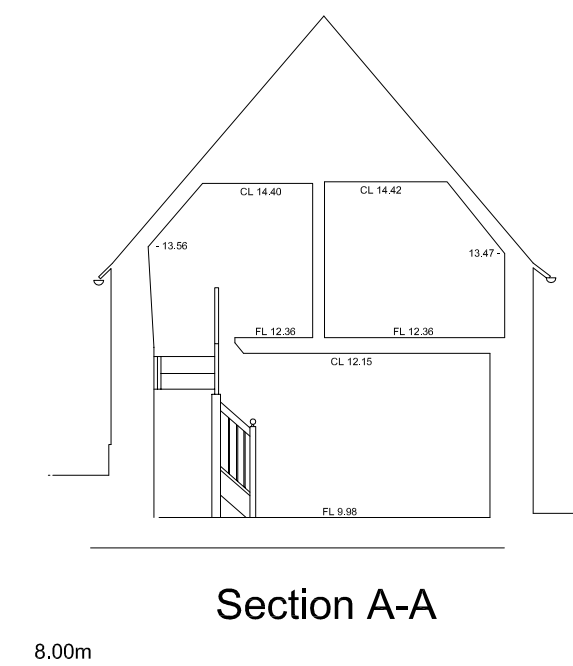

D&H Surveys Ltd The Manor Stables, Great Somerford, Chippingham Wiltshire, SN15 5EH.			
Email: admin@dsurveys.co.uk Website: www.dsurveys.co.uk		Tel (01249) 720545 Fax (01249) 721124	
Topographic Surveys Elevation Surveys Floor Plan Surveys Volumetric Surveys		As Built Drainage Surveys Co-ordination Of Site Layouts Rectified Photo Elevations C.A.D Plotting Bureau	

Project Name: 2-3 Bences Lane Corsham SN13 0DD									
Drawing Title: Elevations & Sections									
Client: Zoe England Agent: Nick Matthews Surveying Ltd									
Date: Jan 2026	Scale: A1 @ 1:100								
<table border="1" style="width: 100%; border-collapse: collapse;"> <tr> <td style="width: 50%; padding: 5px; text-align: center;">Drawn</td> <td style="width: 50%; padding: 5px; text-align: center;">Surveyor</td> </tr> <tr> <td style="width: 50%; padding: 5px; text-align: center;">KJH</td> <td style="width: 50%; padding: 5px; text-align: center;">SCB</td> </tr> </table>	Drawn	Surveyor	KJH	SCB	<table border="1" style="width: 100%; border-collapse: collapse;"> <tr> <td style="width: 50%; padding: 5px; text-align: center;">Dwg No</td> <td style="width: 50%; padding: 5px; text-align: center;">Revision</td> </tr> <tr> <td style="width: 50%; padding: 5px; text-align: center;">EL 01</td> <td style="width: 50%;"></td> </tr> </table>	Dwg No	Revision	EL 01	
Drawn	Surveyor								
KJH	SCB								
Dwg No	Revision								
EL 01									
Site Datum TBM Entrance 10.00m									
Grid Orientation Arbitrary (Magnetic North)									
OSBM Ref Sheet ID MATTHEWS-Corsham-Bences Lane									
Disclaimer D & H Surveys will Guarantee that this Survey Data & Station Coords are Correct to the Indicated Scale ONLY Copyright of this Drawing Remains With D & H Surveys.									

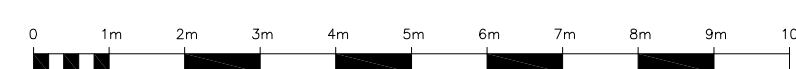

Scale 1 : 100