




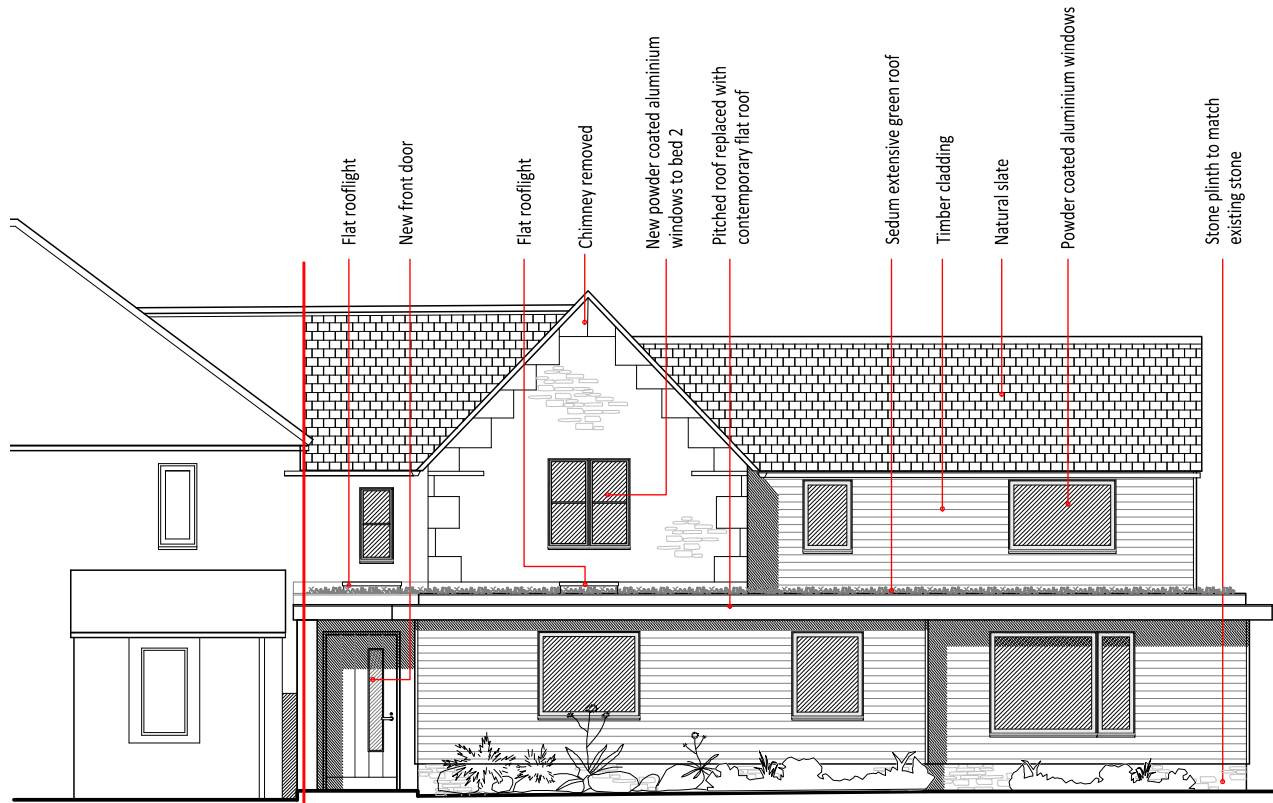


North West Elevation

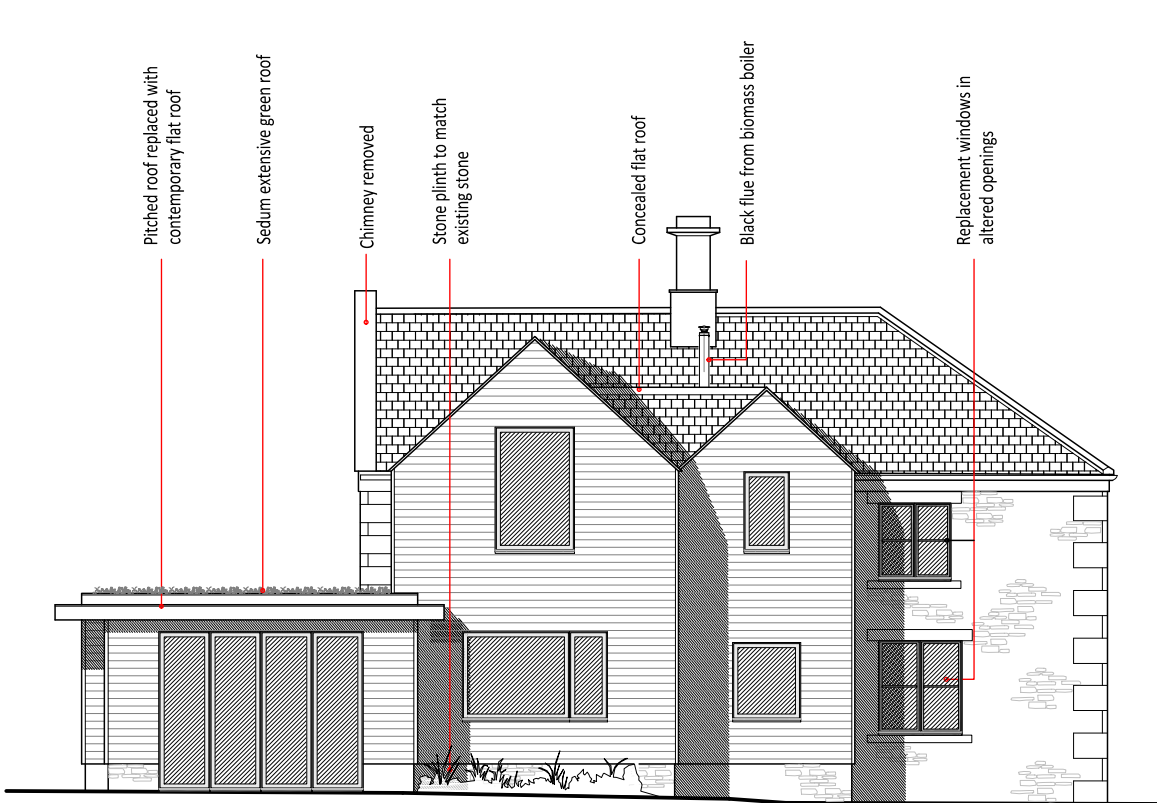


South West Elevation

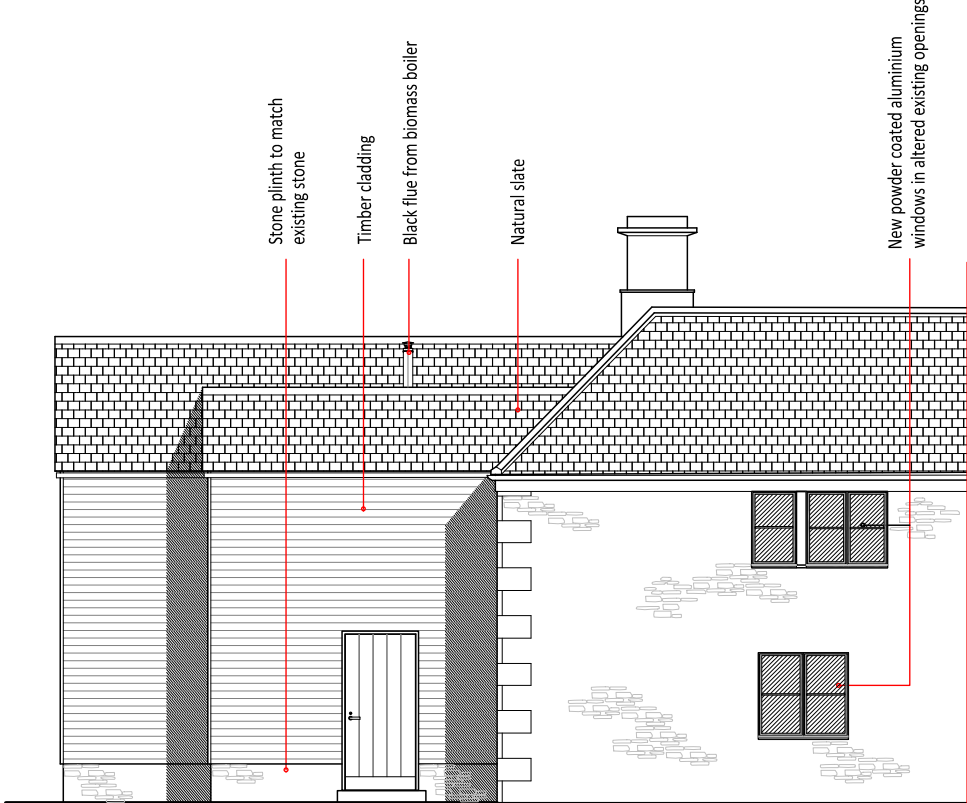


South East Elevation

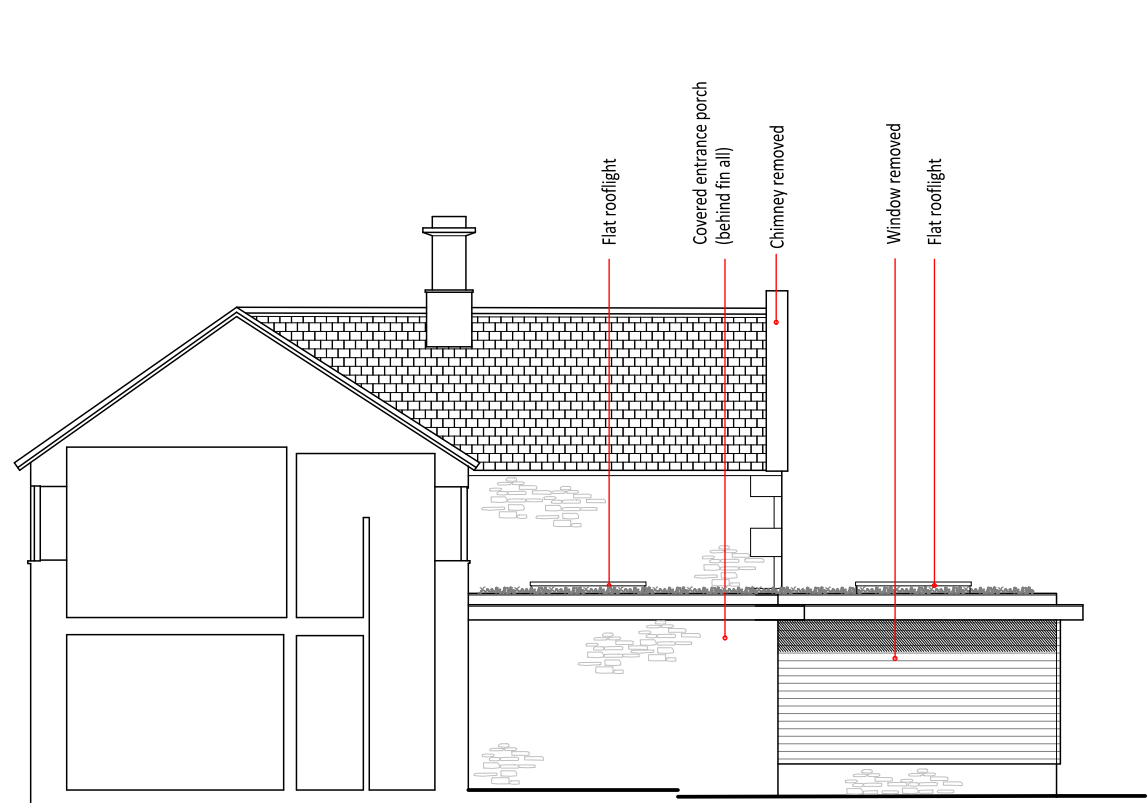



North East Elevation

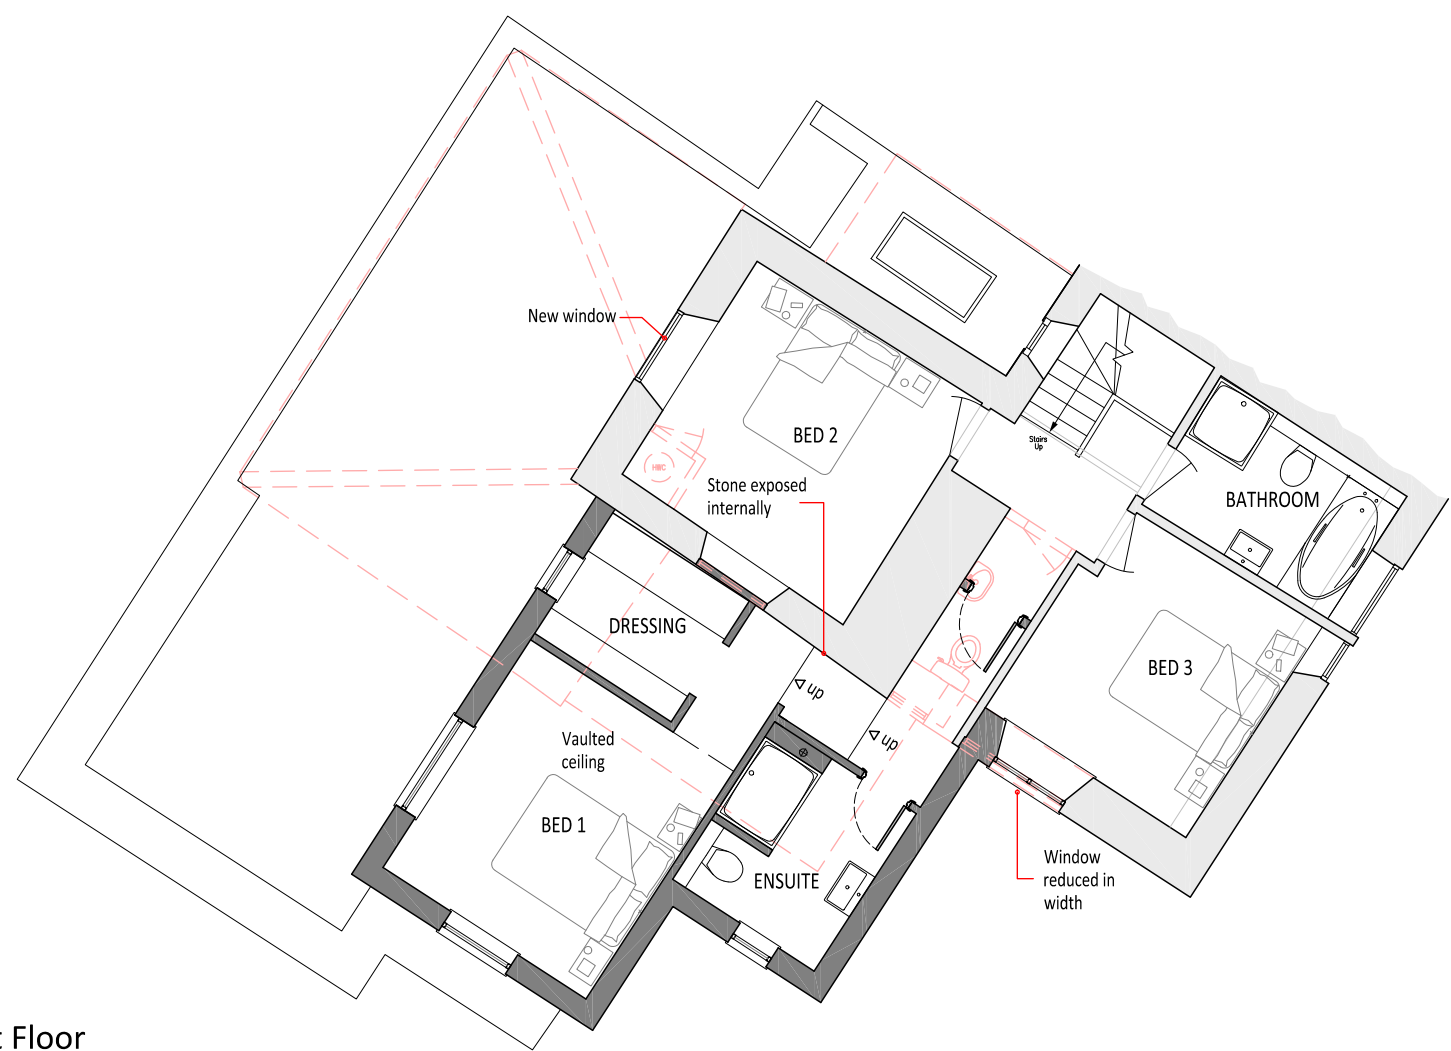


First Floor

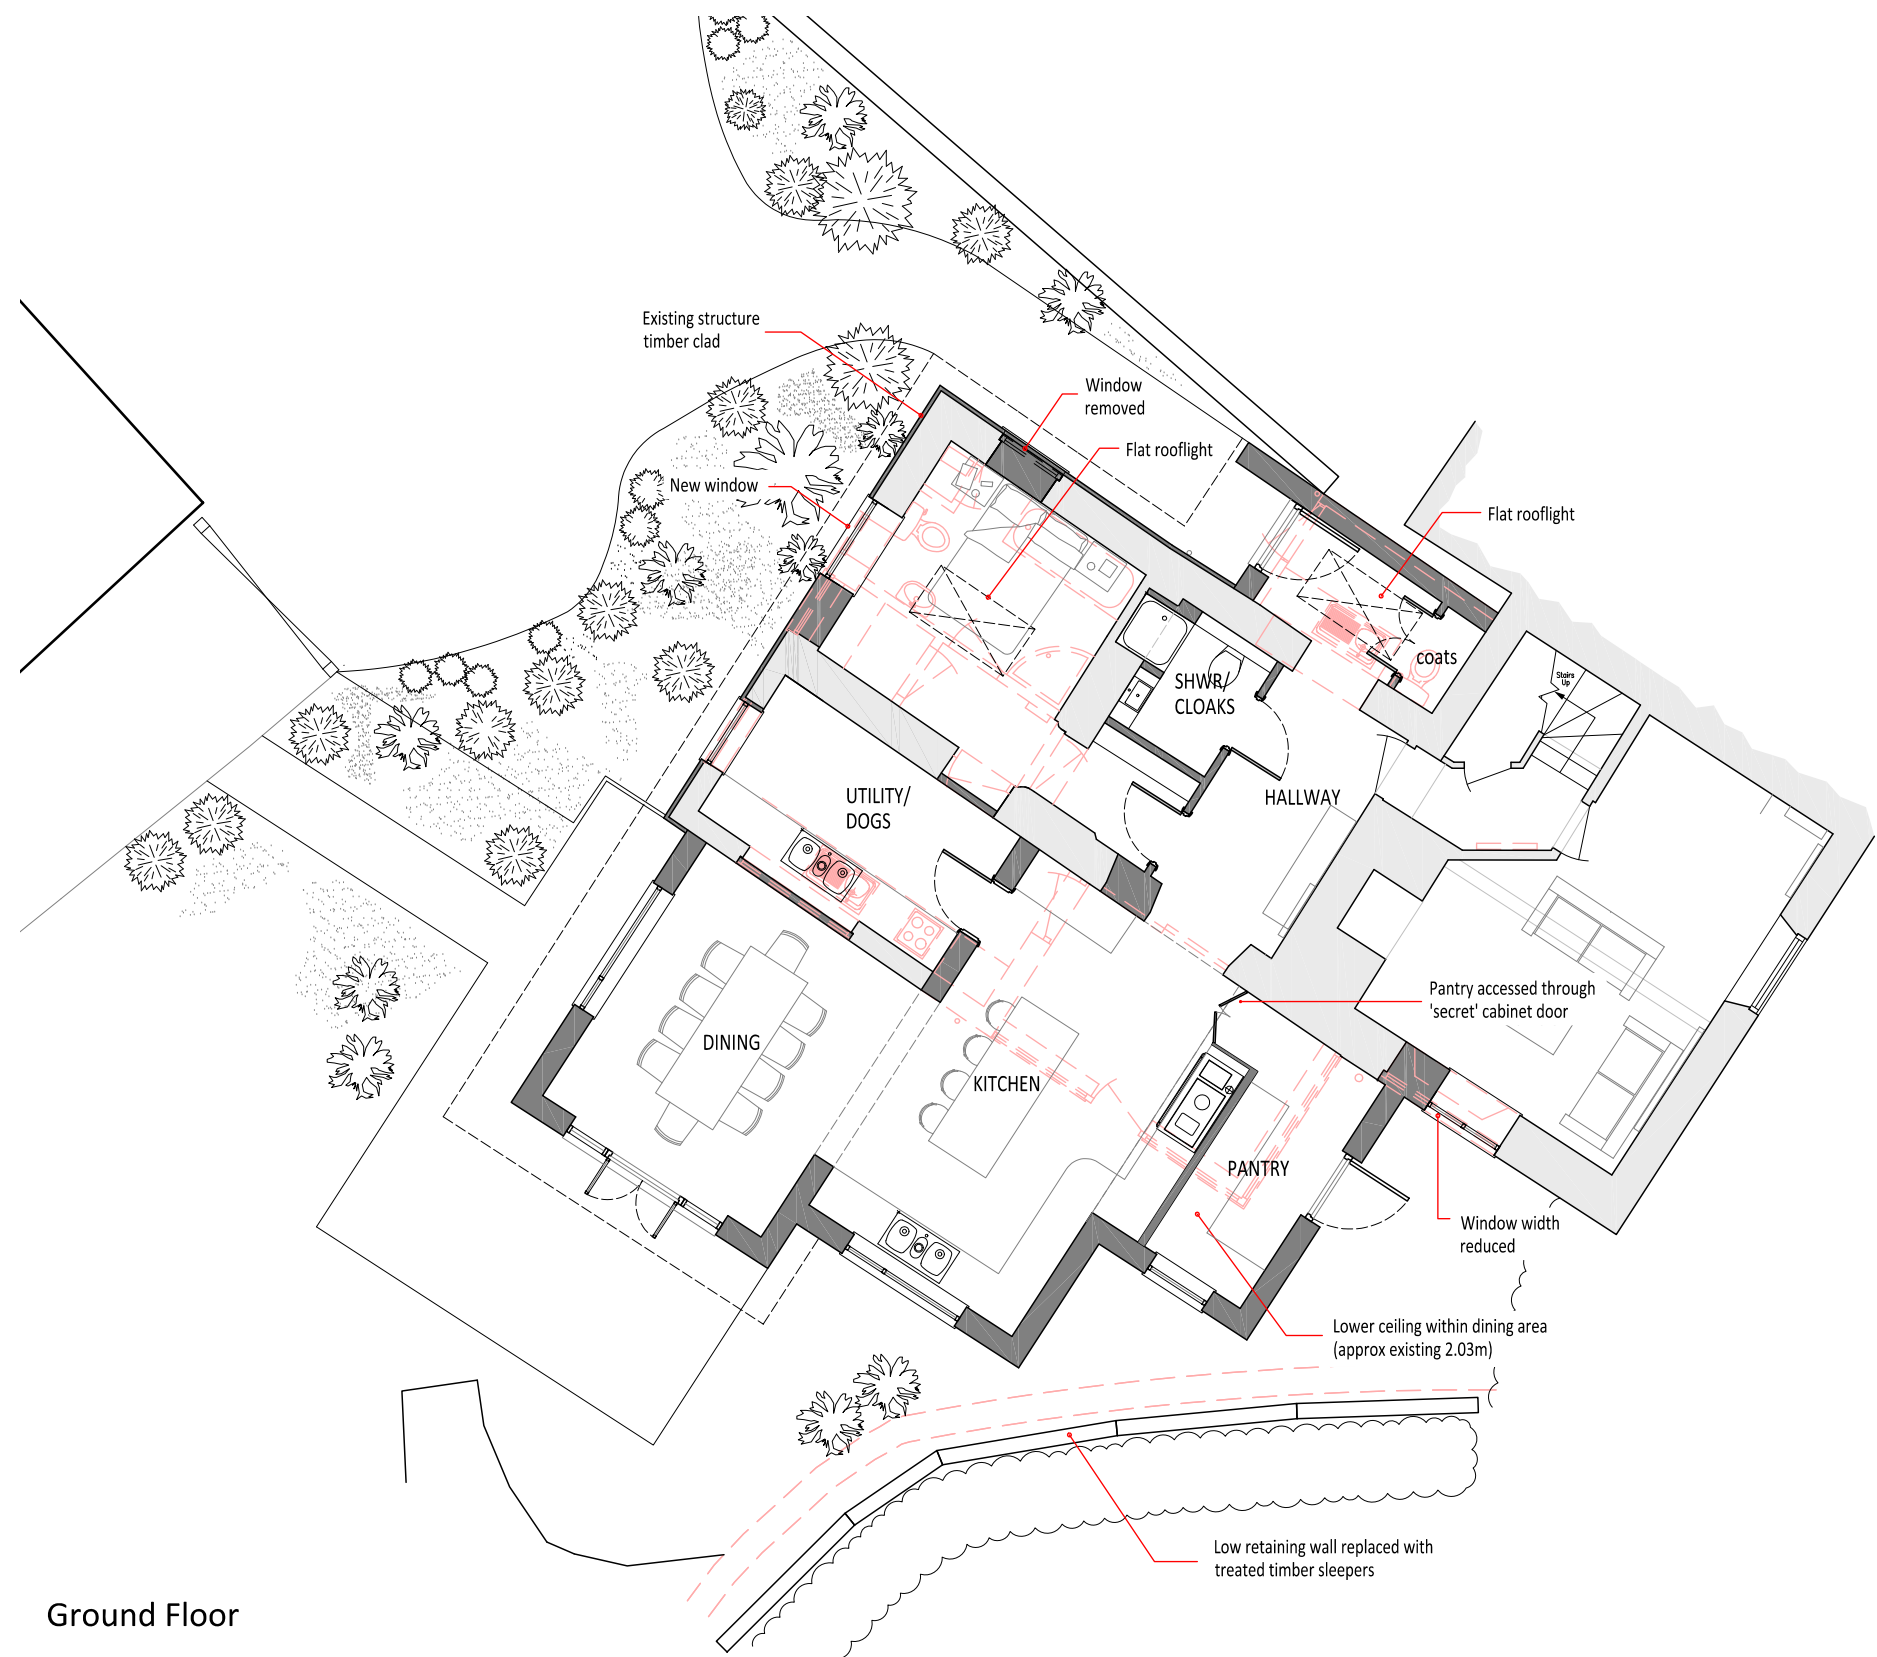

Ground Floor

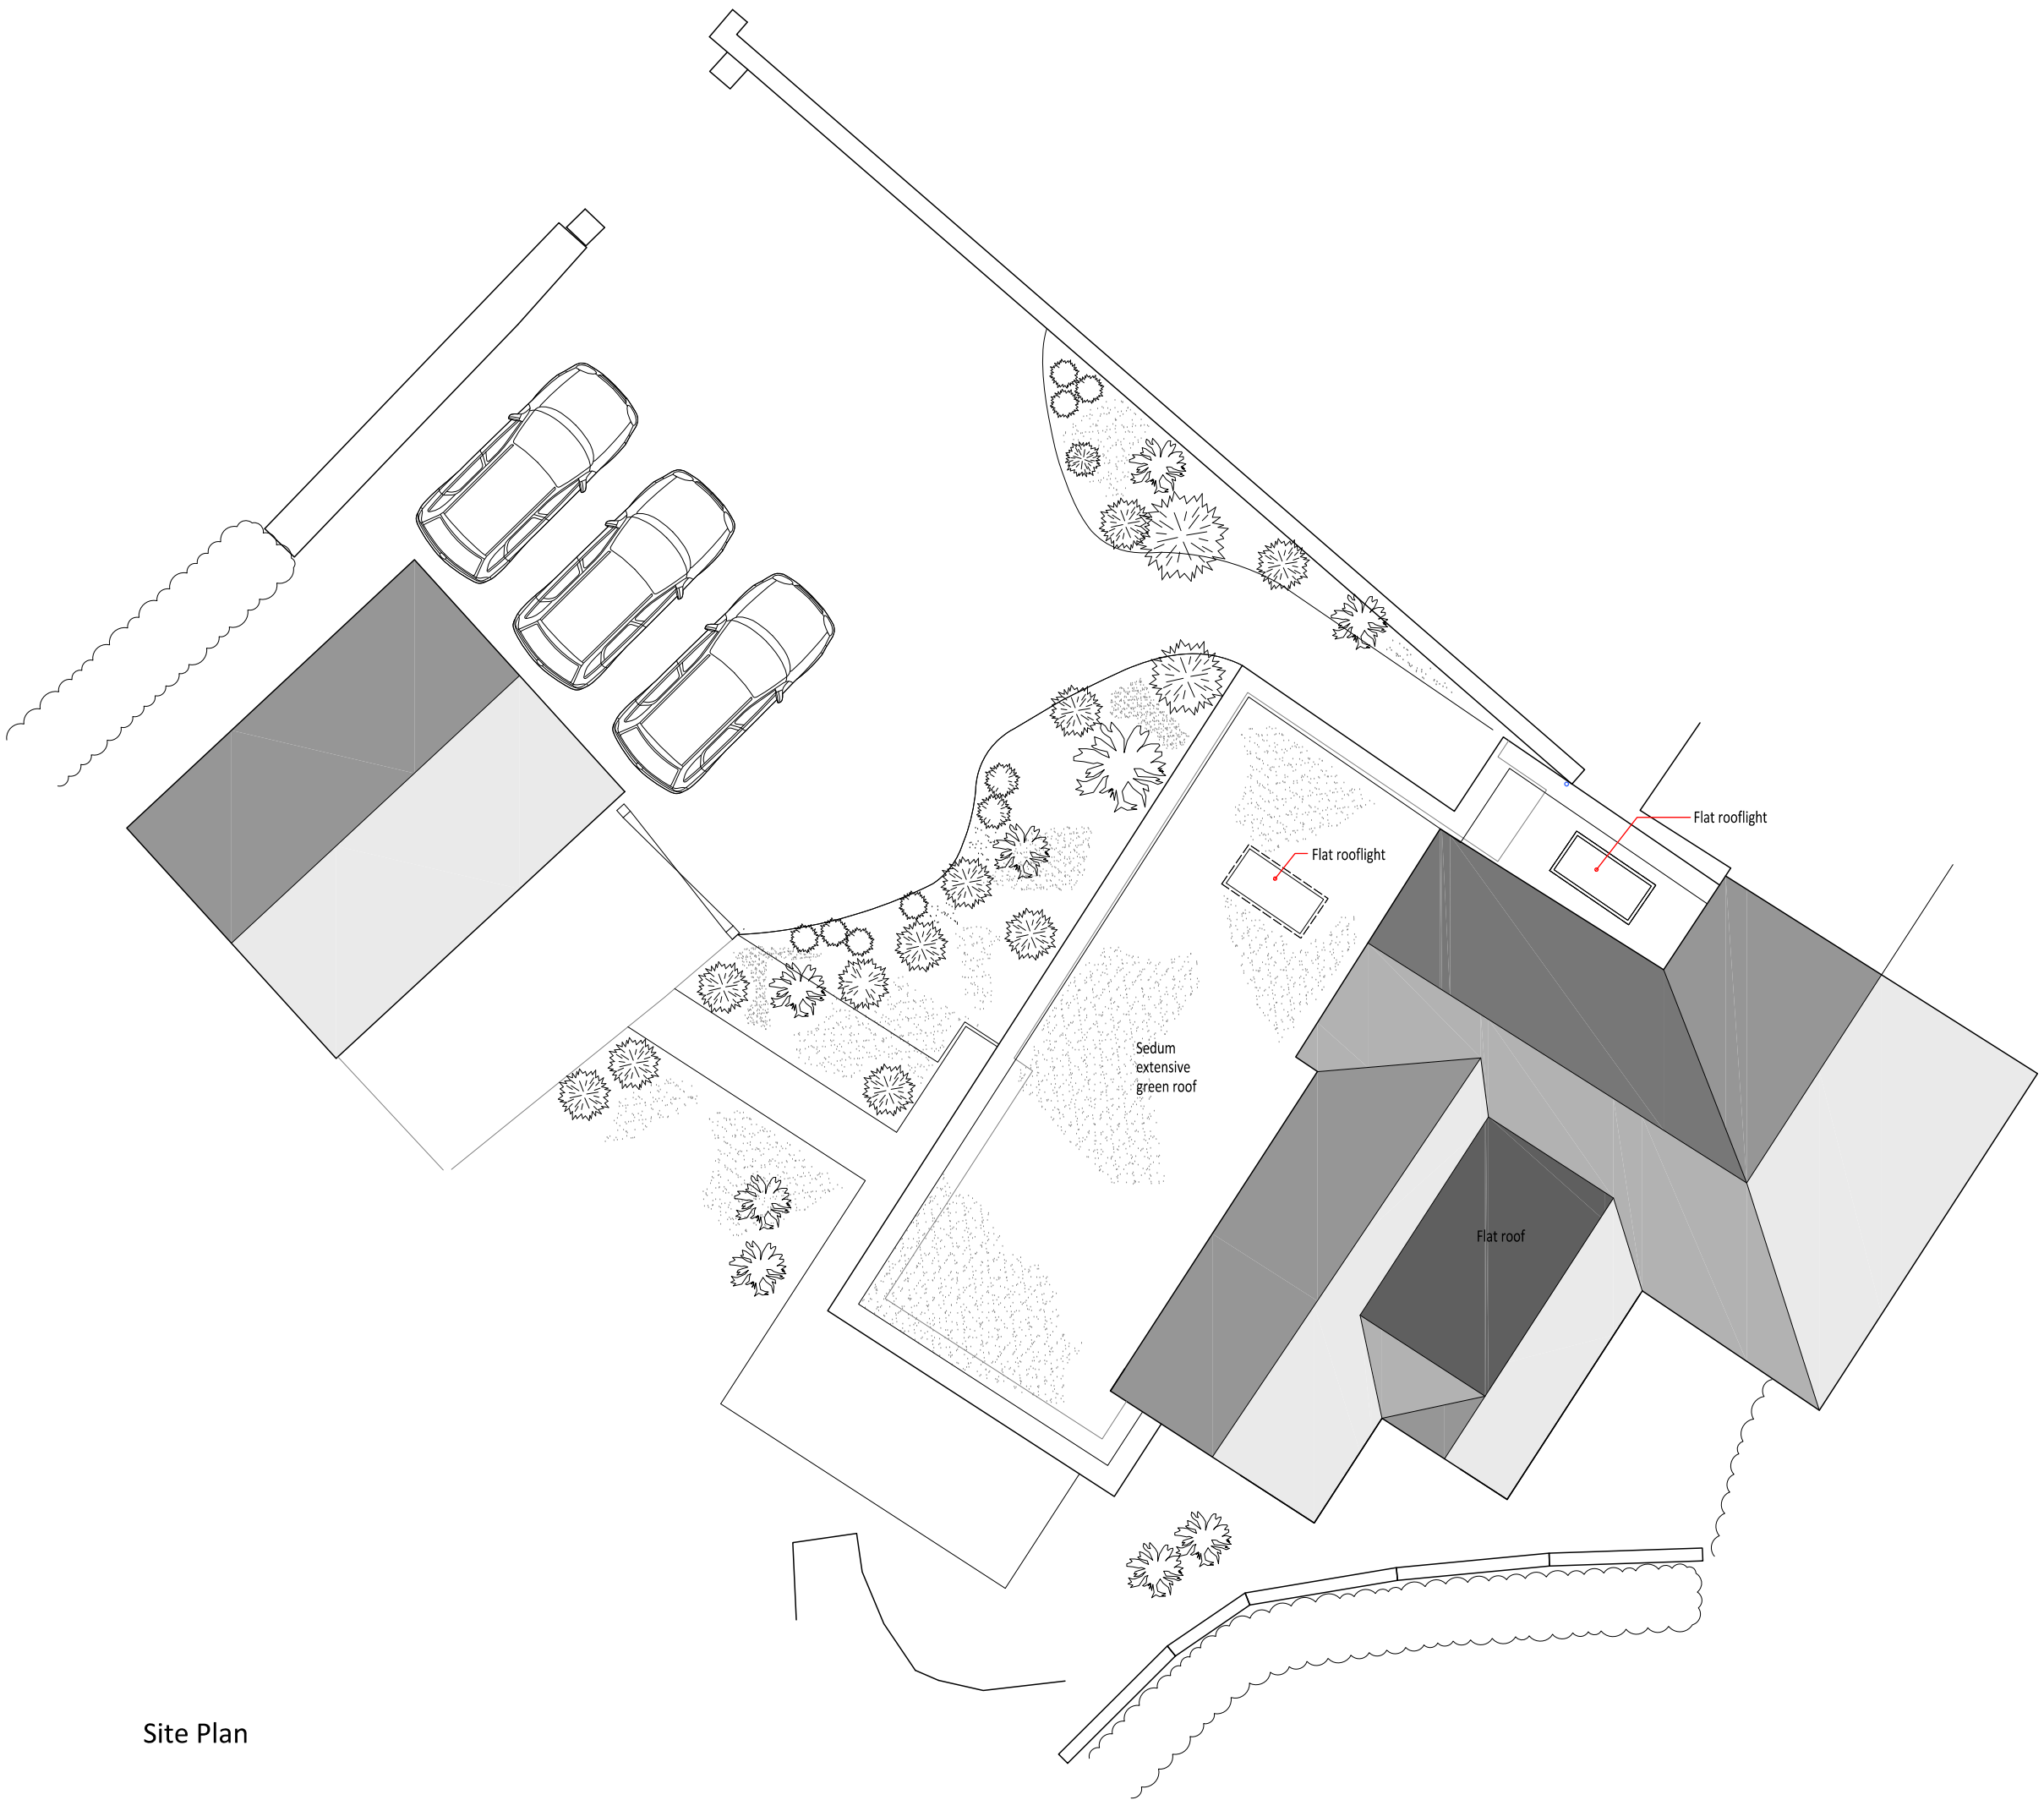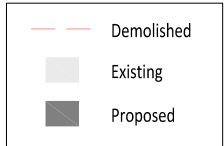

Site Plan

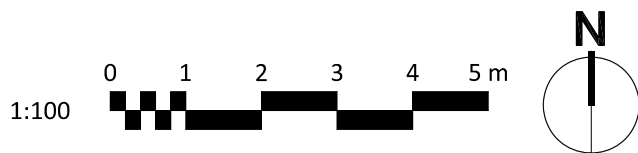

This drawing is the copyright of PKA Architects Ltd.
Registered in England and Wales No 8605083.
Do not rely on Scaled Dimensions - work to figured dimensions only.
If in doubt - ASK.
All dimensions to be checked on site by contractor.
Work to existing building features where appropriate.
Any copyright data on this drawing is reproduced under license

Date	No.	Revision Notes
25-02-2026	A	Roof plan and rear elevation corrected

PKA ARCHITECTS
PKA Architects Limited
Featherbrook, Whitley Road, Potterne, Devizes, Wiltshire SN10 5TD
tel: 01380 725688 | email: tom@pka-architects.com | www.pka-architects.com

RIBA Chartered Practice

Project Title:
Extension and Internal Alterations
Address:
172 Littleworth Lane, Whitley

Client:
Mr and Mrs Whittle

Sheet Title:
Revised scheme following meeting with Planning Officer

Scale	Drawn By	Date
1:100 @A1	tk/ rjm	25-02-2026

Project ID	Stage	Sheet No.	Revision
2148		PL-002-A	

Status:
PRELIMINARY FOR DISCUSSION ONLY

File Name:
2148 - PLAN 2.dwg

Stage Key
Ex - Existing
St - Sketch
Pl - Planning
WD - Working Drawings
MR - Building Preparation
TH - Tender
CR - Construction
AB - As Built