


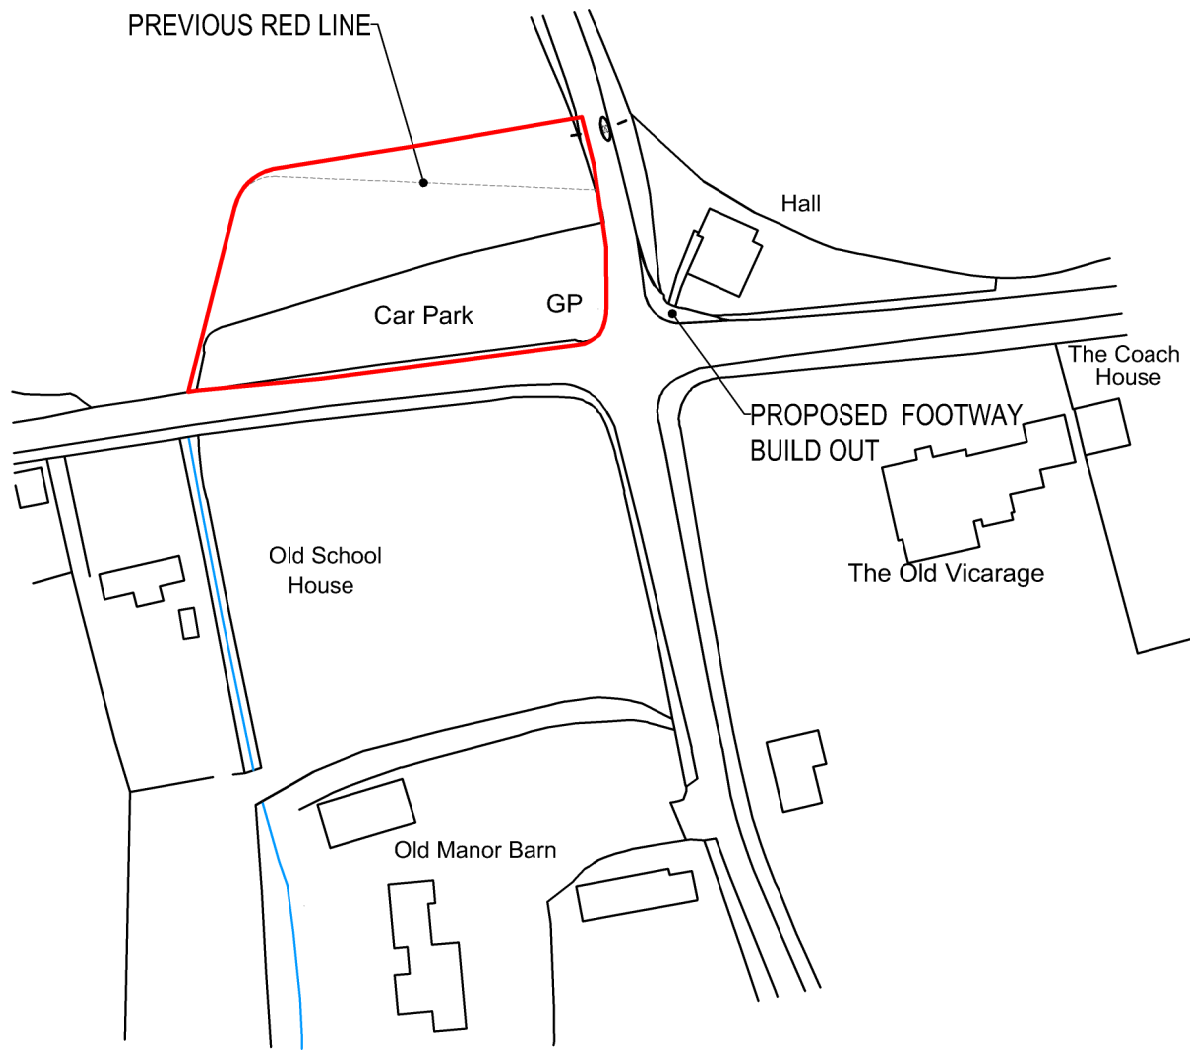




Ordnance Survey. (c) Crown Copyright 2022. All rights reserved. Licence number 100022432

LOCATION PLAN

SCALE 1:1250

0 25m 50m 75m

Scale bar (1:1250)

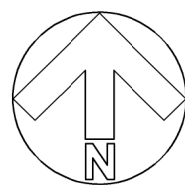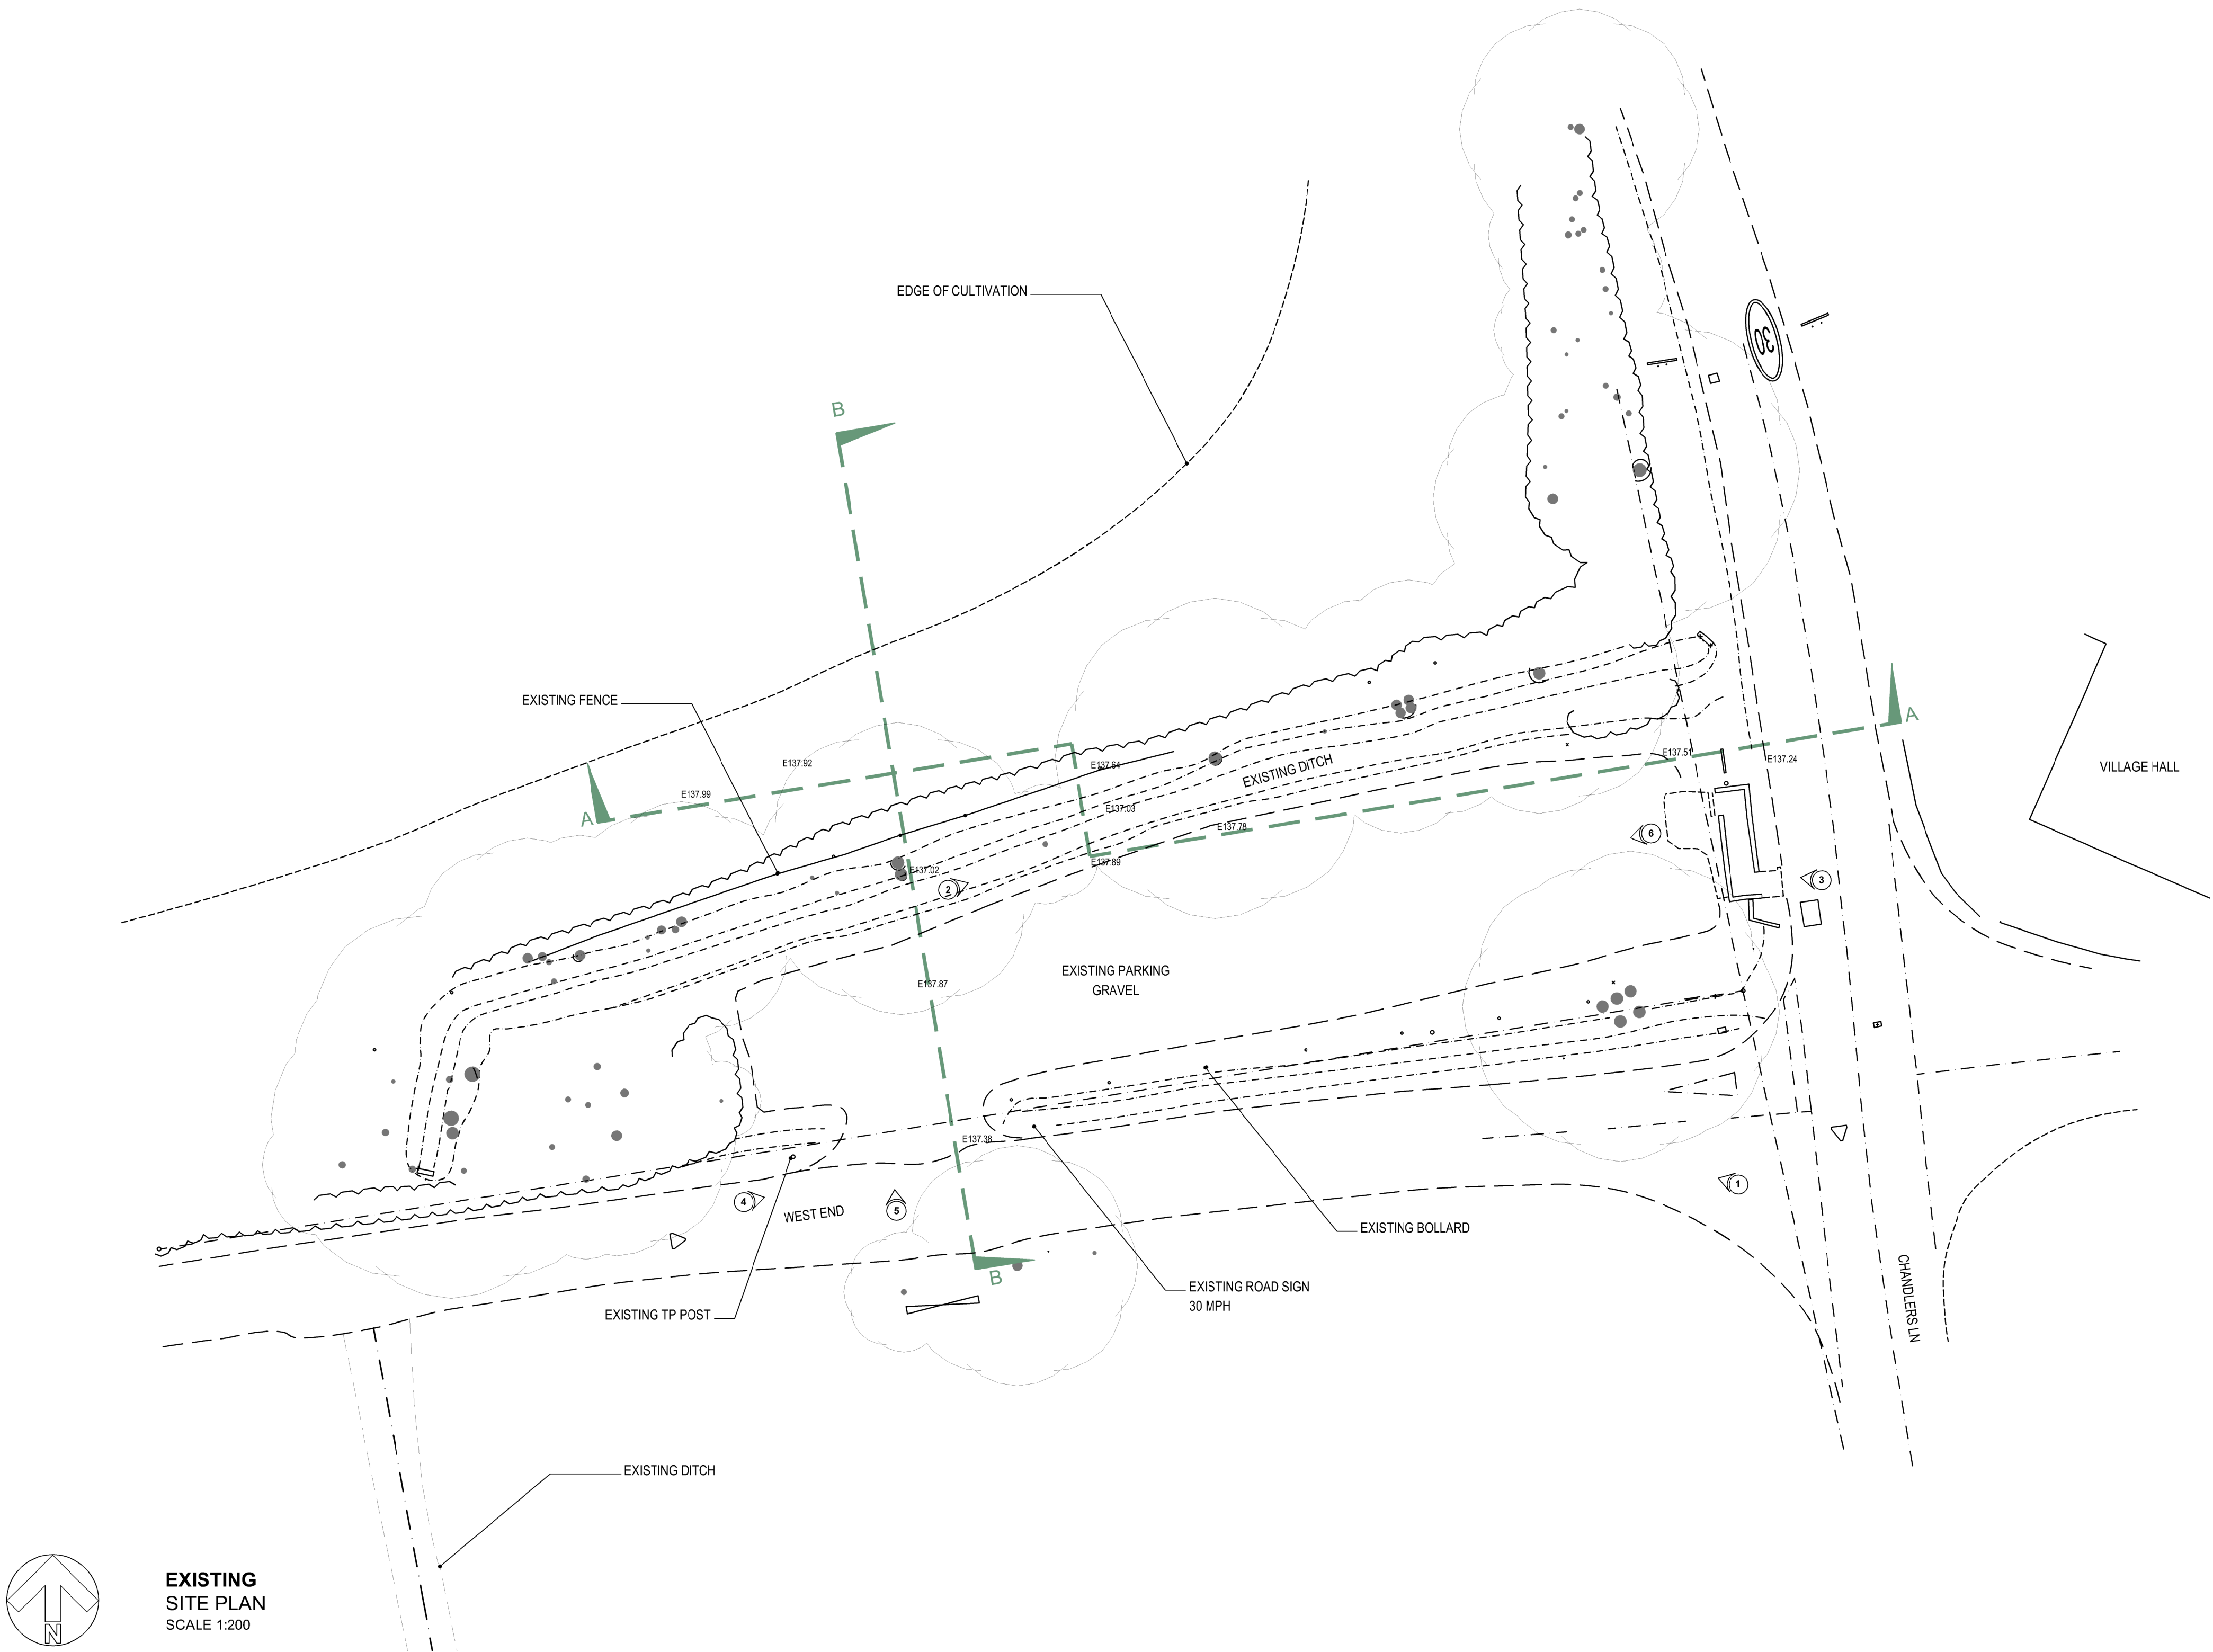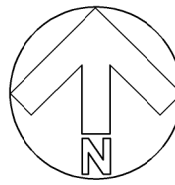

EXISTING
SITE PLAN

SCALE 1:200

0 2m 4m 6m 8m 10m 12m

Scale bar (1:200)

This drawing is based on the site
topographic survey information
provided by Matthew Read

D	11.12.24	Red line amended.	EK
C	06.12.24	Red line amended.	EK
B	25.01.24	Red line amended to include proposed footway build out.	JG
A	15.12.22	Red line on locaton plan shown	EK
Rev.	Date		Init

CLIENT

BISHOPS CANNINGS
PARISH COUNCIL

PROJECT

VILLAGE HALL PARKING

DRAWING

EXISTING SITE PLANS

DRAWN:	Date:	Scale:
EK	21/10/2022	1:200@ A1
Drawing number:	3740-01	Rev. D

DOLMAN

ARCHITECTURAL DESIGNERS BUILDING SURVEYORS
COST CONSULTANTS CDM PRINCIPAL DESIGNERS
Sussex House
Bath Road
Devizes
Wiltshire SN10 2AF
Tel: 01380 729456
Web: www.dolmansurveyors.co.uk
Email: info@dolmansurveyors.co.uk