




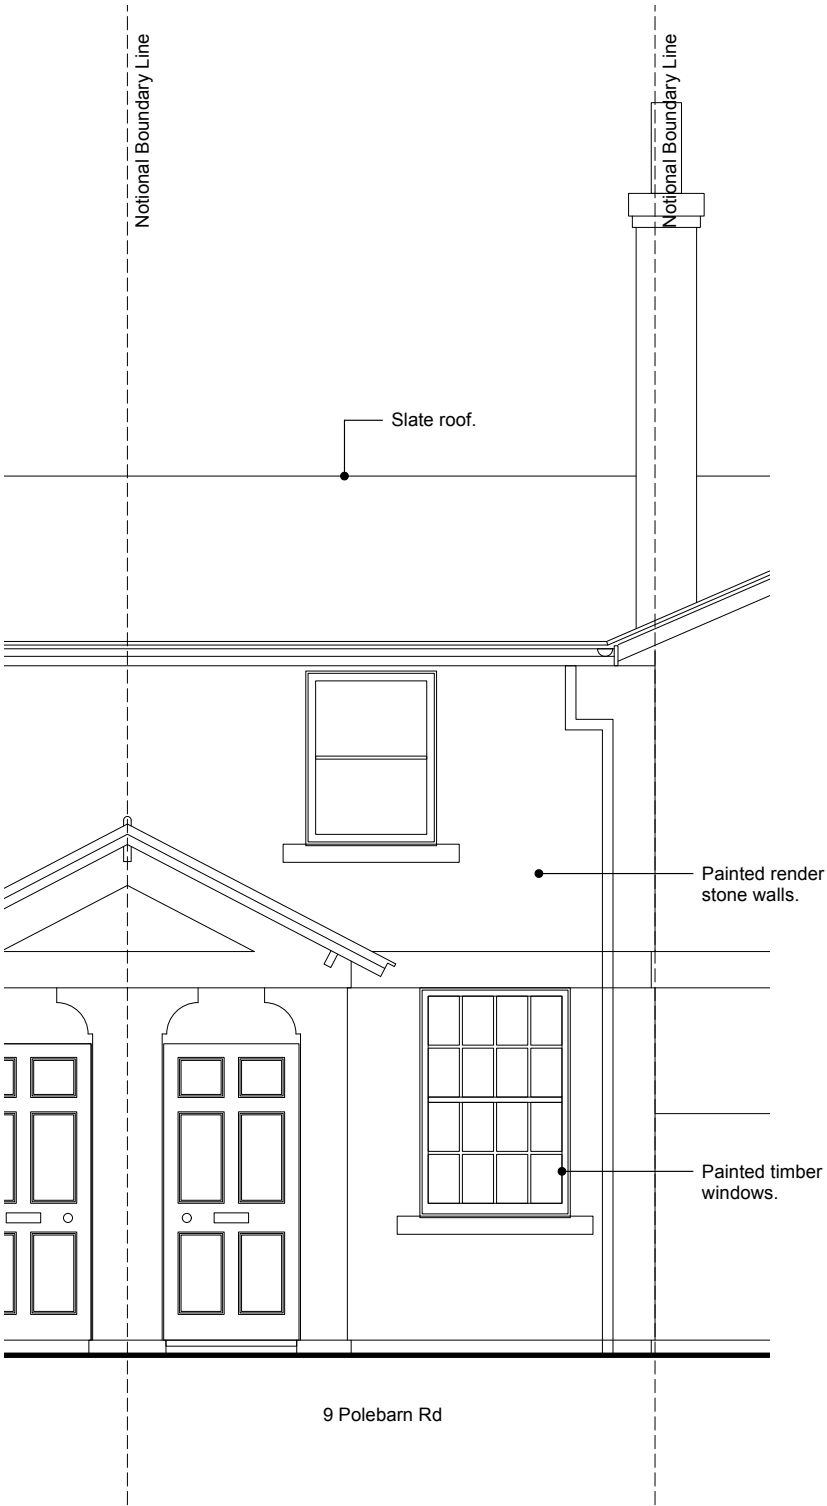

EXISTING FRONT ELEVATION
SCALE 1:50

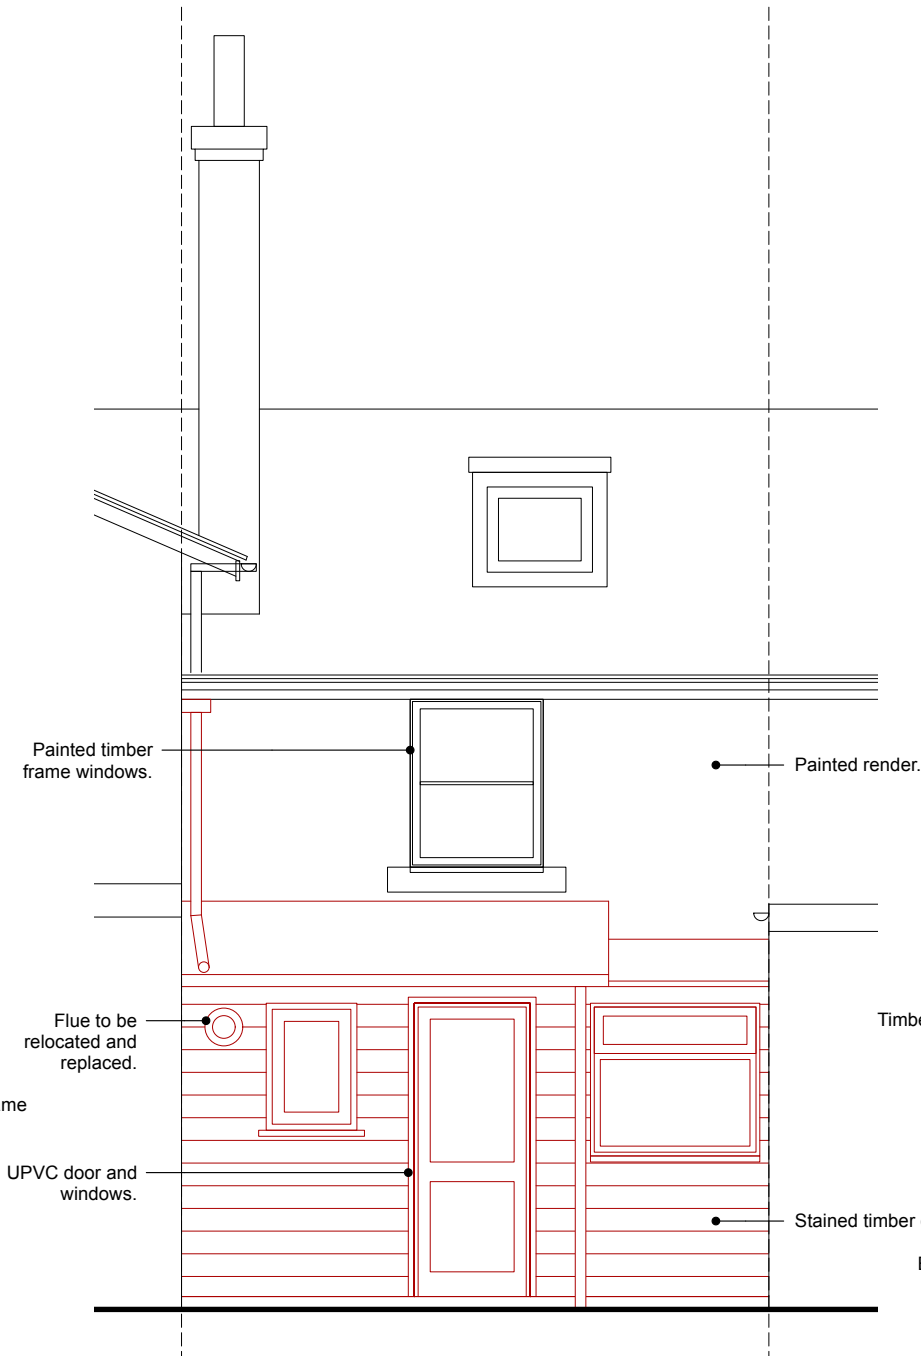

EXISTING REAR ELEVATION
SCALE 1:50

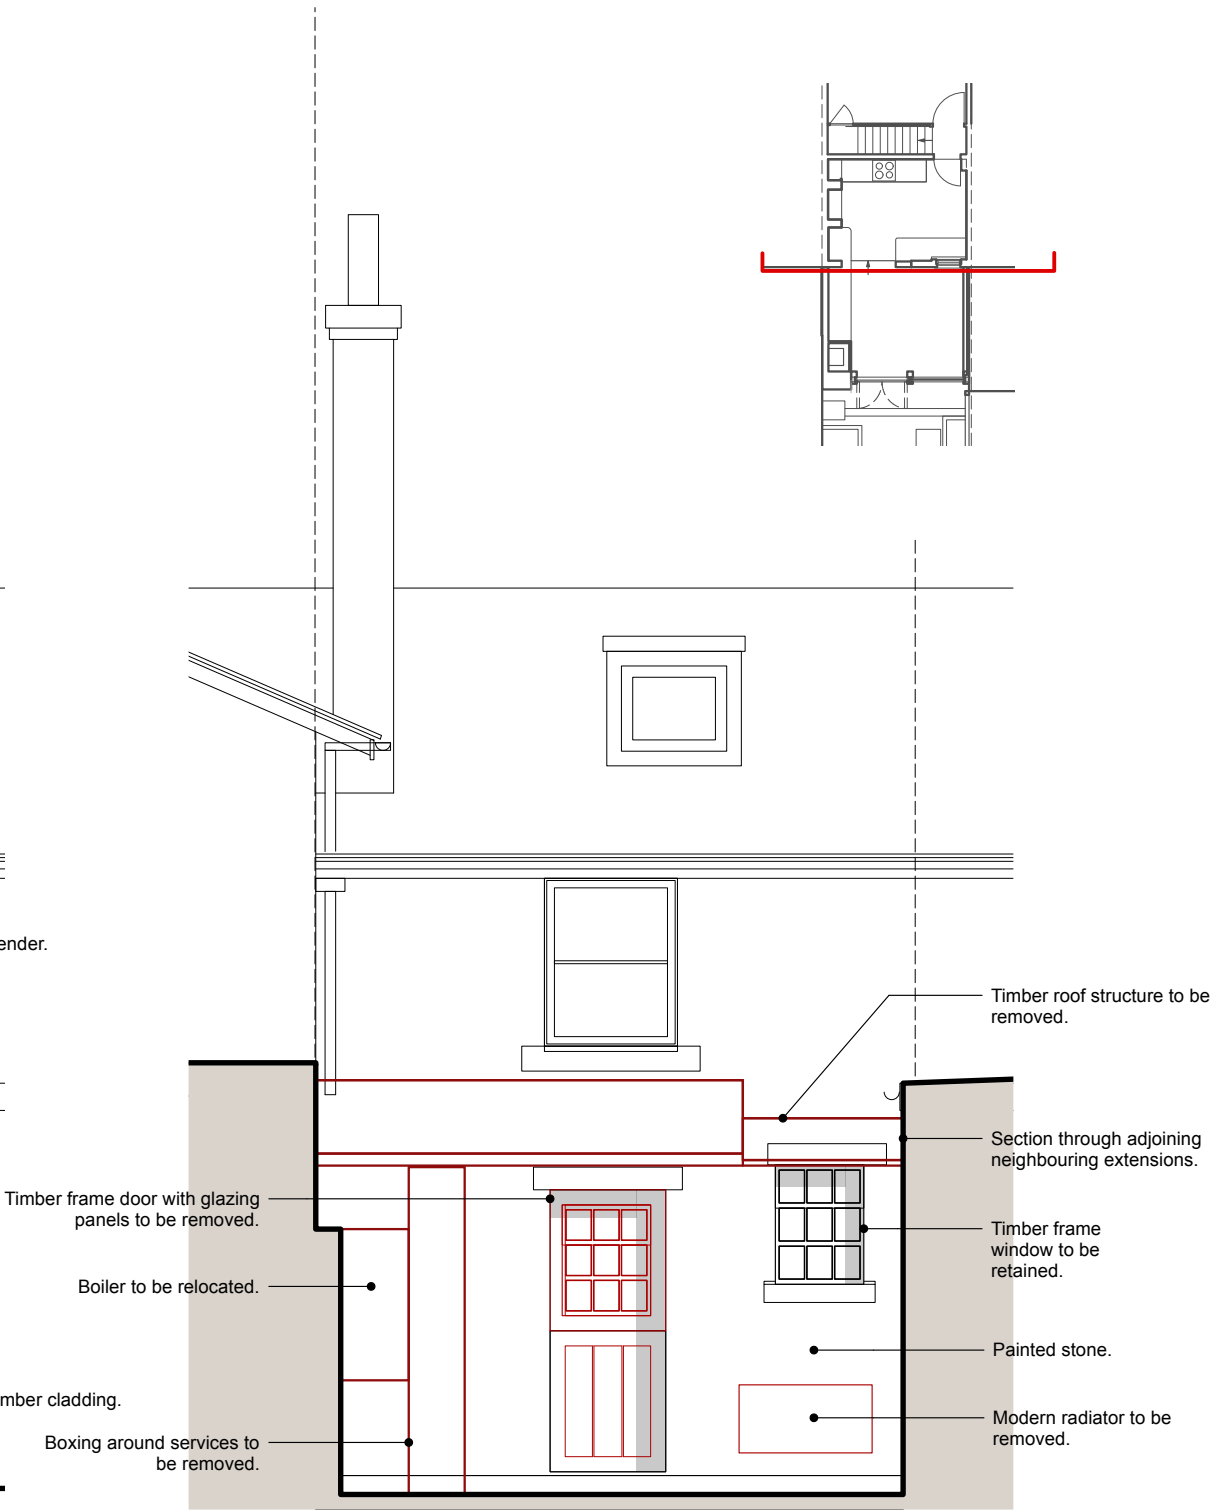

EXISTING REAR HOUSE WALL ELEVATION
SCALE 1:50

General Note:
Red Lines/Fill = Fabric to be Removed.

0 2 m

studio fourpointten
studio@fourpointten.co.uk
01225 688410

This drawing is not for construction purposes.

DRAWING Existing Elevations

DRAWING NO. 104-E-03

SCALE 1:50@A3

REV.

DATE March 2026

JOB TITLE 9 Polebarn Road, Trowbridge BA14 7EG