



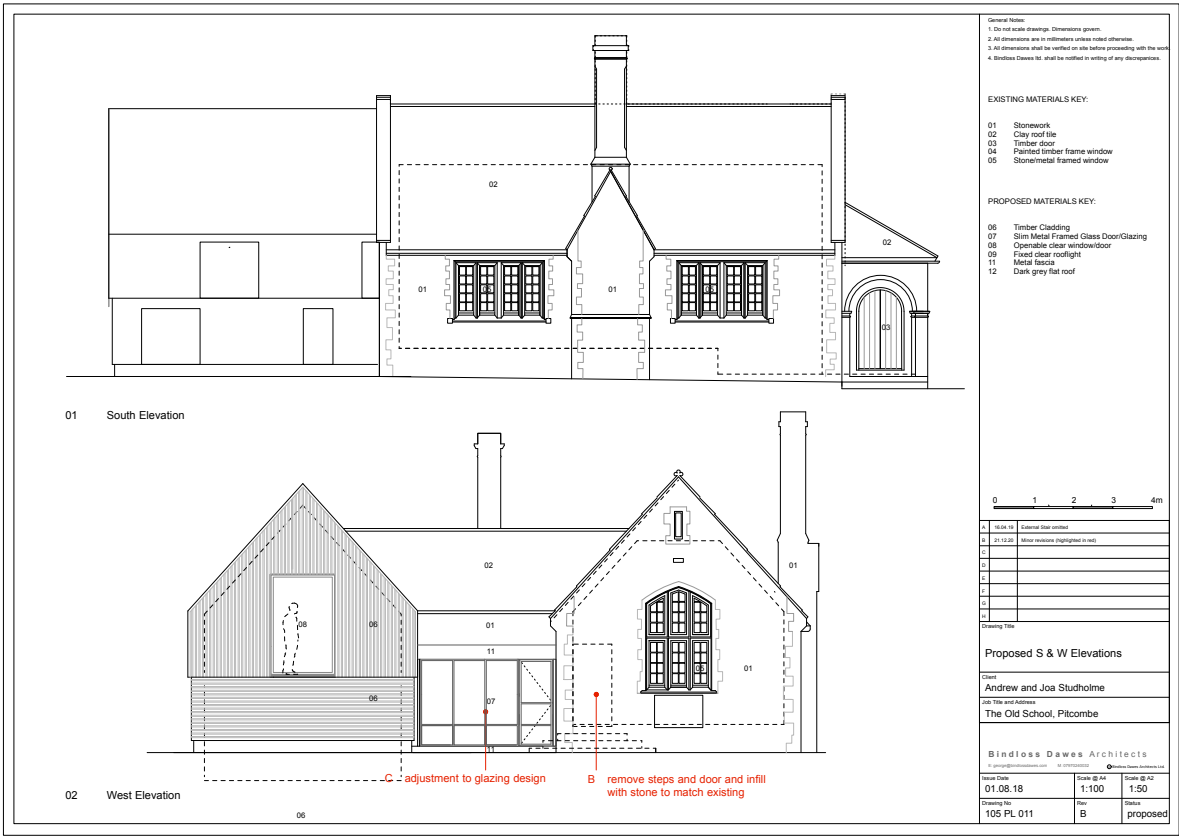

Somerset Council - 2003702LBC

- The Old School Church Lane Pitcombe Bruton BA10 0PE

- Alterations to the original school house building, including infilling west facing door and removal of internal raised floor and mezzanine. Minor amendments to the approved extension under approval 19/00316/LBC, including adjustment to window composition and link window elevation. (Revised application)

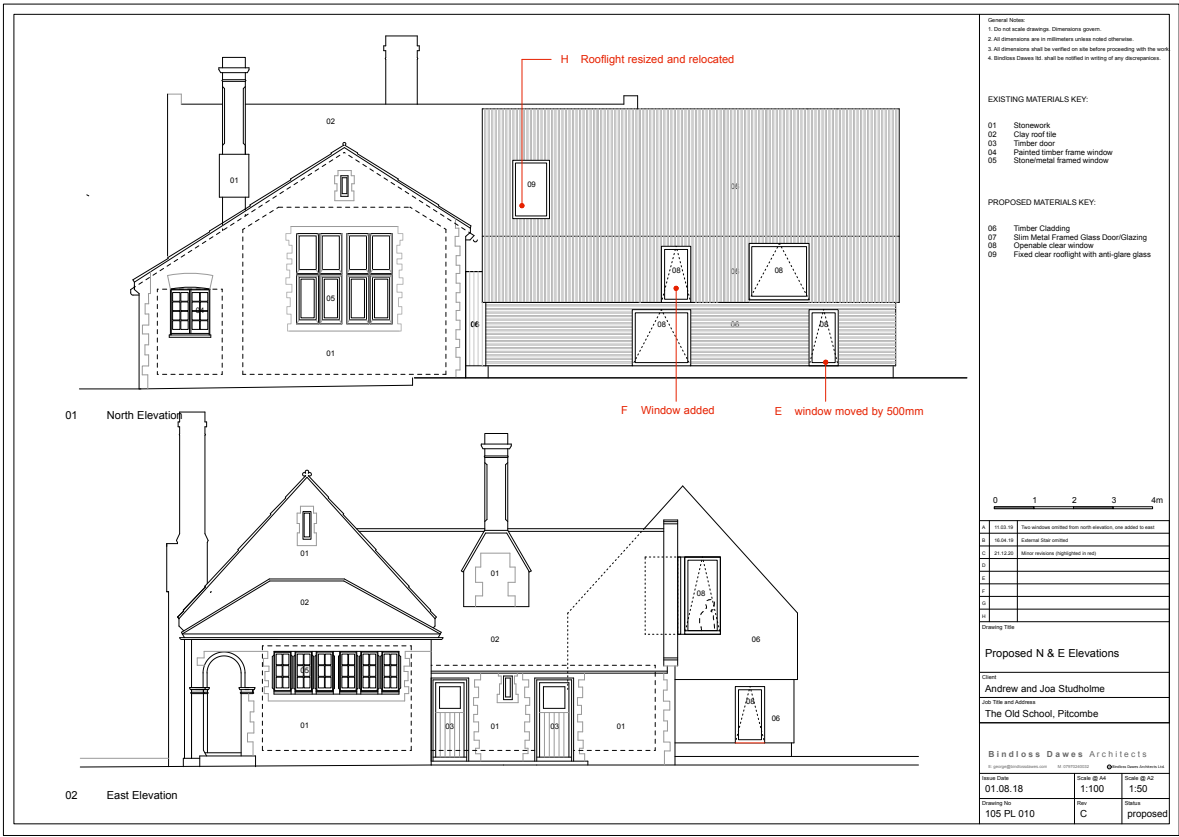

This drawing is the copyright of PKA Architects Ltd. Registered in England and Wales No 8605083. Do not rely on Scaled Dimensions - work to figured dimensions only. If in doubt - ASK. All dimensions to be checked on site by contractor. Work to existing building features where appropriate. Any OS copyright data on this drawing is reproduced under license.

Date	No.	Revision	Notes
------	-----	----------	-------



PKA Architects Ltd RIBA CHARTERED PRACTICE
Featherbrook, Whitley Road, Potterne, Devizes, Wiltshire. SN10 5TD
tel 01380-725688 tom@pka-architects.com www.pka-architects.com

Project Title
Extension and Internal Alterations

Address
172 Littleworth lane, Whitley.

Client
Mr & Mrs Whittle

Sheet Title
Precedent project 4

Scale NA	Drawn By SW	Date 02/04/2026
-------------	----------------	--------------------

Project ID.	Stage.	Sheet No.	Revision.
2148	PC-04	-	-

Status	Stage Key.
PLANNING	EX - Existing SK - Sketch PL - Planning WD - Working Drawings BR - Building Regulations TN - Tender CN - Construction AB - As Built
File Name	
Precedent sheets.vwx	