





North West Elevation



South West Elevation

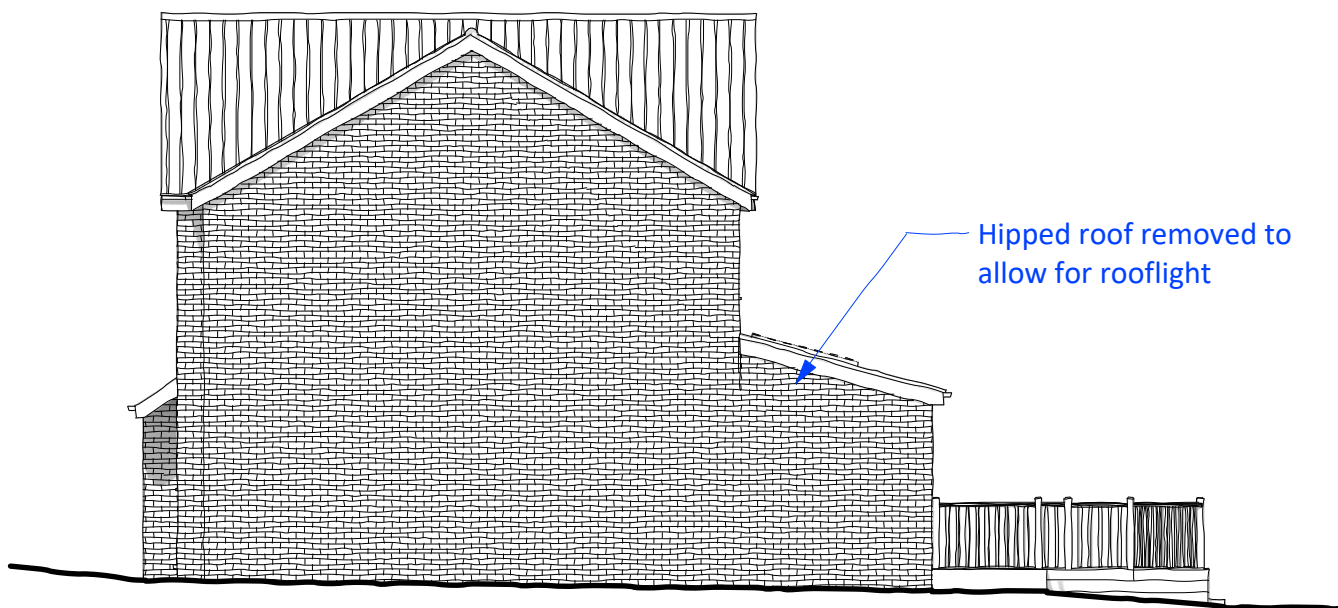



South East Elevation

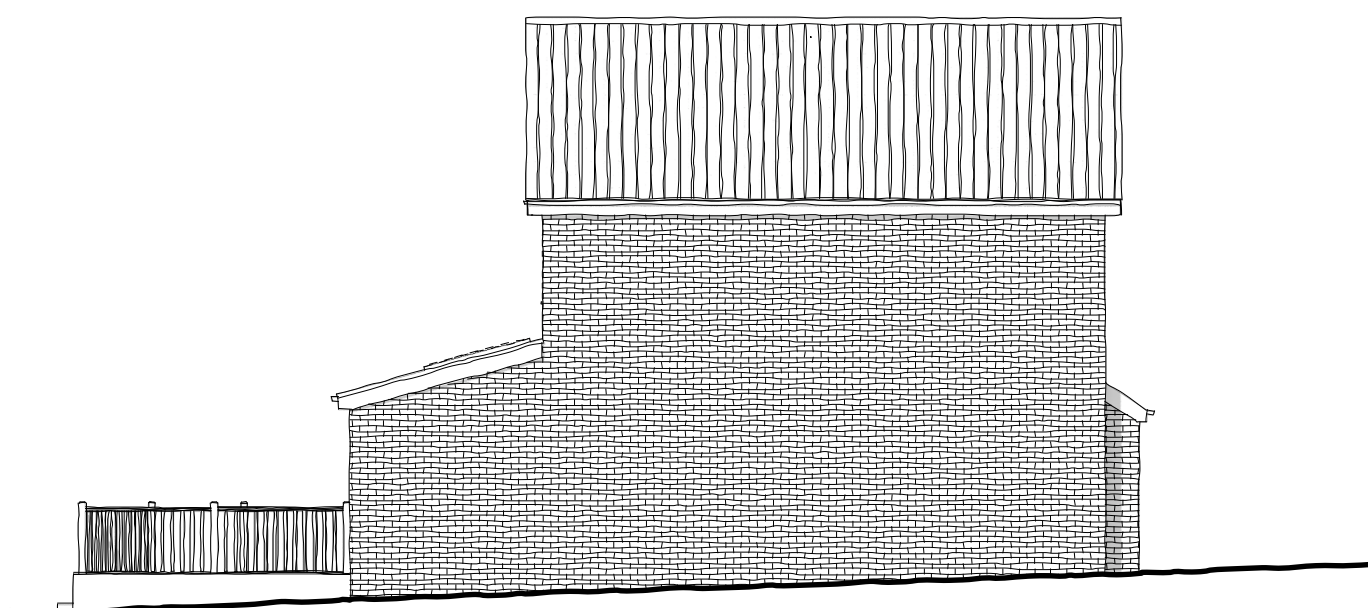




North East Elevation




Location Plan 1:1250

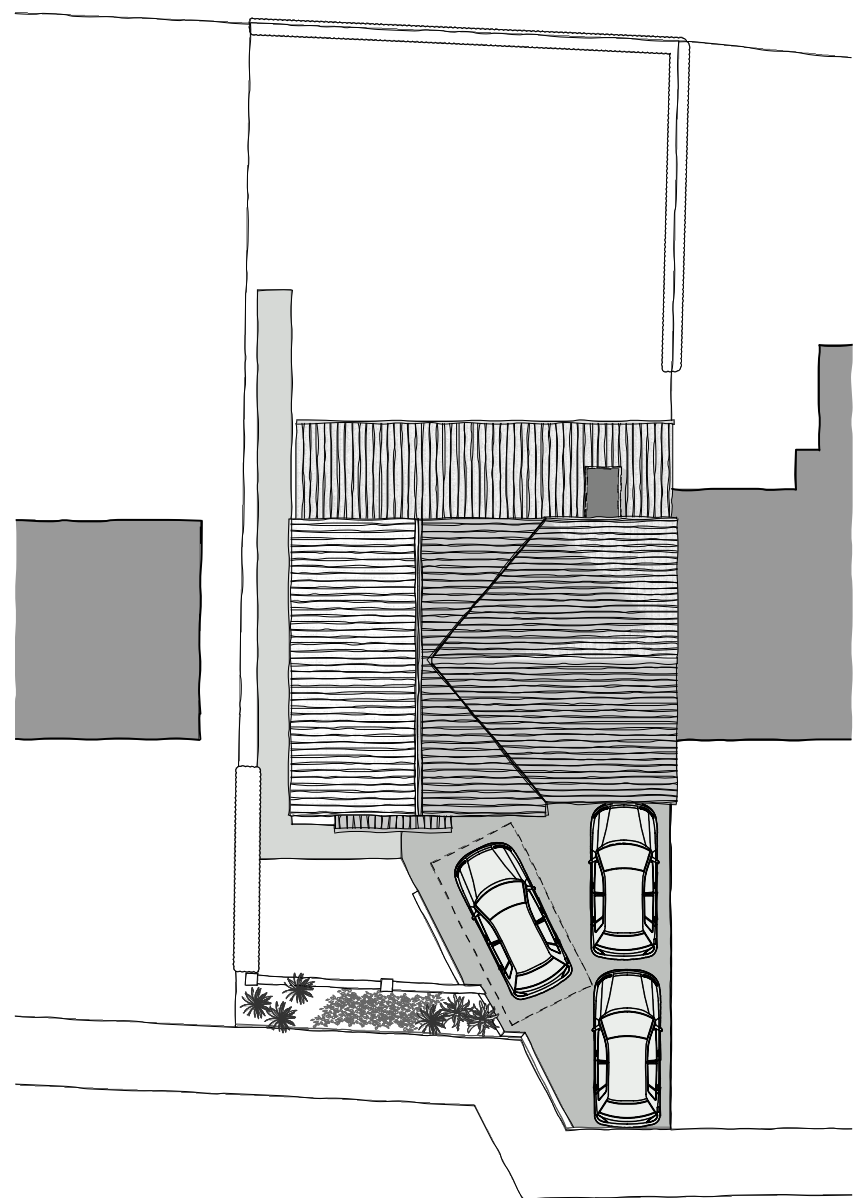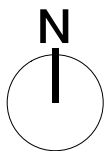



Roof/ Block Plan 1:200

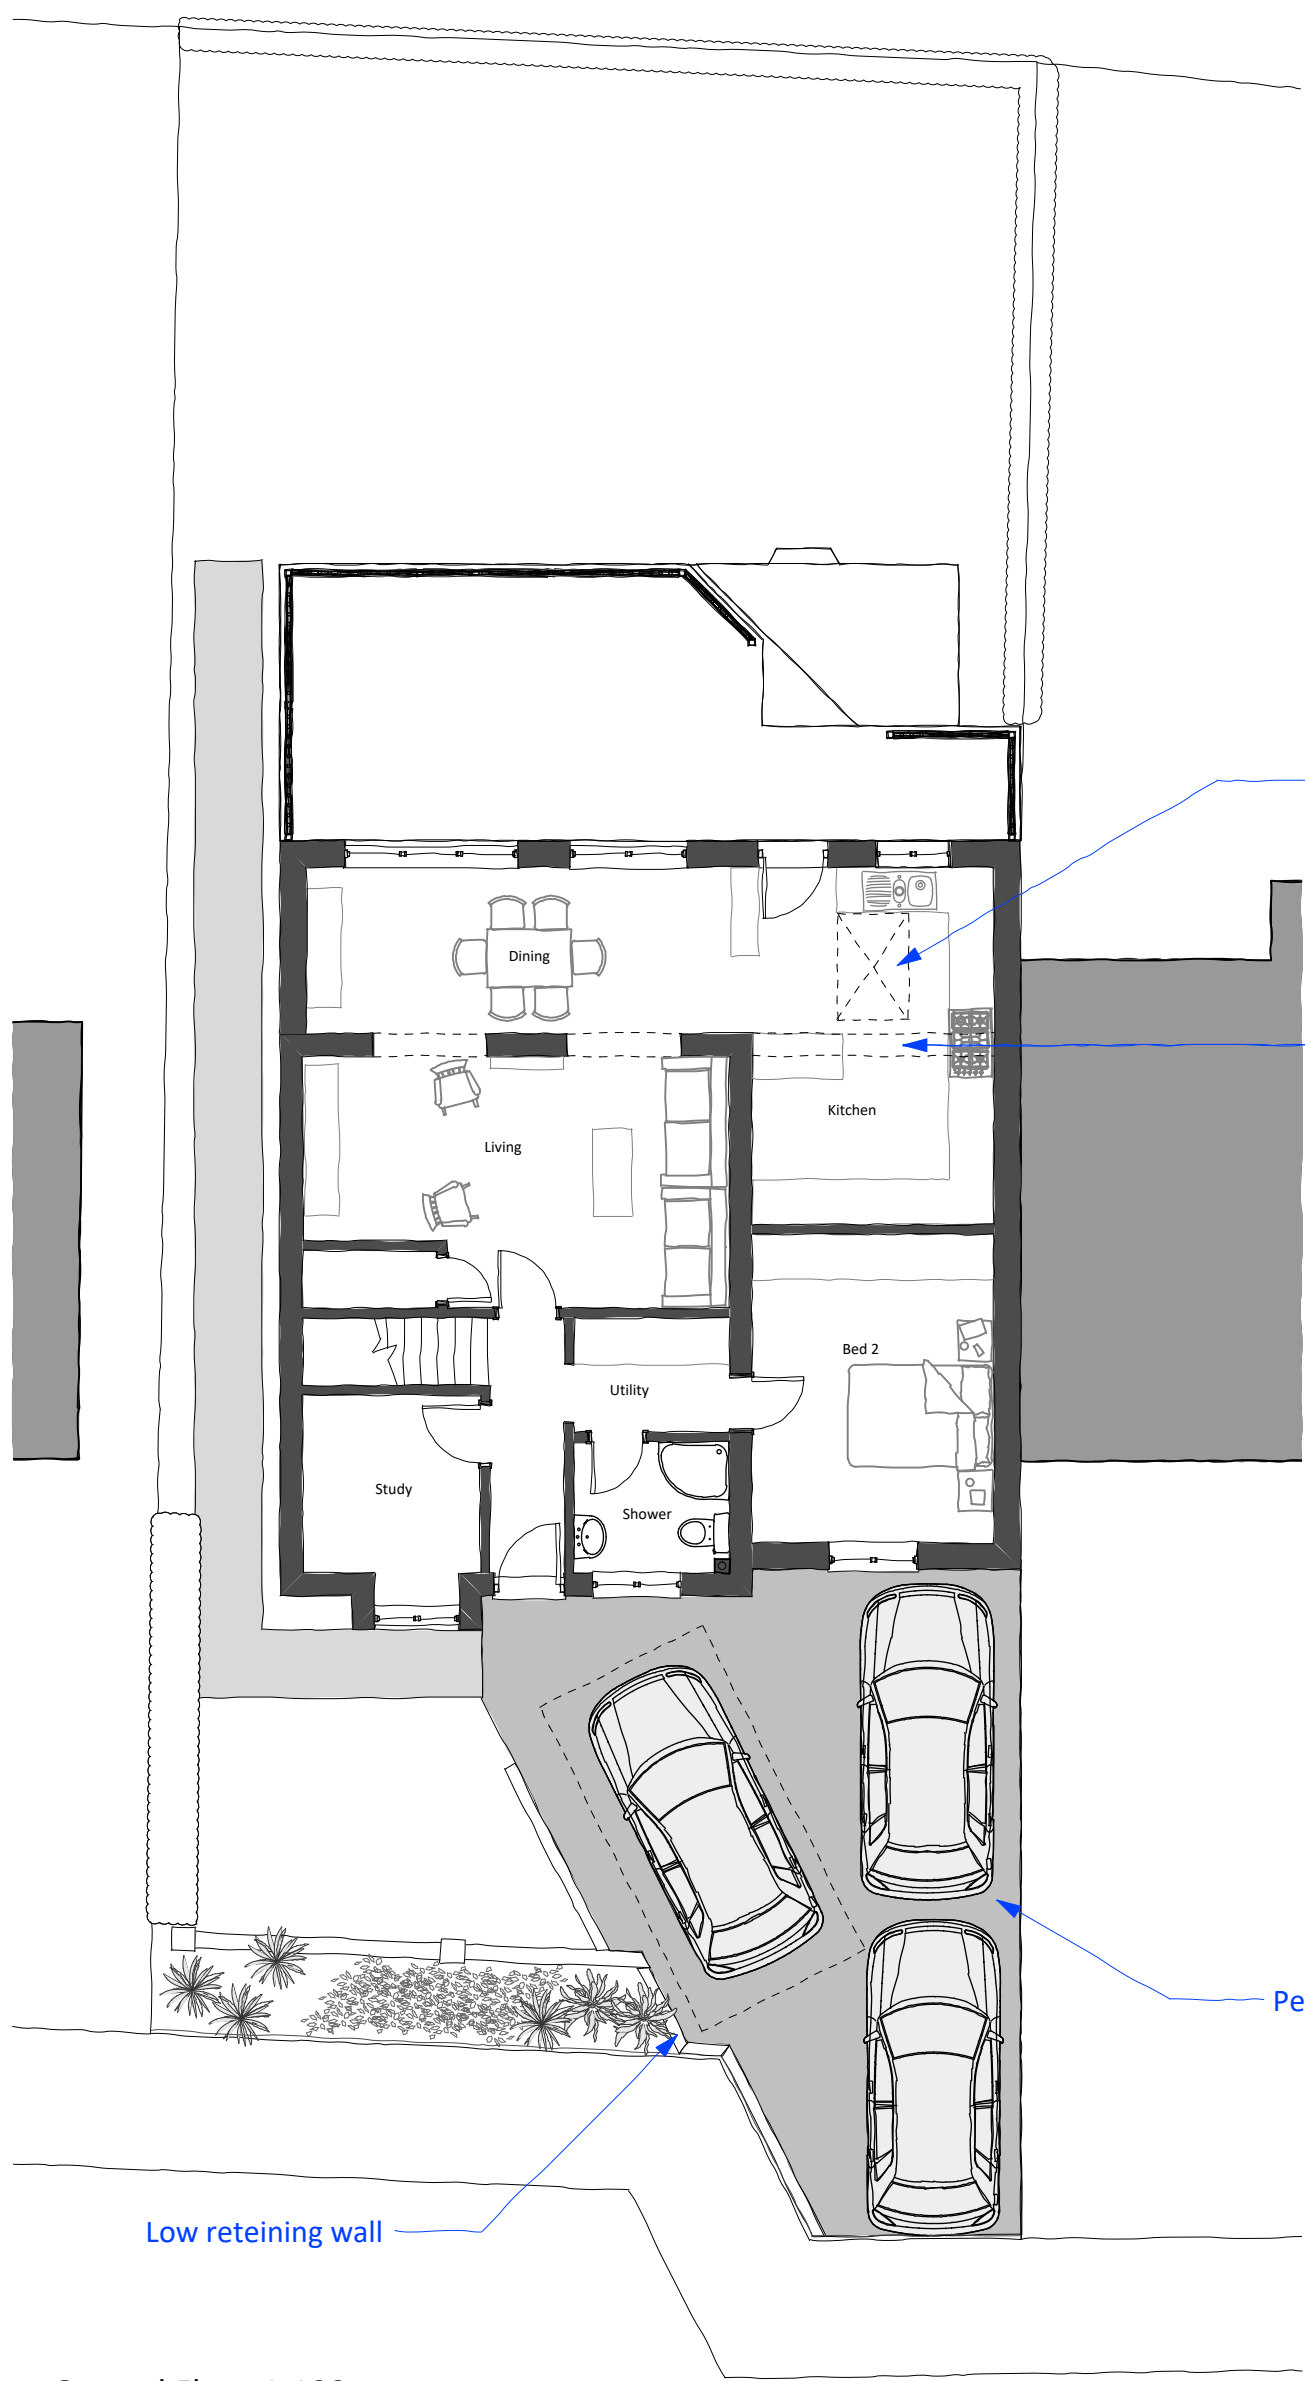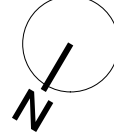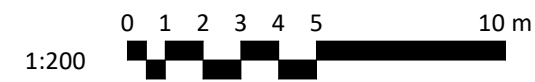

Ground Floor 1:100

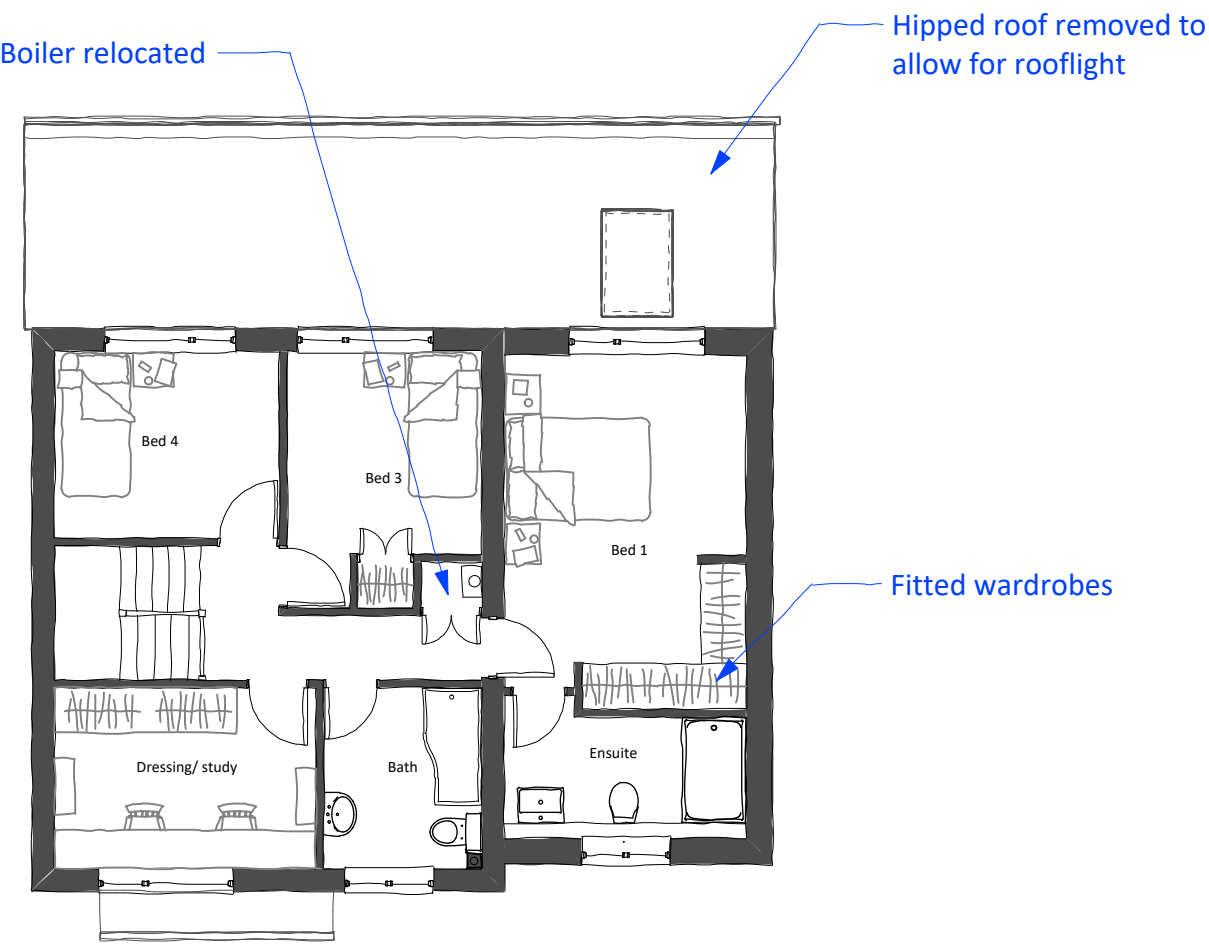

First Floor 1:100

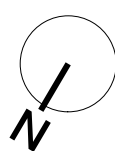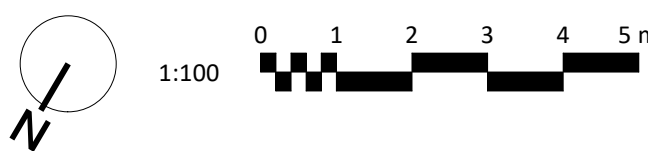

This drawing is the copyright of PKA Architects Ltd.
Registered in England and Wales No 8605083.
Do not rely on Scaled Dimensions - work to figured dimensions only. If in doubt - ASK.
All dimensions to be checked on site by contractor
Work to existing building features where appropriate
Any OS copyright data on this drawing is reproduced under license

Date	No.	Revision Notes
------	-----	----------------



PKA Architects Ltd
Featherbrook, Whitley Road, Potters, Devizes, Wiltshire. SN10 3TD.
tel 01380 725688 tom@pka-architects.com www.pka-architects.com

Project Title
Master bedroom Extension

Address
39 Crawley Crecent, Trowbridge,
Wiltshire. BA14 9SP

Client
Mr and Mrs Swindell

Sheet Title
Proposed Elevations, Floor, Site and
Location Plans

Scale
1:1250/200/100 @A1

Drawn By
TK

Date
22/04/2026

Project ID
2175

Stage
PL-001

Status
Planning Issue

Stage Key
EX - Existing
SK - Sketch
PL - Planning
WD - Working
DR - Drawings
BR - Building
Regulations
TR - Tender
CN - Construction
AB - As Built

File Name
2175-DESIGN.vwx