
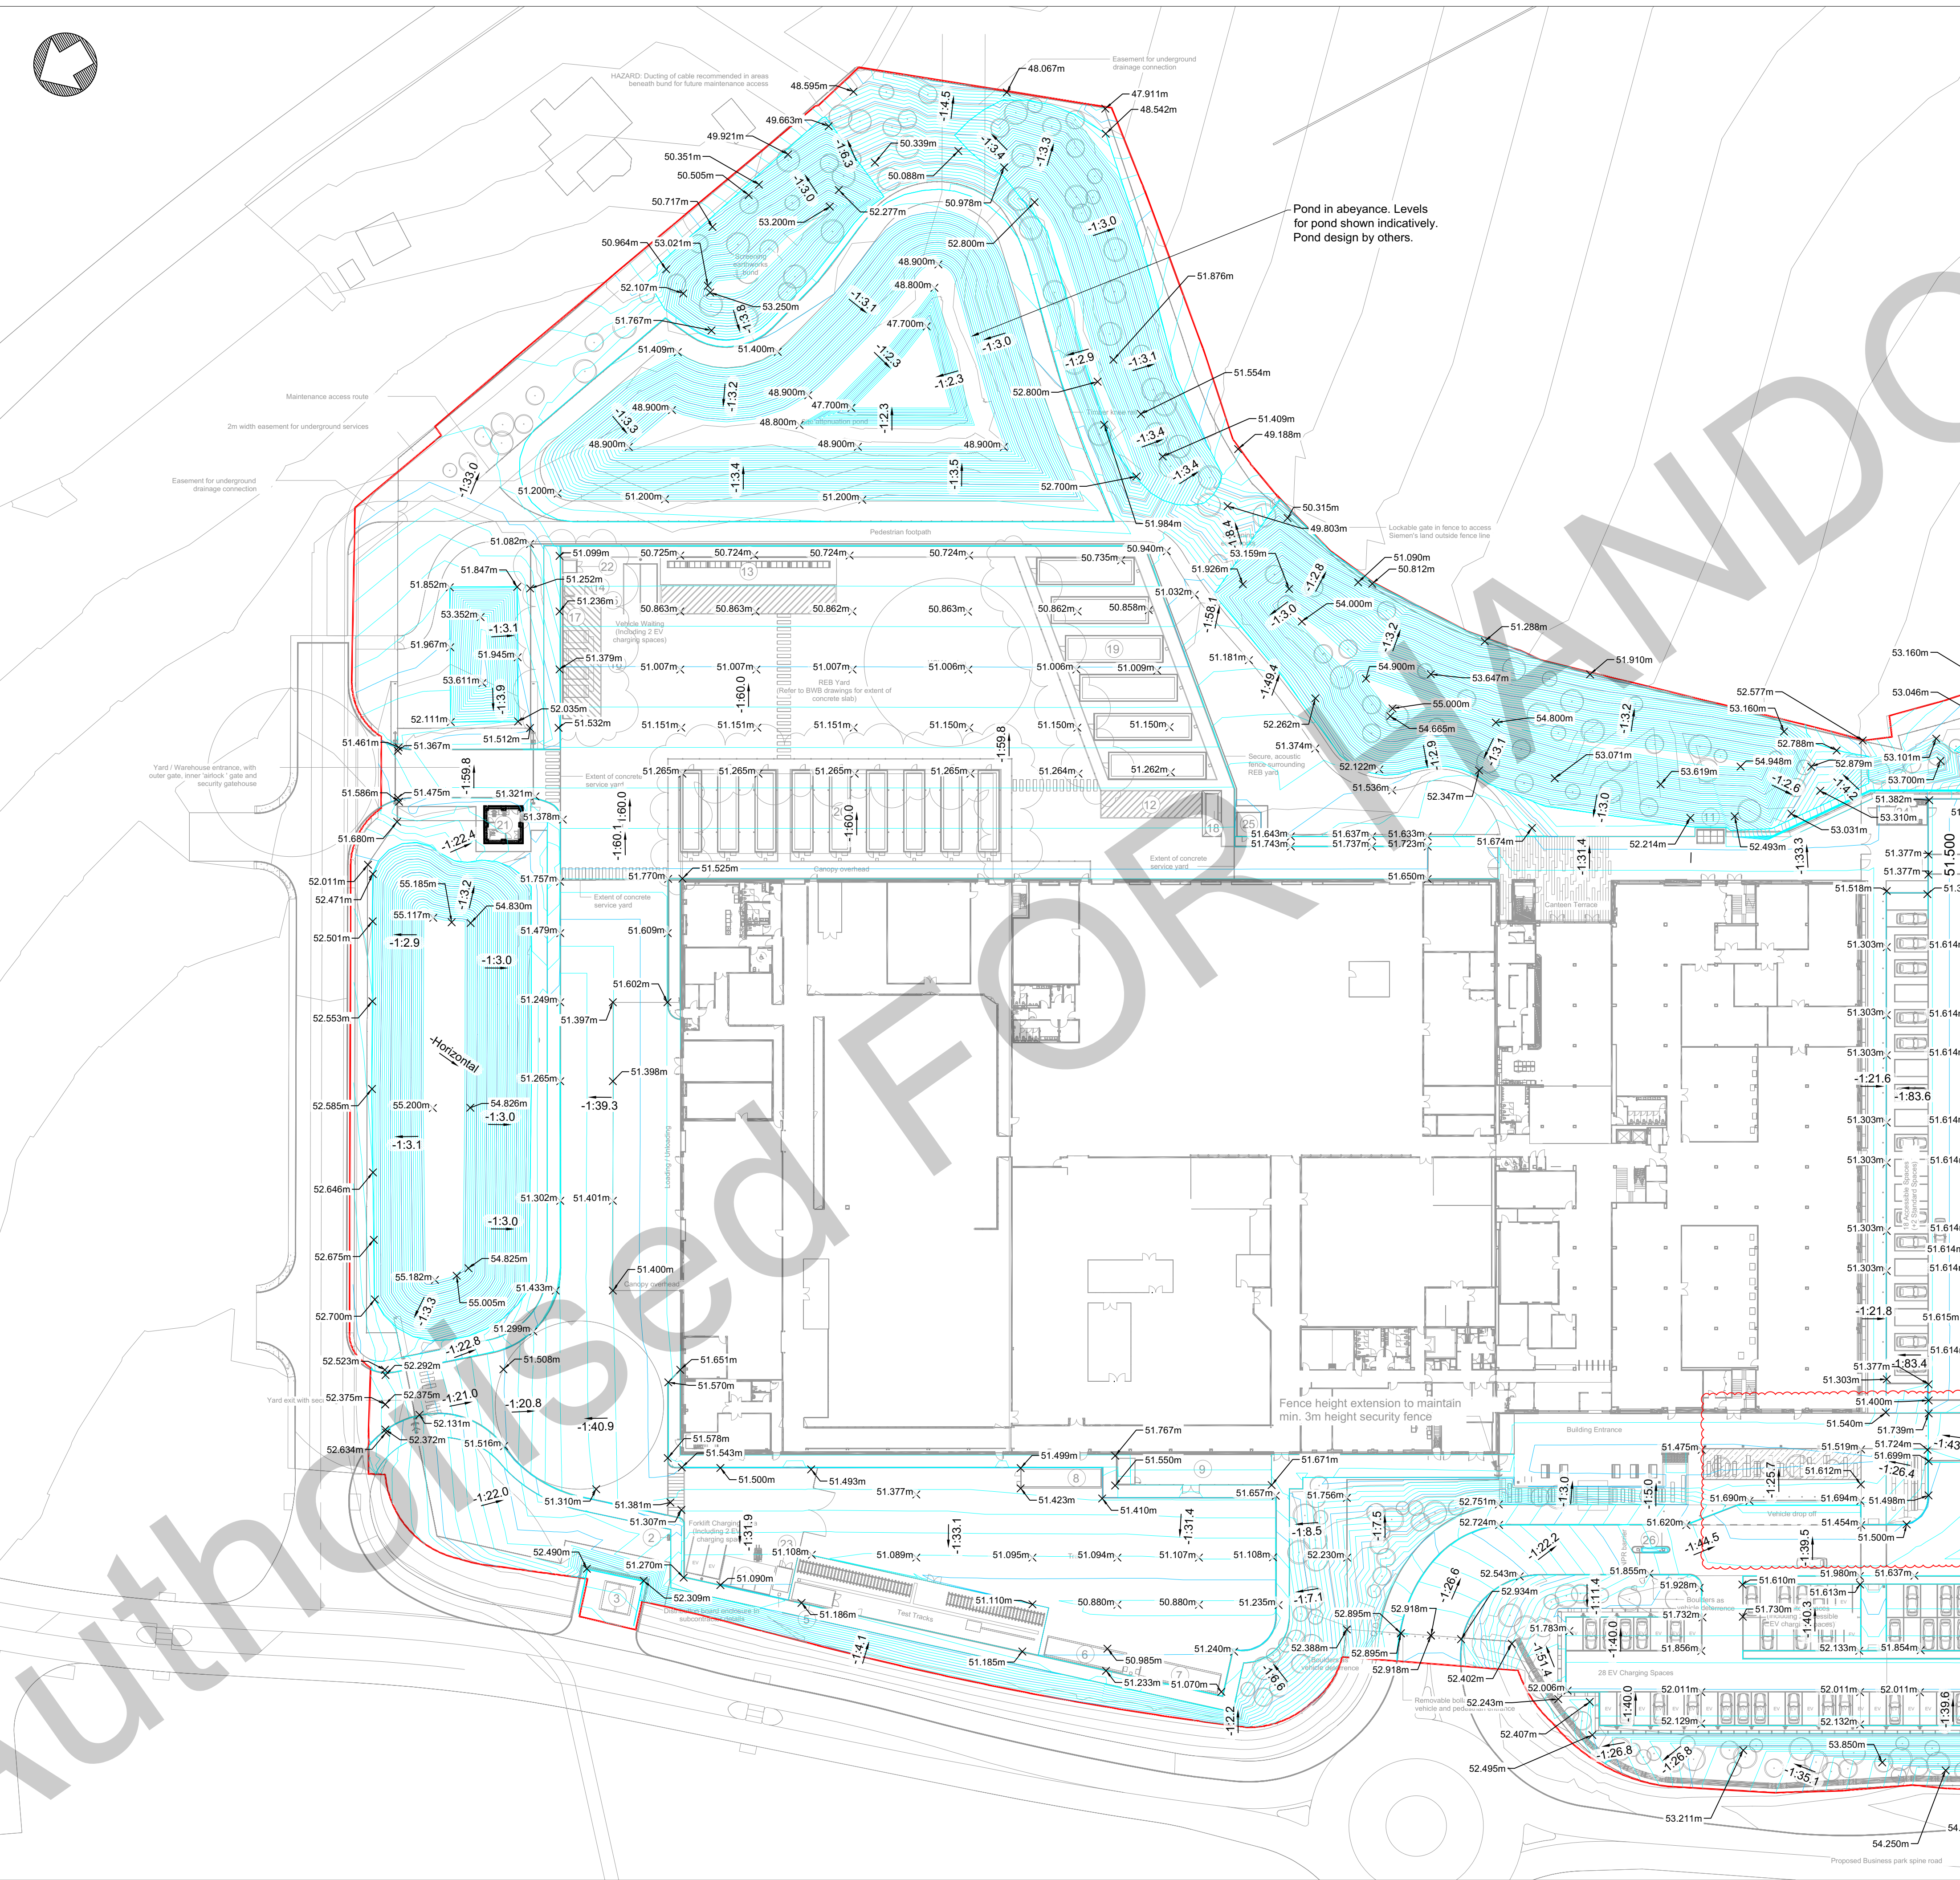


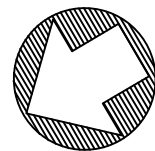

Notes

- Do not scale this drawing. All dimensions must be checked/ verified on site. If in doubt ask.
- This drawing is to be read in conjunction with all relevant architects, engineers and specialists drawings and specifications.
- All dimensions in millimetres unless noted otherwise. All levels in metres unless noted otherwise.
- Any discrepancies noted on site are to be reported to the engineer immediately.

Key Plan

Legend

- Site Boundary
- Major Contour Line (0.5m Intervals)
- Minor Contour Line (0.1m Intervals)
- Surface Gradient
- Surface Spot Elevation

AS-BUILT

This "AS-BUILT" drawing represents the final intent of BWB and is offered for incorporation into the Health & Safety File. The "AS-BUILT" drawing records records any amendments made on site by the Contractor only where the details of such amendments have been specifically notified to BWB. BWB rely solely on the Contractor for the provision of the information and BWB accept no responsibility for the accuracy of the information provided by the Contractor. Any discrepancy between this "AS-BUILT" drawing and the completed works should be referred to the Contractor for clarification.

C12	20.02.26	As-Built Issue	ZC	TW
C11	18.11.25	Updated to latest masterplan	GK	TW
C10	28.10.25	Updated to latest masterplan	GK	TW
C9	03.10.25	Updated to latest masterplan	GK	TW
C8	31.03.25	Updated to latest REB Yard thicknesses	GK	TW
C7	28.02.25	Construction Issue	GK	TW
C6	14.02.25	Updated to latest REB Yard thicknesses	GK	TW
C5	20.01.25	Updated to latest levels	GK	TW
C4	14.01.25	Updated to latest levels	GK	TW
C3	13.12.24	Bunds Updated, Crossing Updated.	GK	TW
C2	05.12.24	Landscaping area updated to 450mm topsoil.	GK	TW
C1	28.11.24	Updated to latest levels	GK	TW
P2	15.11.24	Updated to latest levels	GK	TW
P1	01.11.24	Preliminary Issue	MI	MR
Rev	Date	Details of issue / revision	Drw	Rev

Issues & Revisions

BWB
A CAF GROUP COMPANY

☐ Birmingham | 0121 233 3322
☐ Leeds | 0113 233 8000
☒ London | 020 7407 3879
☐ Manchester | 0161 233 4260
☐ Nottingham | 0115 924 1100
www.bwbconsulting.com

Client
BOWMER AND KIRKLAND LTD.

Project Title
SIEMENS, CHIPPENHAM

Drawing Title
PROPOSED FORMATION LEVELS SHEET 1

Drawn:	M. Izzaoui	Reviewed:	M. Ross
BWB Ref:	244347	Date:	Oct'24
Scale@A1:	1:500		

Drawing Status
AS-BUILT

Project - Originator - Zone - Level - Type - Role - Number	Rev
SMC-BWB-ZZ-XX-D-C-1110	A6 C12