

BRADFIELD MANOR SN14 6EU


Planning Application No PP-13743652

BRADFIELD MANOR SITE/BLOCK PLAN

Extension north wall taken down and re-built on same footprint using original stone. Window as shown in elevation drawing.

West wall taken down and re-sited as shown in red using original stone. Door as shown in elevation drawing.

Extension south wall taken down and re-built on same footprint using original stone. Window as shown in elevation drawing.

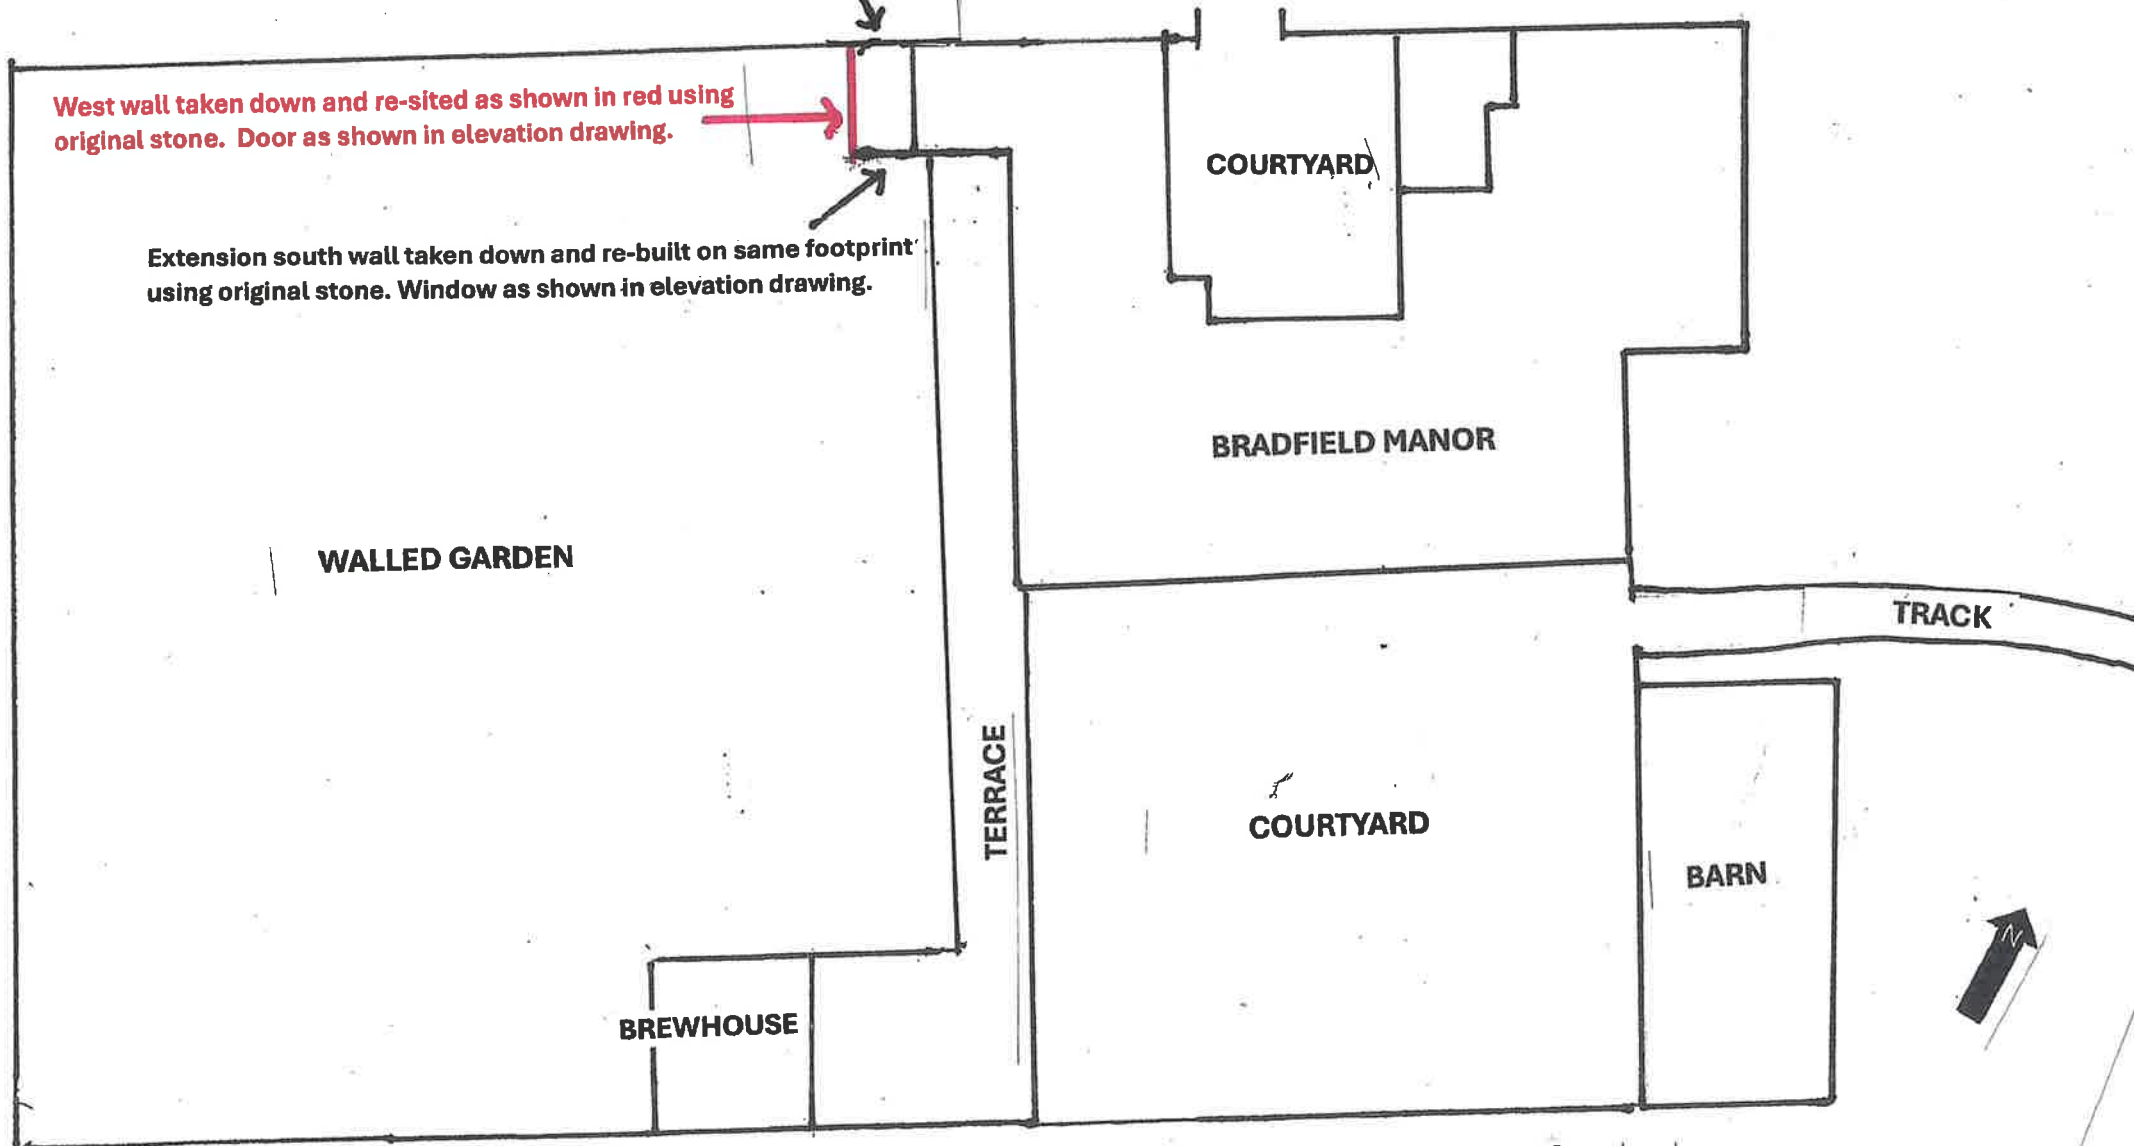

Scale: 1:250 @ A4

0 10
Metres