





WEST ELEVATION



NORTH ELEVATION

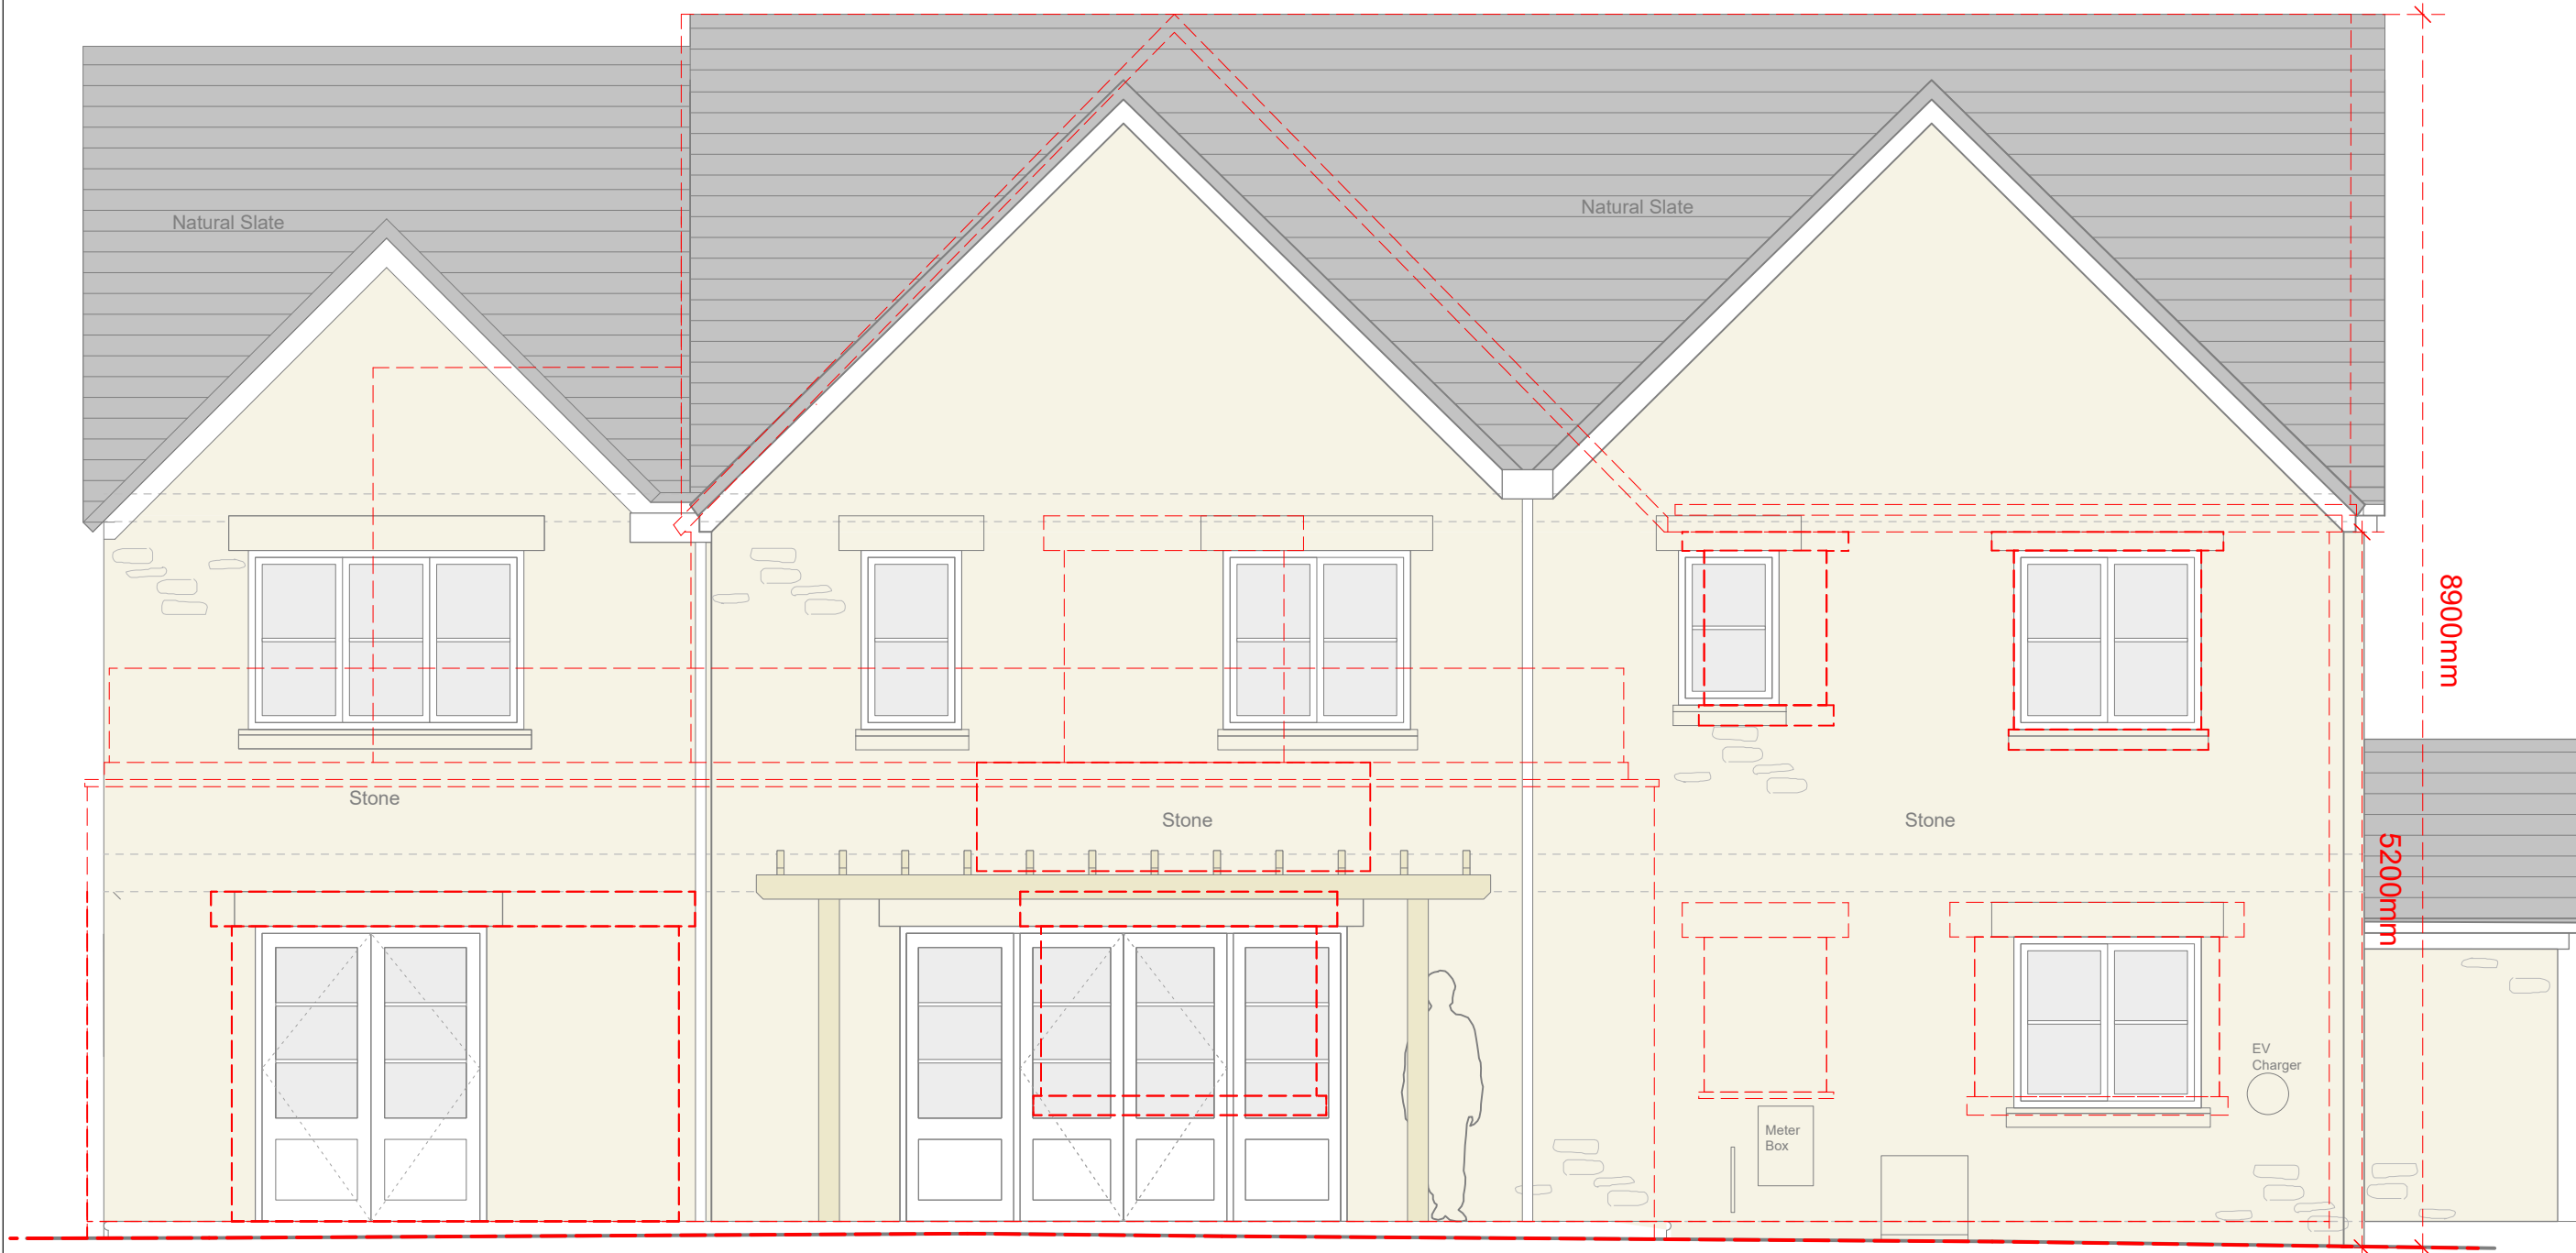

EAST ELEVATION

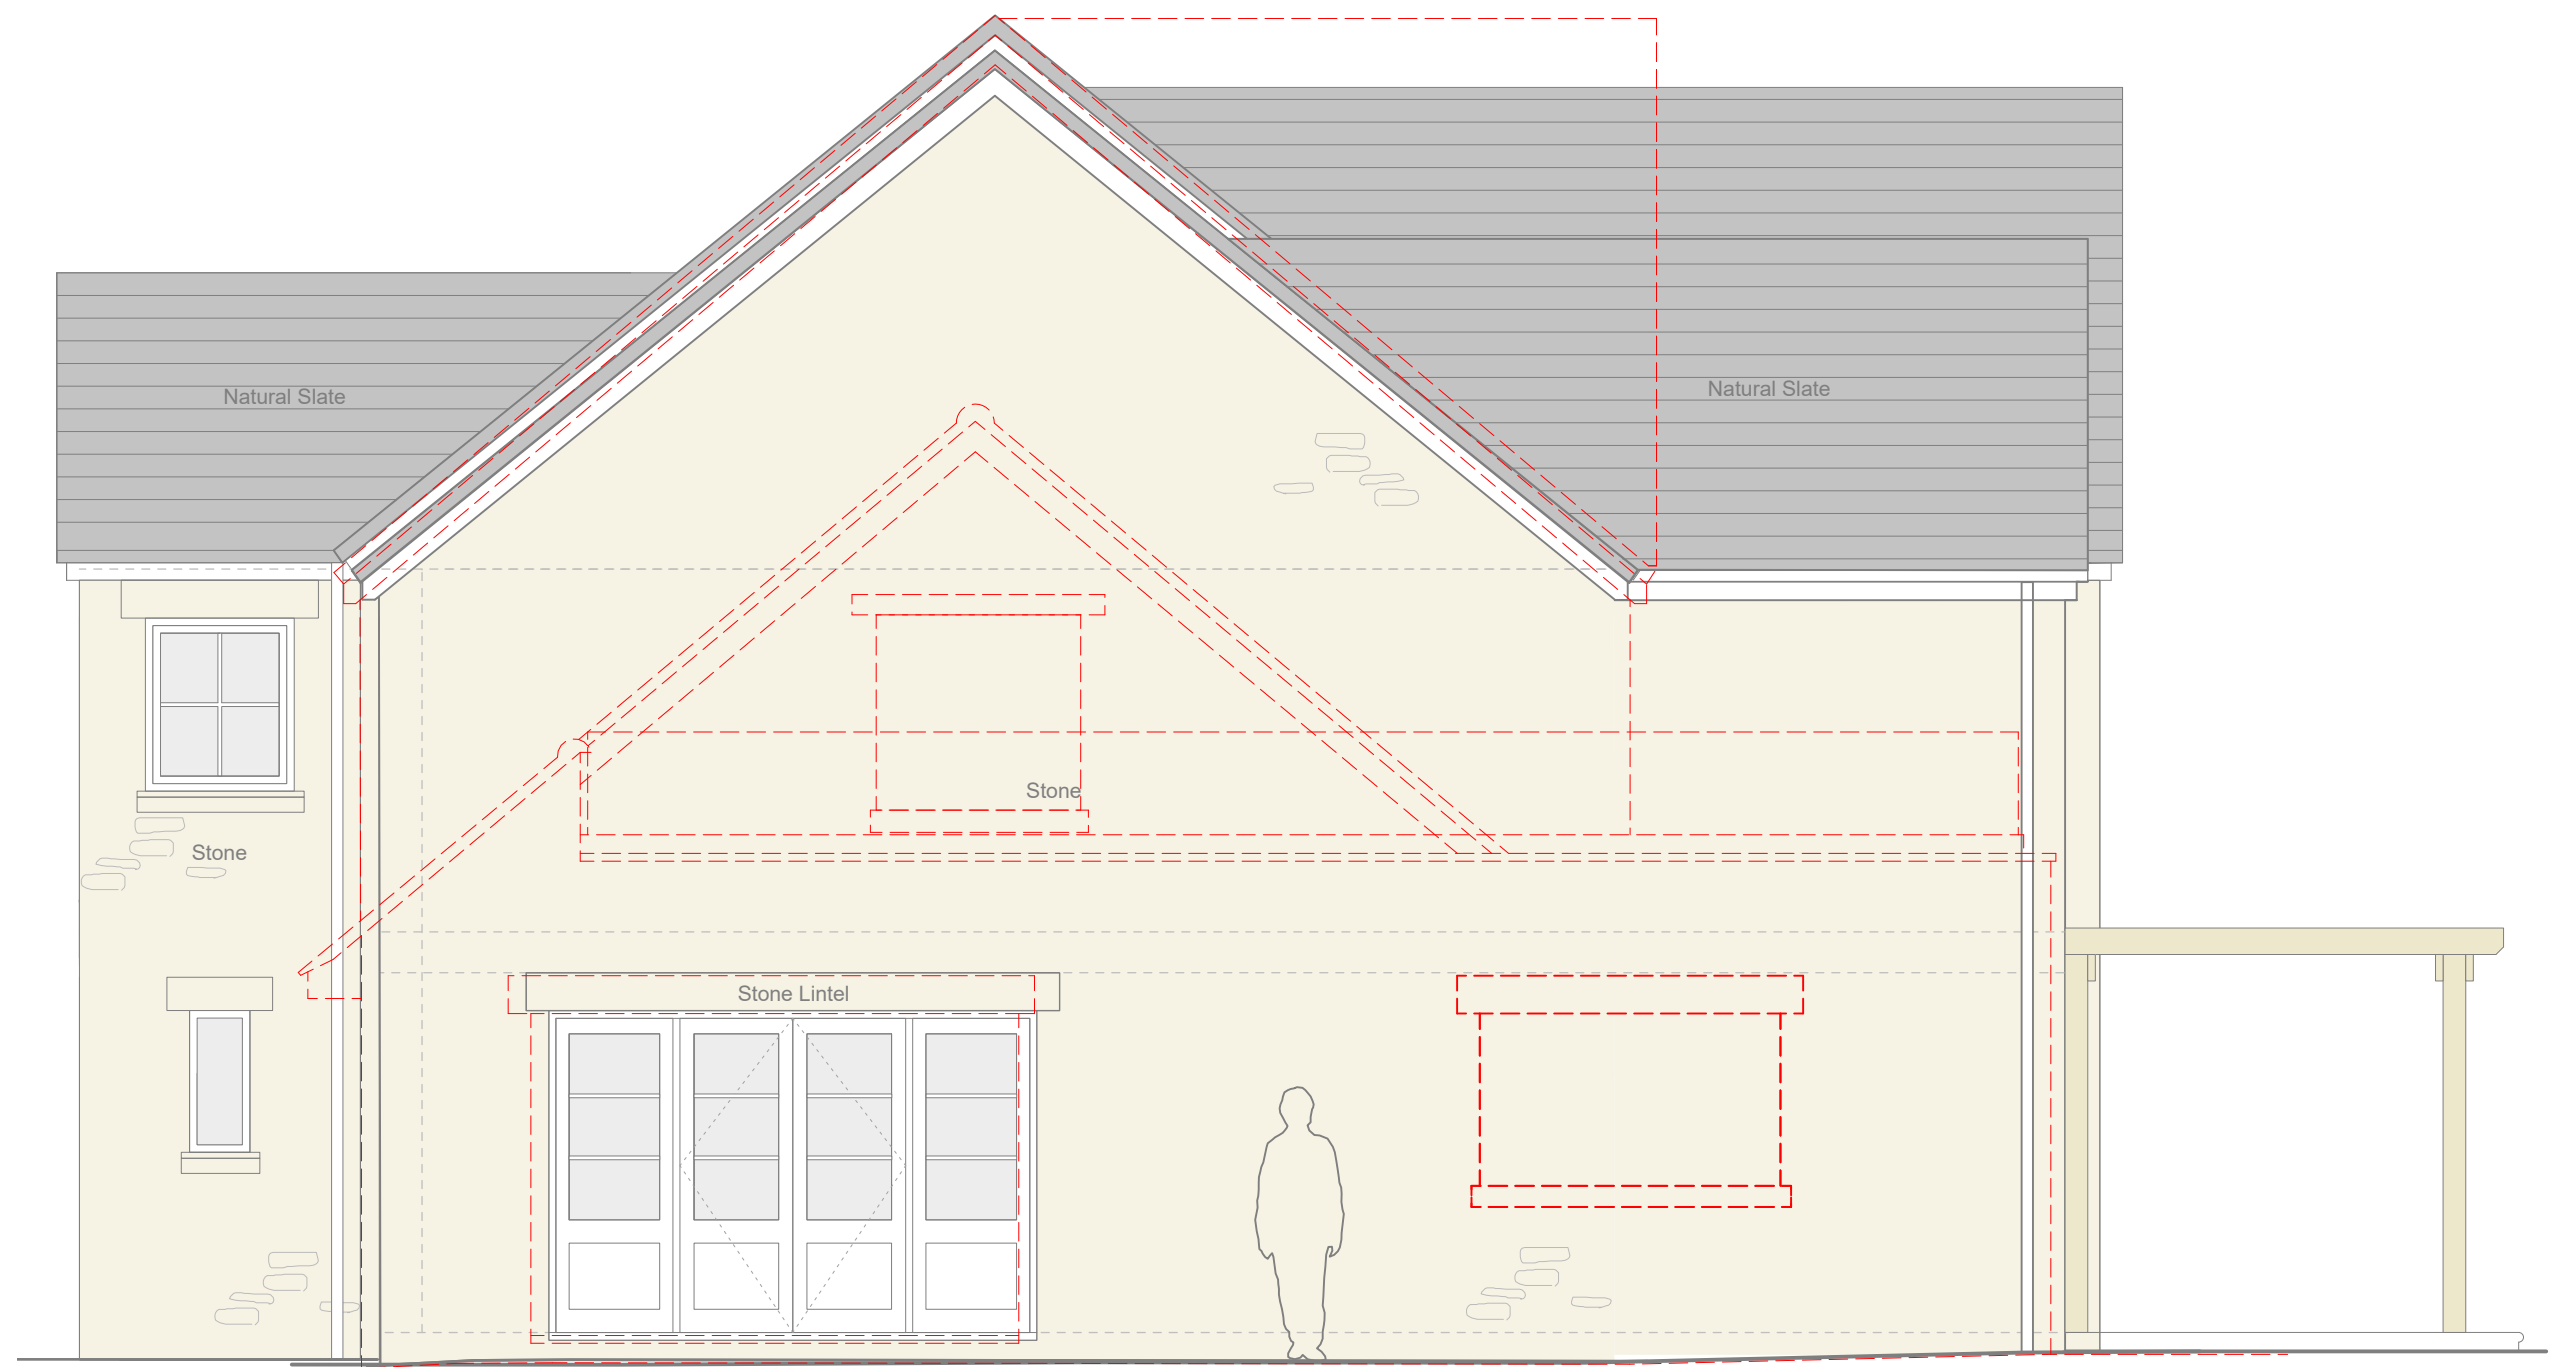

SOUTH ELEVATION

PLANNING NOTES
-
DEMOLITION NOTES
-
CONSTRUCTION NOTES
-All dimensions must be checked on site and not scaled from this drawing
MAINTENANCE NOTES
-

Revisions

--	--	--

VERITY & BEVERLEY
ARCHITECTS DESIGNERS
The Coach House | 4 The Chipping | Tetbury | Glos. | GL8 8ET
Telephone 01666 503516 | www.verity-beverley.co.uk

THE FIELDS
BROAD TOWN
PLANNING
ELEVATIONS
AS PROPOSED WITH EXISTING
CONSENT OVERLAID

Scale: 1:50	25.1607/18
Date: May 2026	
Drawn: DLS	
Size: A1	

0 1 2 3 4 5 M

SCALE MEASUREMENTS SHOWN IN METRES.
ACCURACY OF SCALE CAN ONLY BE ASSURED ON
PROPERLY CALIBRATED MACHINERY

Red line indicates previous approval ref: PL/2026/01079