

KEY:

DOTTED RED LINE INDICATING ALTERATIONS TO EXISTING

- Acc WC
- Teaching Space
- Circulation / lobby / Stairs
- Office
- Store
- Proposed Walk

PROPOSED EXTENSION AND COVERED STEEL FIRE ESCAPE STAIR

RED LINE INDICATING SITE

No	Details	Date	By
A	minor amendment to parking	12/05/26	DR
B	minor amendment	28/05/26	DR

S6C EXPANSION

SALISBURY 6TH FORM COLLEGE

66-78 TOLLGATE ROAD

SALISBURY

SP1 2JJ

SITE AND FLOOR PLANS

AS PROPOSED

Scale AS SHOWN @ A1


Date May 2026

Drawn by DR

Checked OC


Dwg 691- P - 03

Revision B

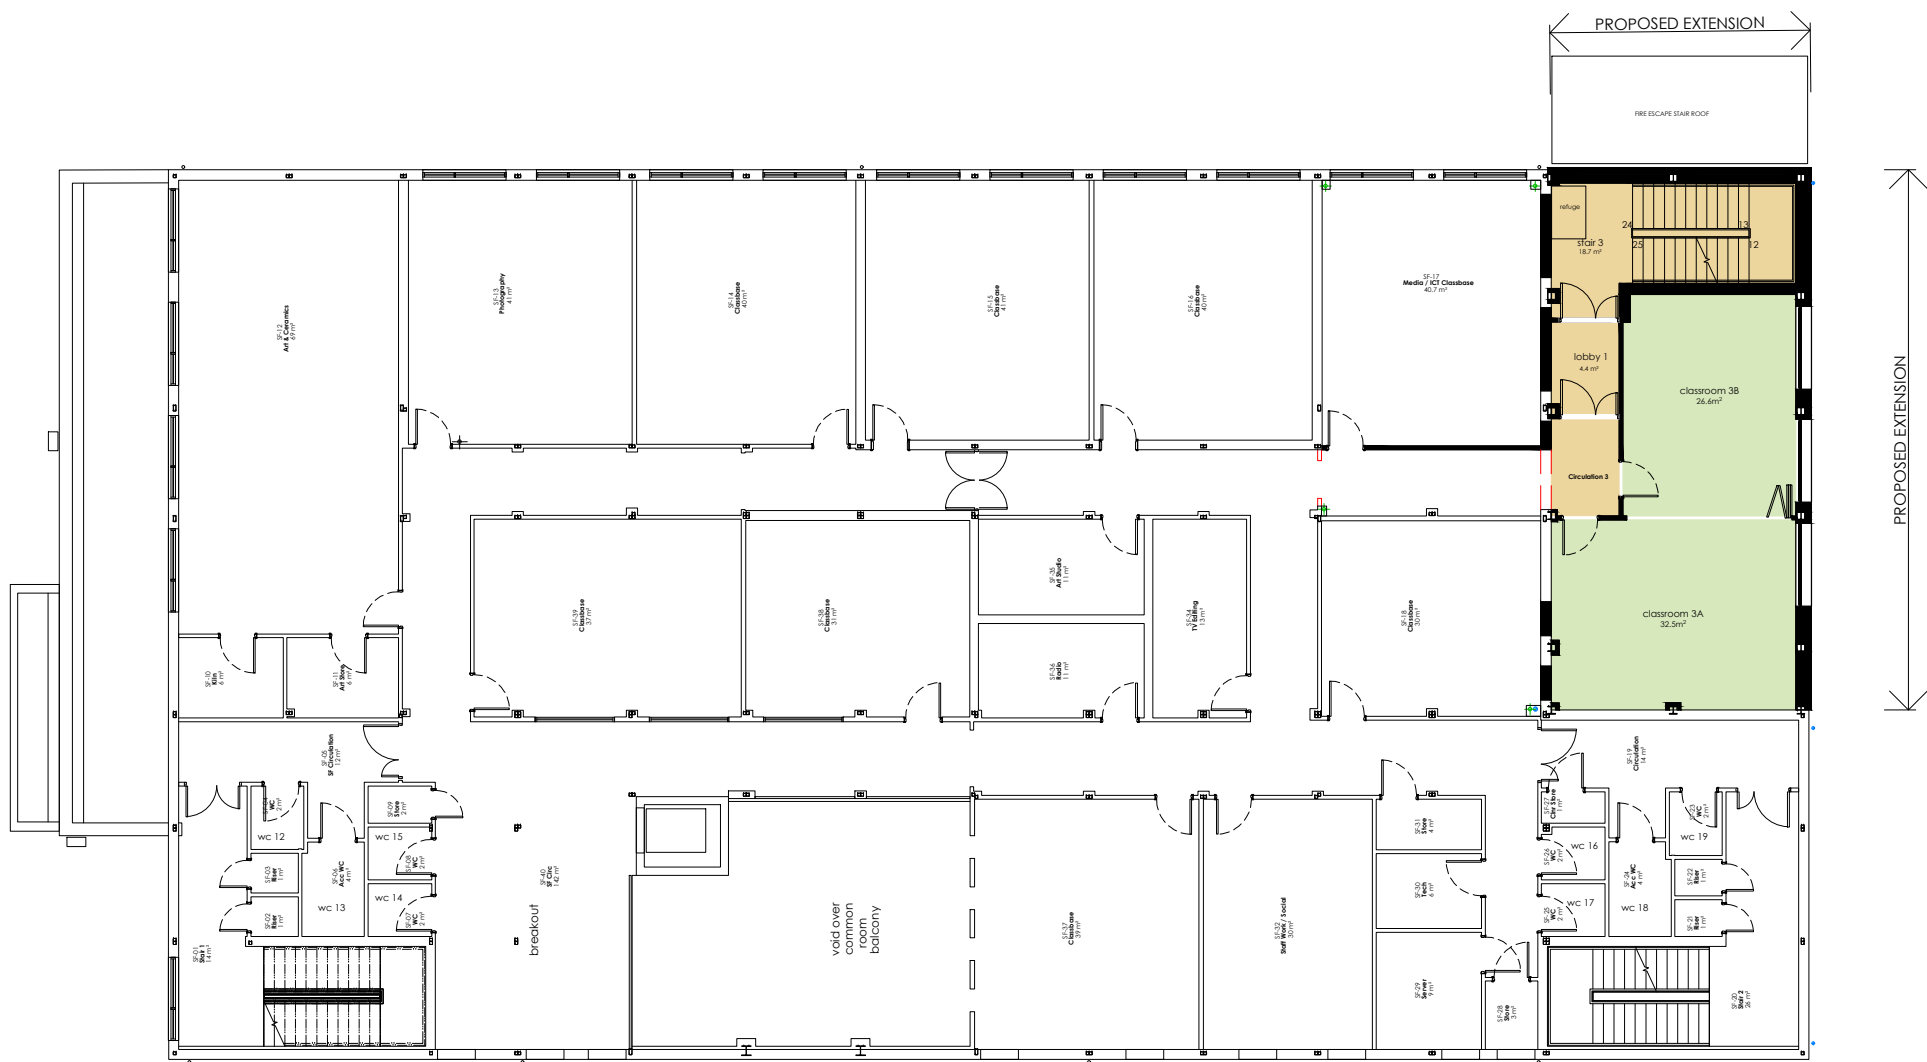


SECOND FLOOR PLAN

SCALE @ 1/200

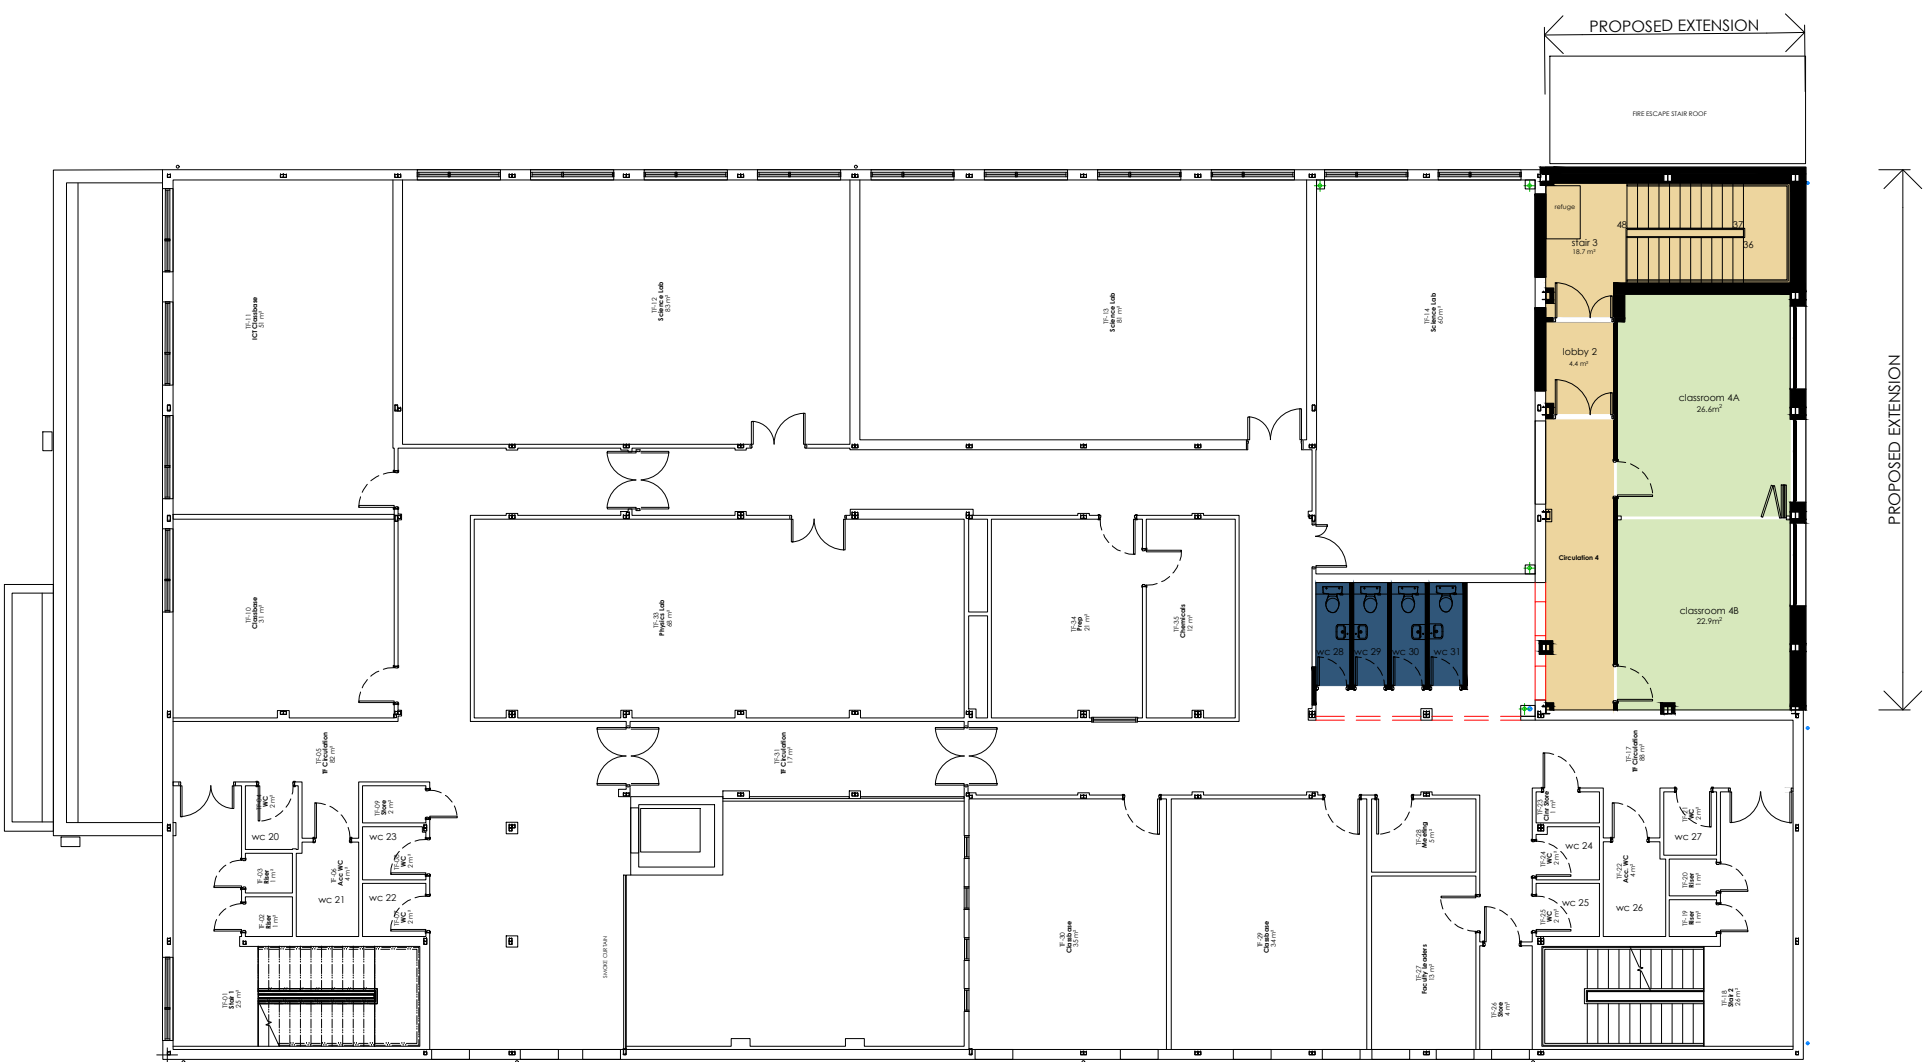


THIRD FLOOR PLAN

SCALE @ 1/200

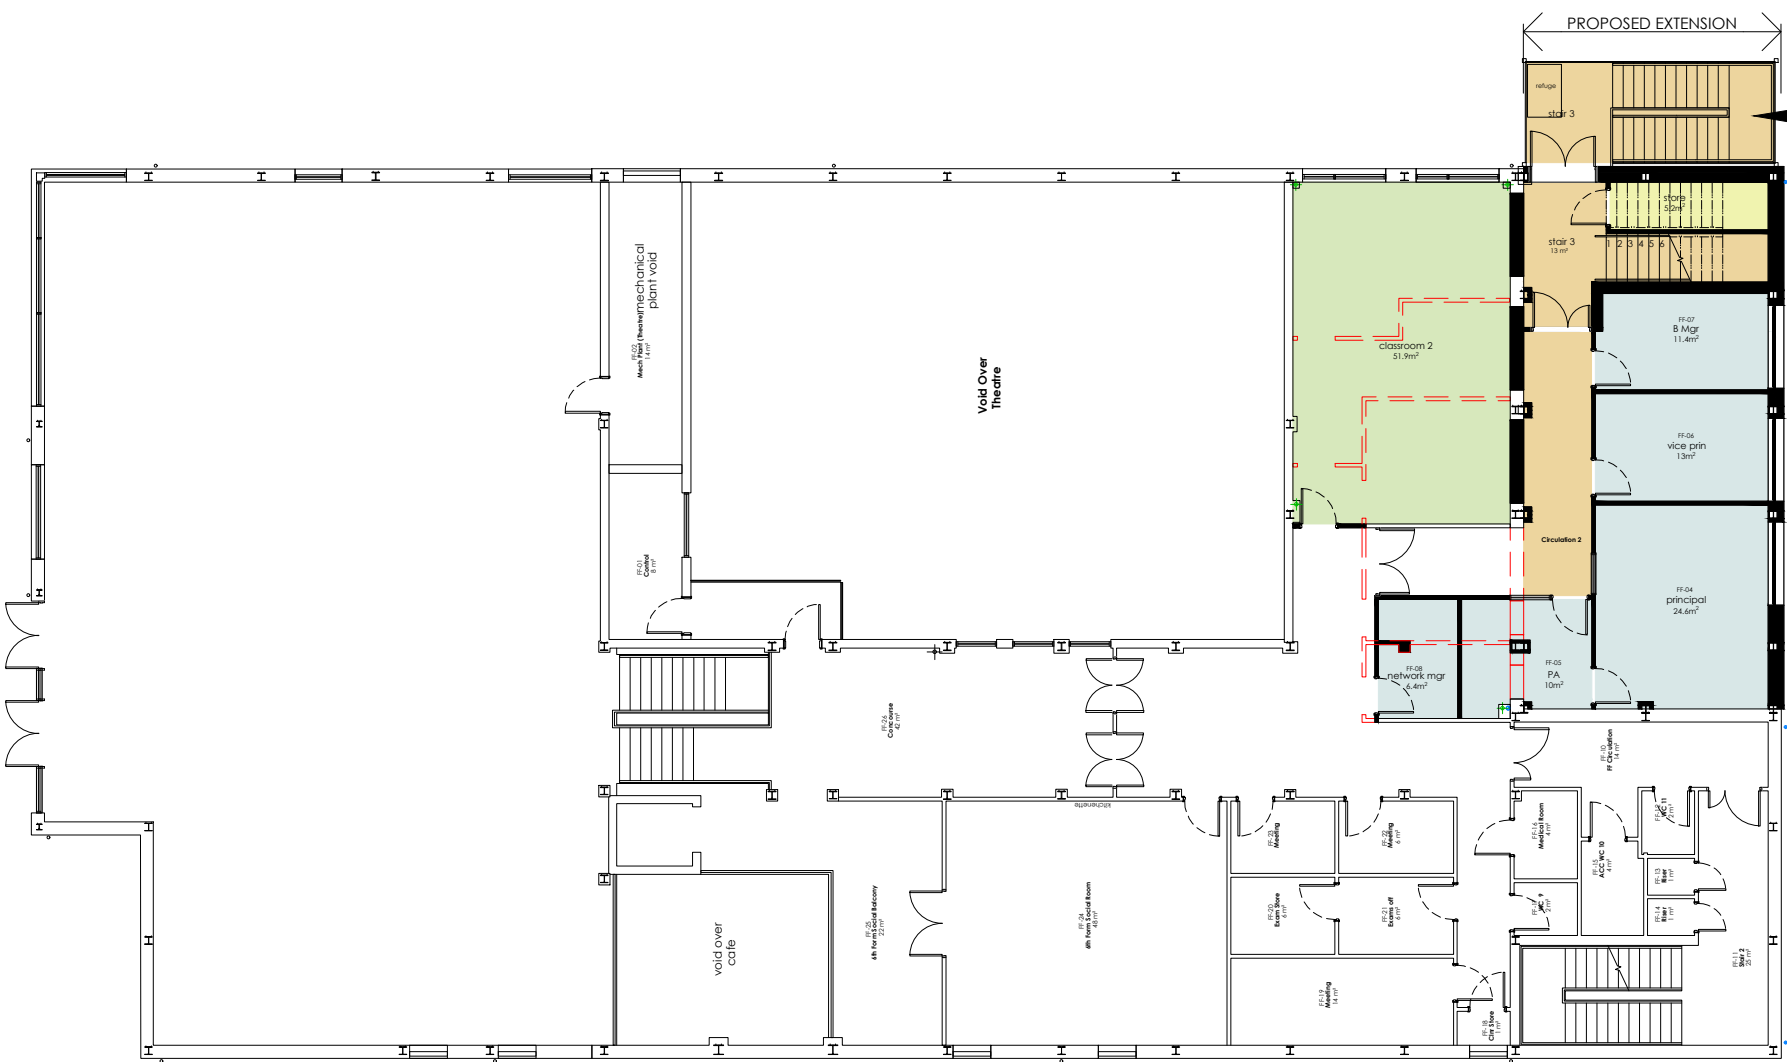

FIRST FLOOR PLAN

SCALE @ 1/200

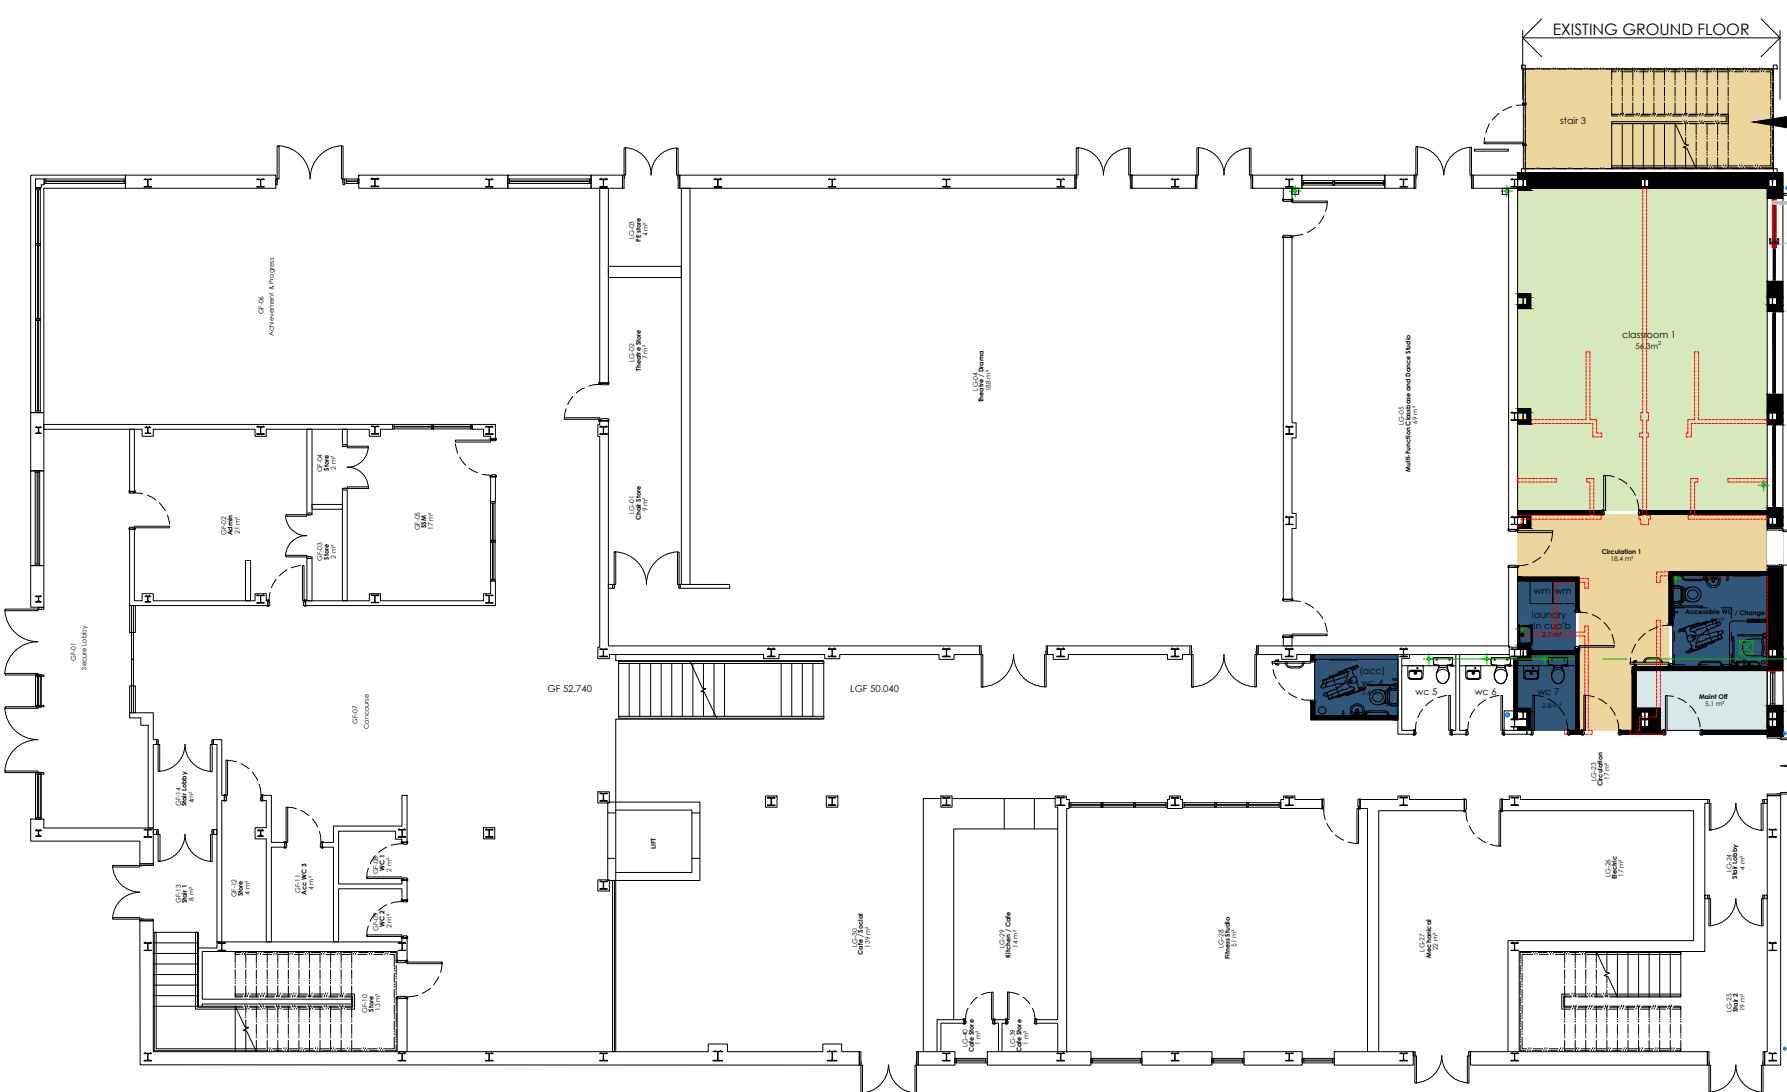

LOWER GROUND / GROUND FLOOR PLAN

SCALE @ 1/200

PROPOSED COVERED STEEL FIRE ESCAPE STAIR

PROPOSED COVERED STEEL FIRE ESCAPE STAIR

EXISTING BUILDING SOUTH ELEVATION



SITE PLAN

SCALE @ 1/500

PUPIL ACCESS TO MUGA RELOCATED TEMPORARILY