




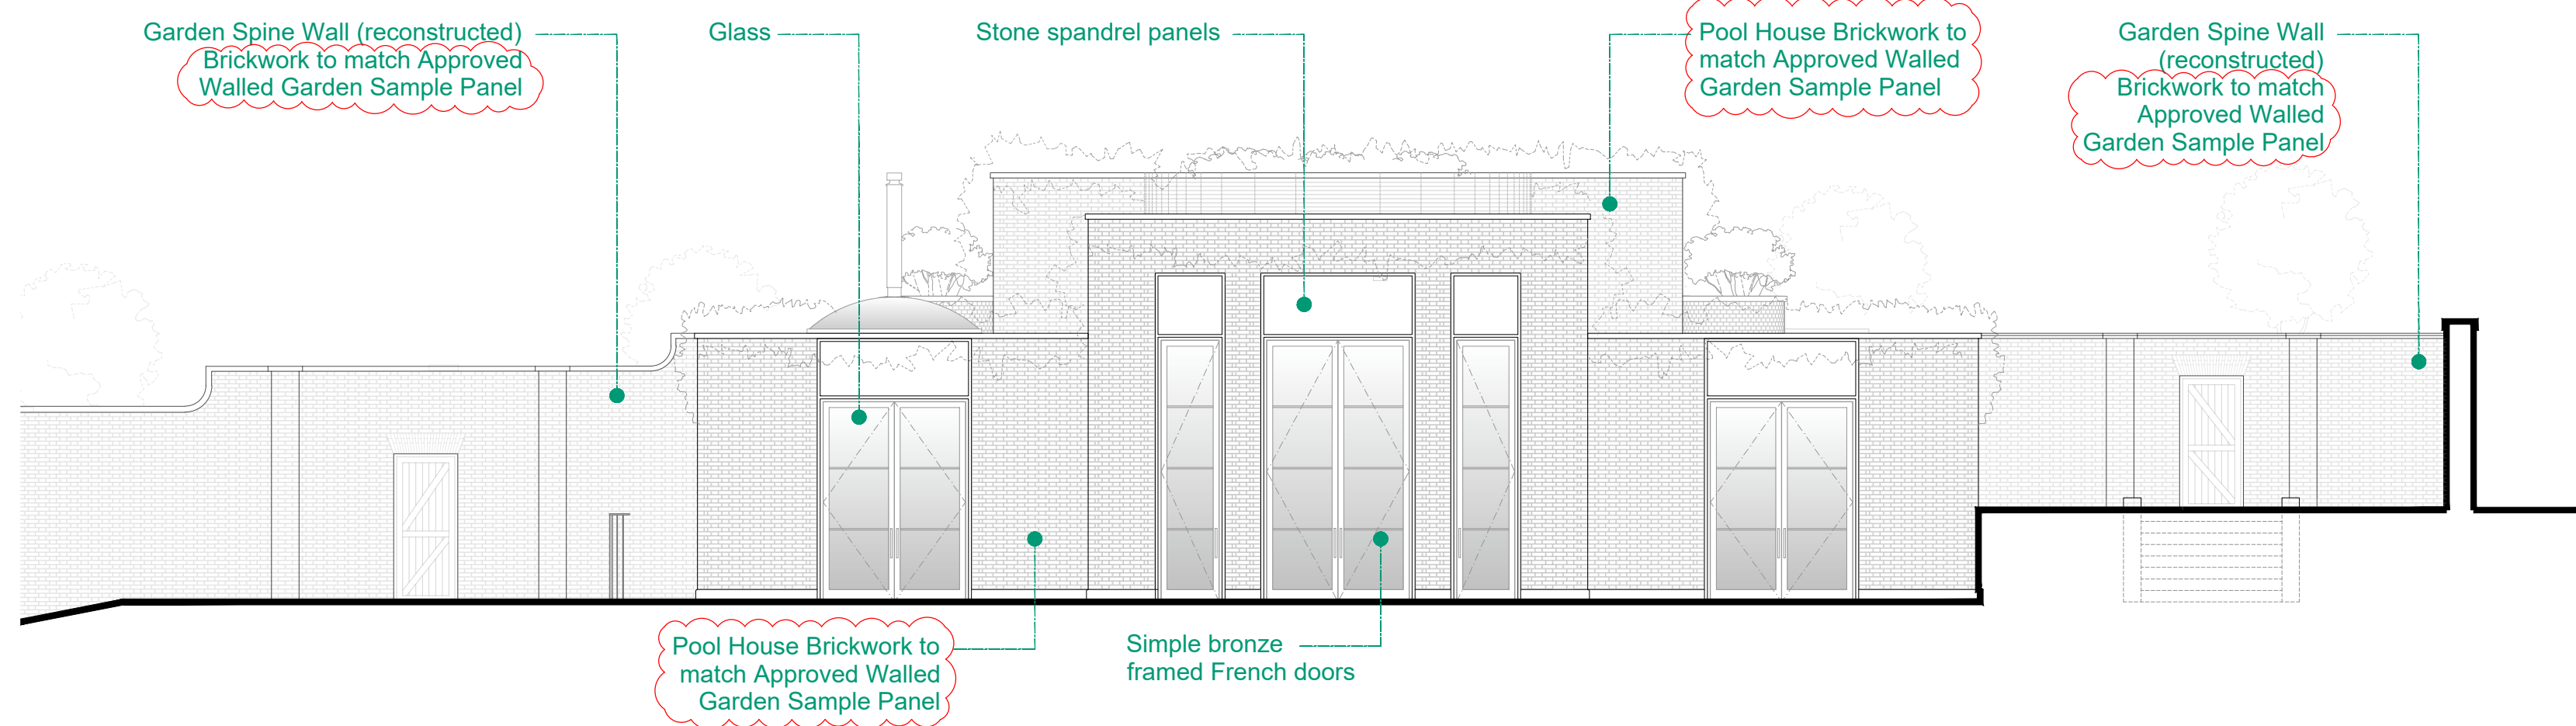

Proposed Pool House South Elevation
Scale 1:100

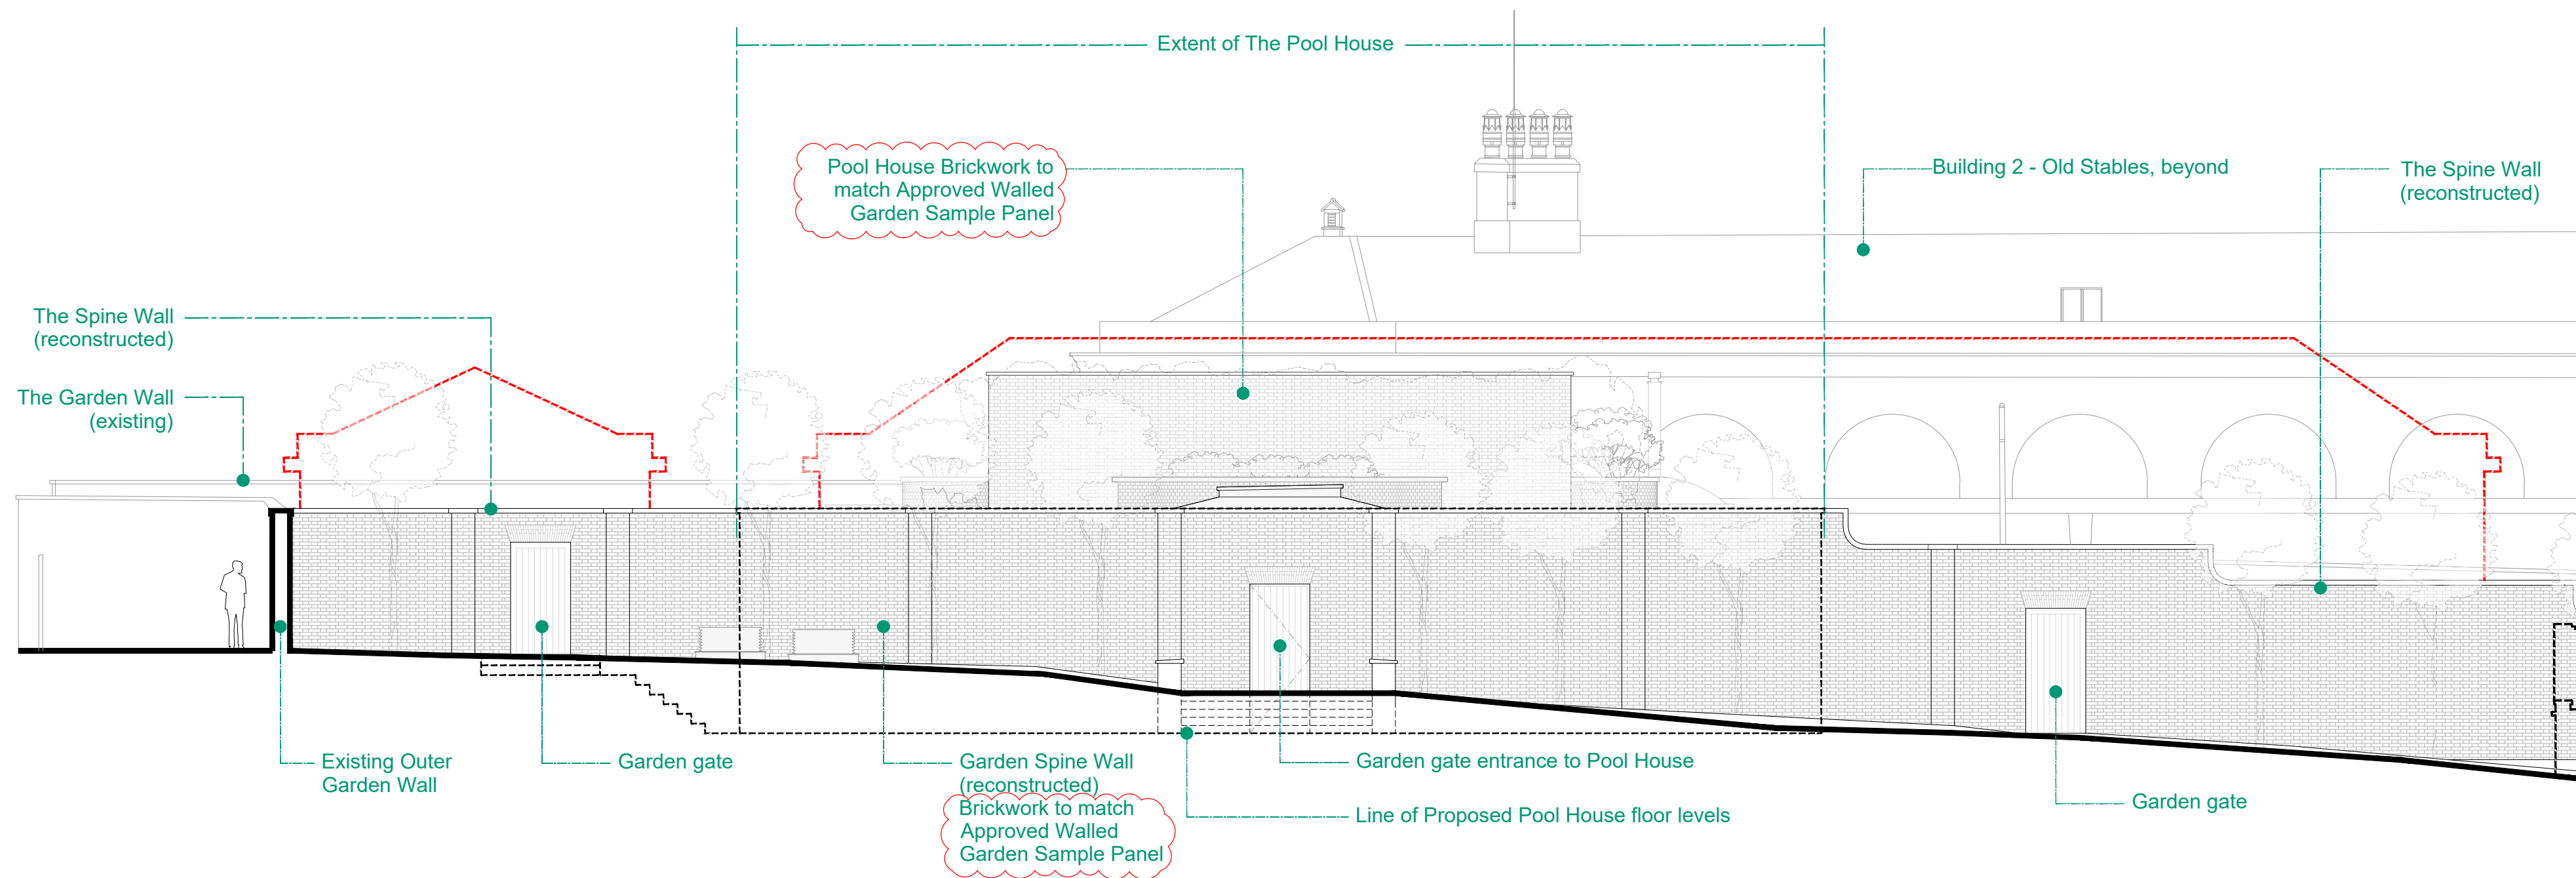

Proposed Pool House North Elevation
Scale 1:100

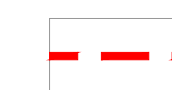


NOTE:
Red line indicates Consented drawings omitted from this application (Orangery and Pool Pavilion Proposals)

No. Notes

1. Dimensions to be verified on site. Only figured dimensions to be used and any discrepancies in dimensions are to be reported to the architect. No dimensions are to be scaled from printed drawings. Any areas indicated on this drawing are for guidance only. No responsibility is taken for their accuracy.
2. There is a risk of injury or death in construction if the works are not properly planned and supervised. The contractor must not undertake any element of the work without first having carried out the necessary risk assessments and prepared detailed method statements.

0 1 2 3 4 5 10

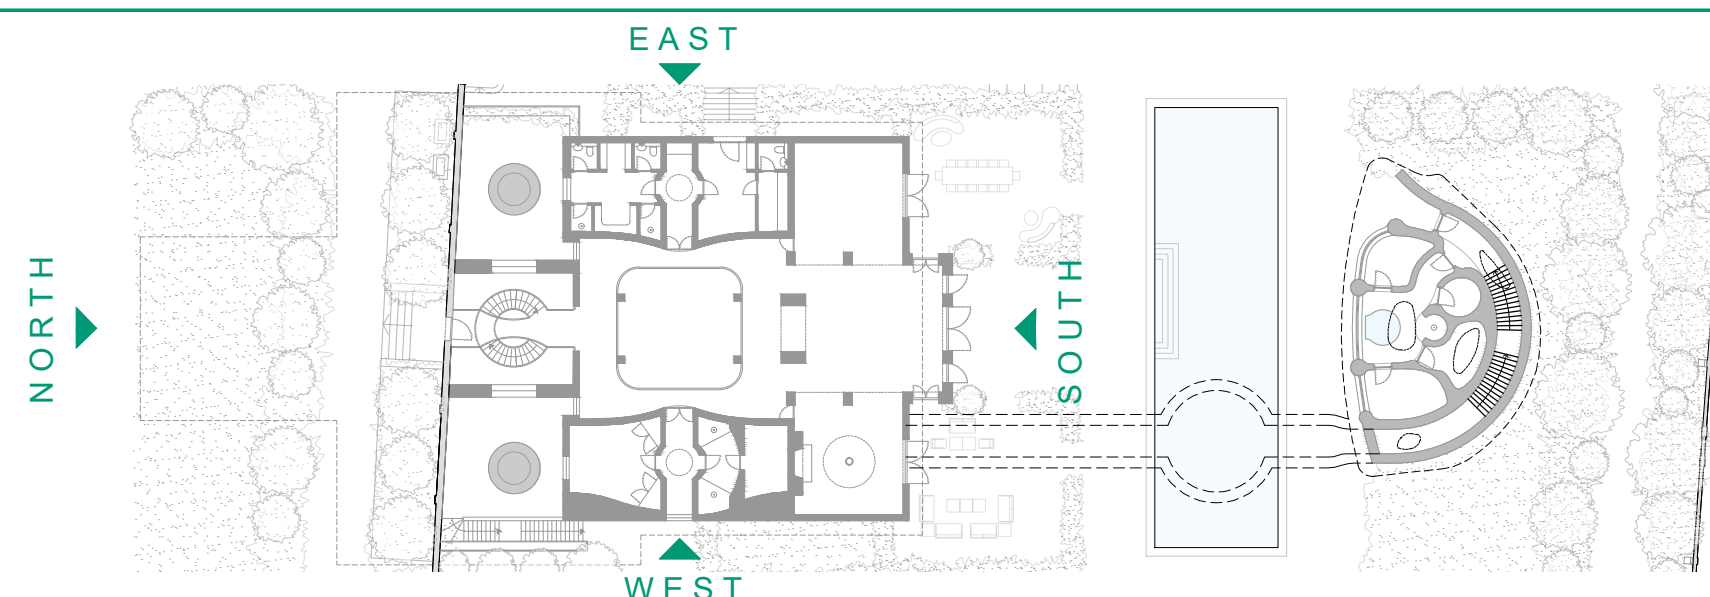

G	Notation 'Red Brick' changed to 'Brickwork to match walled garden sample panel'	2026/05/08
F	Planter troughs, Main door and glazed door transoms amended, entrance level to pool house lowered, MVHR intake and exhaust duct enclosures incorporated.	2026/02/05
E	Rooflight with integral flue incorporated	2025/05/14
D	Planters incorporated	2025/04/10
C	Minor amendments and deviations	2025/04/10
B	Planning issue to Gerald Eve	2024/09/24
A	Soft landscaping added	2024/09/17
*	Initial release	2024/09/13
no.	revision.	date.

Job: TH - The Pool House & The Walled Garden

Title: Proposed South & North Elevations

Type: 250410_FPA01

Status: PLANNING

drawn by	checked by	approved by
scale	size	date
1:100 @ A1	A1	24/09/24
job number	drawing number	revision
3121	220	G

BLDA ARCHITECTS

RIBA Chartered Practice
211 Design Centre East
Chelsea Harbour
London, SW10 0XF
mail@blda.co.uk
www.blda.co.uk
t +44 (0) 20 7838 5555