


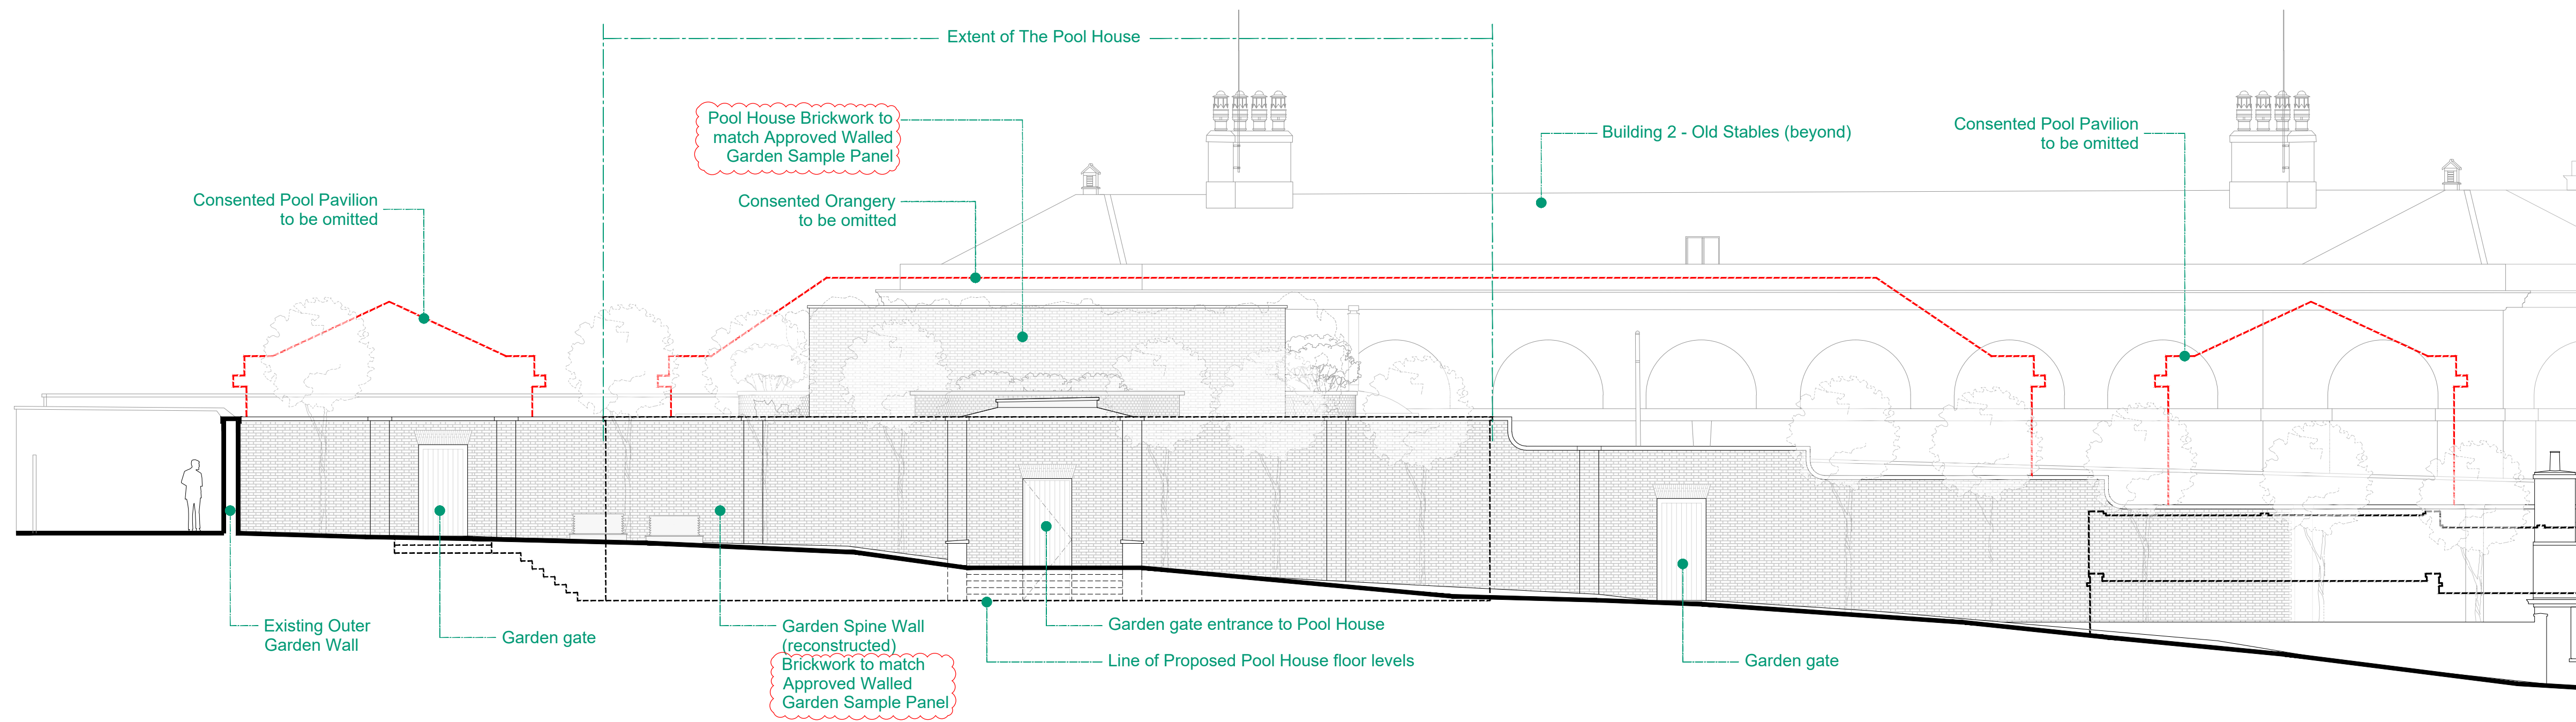

Proposed Pool House North Elevation (with outline of omitted consented buildings)

Scale 1:100




NOTE:
Red line indicates Consented drawings omitted from this application (Orangery and Pool Pavilion Proposals)

No. Notes

1. Dimensions to be verified on site. Only figured dimensions to be used and any discrepancies in dimensions are to be reported to the architect. No dimensions are to be scaled from printed drawings. Any areas indicated on this drawing are for guidance only. No responsibility is taken for their accuracy.
2. There is a risk of injury or death in construction if the works are not properly planned and supervised. The contractor must not undertake any element of the work without first having carried out the necessary risk assessments and prepared detailed method statements.

0 1 2 3 4 5 10

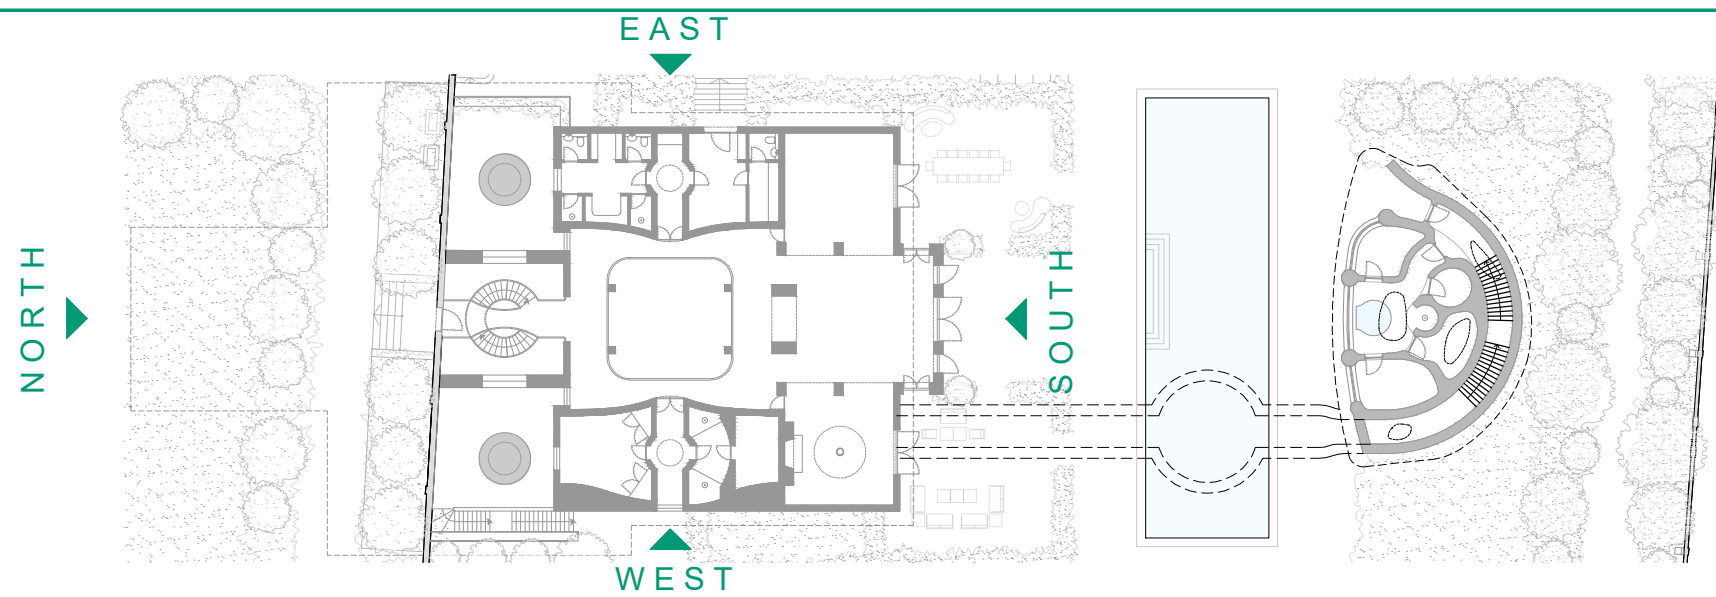

G Notation 'Red Brick' changed to 'Brickwork to match walled garden sample panel' 2026/05/08
F Planter troughs amended, North entrance level to pool house lowered, MVR intake and exhaust duct enclosures incorporated. 2026/02/05
E Rooflight with integral flue incorporated 2025/05/14
D Planters incorporated 2025/05/08
C Minor change to outline of center section walls 2025/04/10
B Annotation amended 2024/09/26
A Planning issue to Gerald Eve 2024/09/24
* Initial release 2024/09/17

no. revision.

Job: TH - The Pool House & The Walled Garden

Title: Proposed North Elevation (with outline of omitted consented buildings)

Type: 250410_FPA01

Status: PLANNING

drawn by	CC	checked by	---	approved by	---
scale	1:100 @ A1	size	A1	date	30/01/26
job number		drawing number		revision	
3121		220.1		G	

BLDA ARCHITECTS

RIBA
Chartered Practice

211 Design Centre East
Chelsea Harbour
London, SW10 0XF

mail@blda.co.uk
www.blda.co.uk
t +44 (0) 20 7838 5555