






85.00m OAD

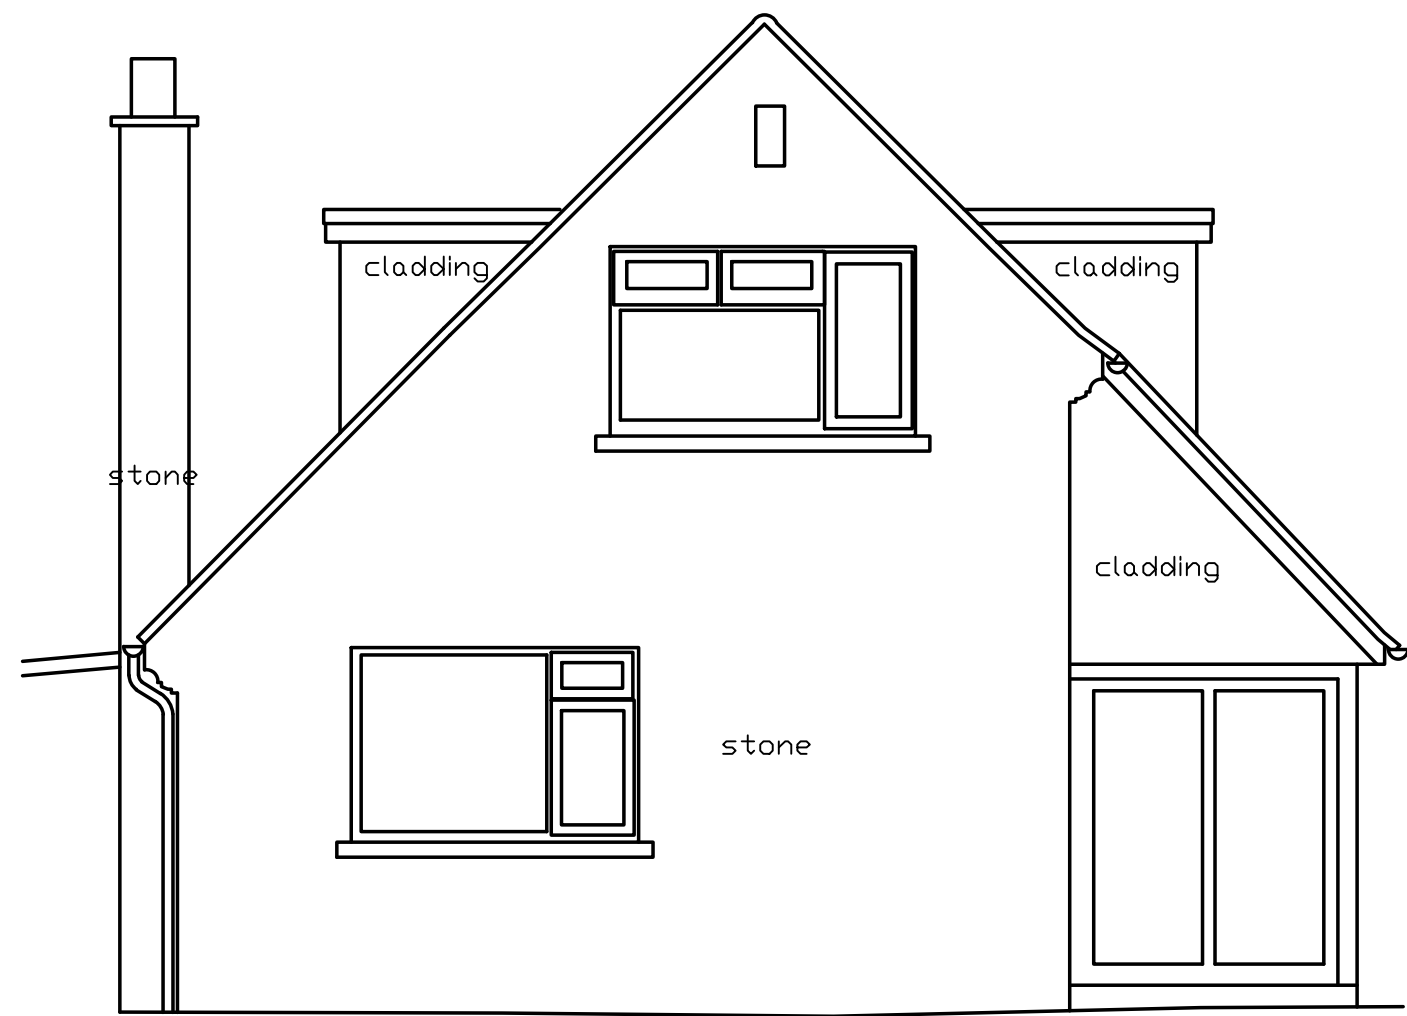


85.00m OAD

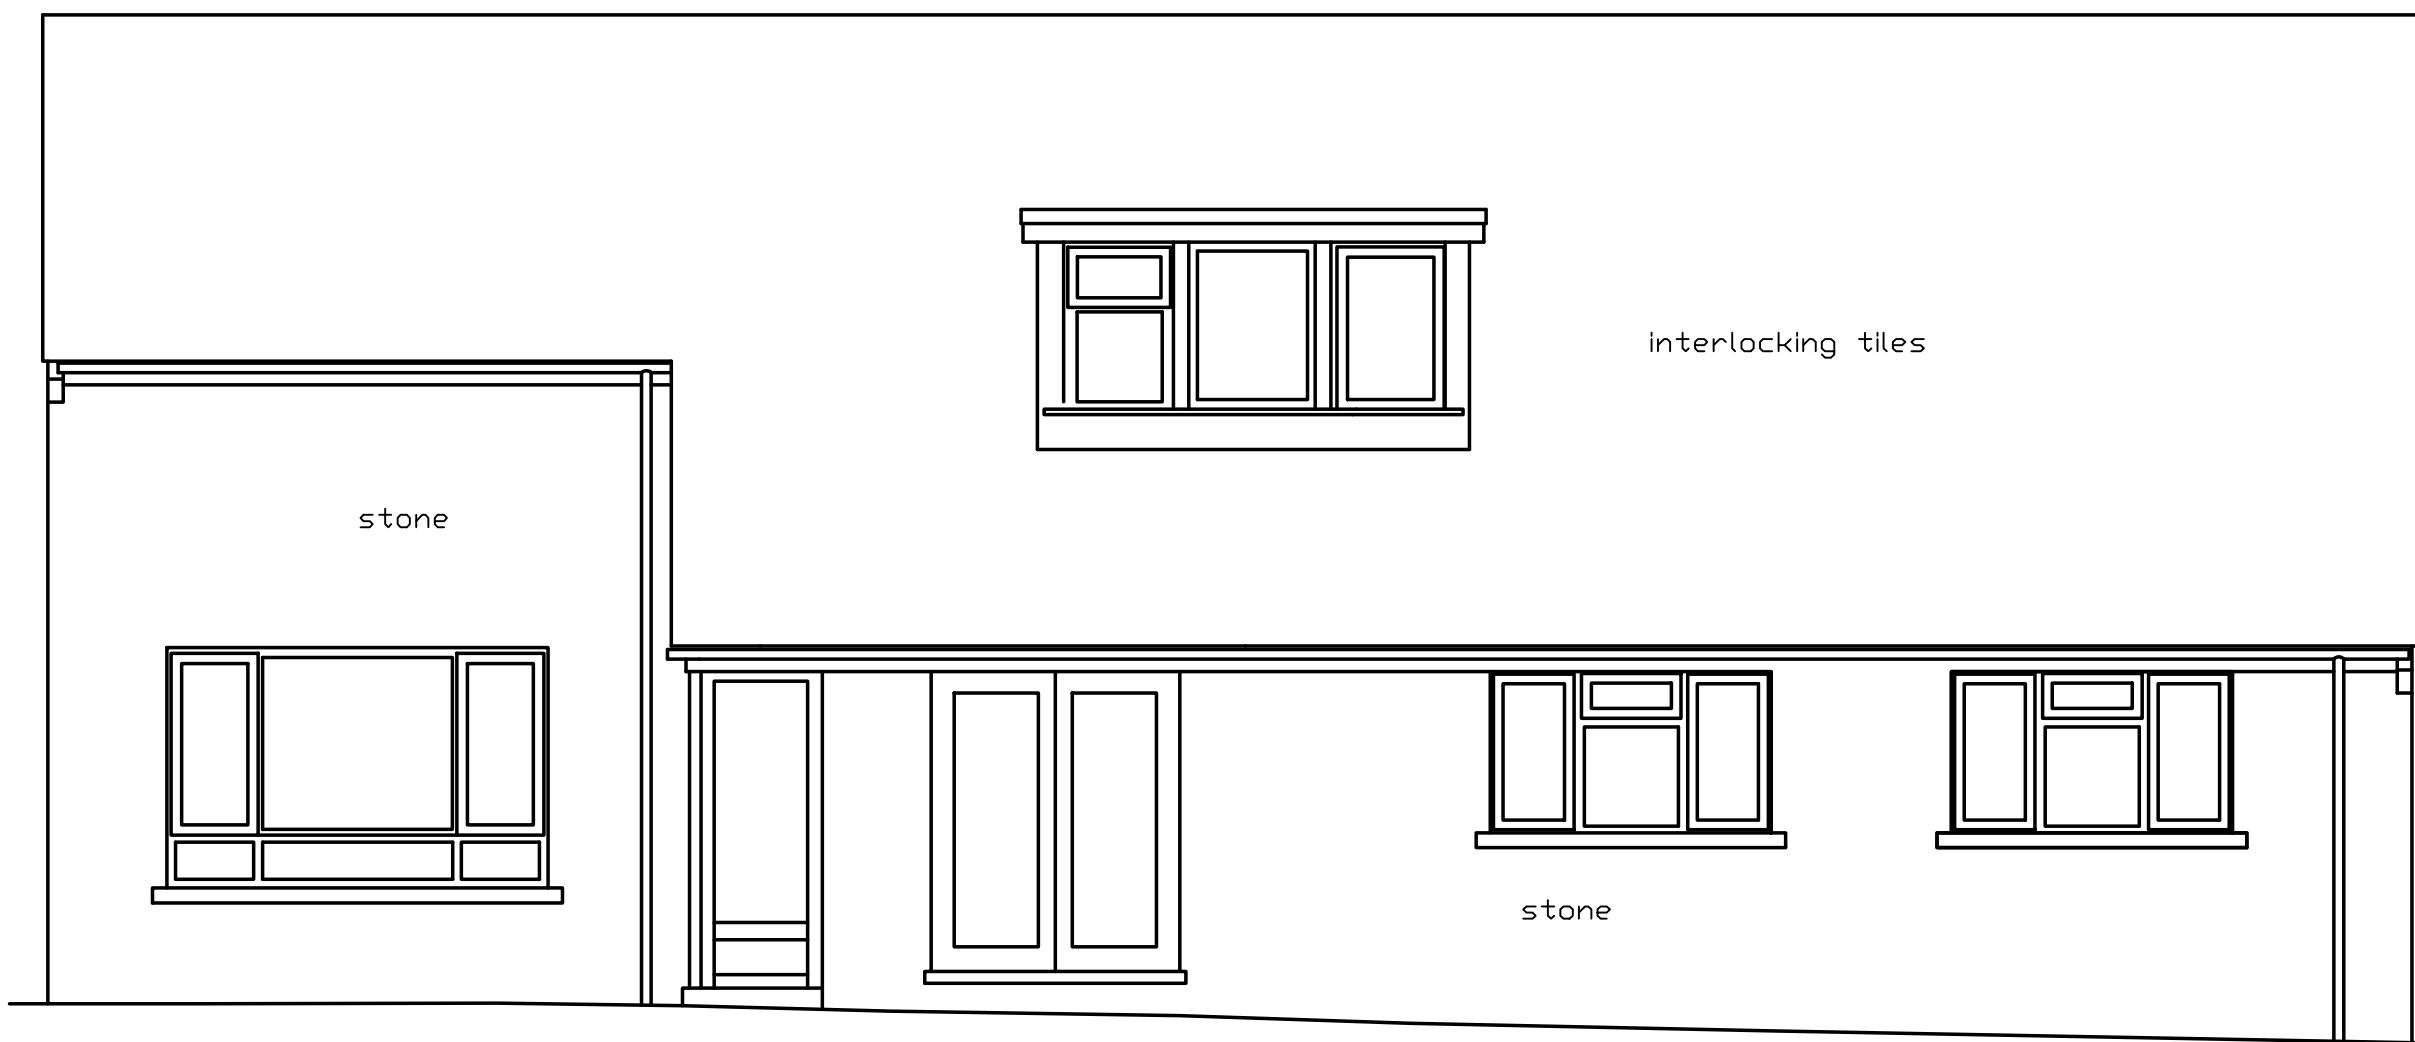

85.00m OAD

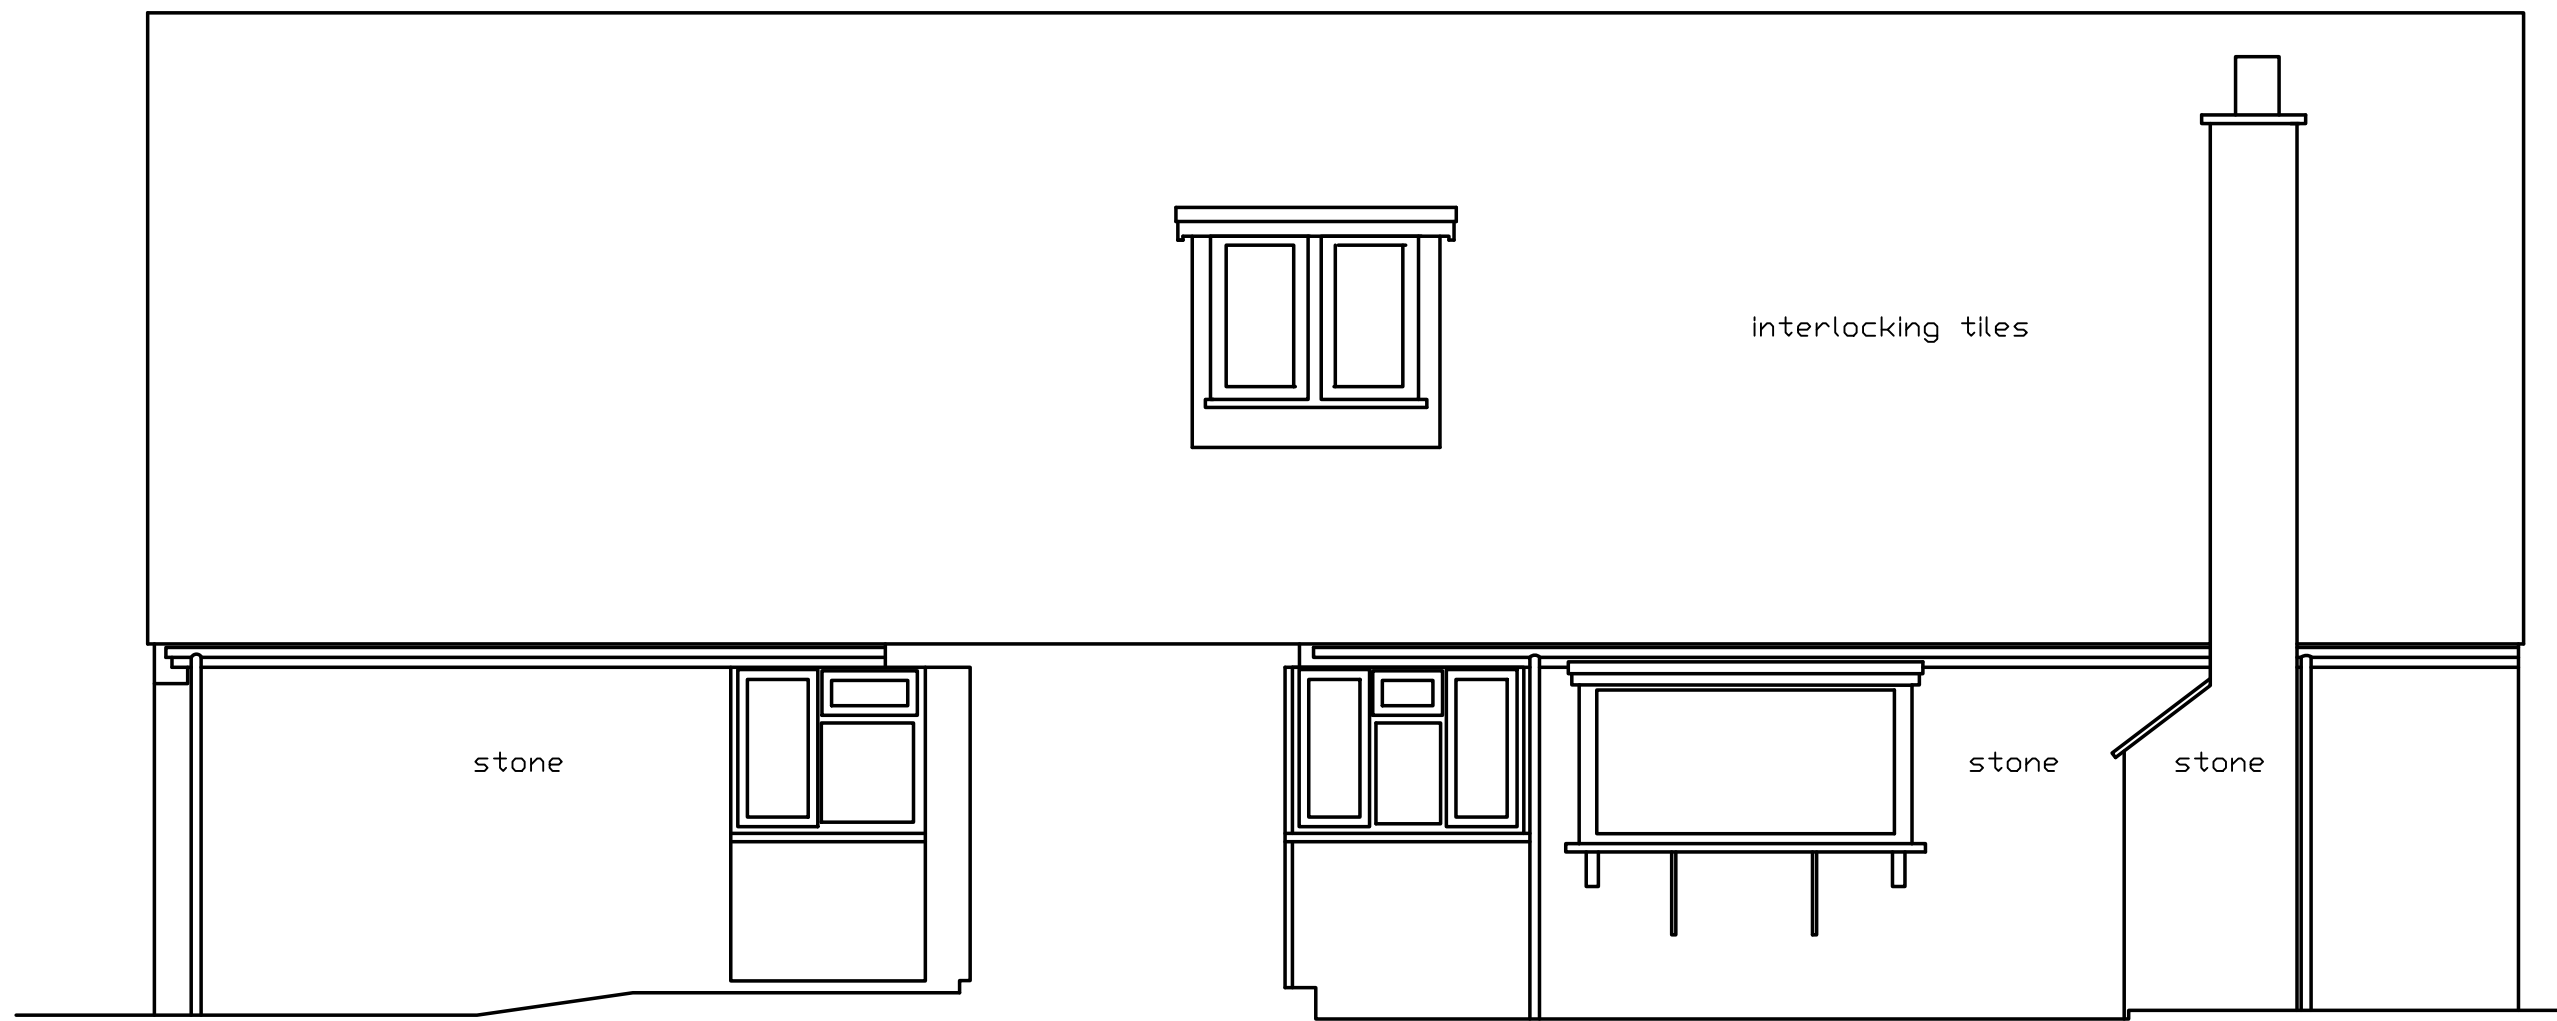

85.00m OAD

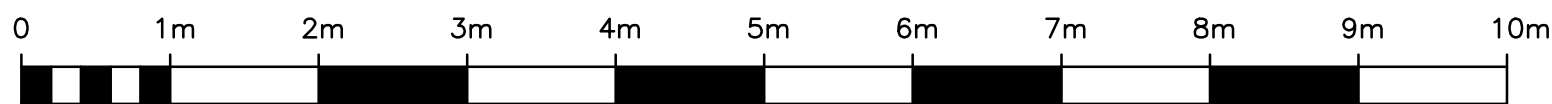

D&H Surveys

The Manor Stables, Great Somerford, Chippenham
Wiltshire, SN15 5EH.
Email: admin@dhsurveys.co.uk Tel (01249) 720545
Website: www.dhsurveys.co.uk Fax (01249) 721124

Topographic Surveys	Site Setting Out
Elevation Surveys	Co-ordination Of Site Layouts
Floor Plan Surveys	Rectified Photo Elevations
Volumetric Surveys	C.A.D Plotting Bureau
As Built Drainage Surveys	

Project Name:
2 Broadmead Close
Corsham SN13 9AN

Drawing Title:
House Elevations

Client:
Ms S Gill
Agent:
Clare Reid Architects

Date: Dec 2022	Scale: A1 @ 1:50
--------------------------	----------------------------

Drawn KJH	Surveyor GH	Dwg No EL 01	Revision
---------------------	-----------------------	------------------------	-----------------

Site Datum As Survey (OS)	OSBM Reference
-------------------------------------	-----------------------

Grid Orientation	Sheet ID GILL-Corsham-Broadmead CL
-------------------------	--

Disclaimer
D & H Surveys will Guarantee that this
Survey Data is Correct to the Indicated
Scale only.