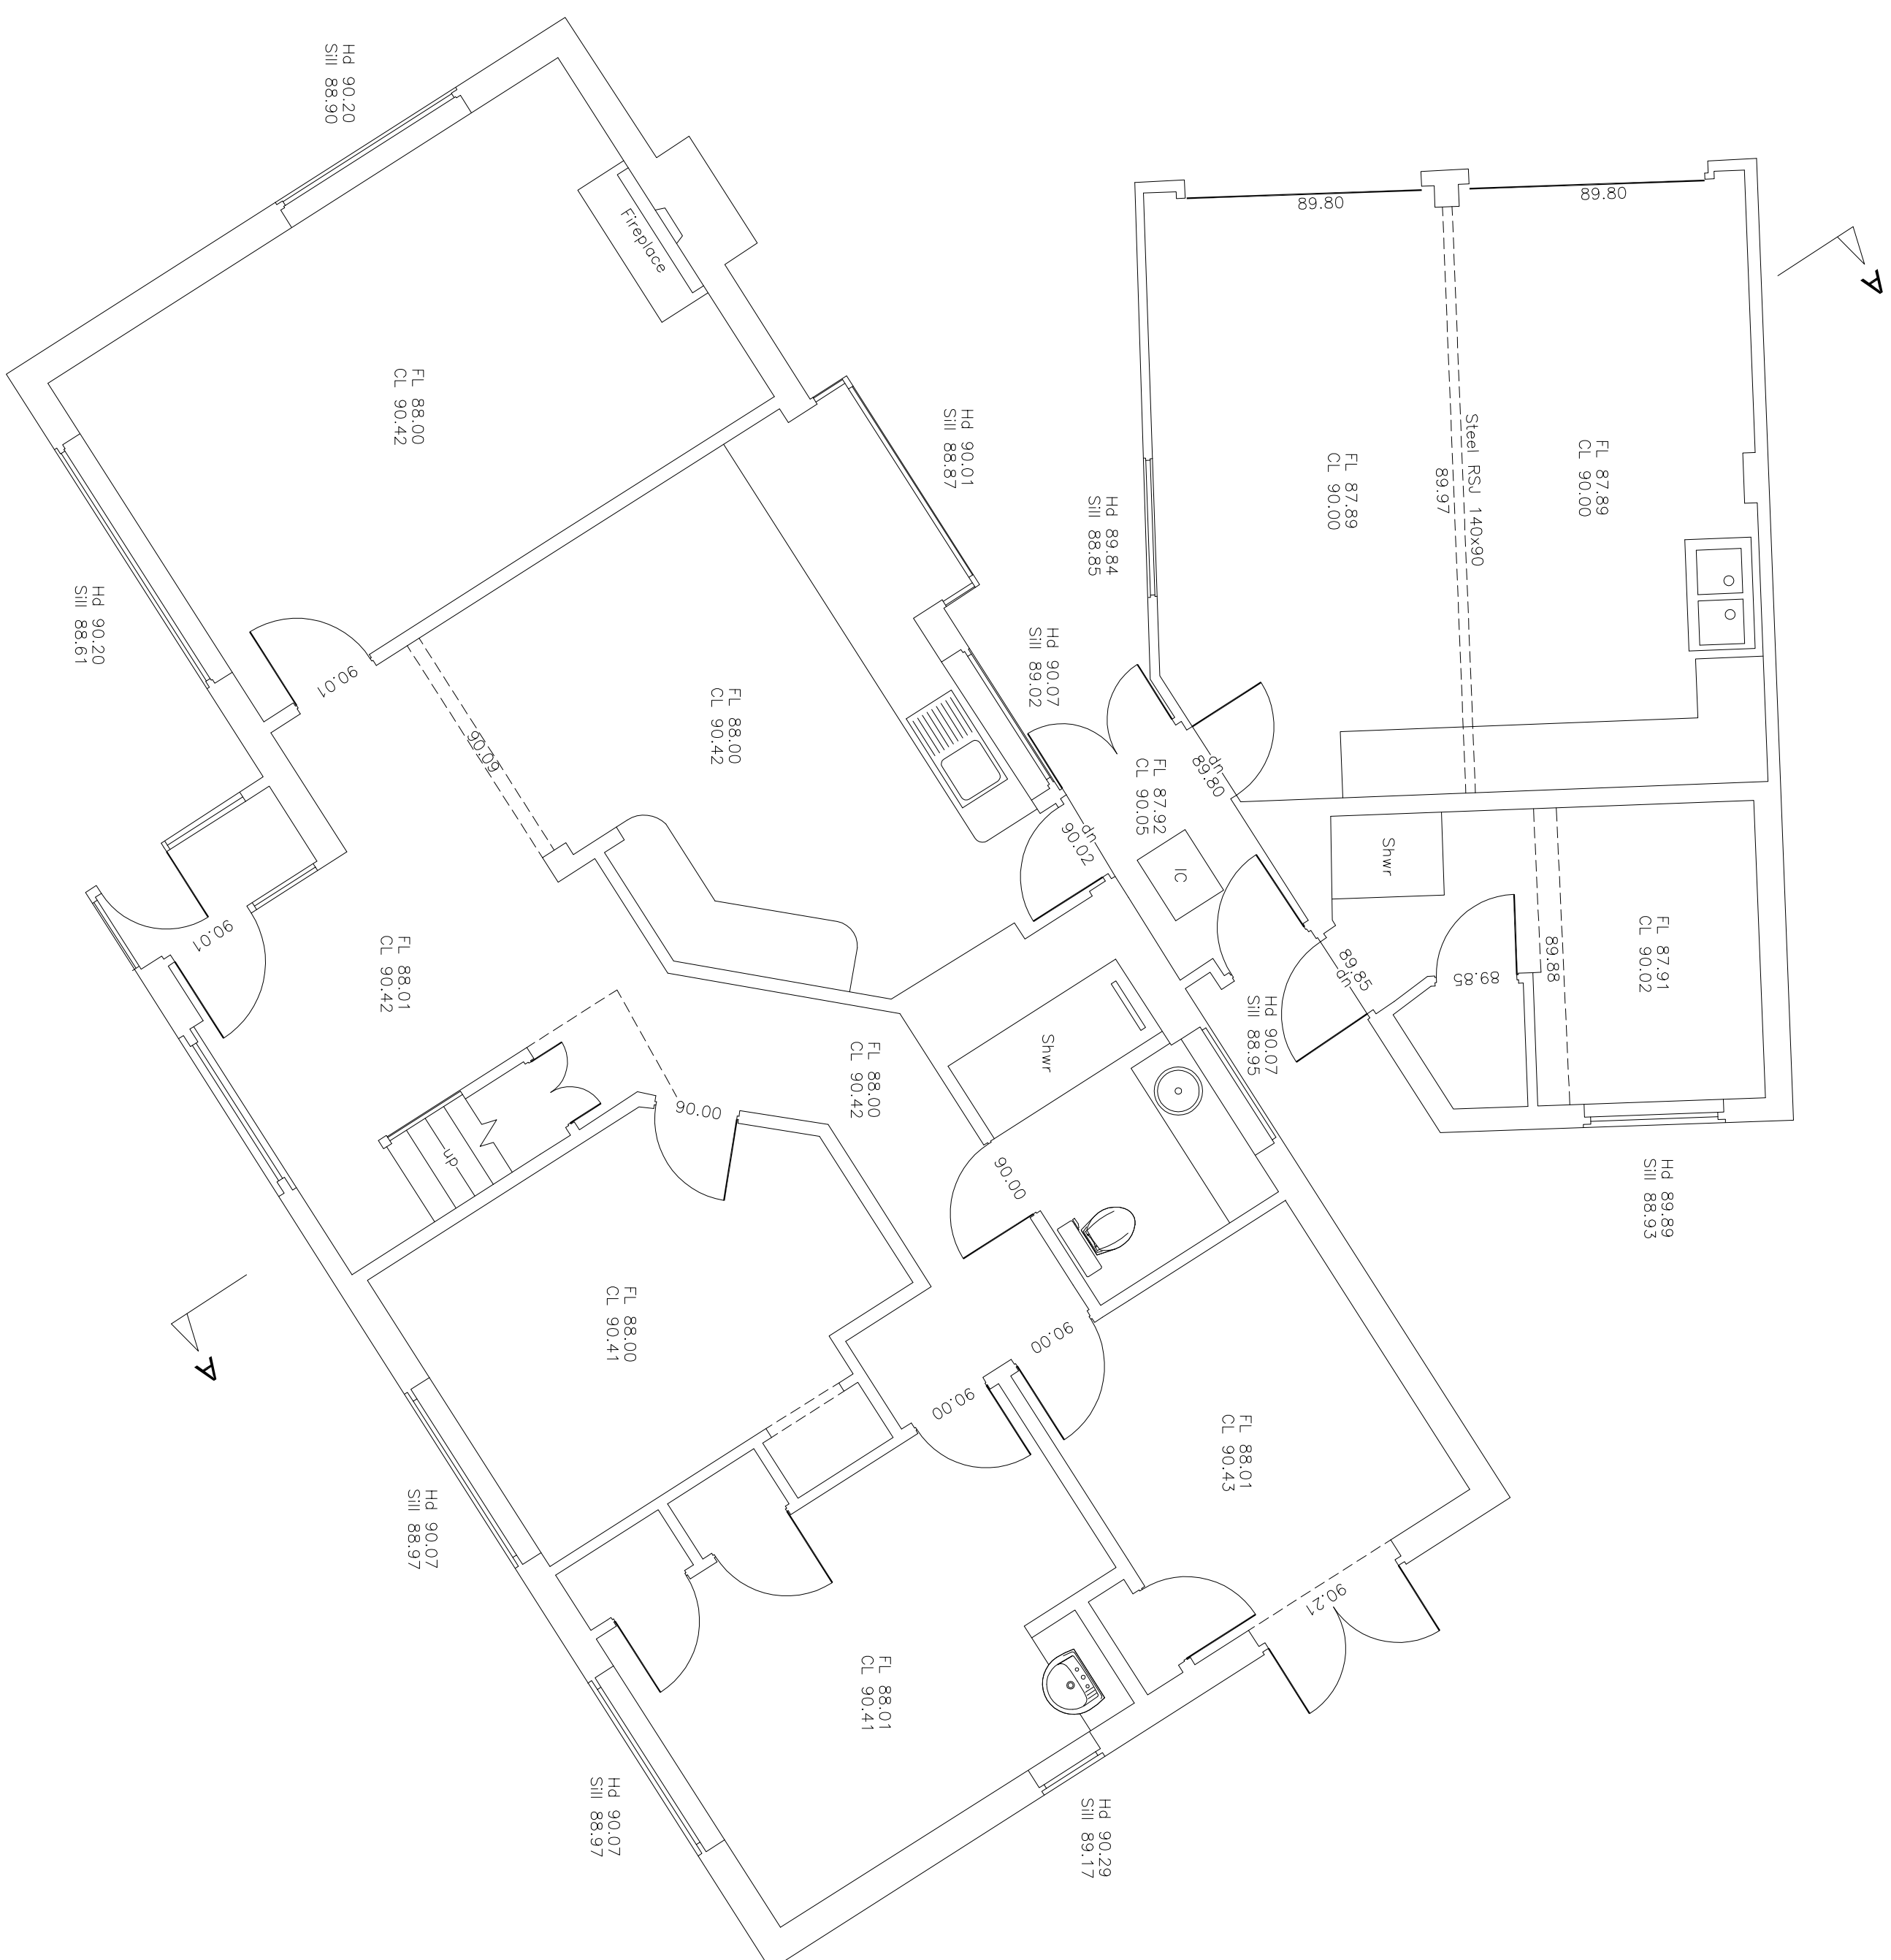
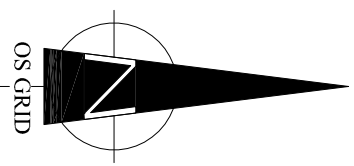


D&H Surveys Ltd The Manor Stables, Great Somerford, Chippingham Wiltshire, SN15 5EH Email: admin@dhurveys.co.uk Website: www.dhurveys.co.uk Tel (01249) 720545 Fax (01249) 721124			
Topographic Surveys Engineering Surveys Floor Plan Surveys Volumetric Surveys		As Built Drainage Surveys Drainage Surveys Rectified Photo Elevations C.A.D Plotting Bureau	
Project Name: 2 Broadmead Close Corsham			
Drawing Title: Ground Floor Plan			
Client: Ms S Gill Agent: Clare Reid Architects			
Date: Dec 2022		Scale: A1 @ 1/50	
Drawn	Surveyor	Dwg No	Revision
K.H	G.H	FP 01	
Site Datum Ordnance Survey		OSBM Ref OS15	
Grid Orientation Ordnance Survey		Sheet ID GLL-Corsham-Broadmead	
Disclaimer D & H Surveys will guarantee that this Survey Data & Station Coords are Correct to the Indicated Scale ONLY Copyright of this Drawing Remains With D & H Surveys			