

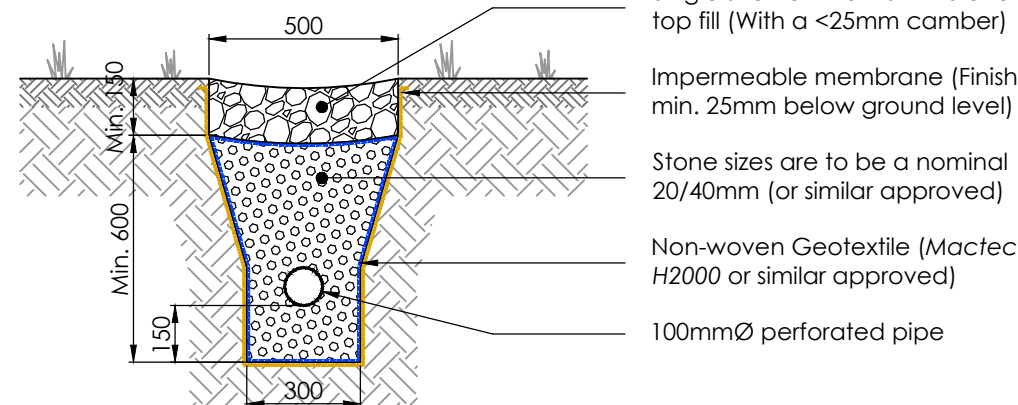
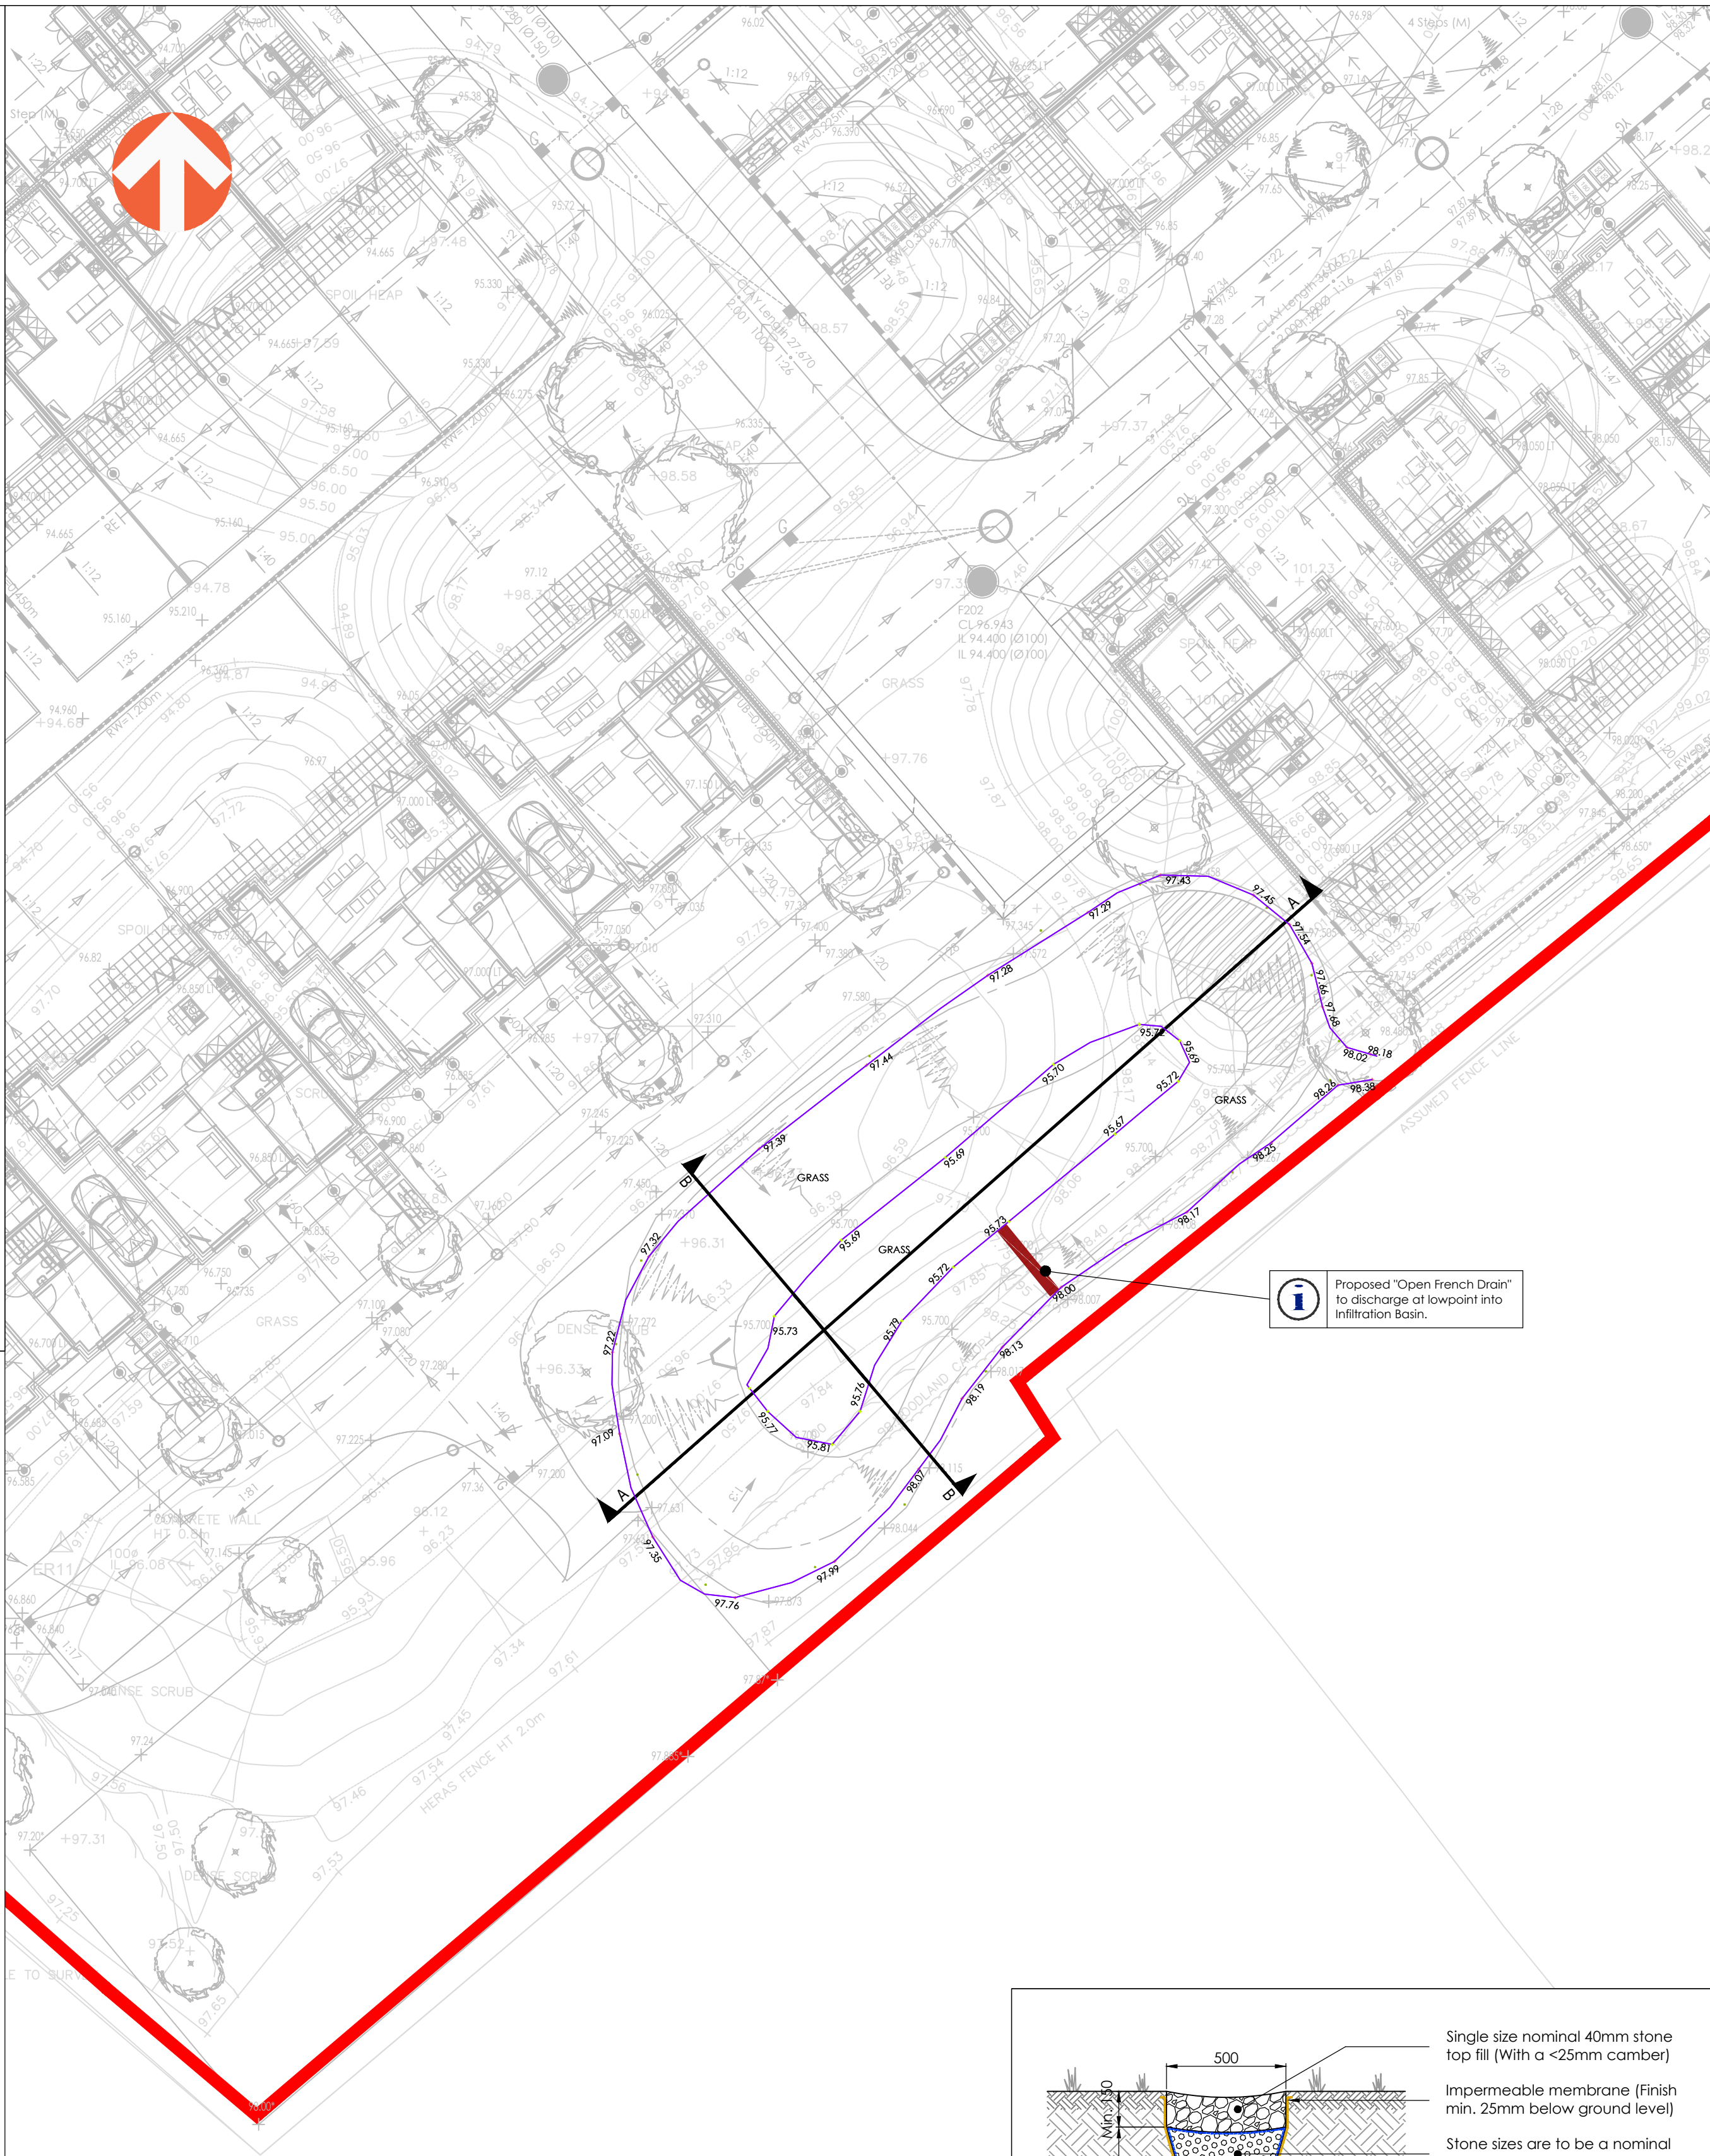
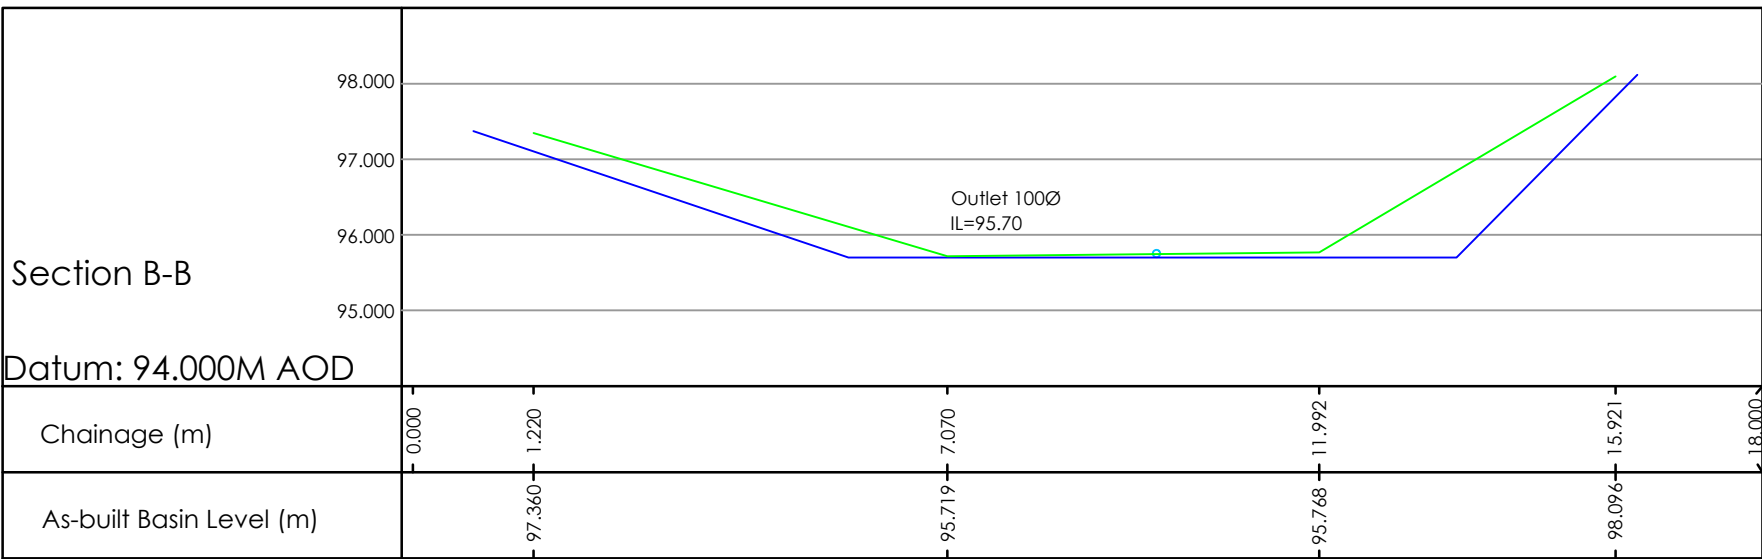


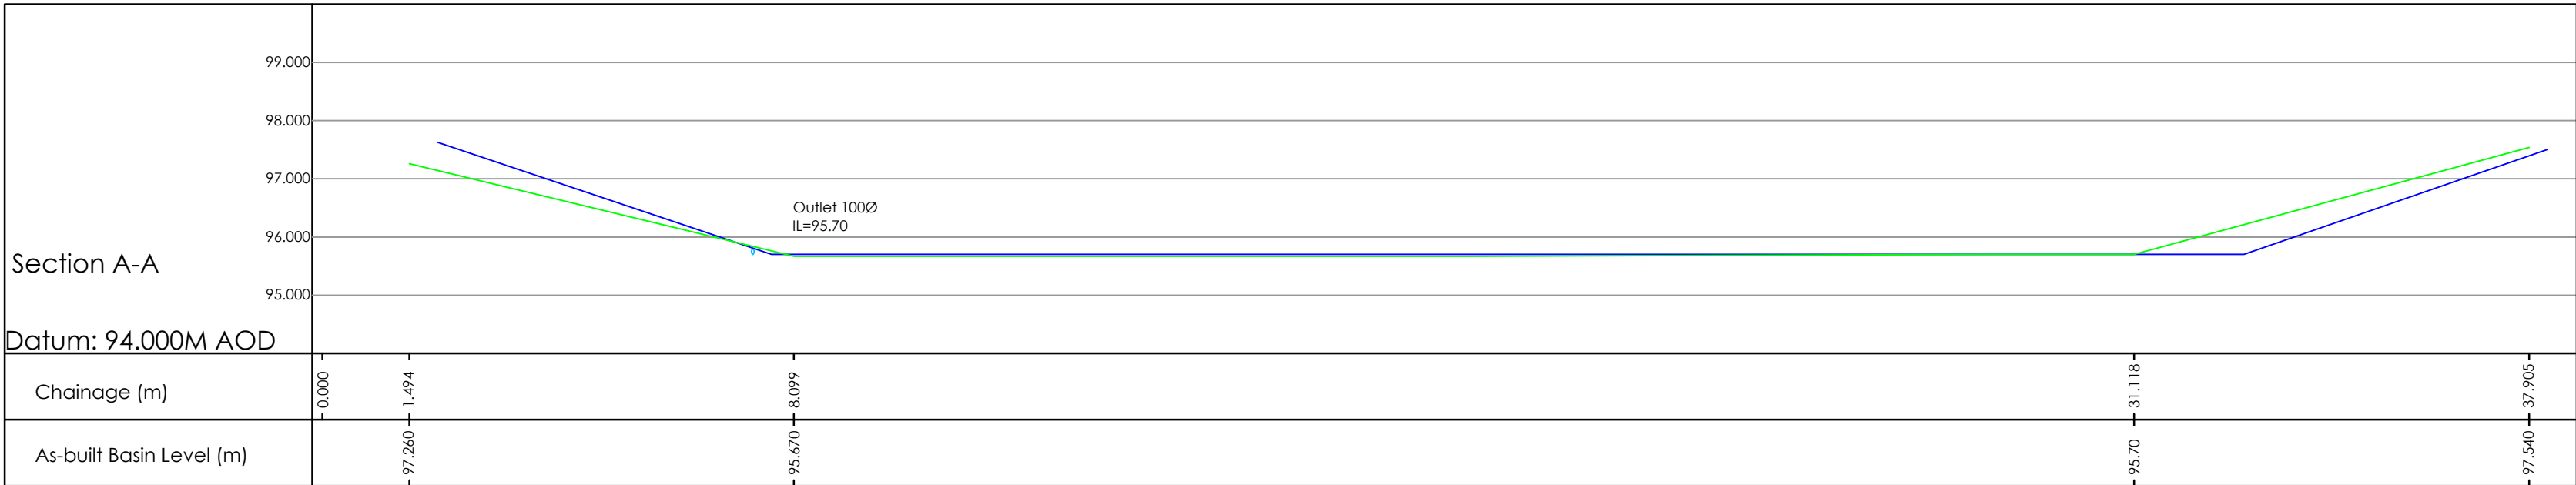

OPEN FRENCH DRAIN INTO DETENTION BASIN
(Not to scale)

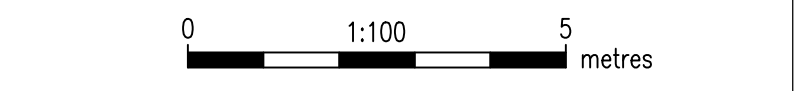

Key

As-built basin level

Original design as per that agreed under conditions 5 and 6 of outline planning permission 15/11604/OUT

Proposed basin level "taken from as-built Coombs Land Survey Calloway Gardens all ponds"



D	10.06.2026	OPEN FRENCH DRAIN ADDED TO LOW POINT OF BASIN & CONSTRUCTION DETAIL SHOWN	AG	JBE	CPY	PROJECT: WESTBURY HOSPITAL			DESIGN BY:  Awcock Ward Partnership, Ada House, Pynes Hill, Exeter, EX2 5TU Tel: 01392 409007 Web: www.awpexeter.com
C	20.01.2026	KEY UPDATED TO SUIT LATEST COMMENT	ZC	CPY	CPY	TITLE: BASIN CROSS SECTION PLAN			
B	09.01.2026	SECTIONS UPDATED TO SUIT LATEST AS-BUILT	TJS	JBE	GJM	PROJECT No: 0654			
REV	DATE	DESCRIPTION	BY	CHK	APD	DRAWING No: 03-SK-1101			
CLIENT: BACKHOUSE HOUSING LTD						REV: D			
DRAWING STATUS: FOR INFORMATION ONLY						SCALE @ A1: AS SHOWN			