




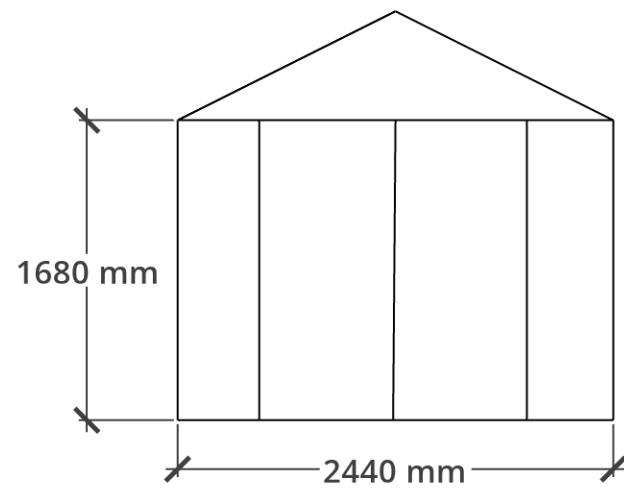


SOUTH EAST ELEVATION

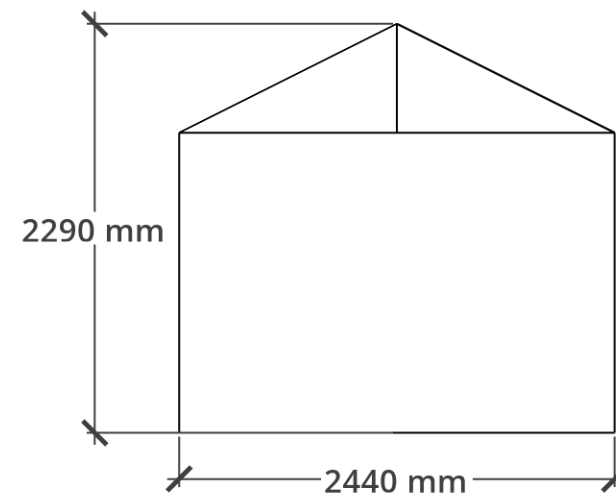


NORTH WEST ELEVATION

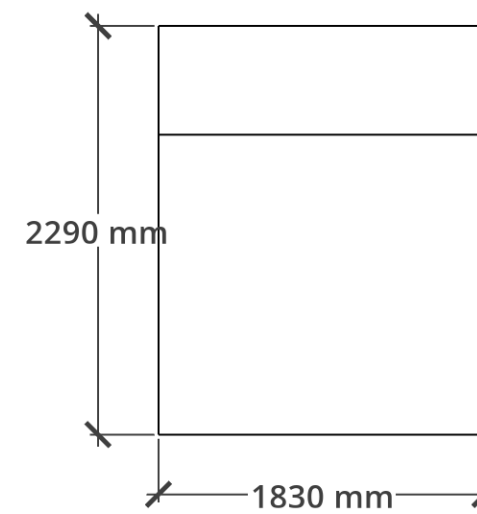

NORTH EAST ELEVATION

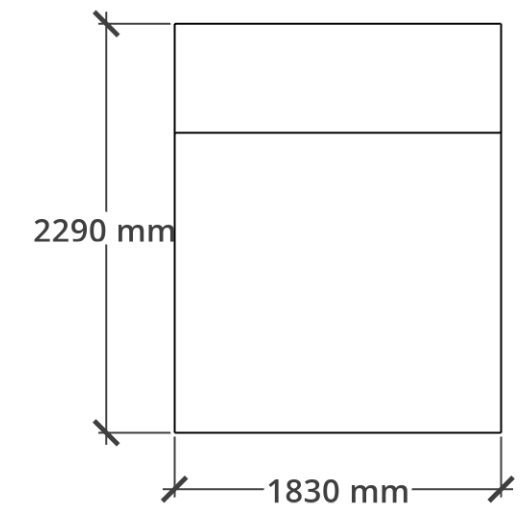

SOUTH WEST ELEVATION

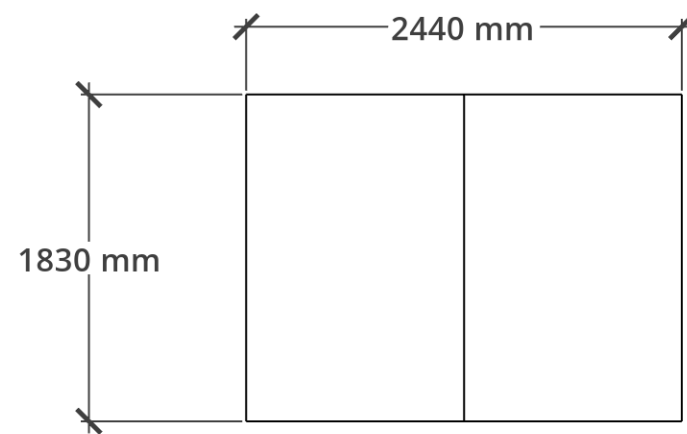

ROOF PLAN

EXISTING SHED ELEVATIONS (AS BUILT)

BUILDING 3

Scale 1:50 @ A3

| - - 0.5 - - | - - 1.0m - - |