


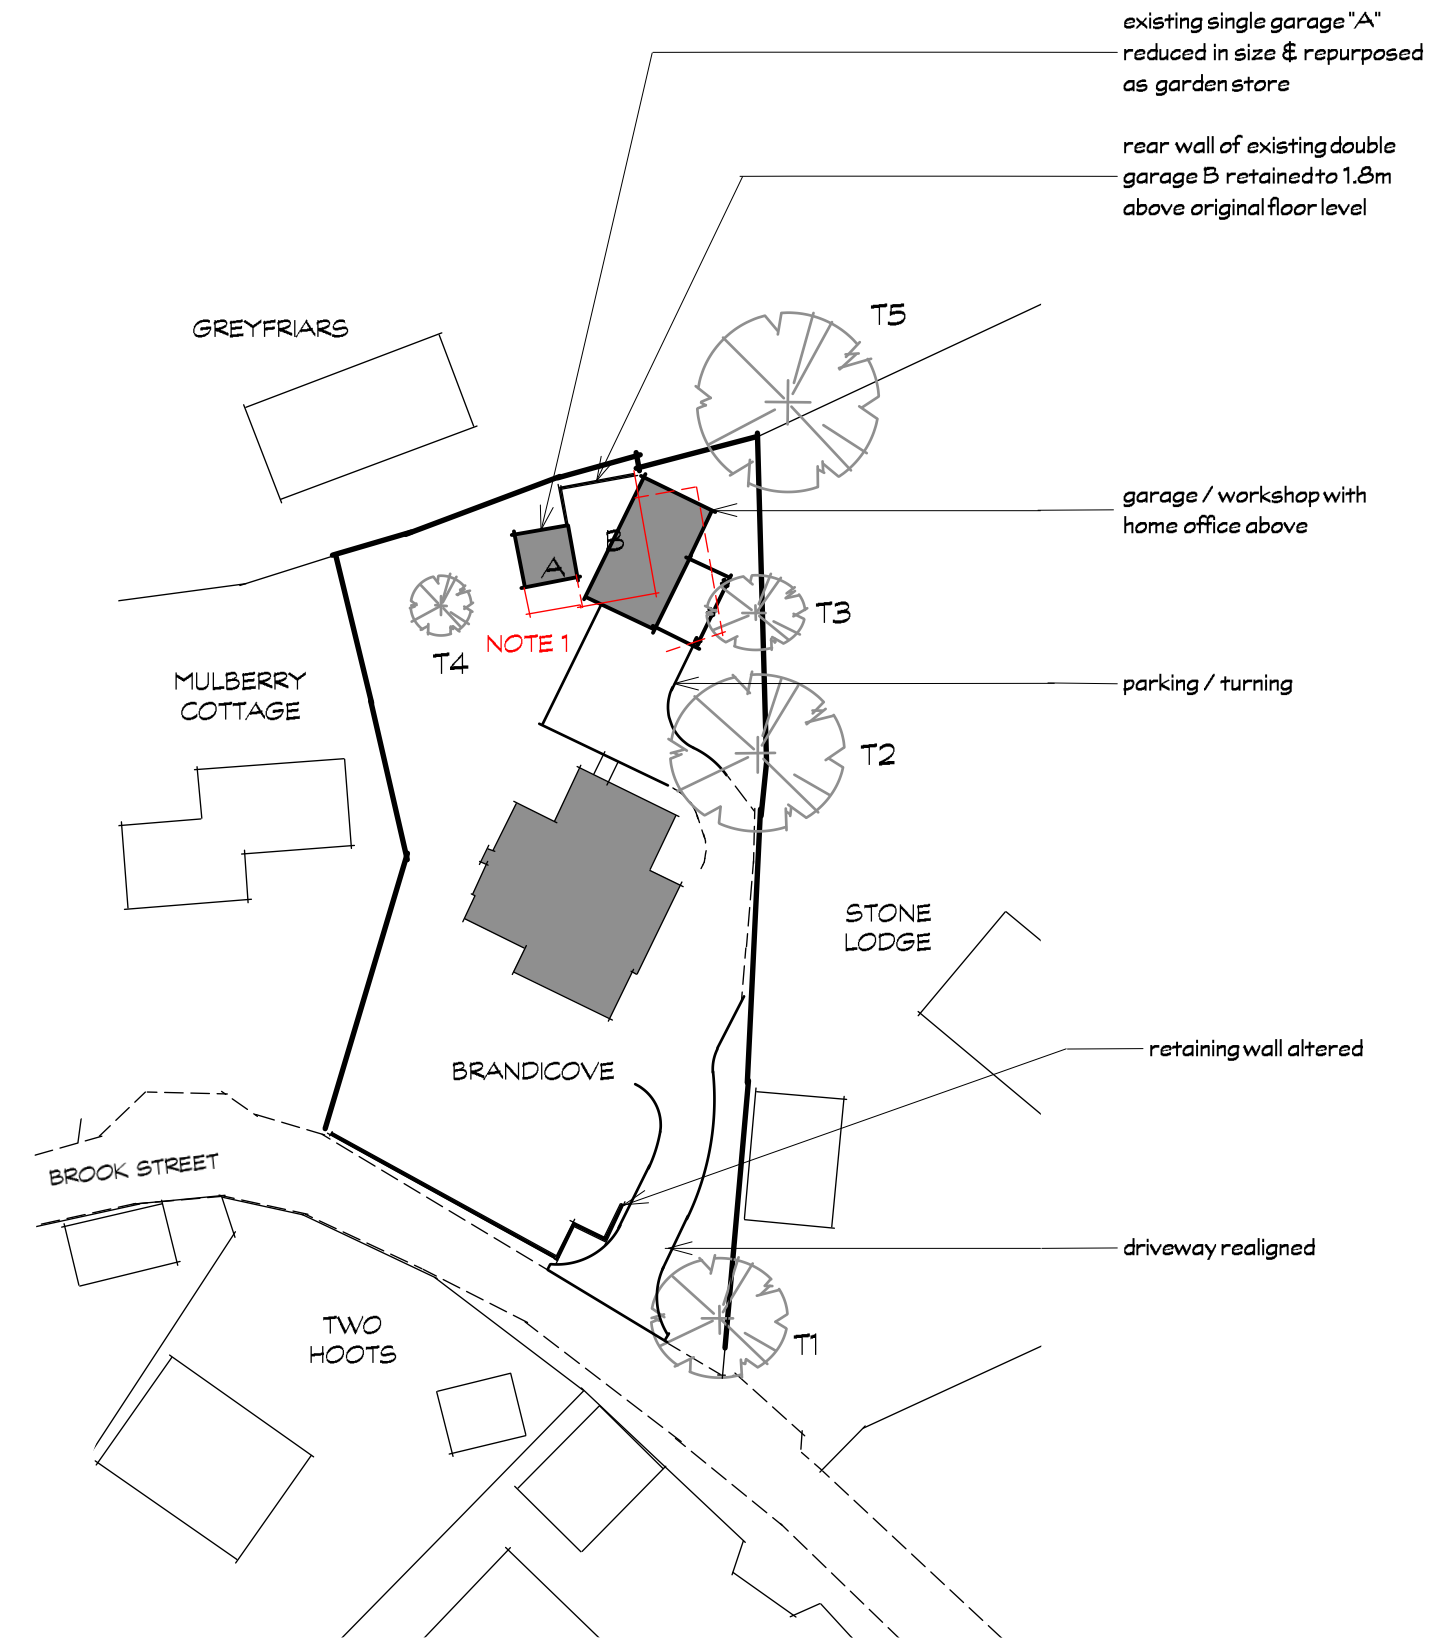

existing single garage "A"
reduced in size & repurposed
as garden store

rear wall of existing double
garage B retained to 1.8m
above original floor level

garage / workshop with
home office above

parking / turning

retaining wall altered

driveway realigned

NOTES

1. Footprint of existing garages "A" and "B" and hard standing shown in red.
2. For tree details refer to Design Statement.

Brandicove, Brook Street
Fovant, Salisbury
SP3 5JB

Block Plan (Proposed)

28 August 2026

PROPOSED



scale 1:500 at A4