



NOTES

1. ALL DIMENSIONS ARE IN MILLIMETERS UNLESS STATED OTHERWISE
2. ALL DIMENSIONS TO BE CHECKED ON SITE BY THE CONTRACTOR PRIOR TO PREPARATION OF SHOP DRAWINGS, ORDERING MATERIALS OR COMMENCING WORKS.
3. THIS DRAWING HAS BEEN PREPARED SOLELY FOR THE PURPOSES OF OBTAINING EITHER PLANNING CONSENT OR BUILDING APPROVAL.

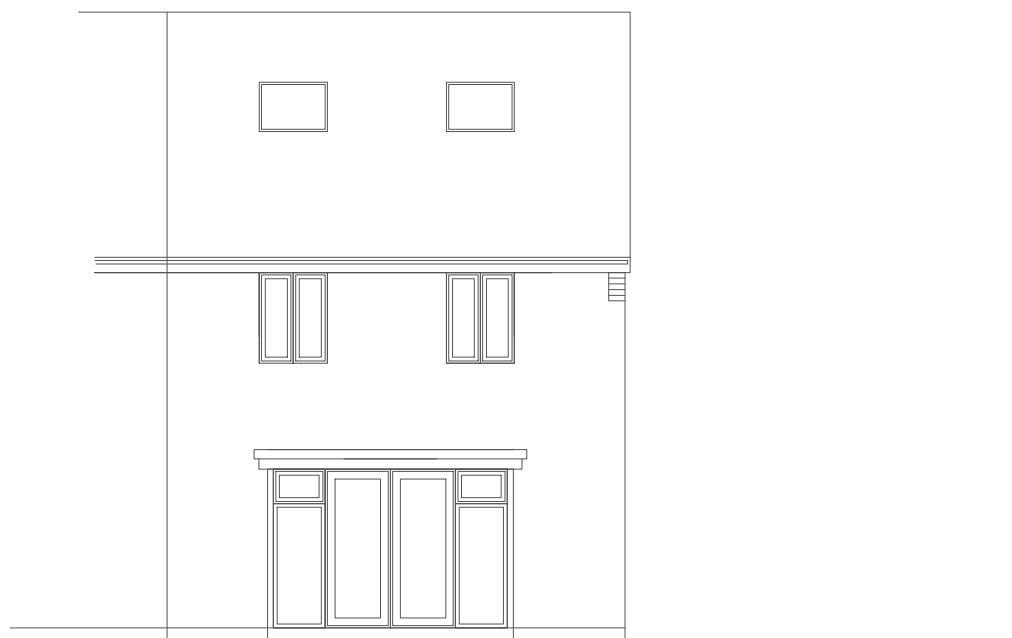

REAR ELEVATION (BEFORE DEVELOPMENT) 1:100

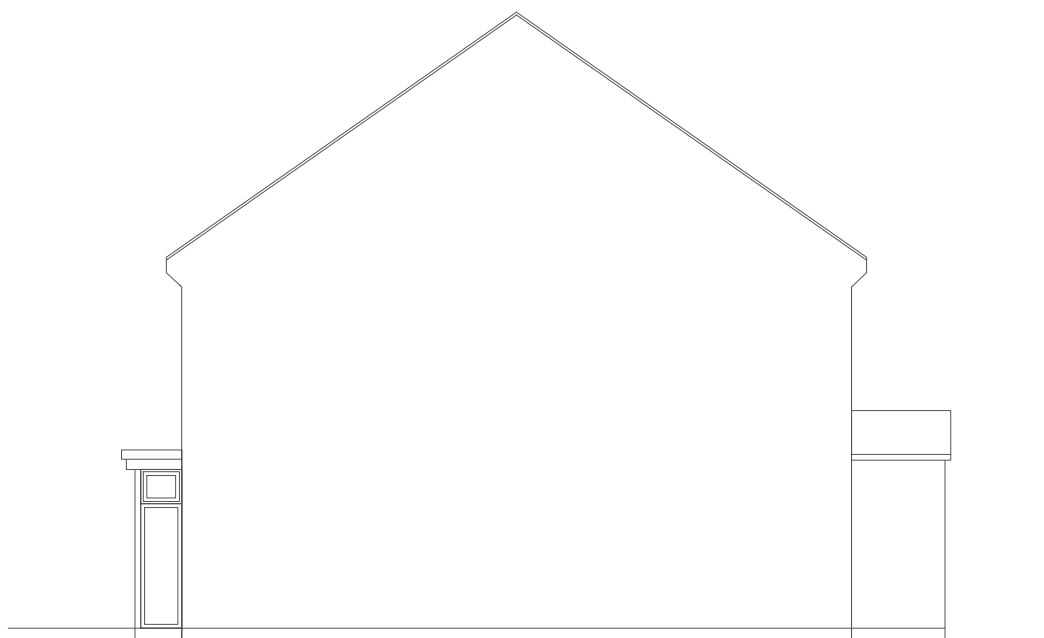

SIDE ELEVATION BEFORE DEVELOPMENT1:100



FRONT ELEVATION BEFORE DEVELOPMENT1:100



PROPOSED (AS BUILT) REAR ELEVATION 1:100




EXISTING SIDE ELEVATION 1:100




EXISTING FRONT ELEVATION 1:100


Extension.

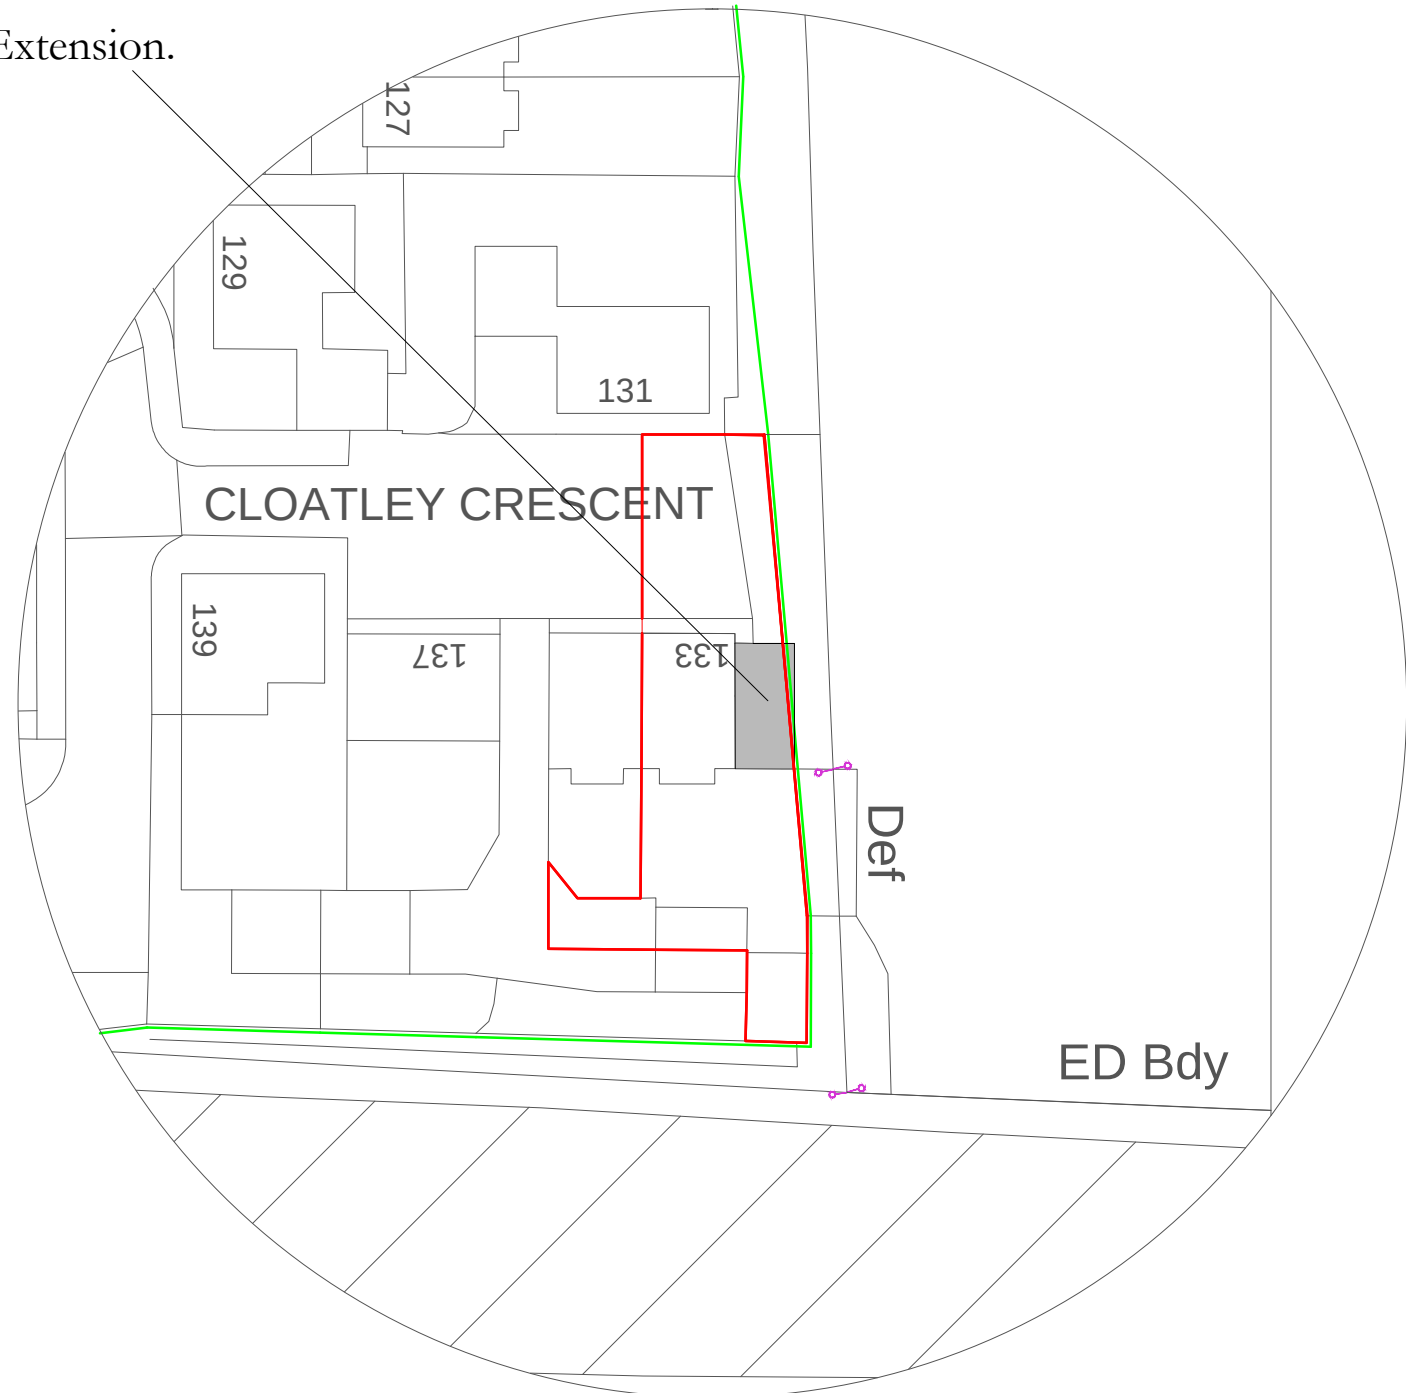

Block Plan Scale 1:500

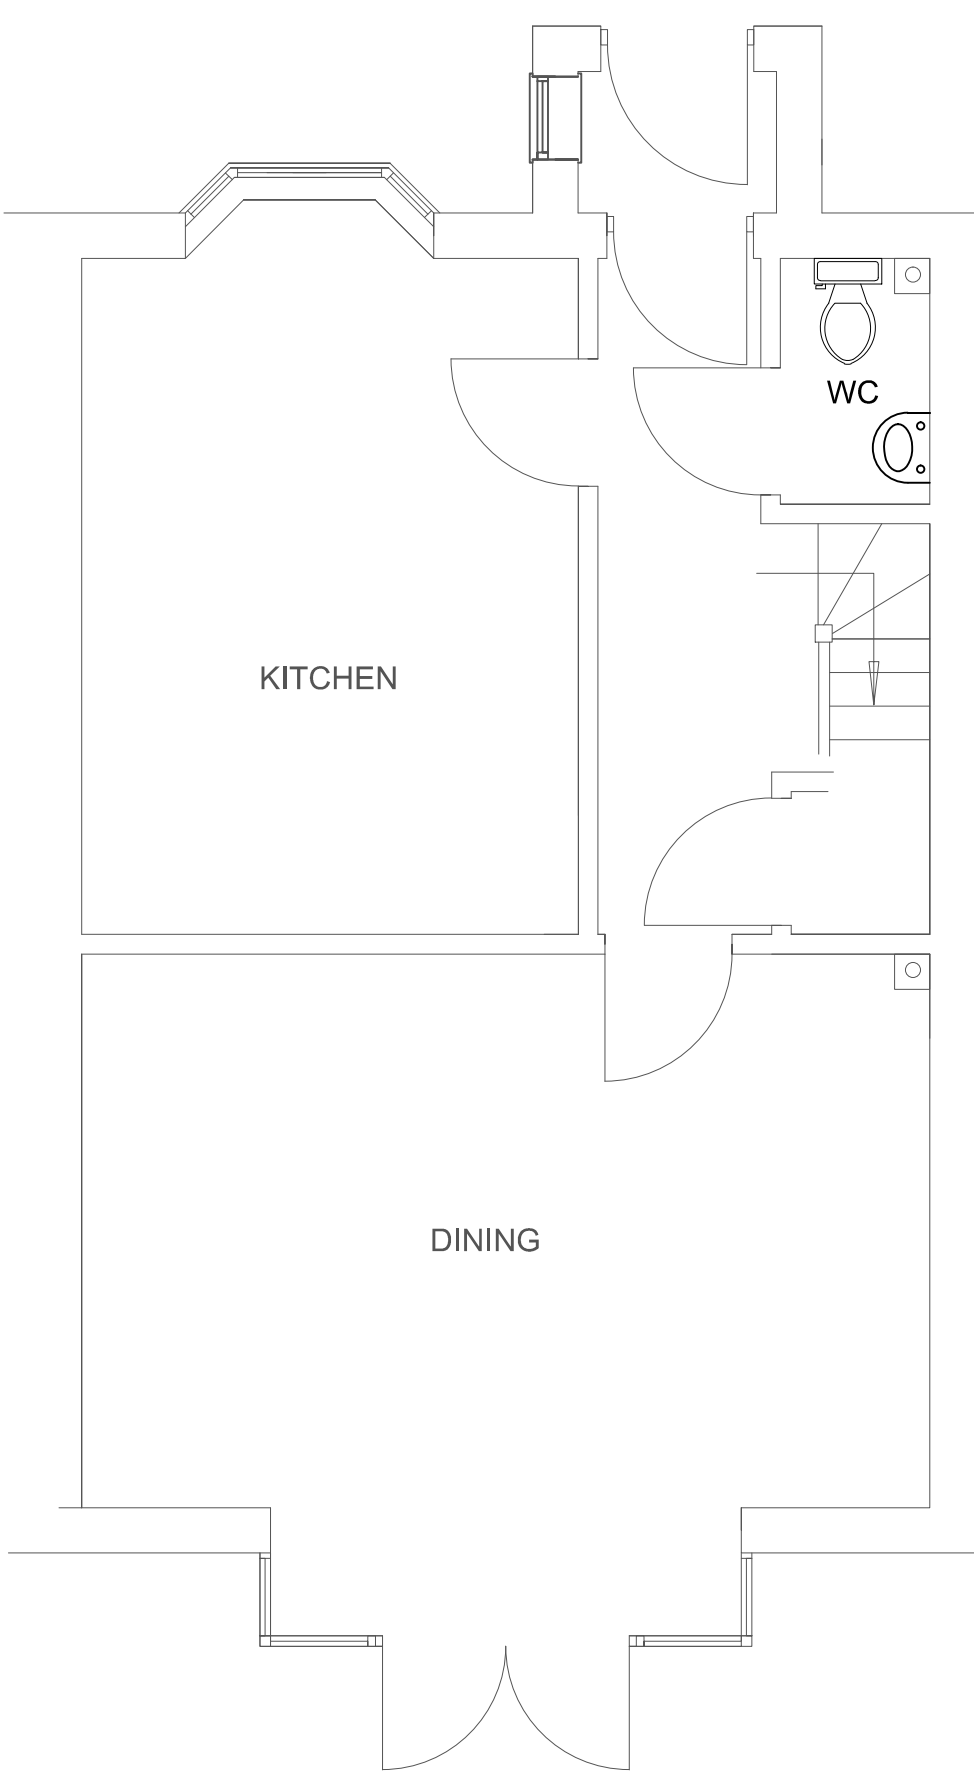


GROUND FLOOR BEFORE DEVELOPMENT.

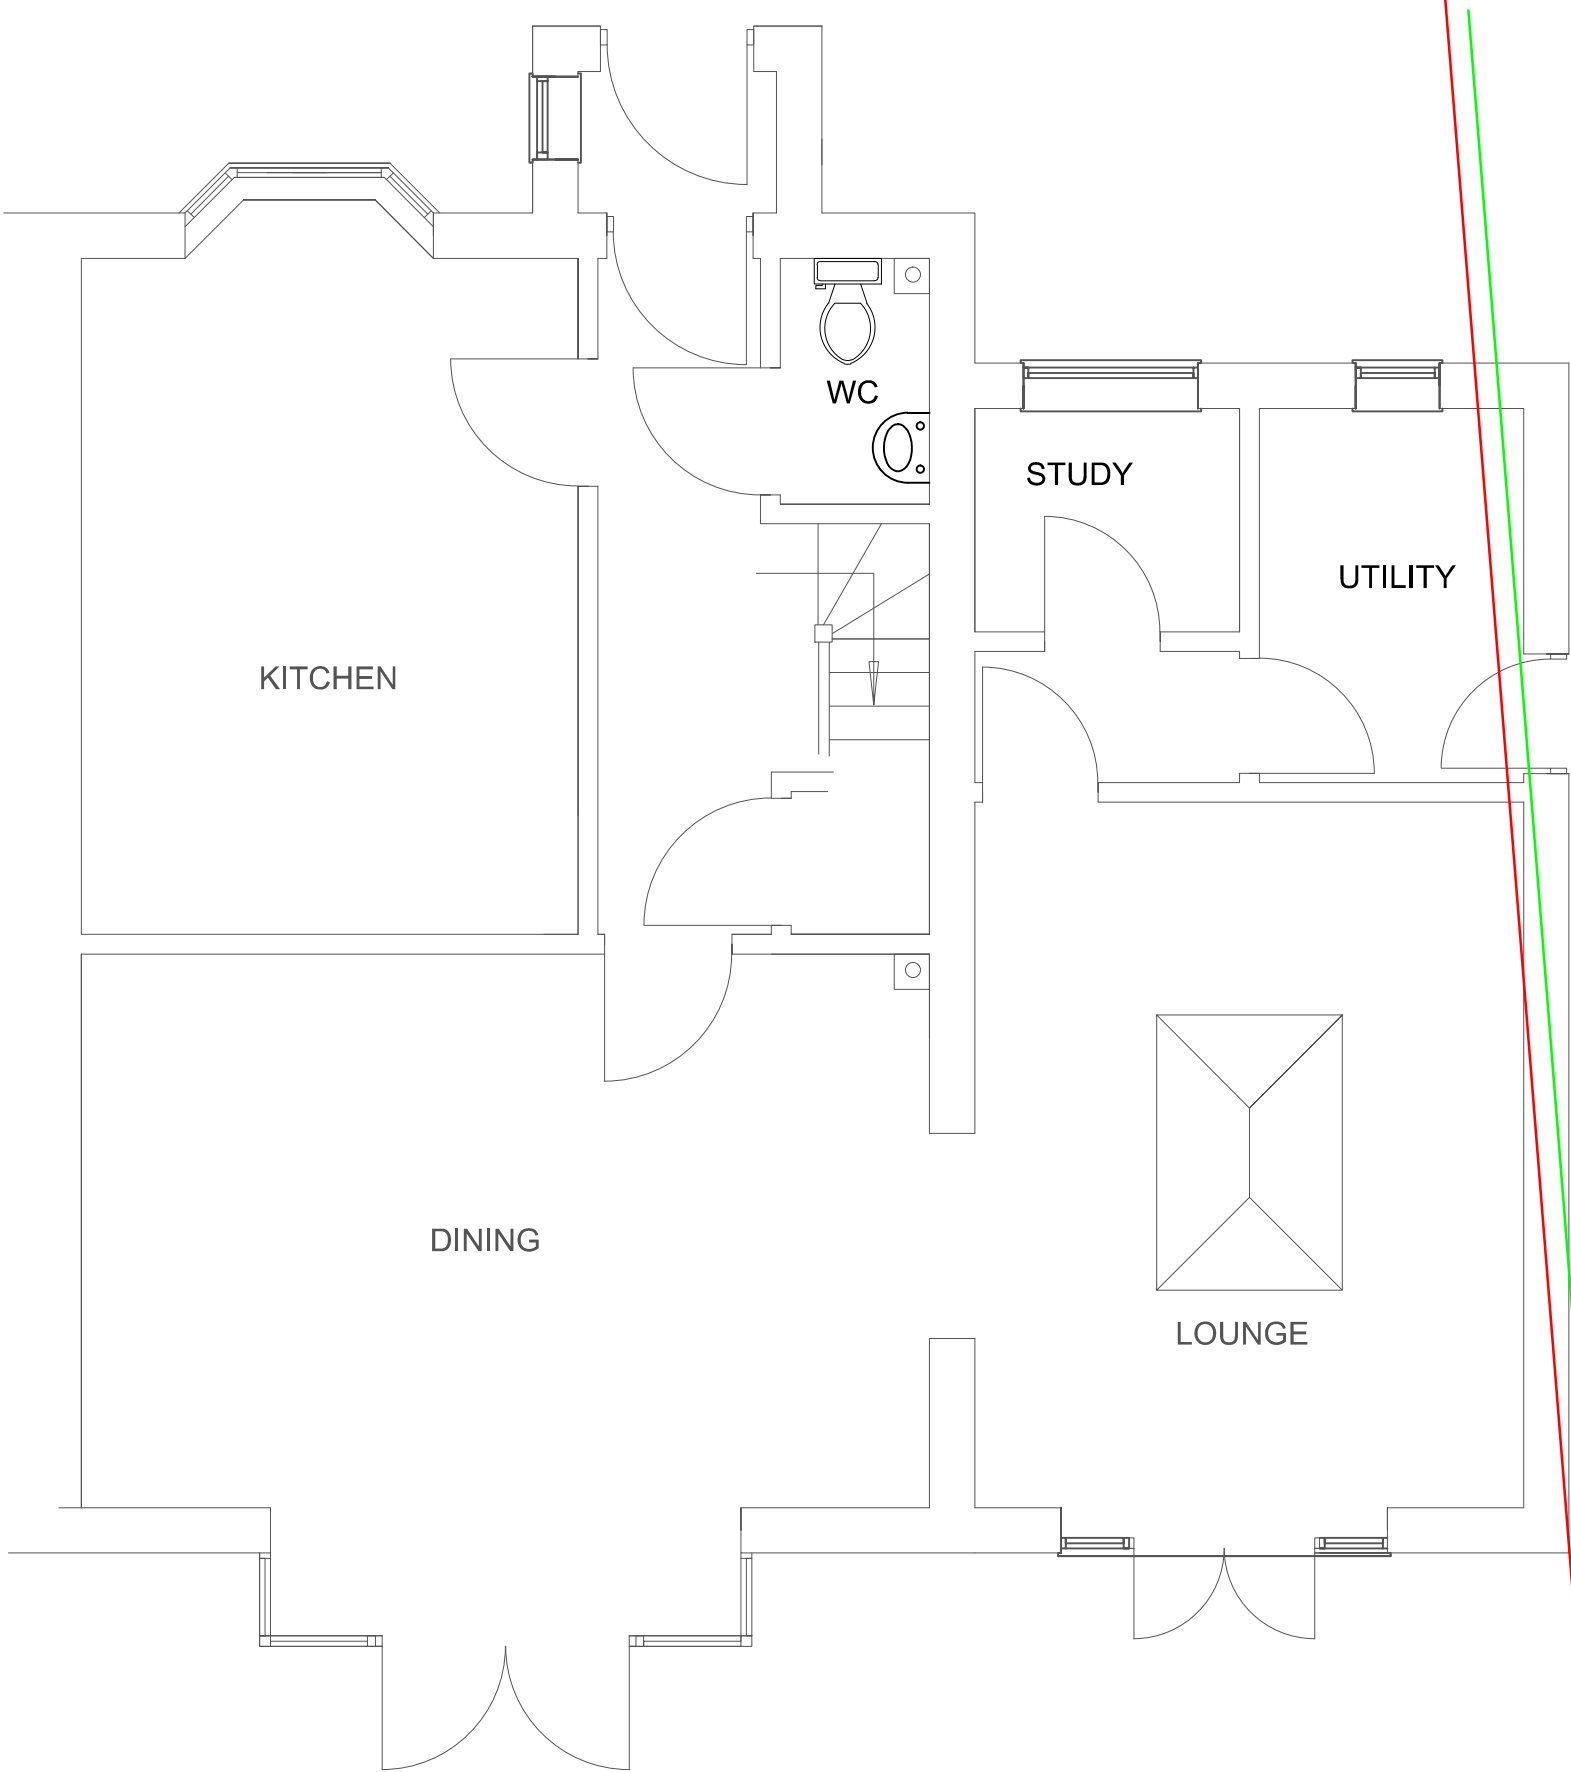


GROUND FLOOR WITH DEVELOPMENT.


Green Boundary
owned by Wiltshire
Council.

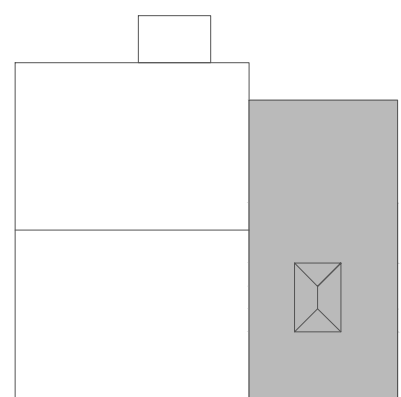


Roof plan Scale 1:200

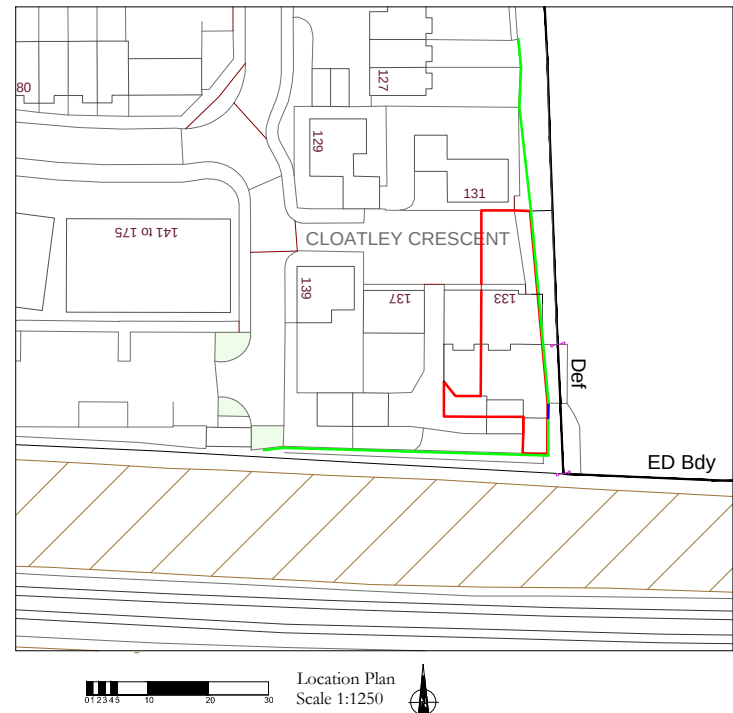

Location Plan
Scale 1:1250

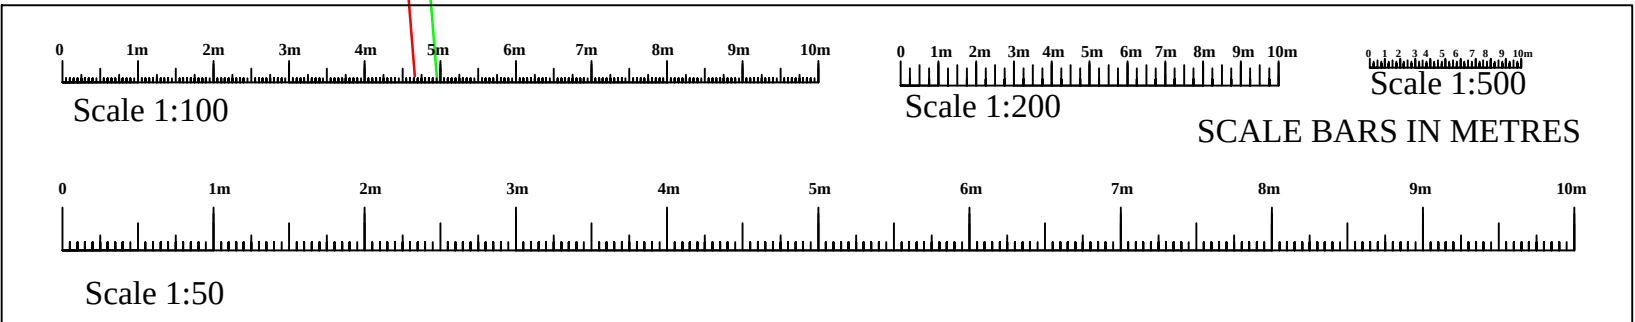

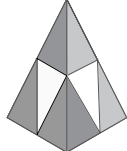client	Mr and Mrs Batten.		
SITE ADDRESS	133 Cloatley Crescent Royal Wootton Bassett Wiltshire SN4 7FX.		
PROJECT	Retrospective application for Single side extension.		
			
	Phil Rand Cherry Tree House Clardon lane Purton. Wiltshire SN5 4HN TEL 01793 771128		
Drawn by	Phil Rand	Drawing No	01 rev 1
Scales	1:500 1:100 1:50	Date	29th June 2026