


90 STRATFORD ROAD, SALISBURY, SP1 3JS

DIMENSIONED SITE LAYOUT - PROPOSED / AS CONSTRUCTED

Scale 1:100 @ A4 when printed at 100% / actual size

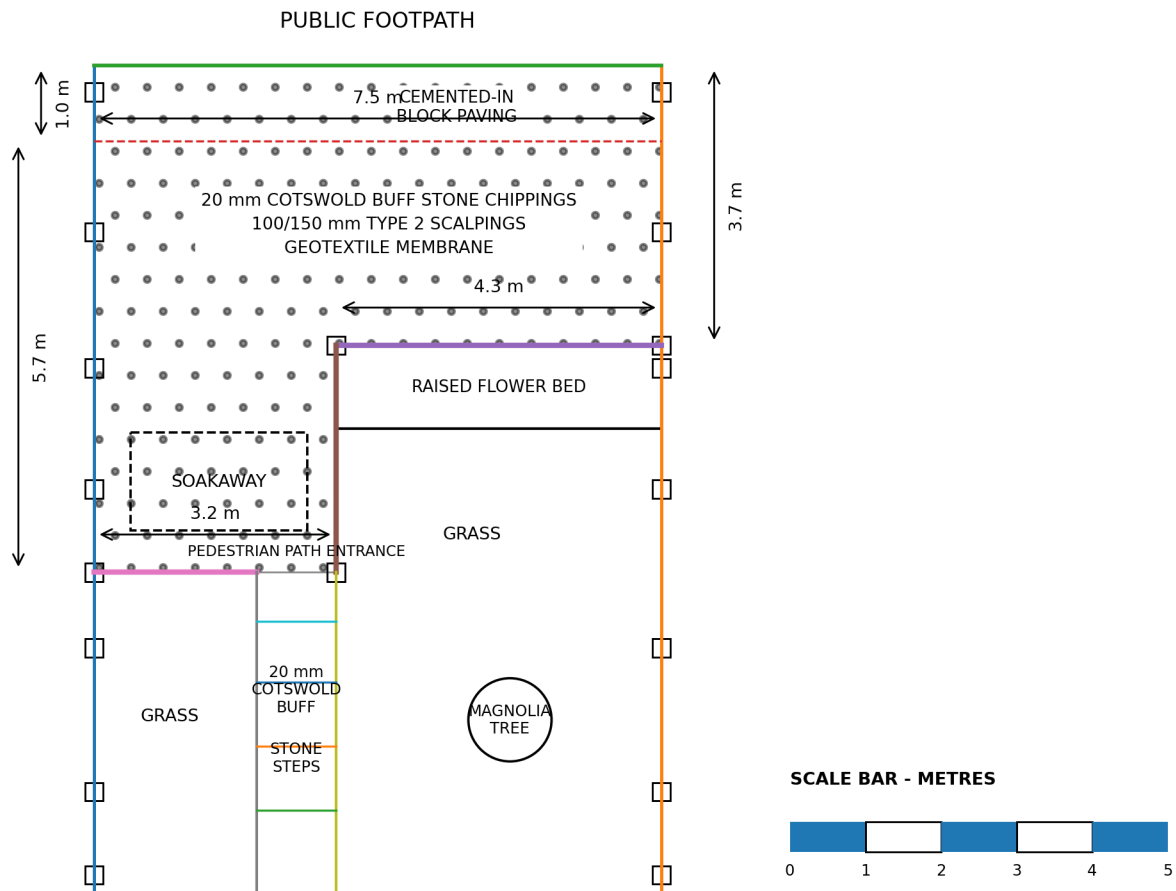

Scale 1:100 @ A4

PRINT AT 100% / ACTUAL SIZE