
 



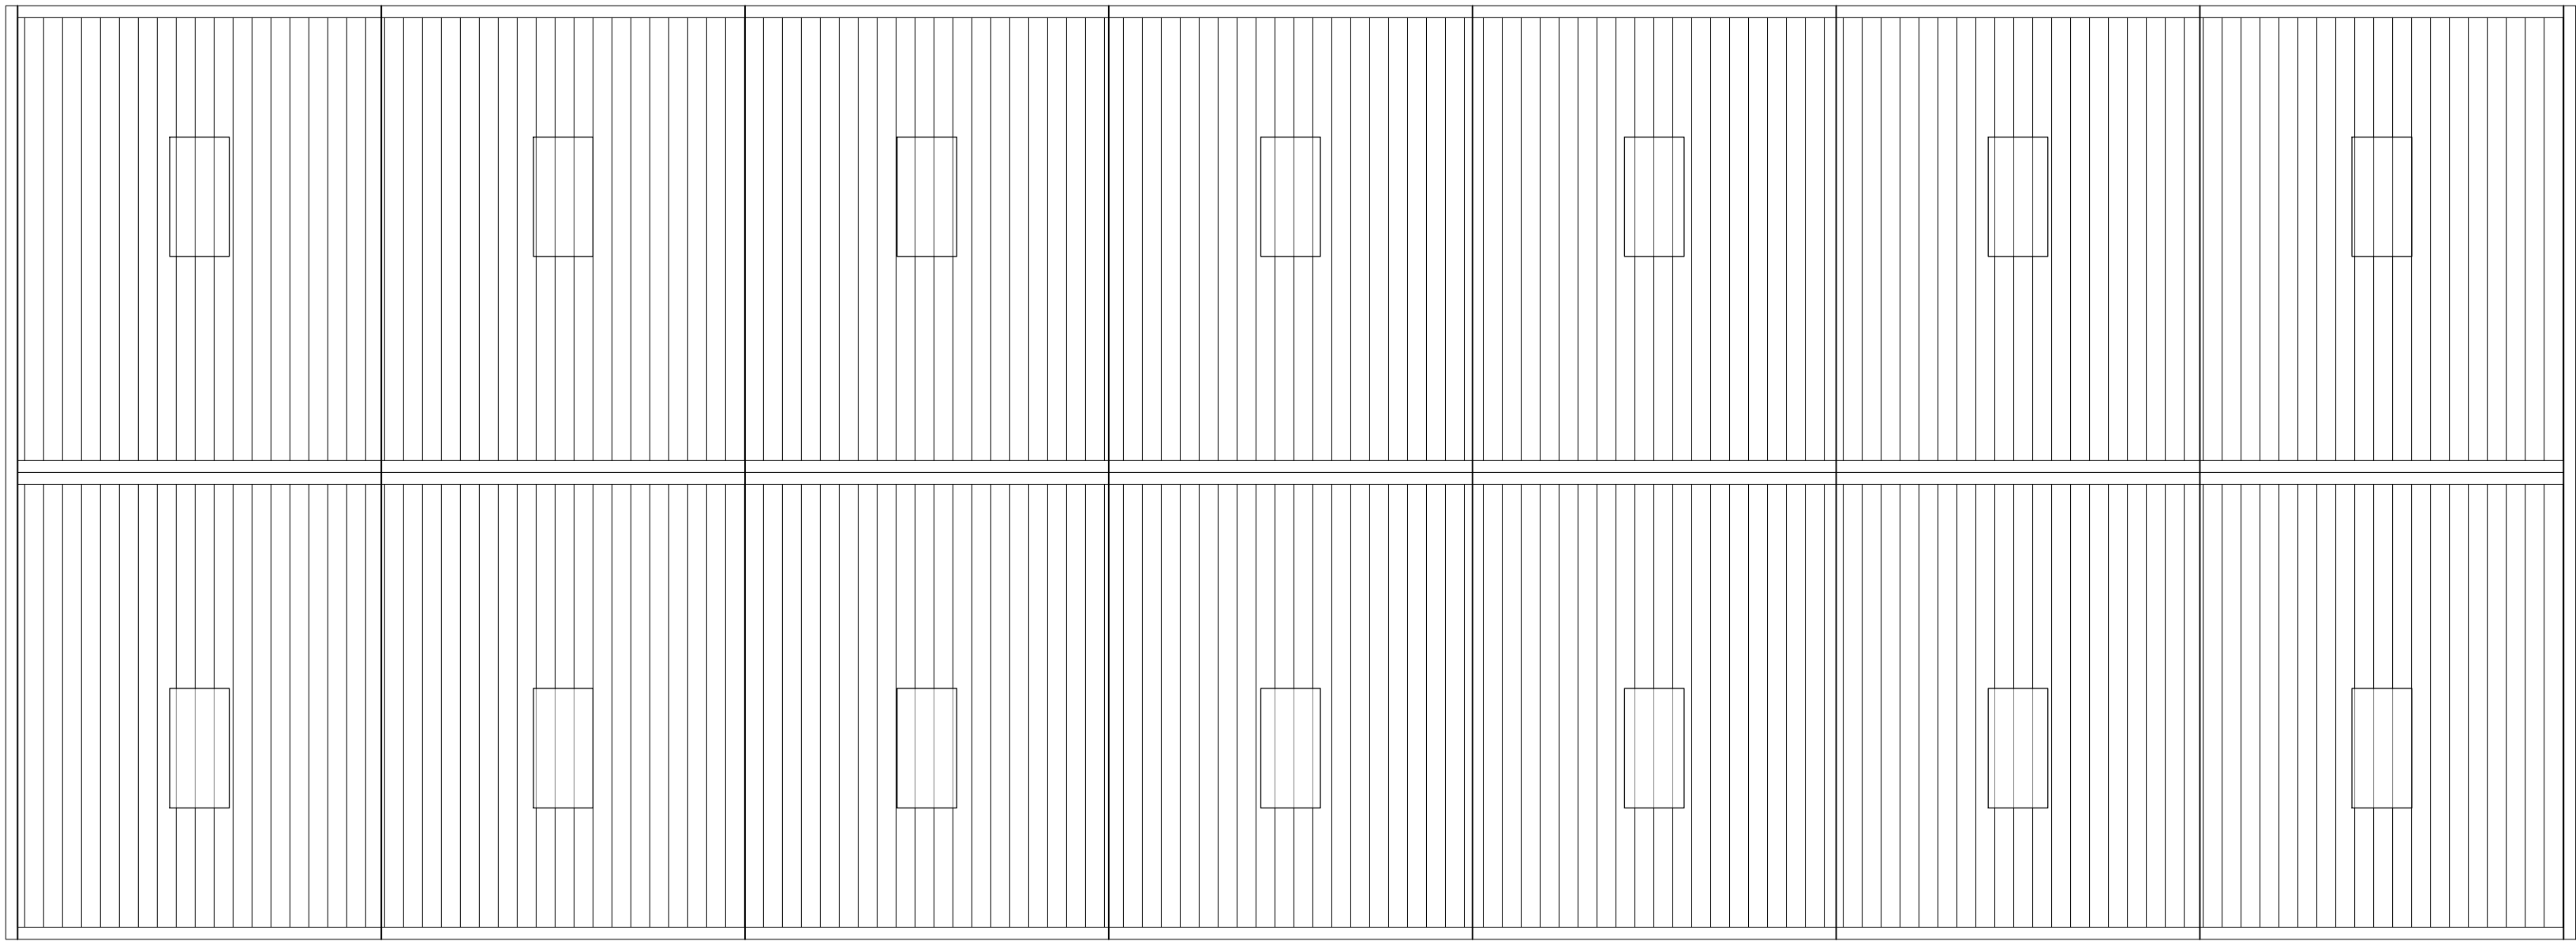


Roof Plan




Floor Plan

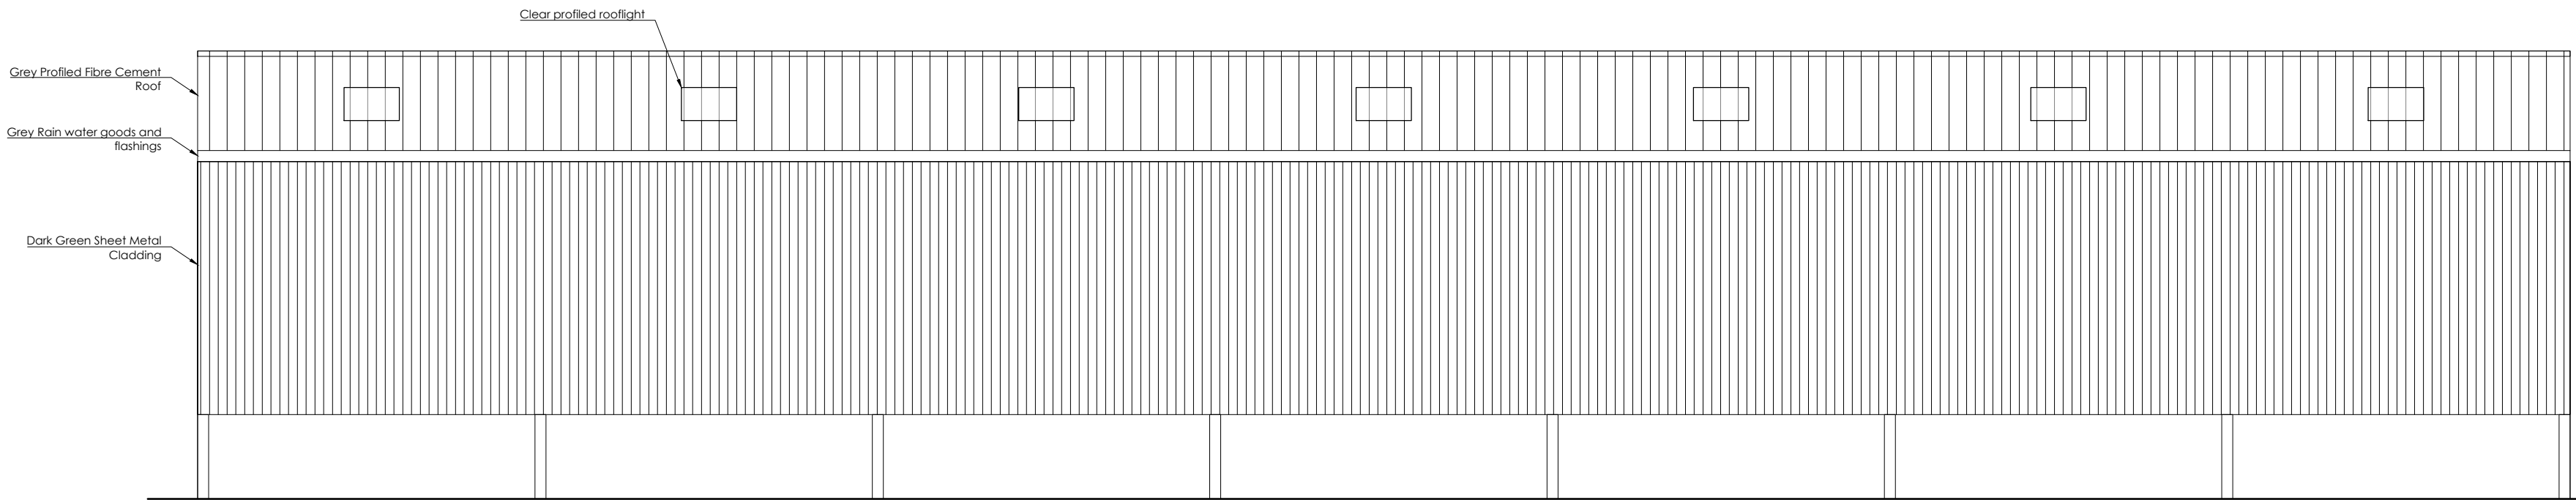


East Elevation

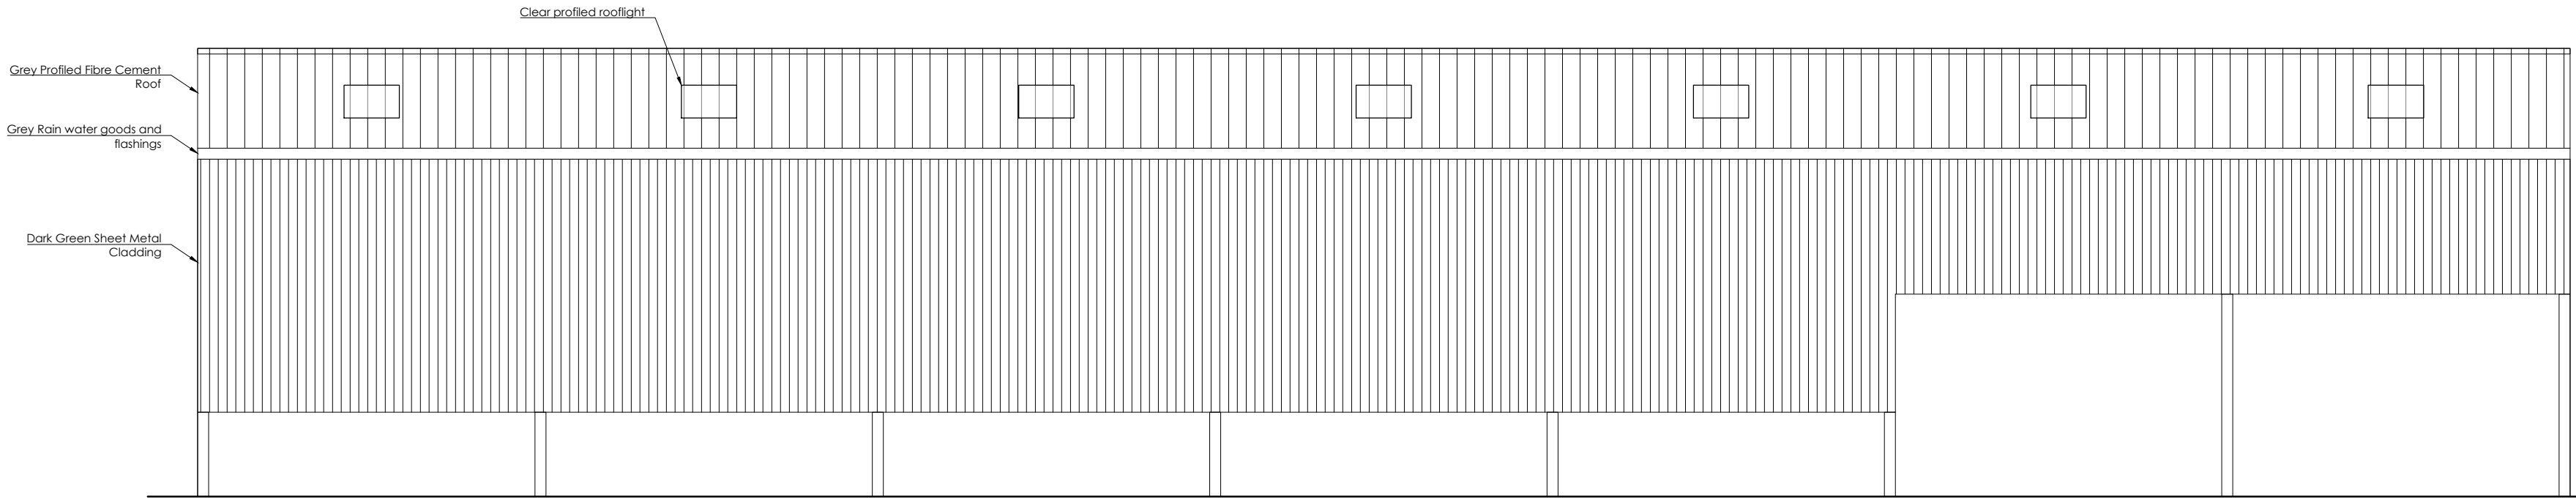


West Elevation

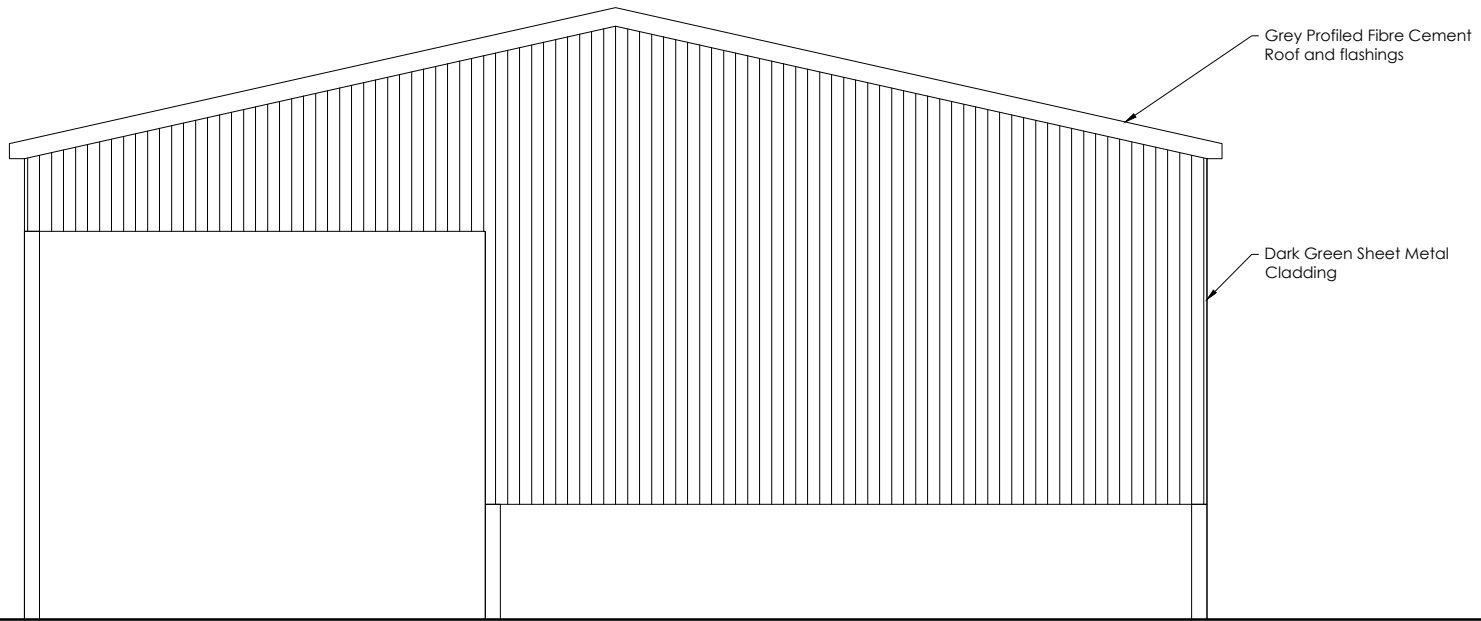

South Elevation

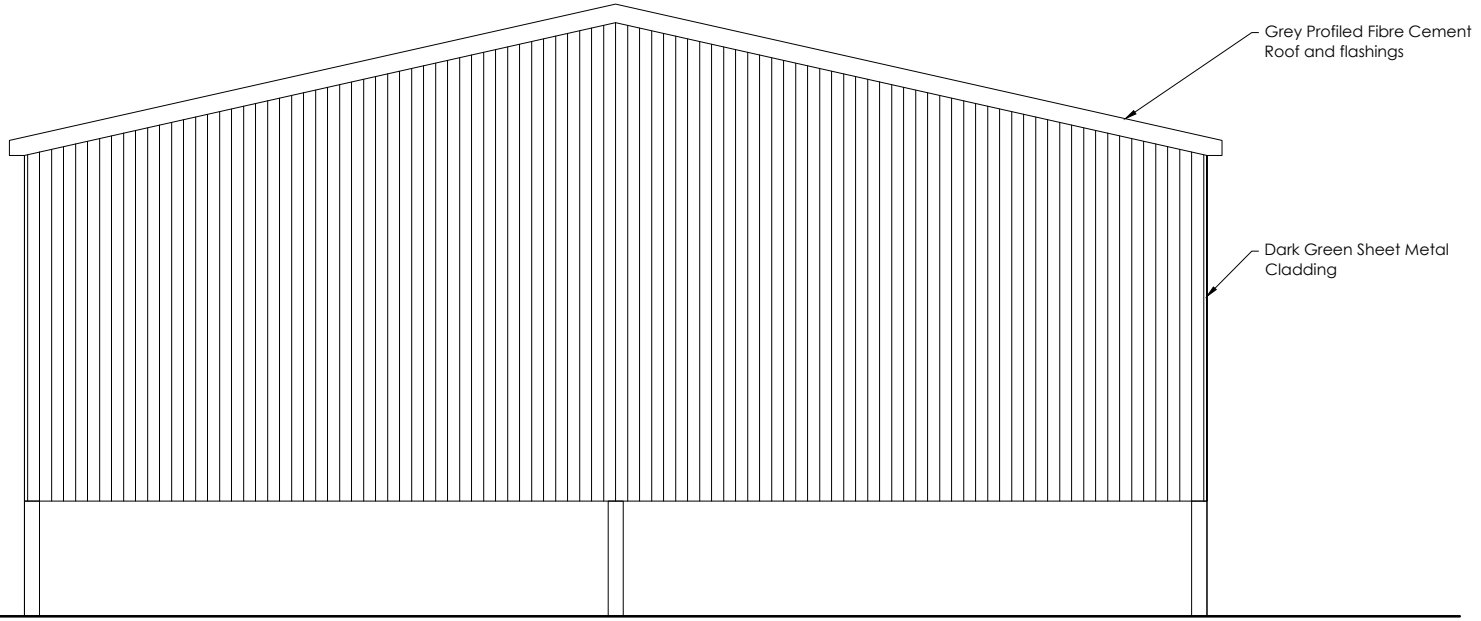

North Elevation

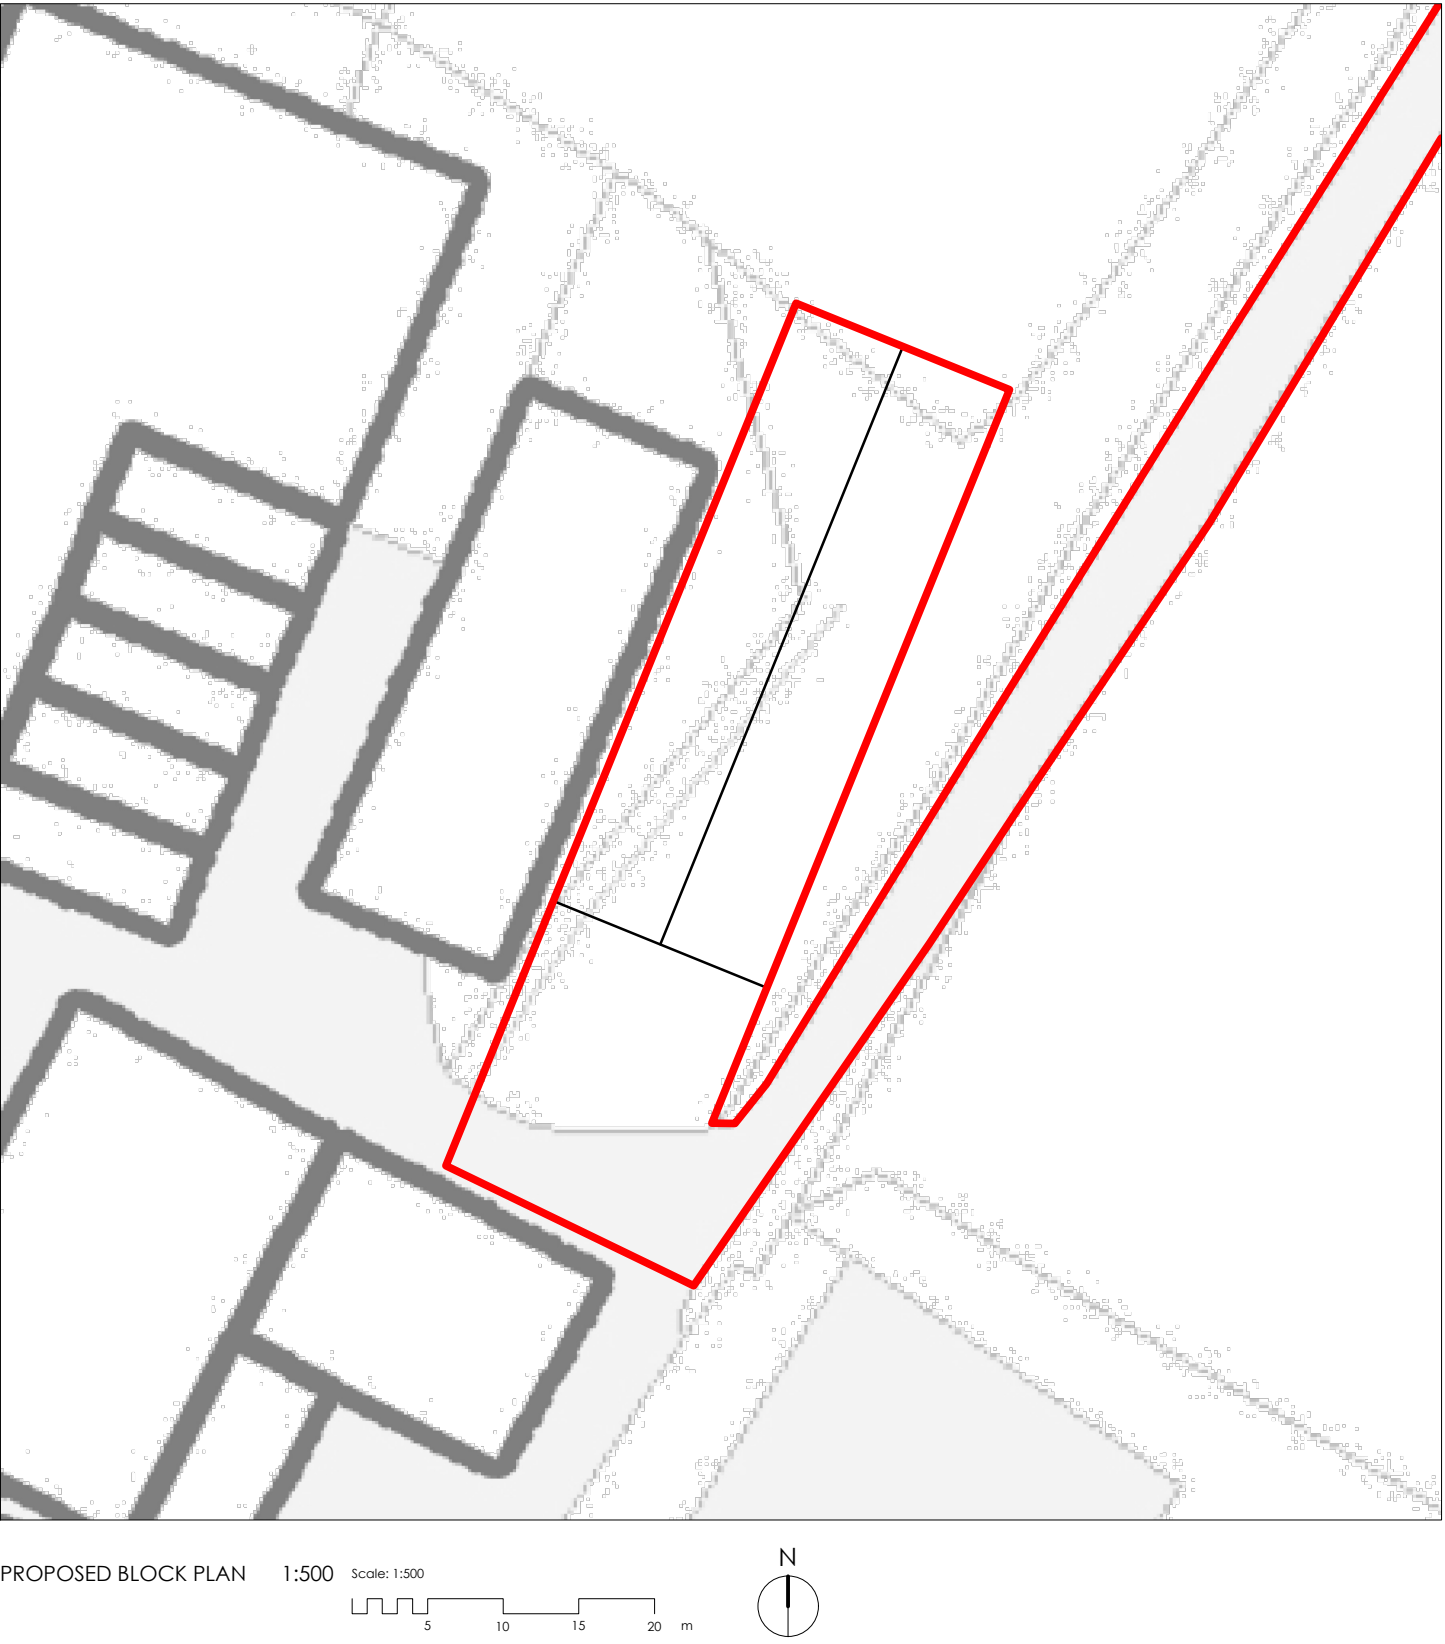

Includes OS Data © Crown copyright and database rights
2025 OS 0100031473
Contractors must work only to figured dimensions which are
to be checked on site.

Rev.	Date	Description	Drawn by
1	31.07.26	Initial Design	CS
2	31.07.26	Revised Design	CS
3	31.07.26	Final Design	CS
4	31.07.26	As Built	CS

Scale: 1:100

1 2 3 4 m

N

Project No: SMITH26

Drawing Status: 31.07.26

Drawn by: CS

Checked by: JB

Project: SMITHWICK FARM

Drawing: PROPOSED PLANS AND ELEVATIONS

Client: MR AND MRS BURROUGH