


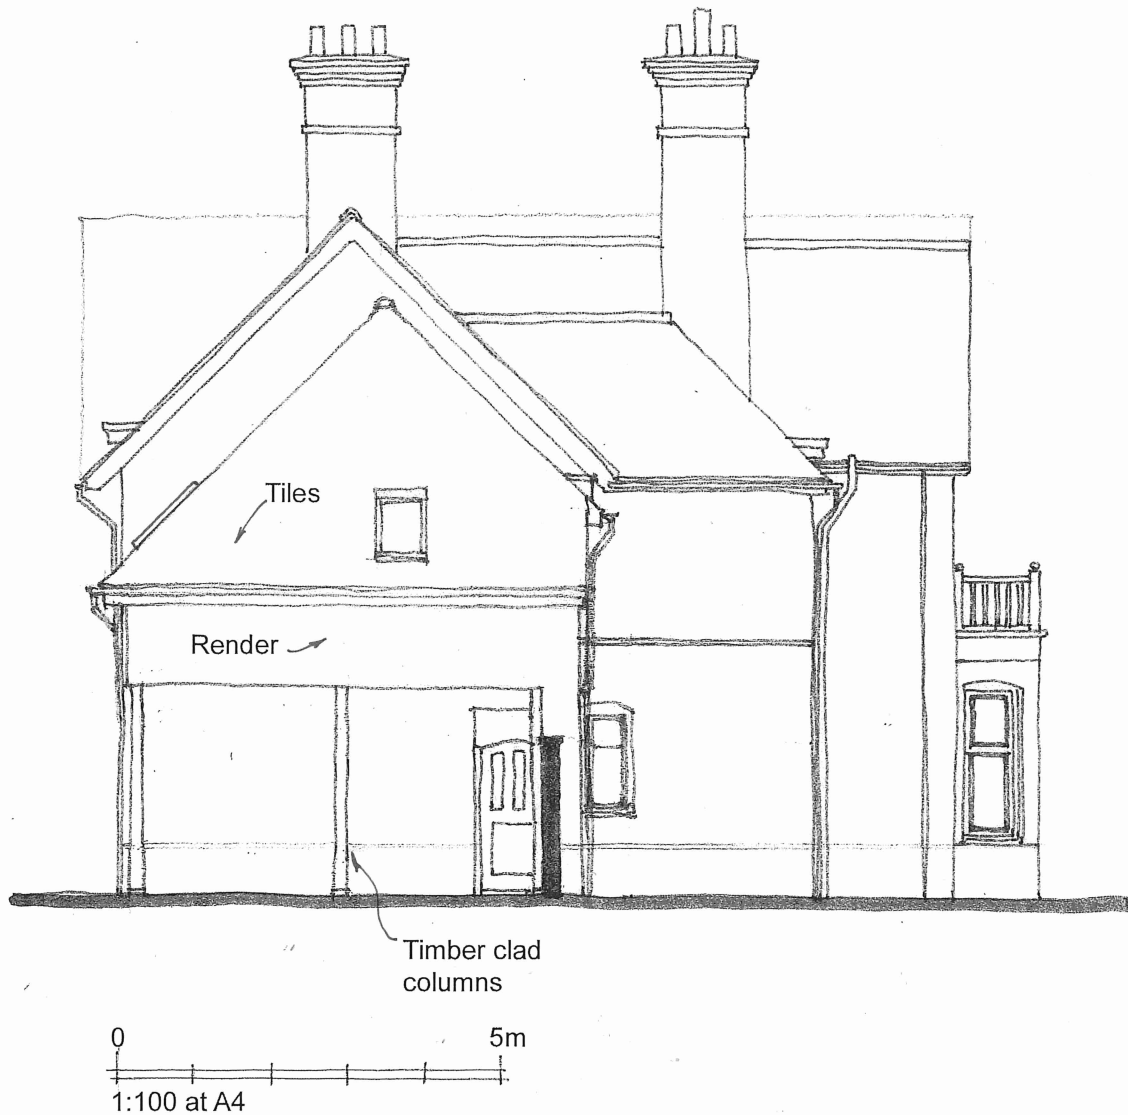

EXTENSION AND ALTERATIONS at THE OLD RECTORY, BEST'S LANE, SUTTON VENY, WILTSHIRE

SIDE ELEVATION AS BUILT/EXTANT

225028/04
Scale as noted at A4