



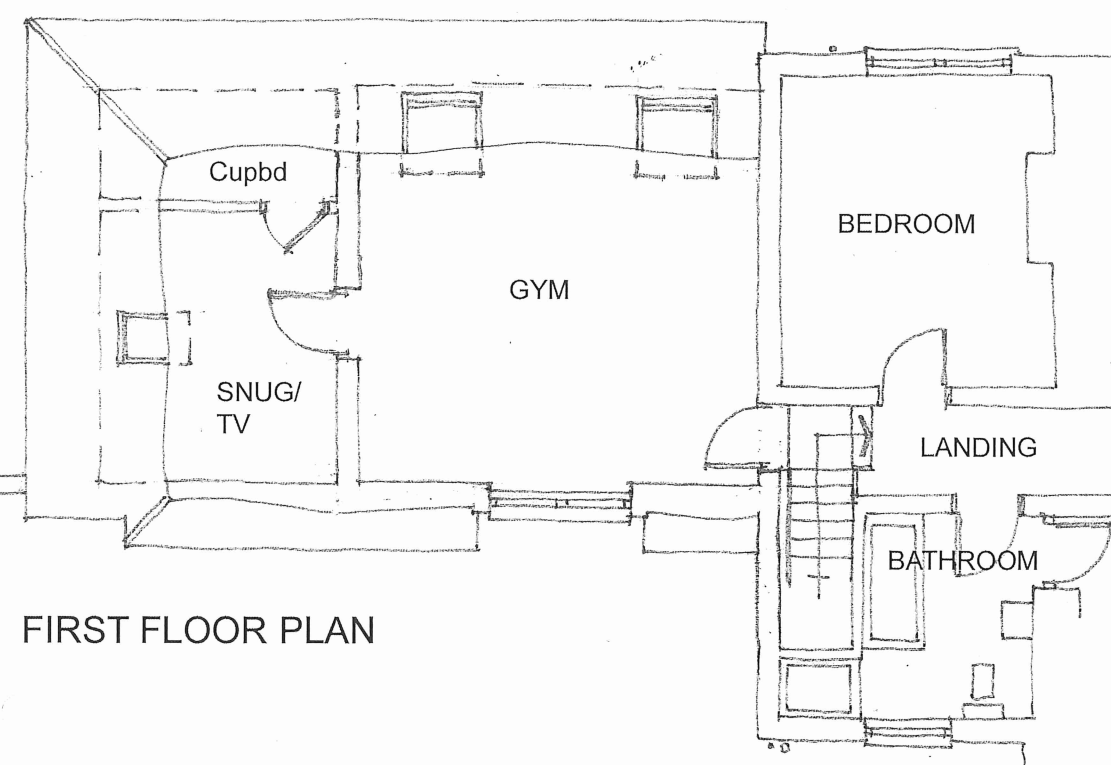

FIRST FLOOR PLAN

0 5m
1:100 at A3

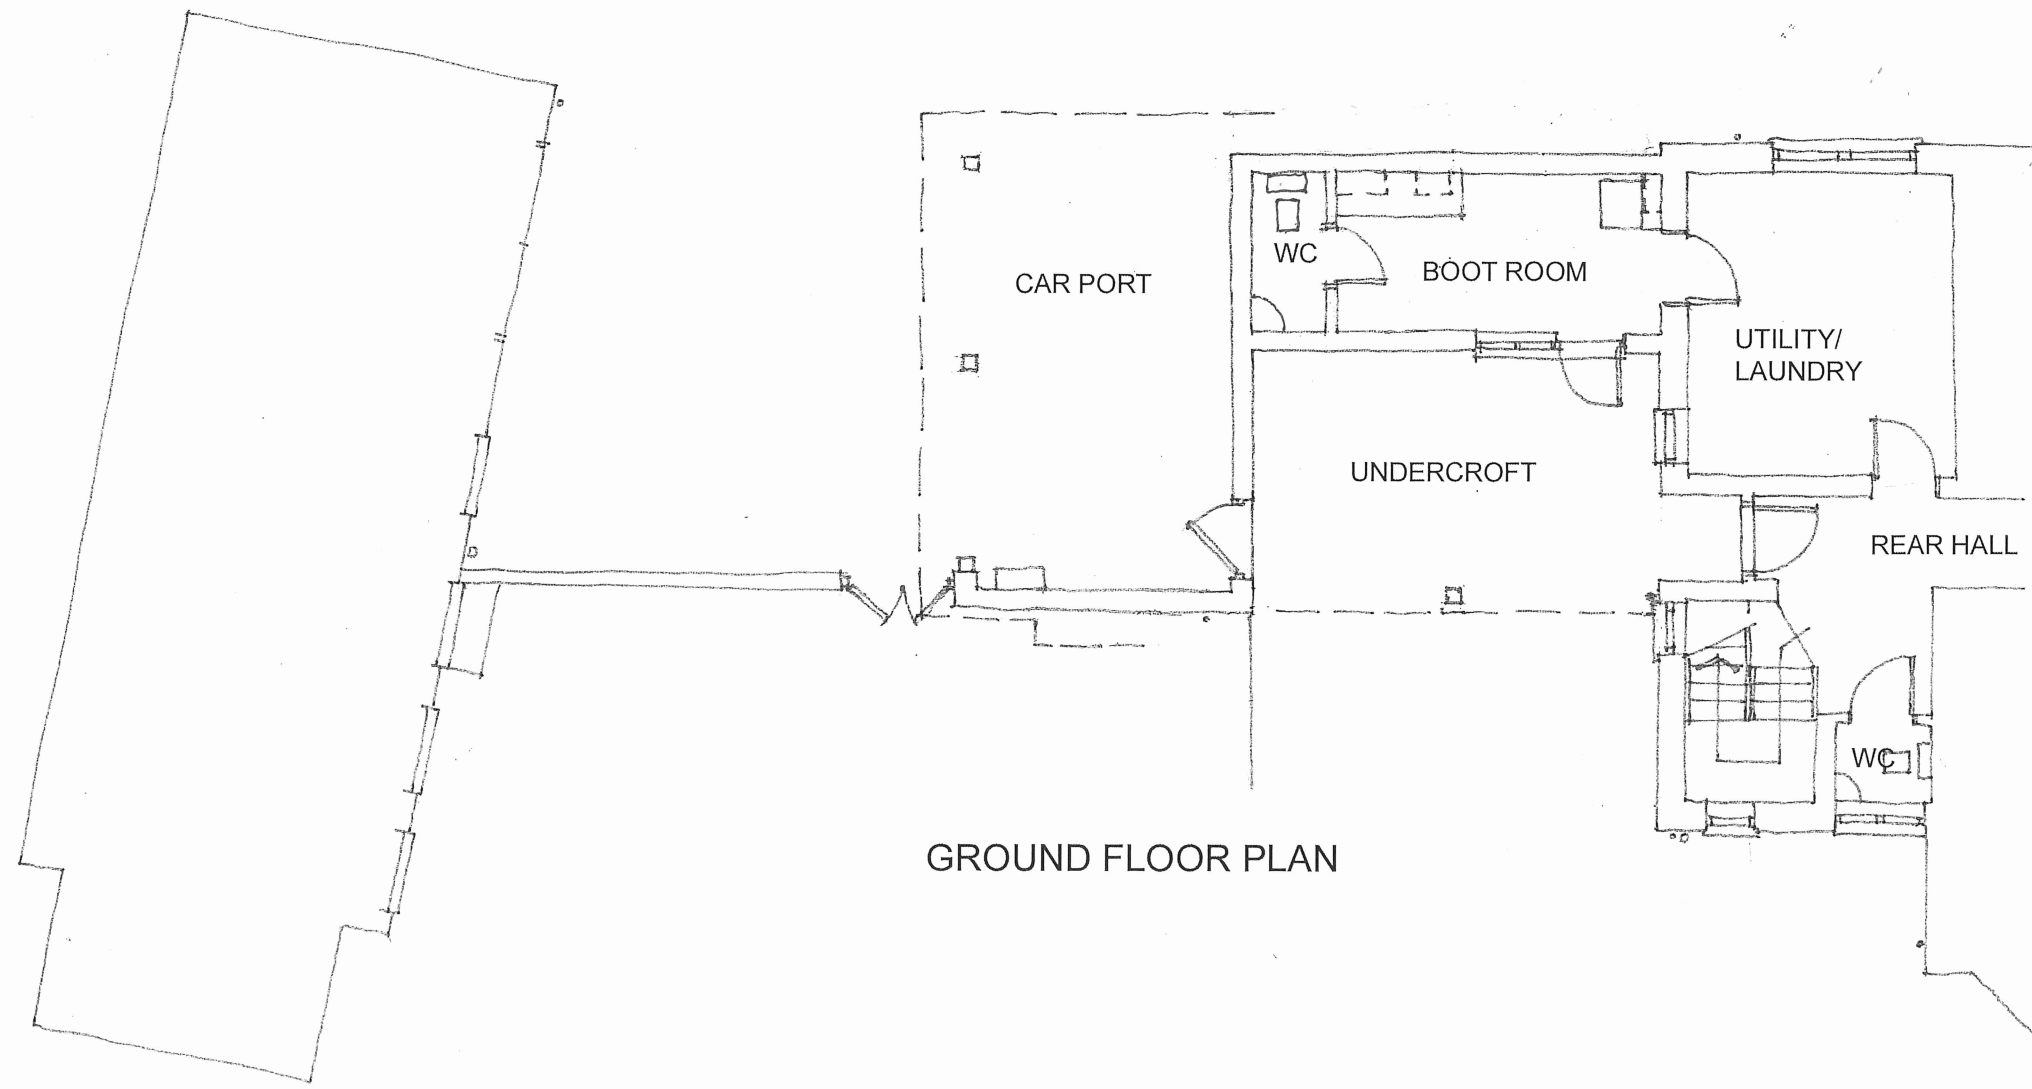

GROUND FLOOR PLAN

This drawing is copyright and shall not be reproduced without the Architect's consent. This drawing may be scaled for planning purposes only. Any discrepancies from this drawing should be notified to the Architect. If in doubt, ask.

EXTENSION AND ALTERATIONS at
THE OLD RECTORY, BEST'S LANE
SUTTON VENY, WILTSHIRE

FLOOR PLANS AS BUILT/EXTANT

225028/02
Scale as noted at A3

www.bta-architects.co.uk

