


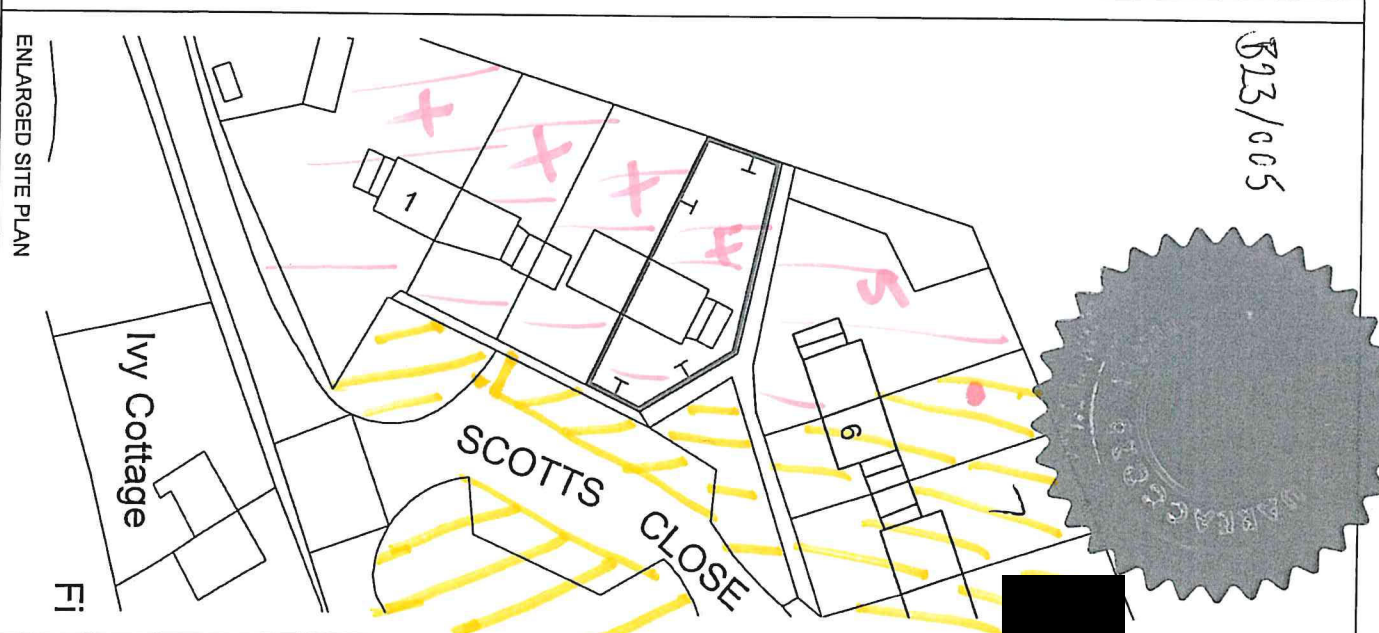

Contractors must check all dimensions on site. Only figured dimensions are to be worked with. Discrepancies must be reported to the Architect before proceeding. THIS DRAWING IS COPYRIGHT. ©		REVISIONS: A 01.09.22 T-marks added. CAB B 02.11.22 Red line amended. CAB	
Ordinance Survey © Crown-copyright 2022 100014368 © Crown copyright material is reproduced with the permission of Land Registry under delegated authority from the Controller of HMSO.			
<i>copy</i>			
LOCATION PLAN scalebar 1:2500 @ A3 0 20 100m			
ENLARGED SITE PLAN scalebar 1:500 @ A3 0 5 10 25m			
			
			
E:\shym\m\green\squareaccord.a3 T: 5200 111 7000			
Project 4 Scotts Close Heddington, Wiltshire		Drawing Title Site Plans	
Date 18.08.22	Status	For Information	
Scale 1:500 / 2500 @ A3	Drawn by CAB	Checked by -	Revision
Project No. 12-054	Drawing No. USL016 / B		