




LAND AT BRUNEL CT, ROWDEN HILL, BATH ROAD, CHIPPENHAM - LOCATION PLAN

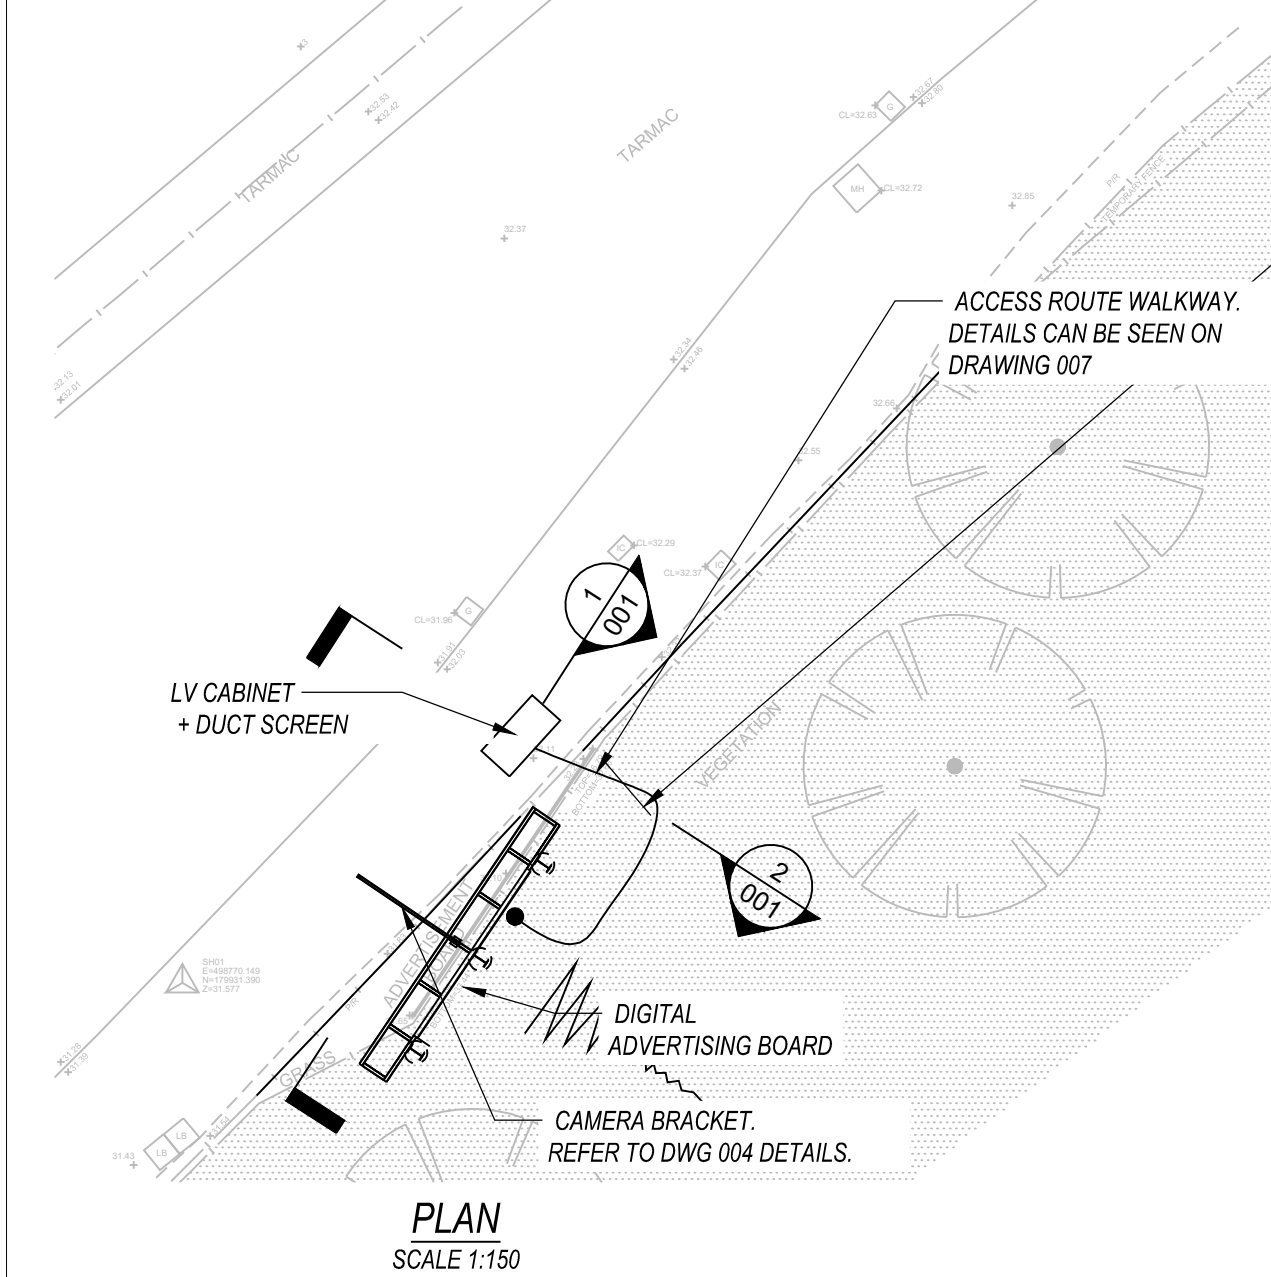


ADVERTISING BOARD STRUCTURE.
SEE DRAWINGS 002 & 003 FOR
DETAILS.


CONCRETE CASING TO BE POURED AFTER
STEEL COLUMN BASE PLATES ARE BOLTED
TOGETHER

150x150x10mm THICK STIFFENER PLATES
WELDED TO POSTS WITH 6mm CFW

2No. 500x650x30mm
THICK BASE PLATES BOLTED
WITH 4No M24 BOLTS

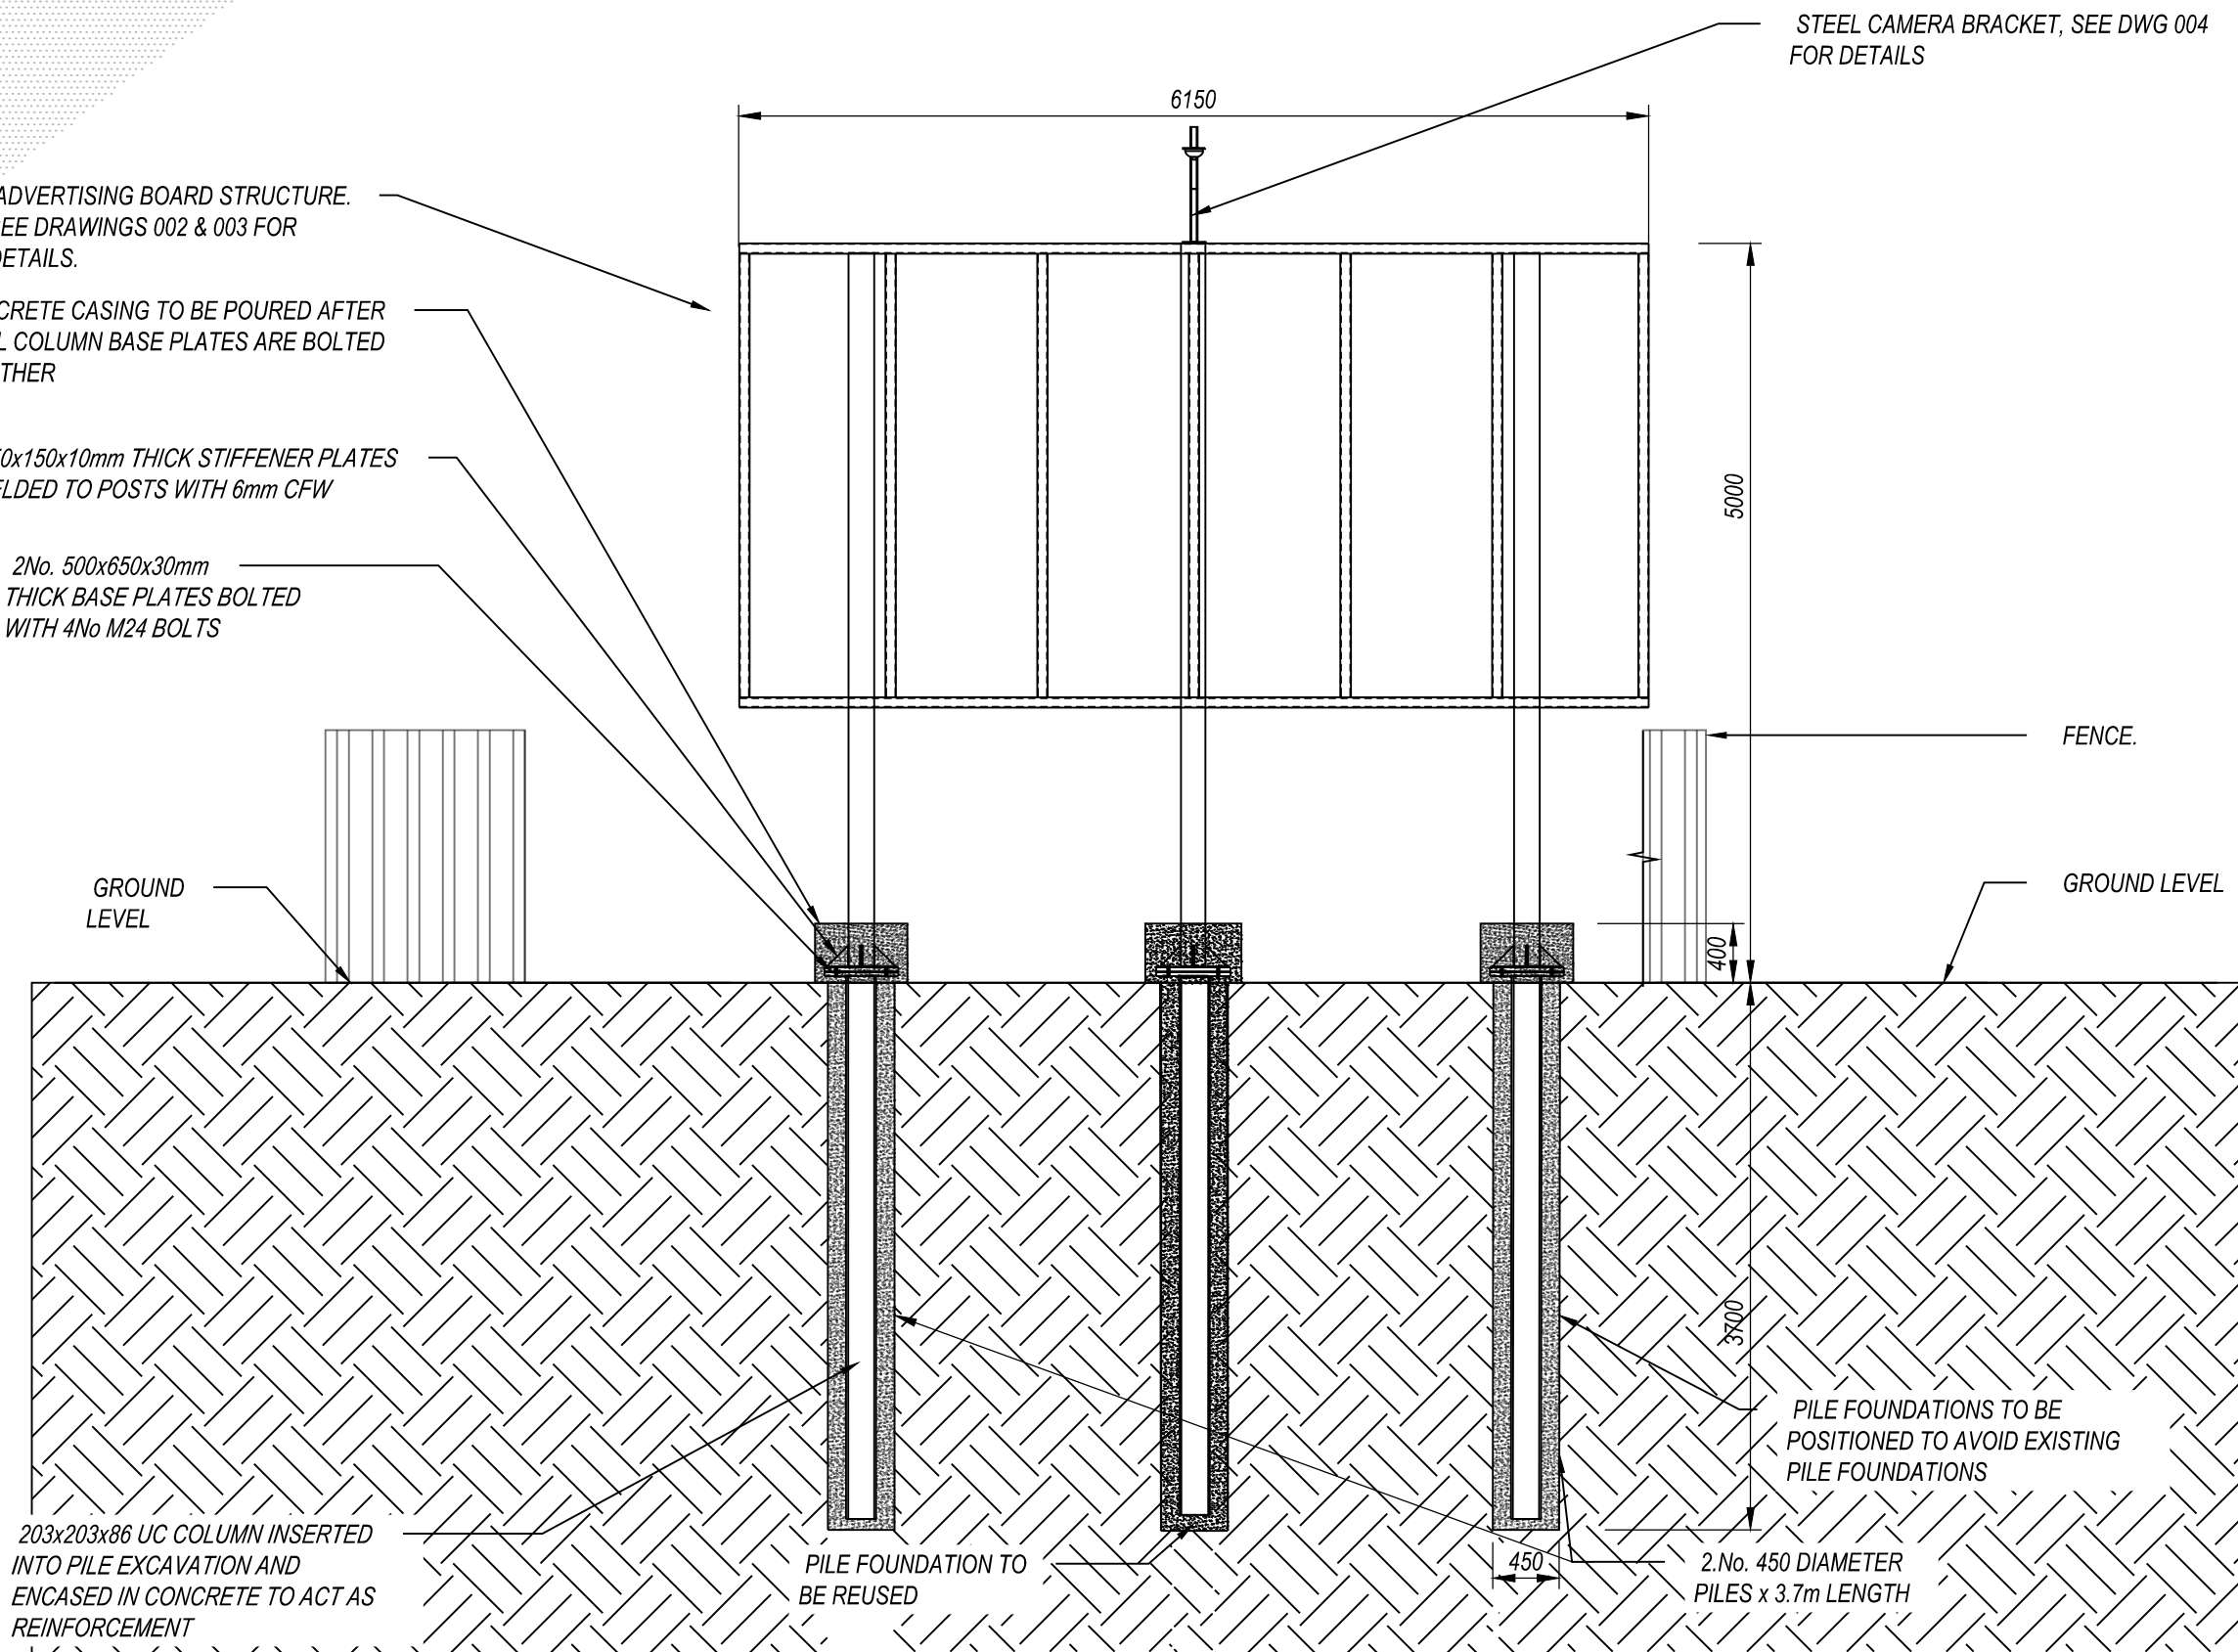

SECTION 1-1
SCALE 1:50

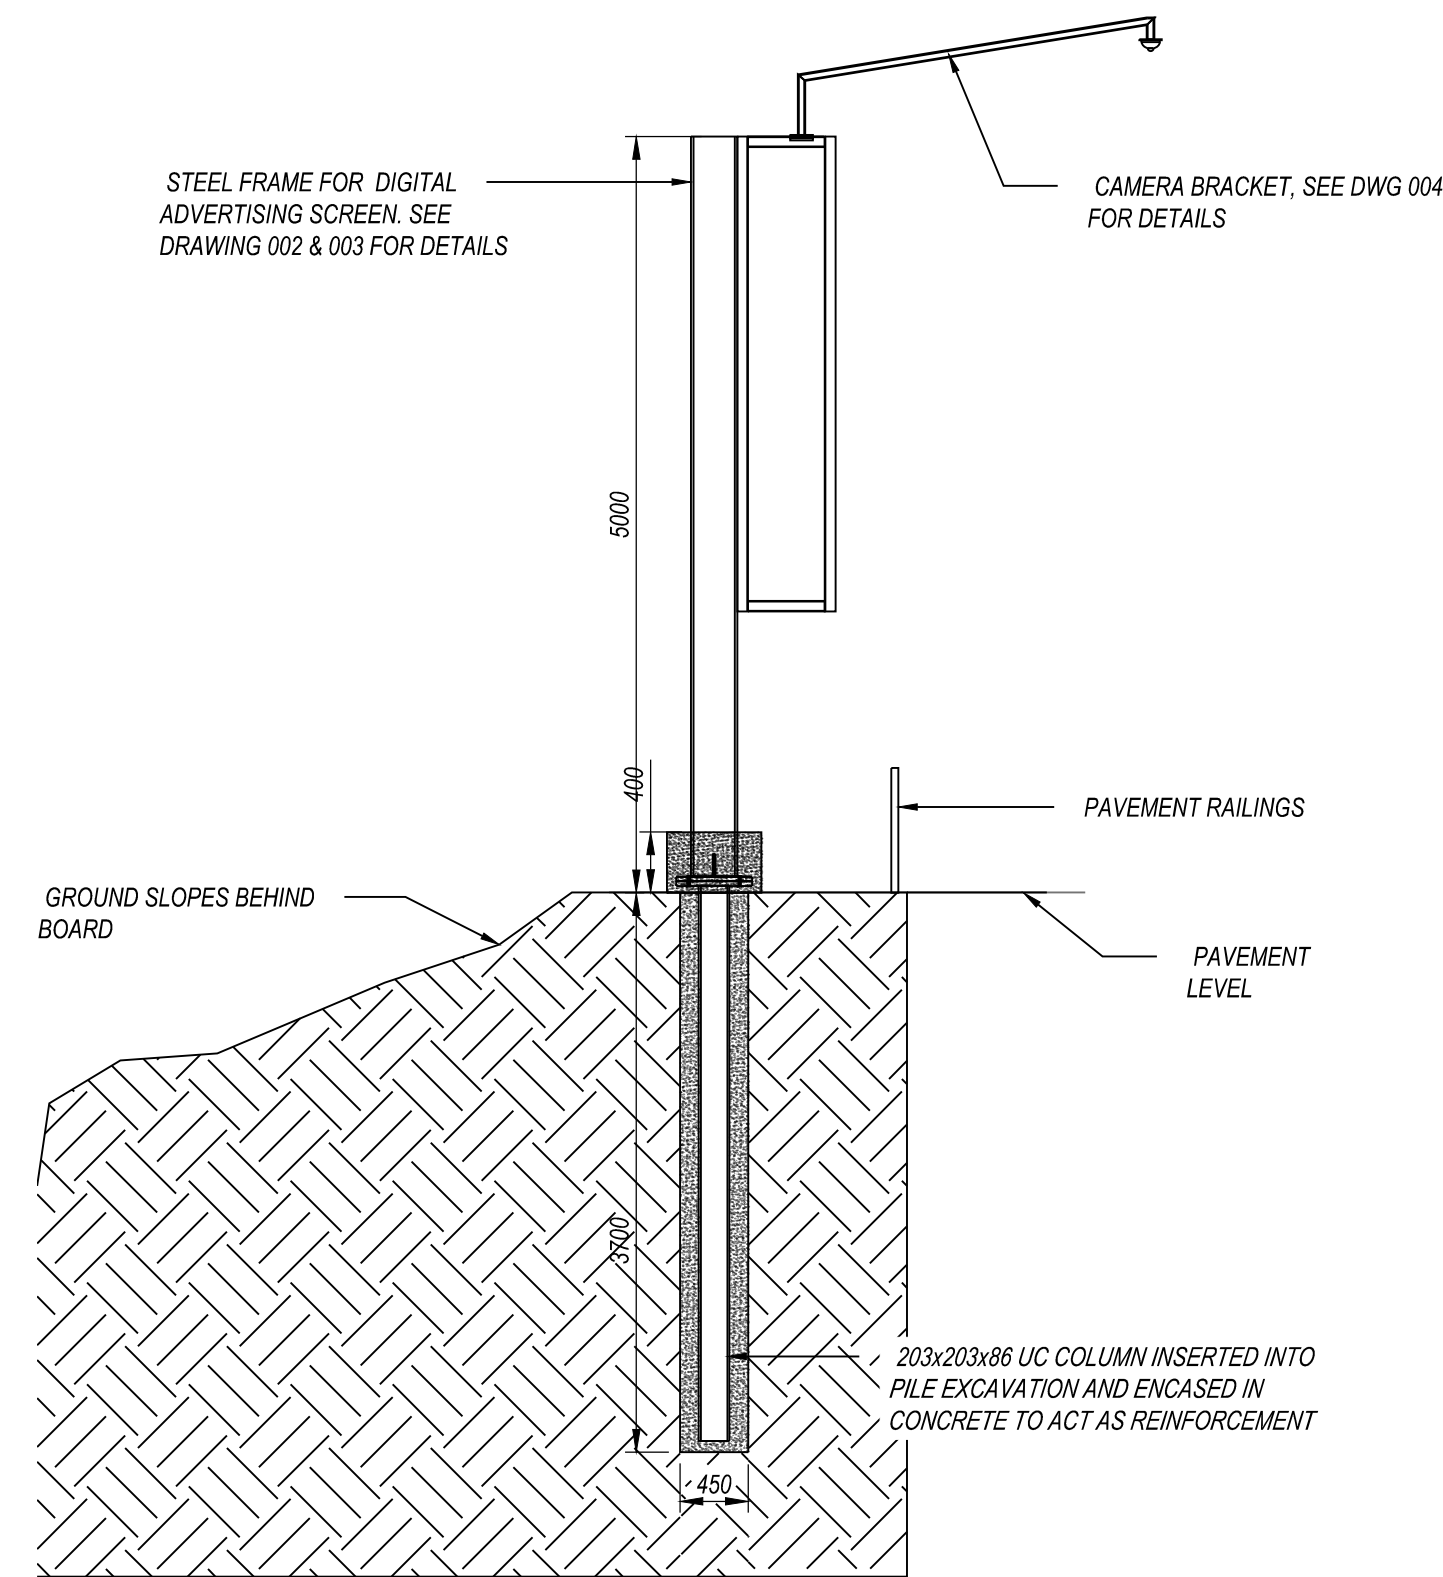

SECTION 2-2
SCALE 1:50

NOTES

COLOUR CODE:	
BLACK -	EXISTING OR UNCHANGED
BLUE -	MODIFIED OR TO BE MOVED
RED -	NEW, PROPOSED OR ADDITIONAL
GREEN -	REDUNDANT OR TO BE REMOVED
ORANGE -	THIRD PARTY / BY OTHERS
GREY -	OS/SURVEY DATA

Z01	08/10/25	MJ	AS BUILT
C01	27/09/24	YN	APPROVED FOR CONSTRUCTION
P02	09/08/2024	AJ	UPDATED TO WALK-IN BOX FRAME
P01	22/11/2023	DJ	FIRST ISSUE
REV	DATE	BY	DESCRIPTION



CLIENT	DYER & BUTLER
--------	---------------

PROJECT TITLE	WALES & WESTERN DIGITAL ADVERTISING BOARDS
---------------	---

DRAWING TITLE	YZ130401199901
---------------	----------------

GENERAL ARRANGEMENT AND SECTION

DRAWING STATUS		AS BUILT
DRAWING No.	3714-VED-XX-XX-DWG-ST-005001	REV Z01
DATE	SEPT 2024	SCALE @ A1 AS SHOWN
DRAWN	AJ	CHECKED YN
VEDA JOB No.		3714