




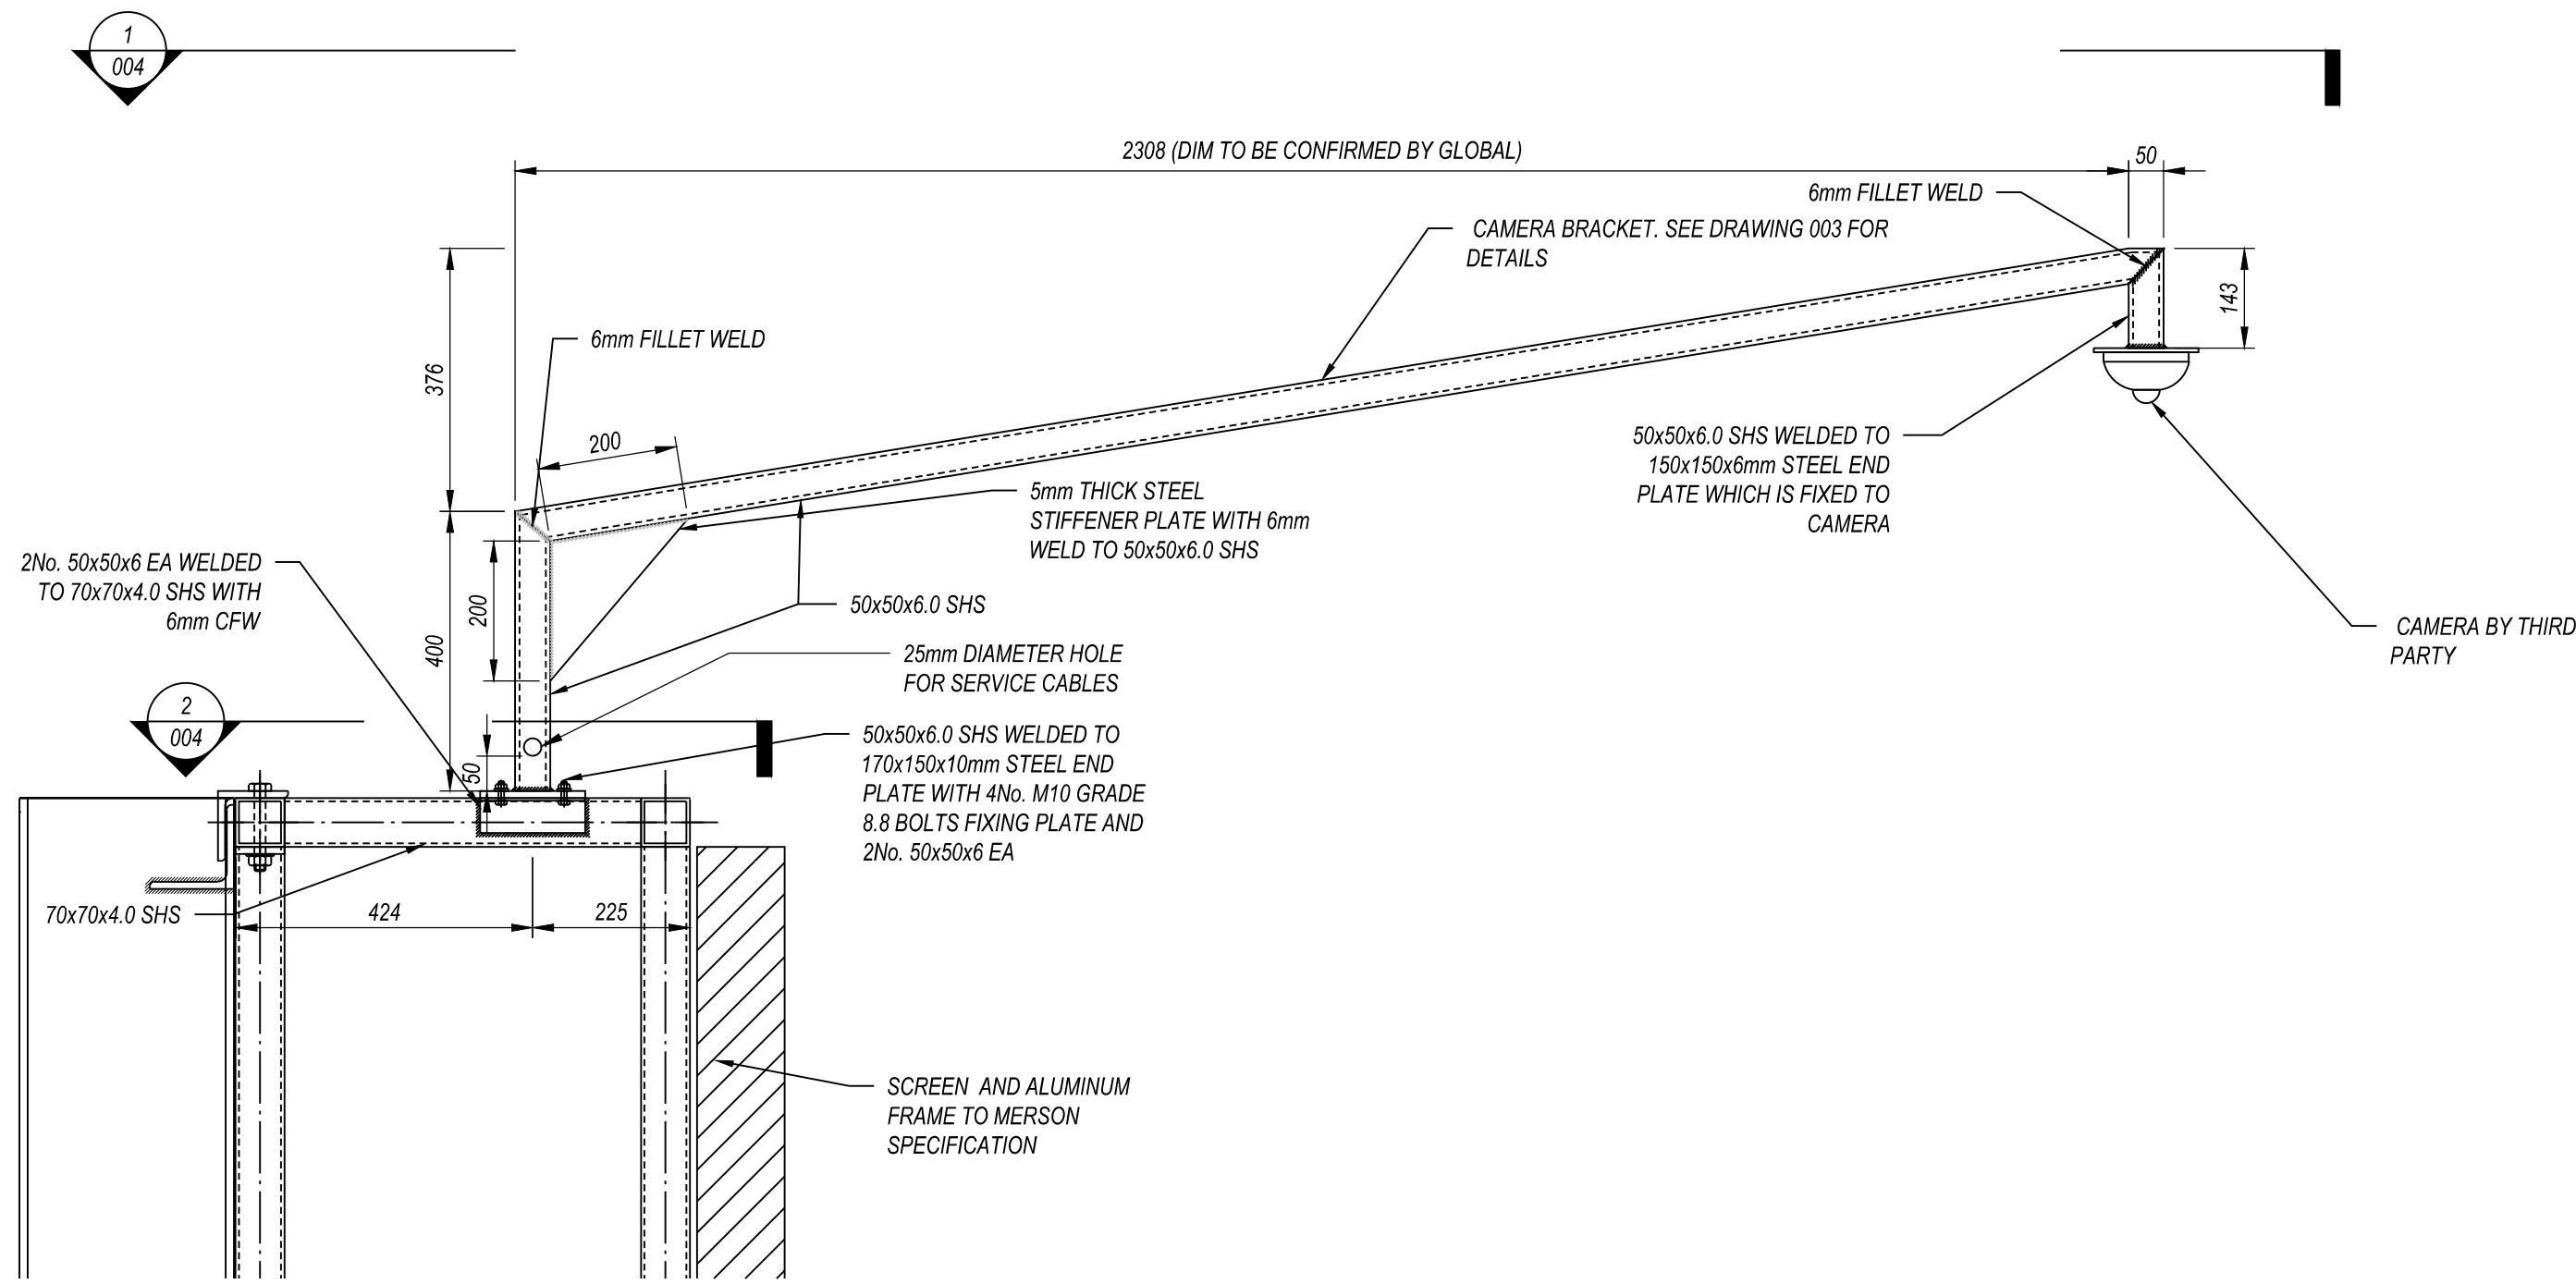


DETAIL 1
SCALE 1:10

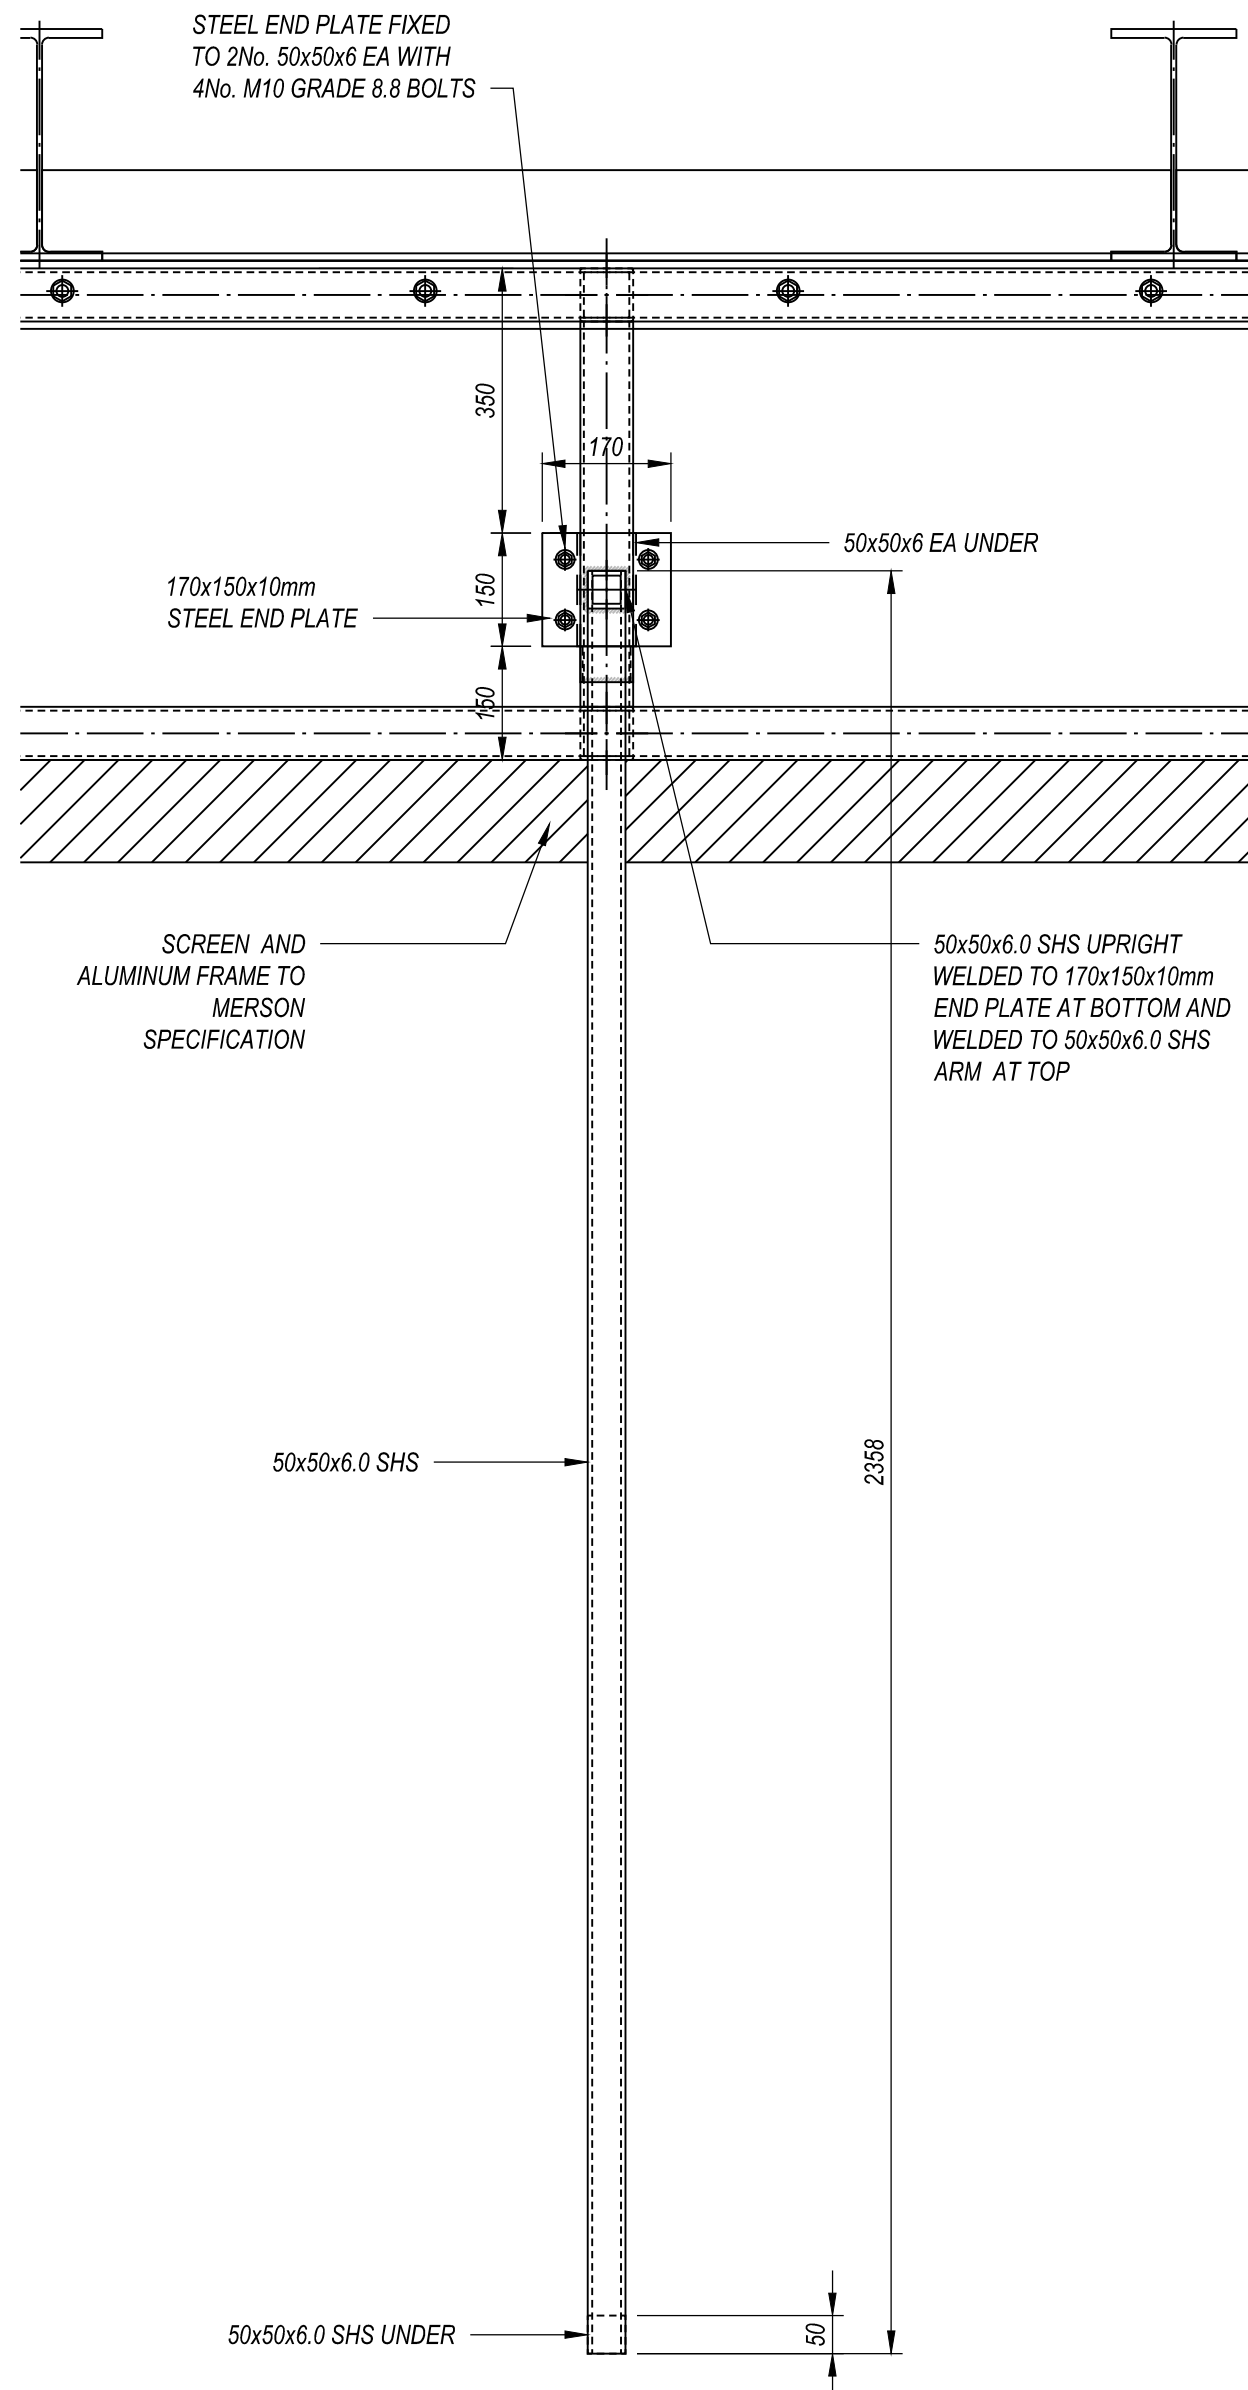

SECTION 1-1 / DETAIL 2
SCALE 1:10

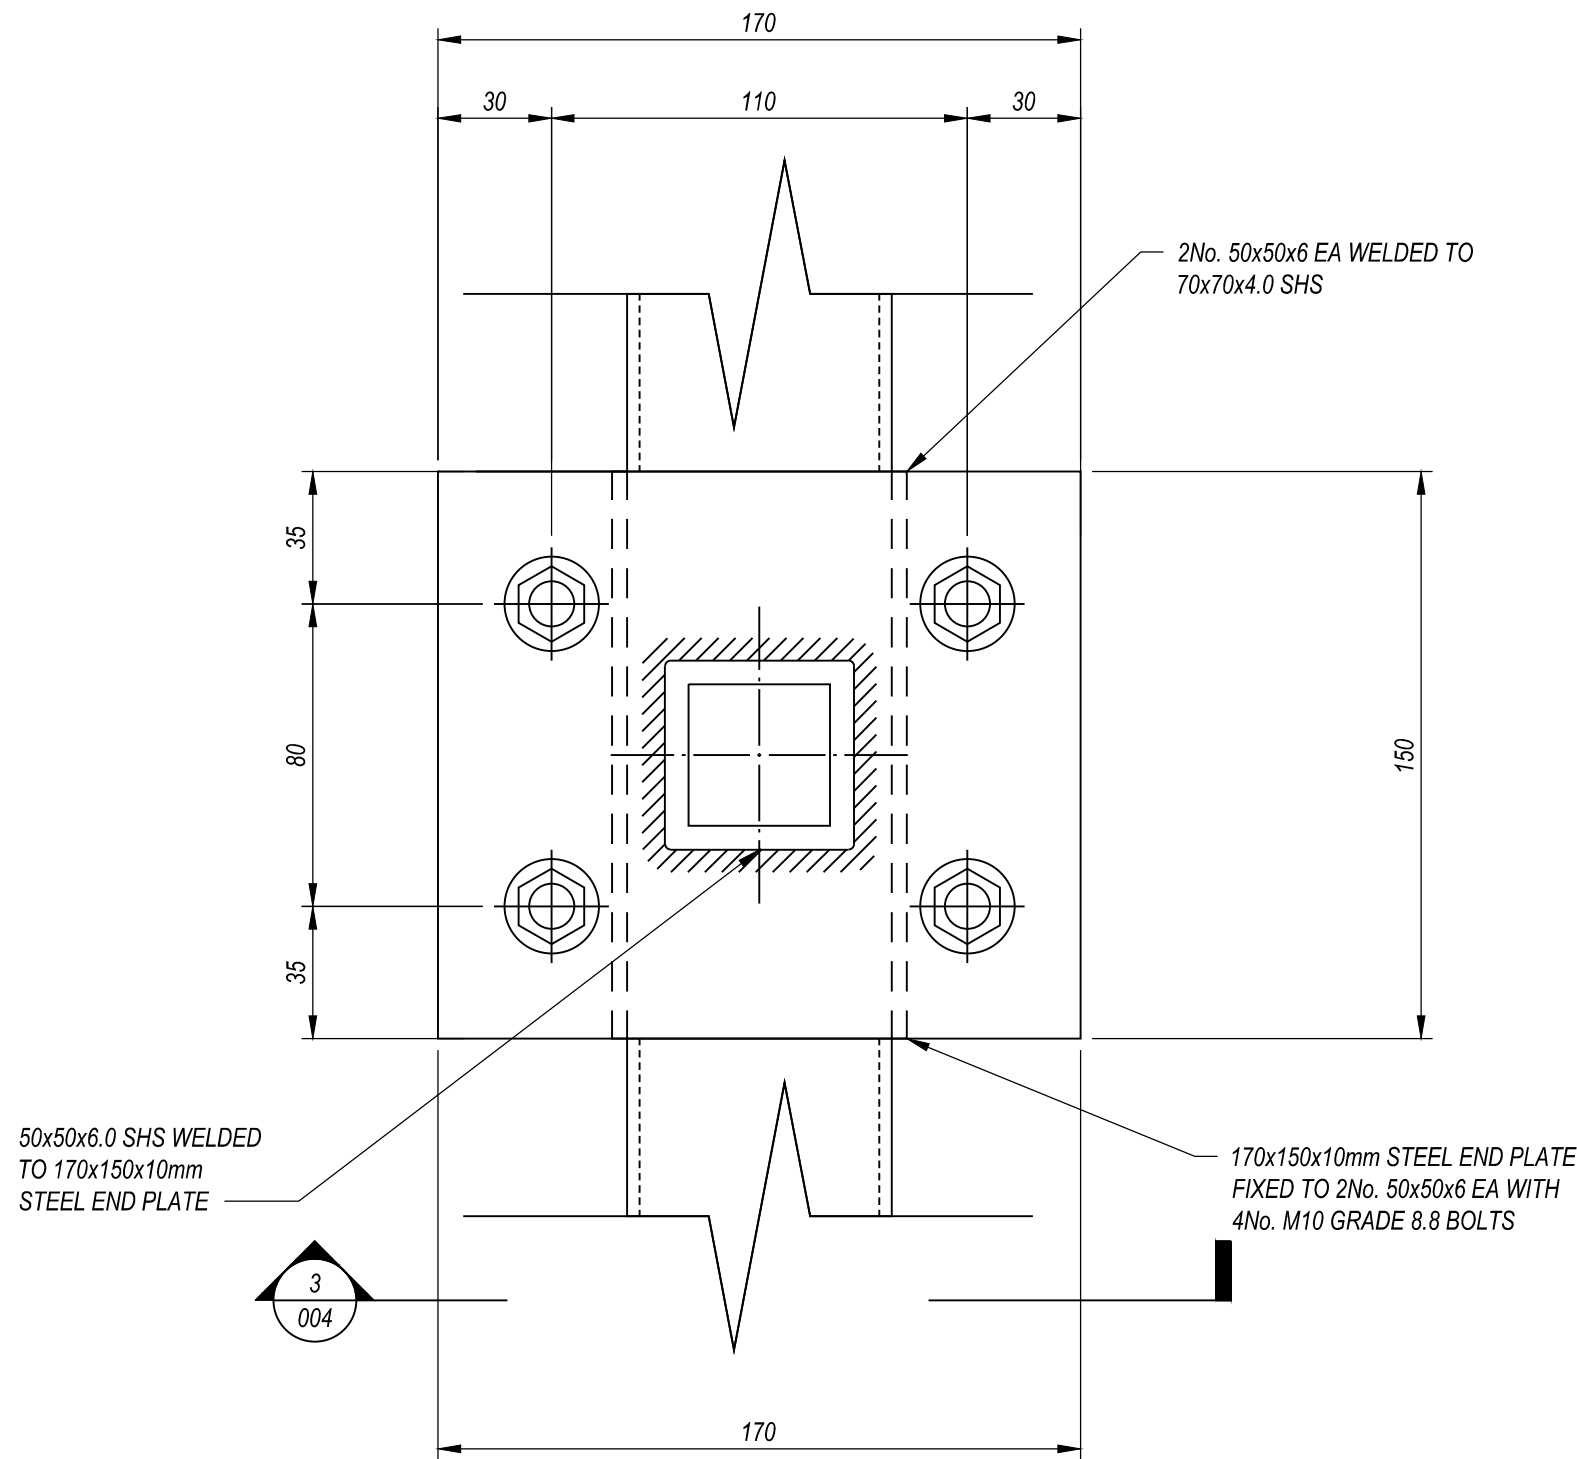

SECTION 2-2
SCALE 1:2

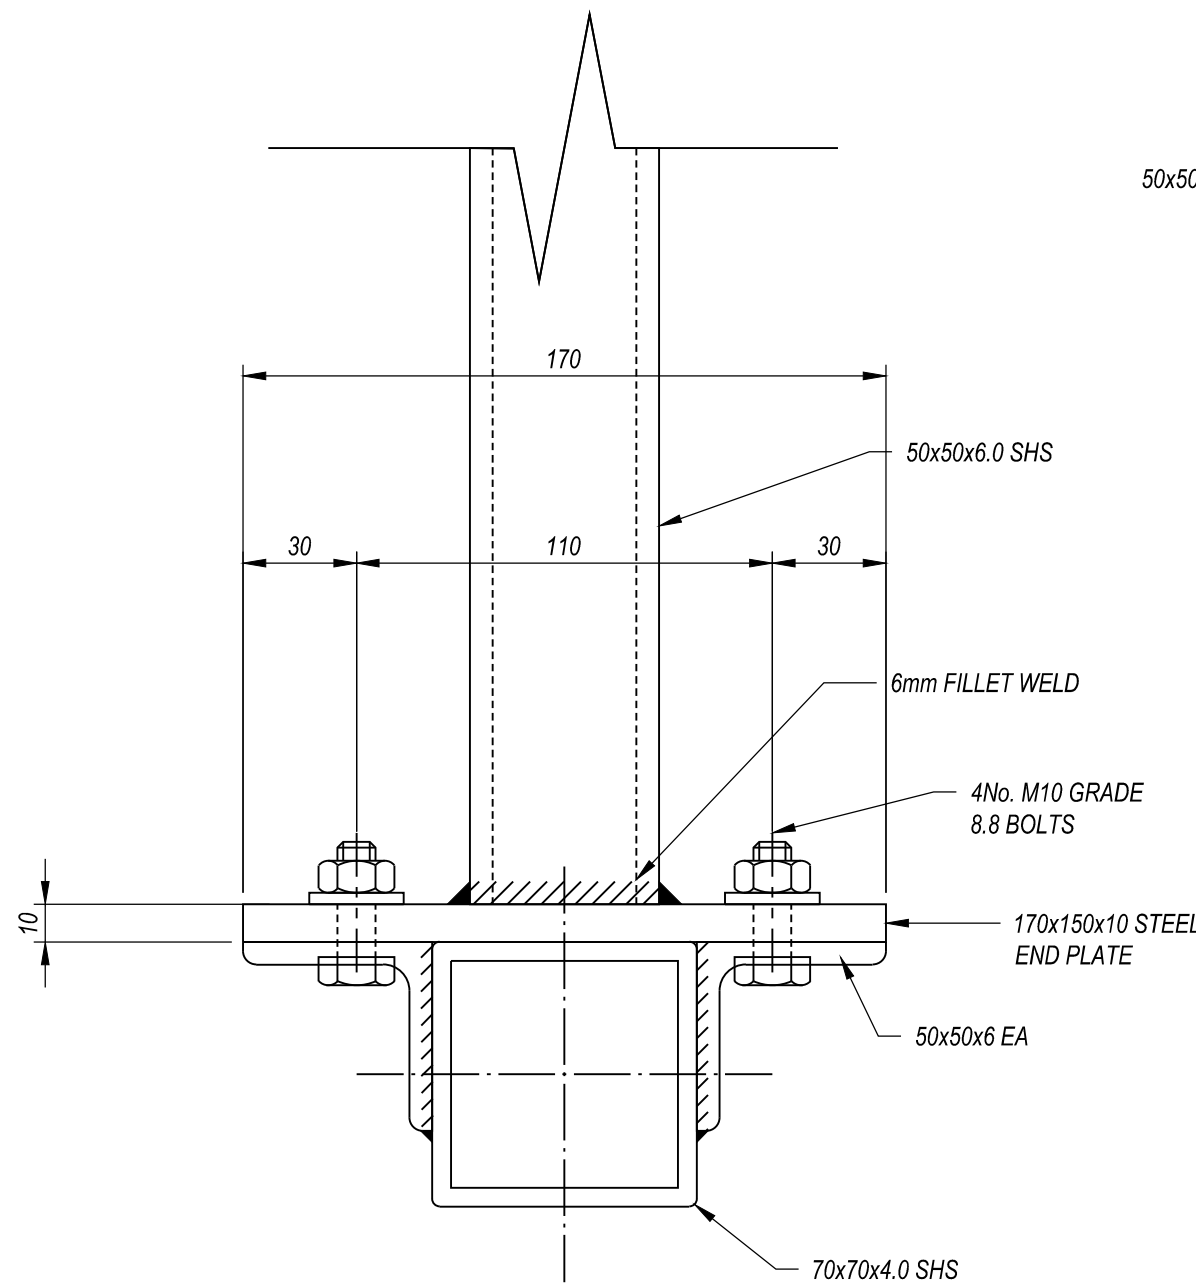

SECTION 3-3
SCALE 1:2

COLOUR CODE:	
BLACK -	EXISTING OR UNCHANGED
BLUE -	MODIFIED OR TO BE MOVED
RED -	NEW, PROPOSED OR ADDITIONAL
GREEN -	REDUNDANT OR TO BE REMOVED
ORANGE -	THIRD PARTY / BY OTHERS
GREY -	OS/SURVEY DATA

Z01	08/10/25	MJ	AS BUILT
C01	27/09/24	YN	APPROVED FOR CONSTRUCTION
P01	09/08/2024	WF	FIRST ISSUE
REV	DATE	BY	DESCRIPTION

London Office
Highland House,
165 The Broadway,
Wimbledon,
London,
SW19 1NE
T: +44 (0)20 5214 5217
E: info@veda.co.uk
www.veda.co.uk

CLIENT

PROJECT TITLE
WALES & WESTERN DIGITAL ADVERTISING BOARDS

DRAWING TITLE
YZ130401199901
CAMERA BRACKET STEELWORK SECTIONS AND DETAILS

DRAWING STATUS	
AS BUILT	
DRAWING No.	3714-VED-XX-XX-DWG-ST-005004
REV	Z01
DATE	SEPT 2024
SCALE @ A1	AS SHOWN
DRAWN	WF
CHECKED	YN
VEDA JOB No.	3714