




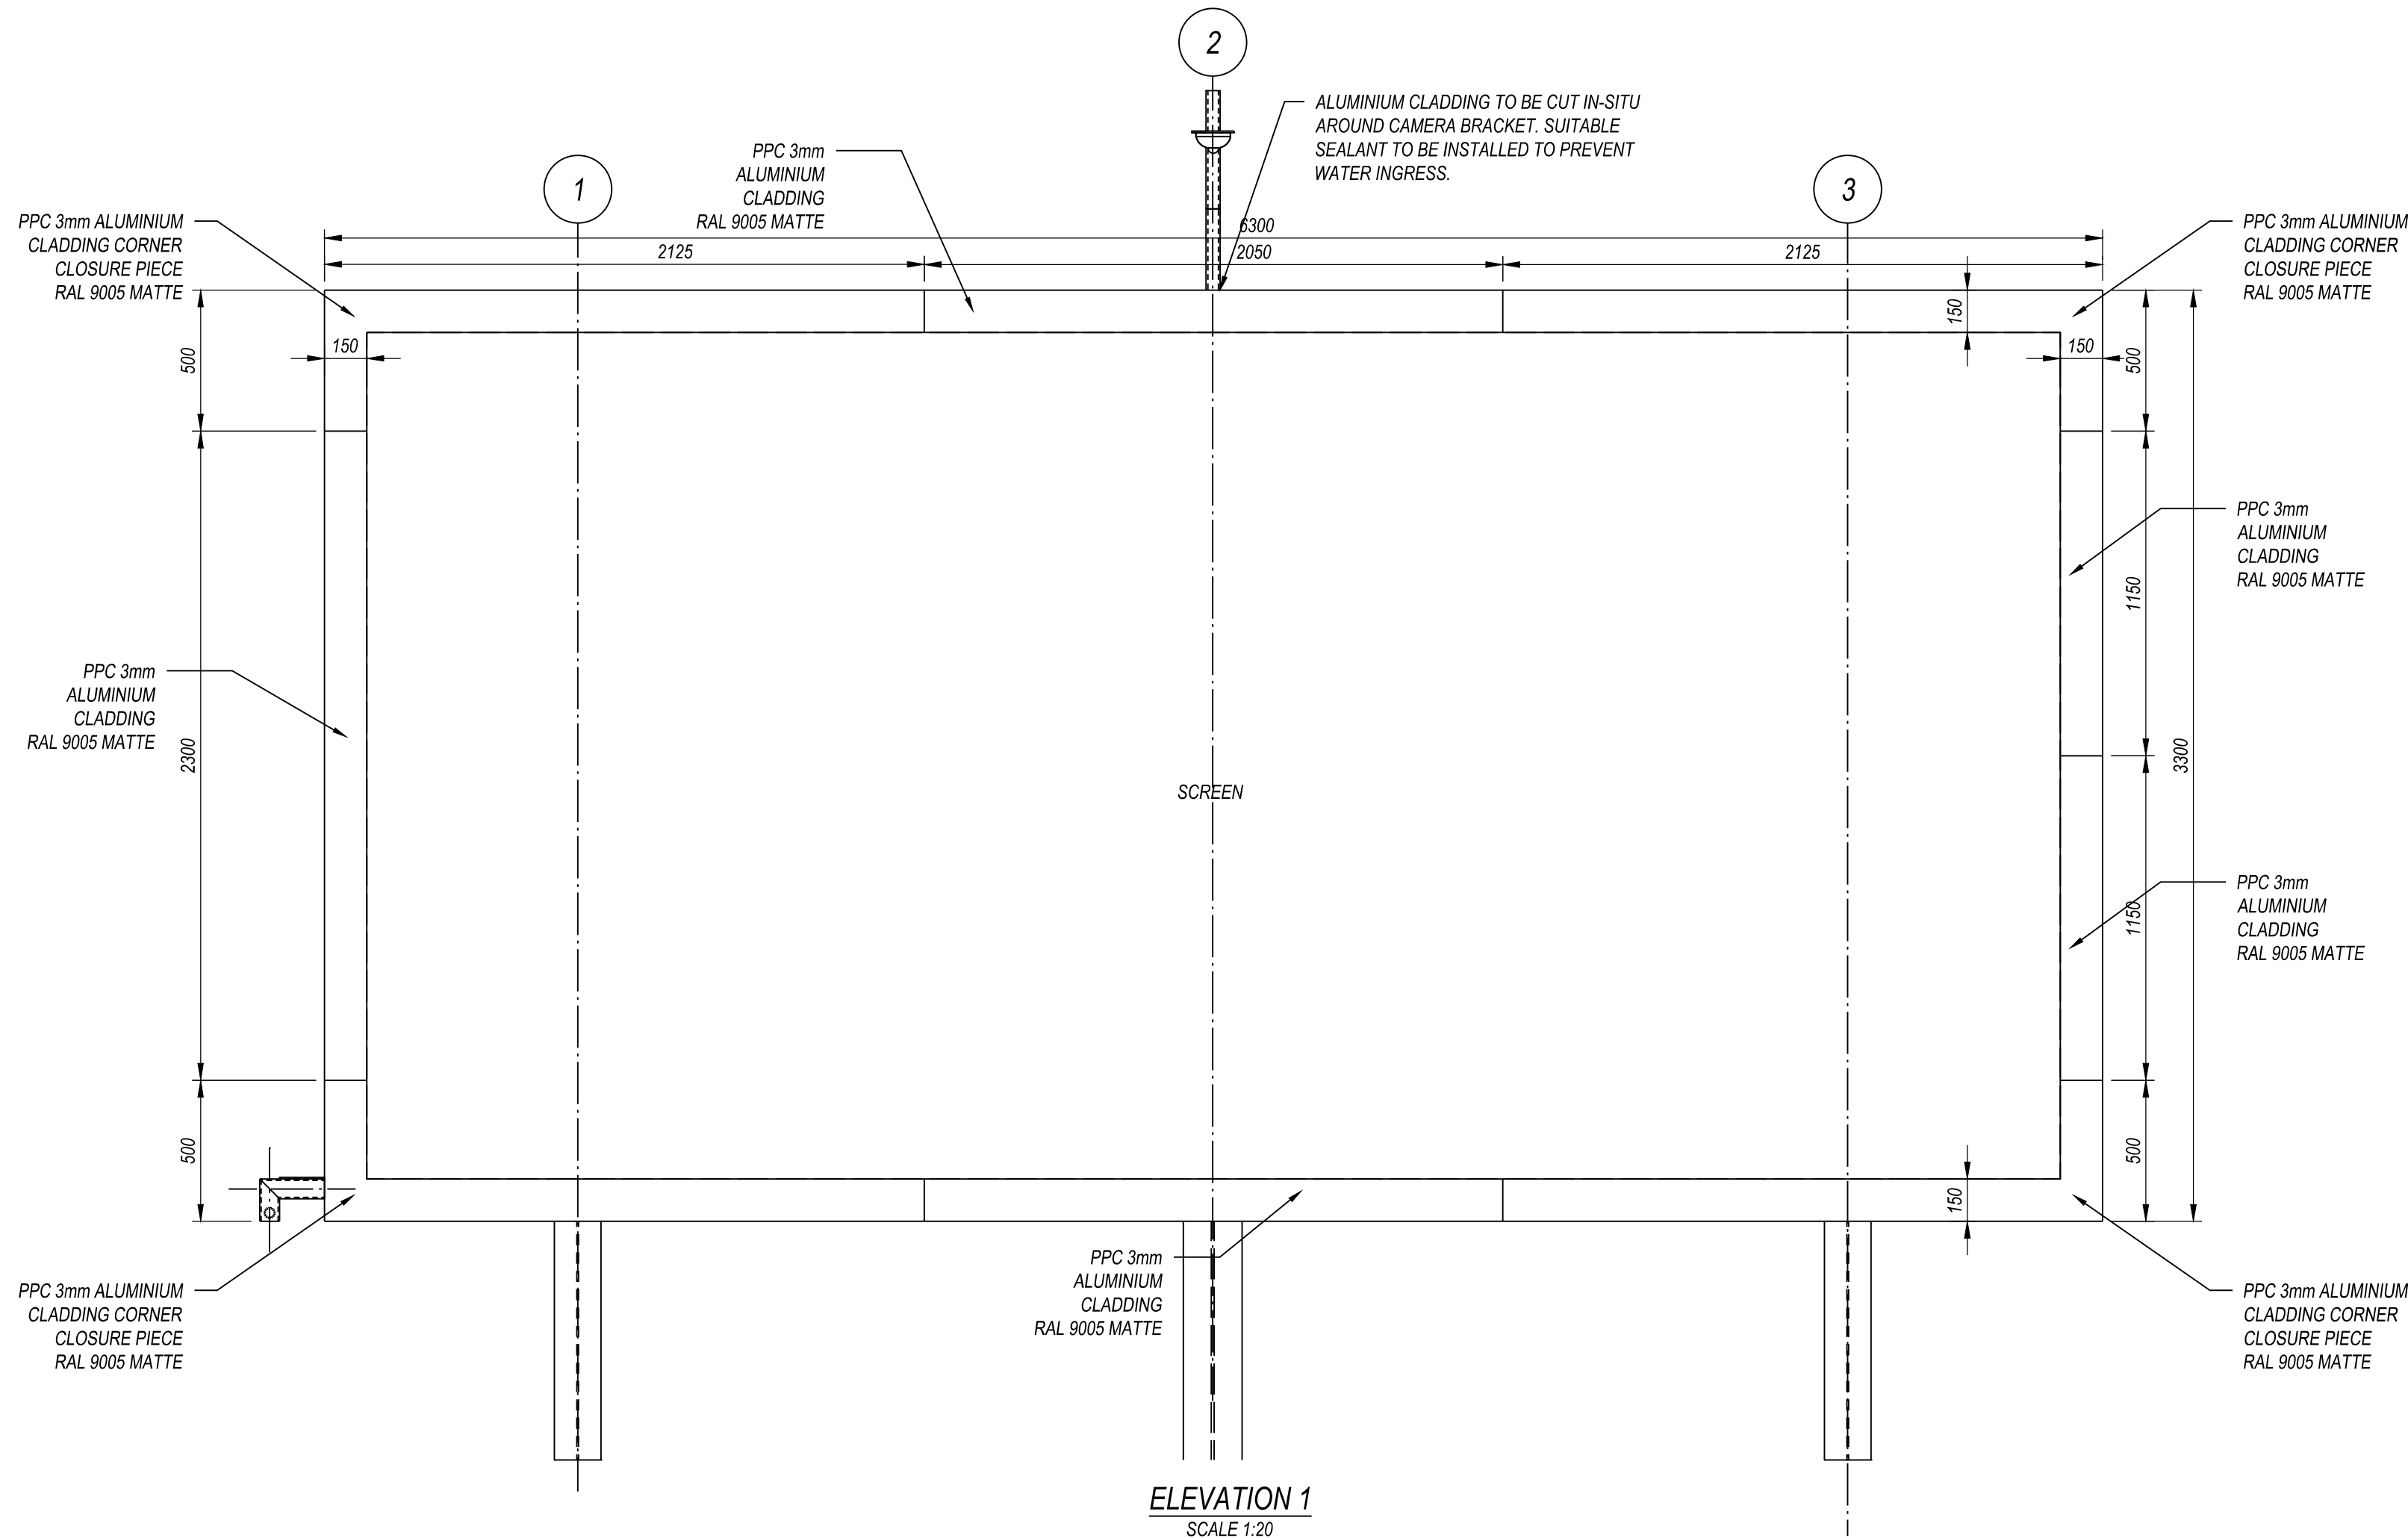


ELEVATION 1
SCALE 1:20

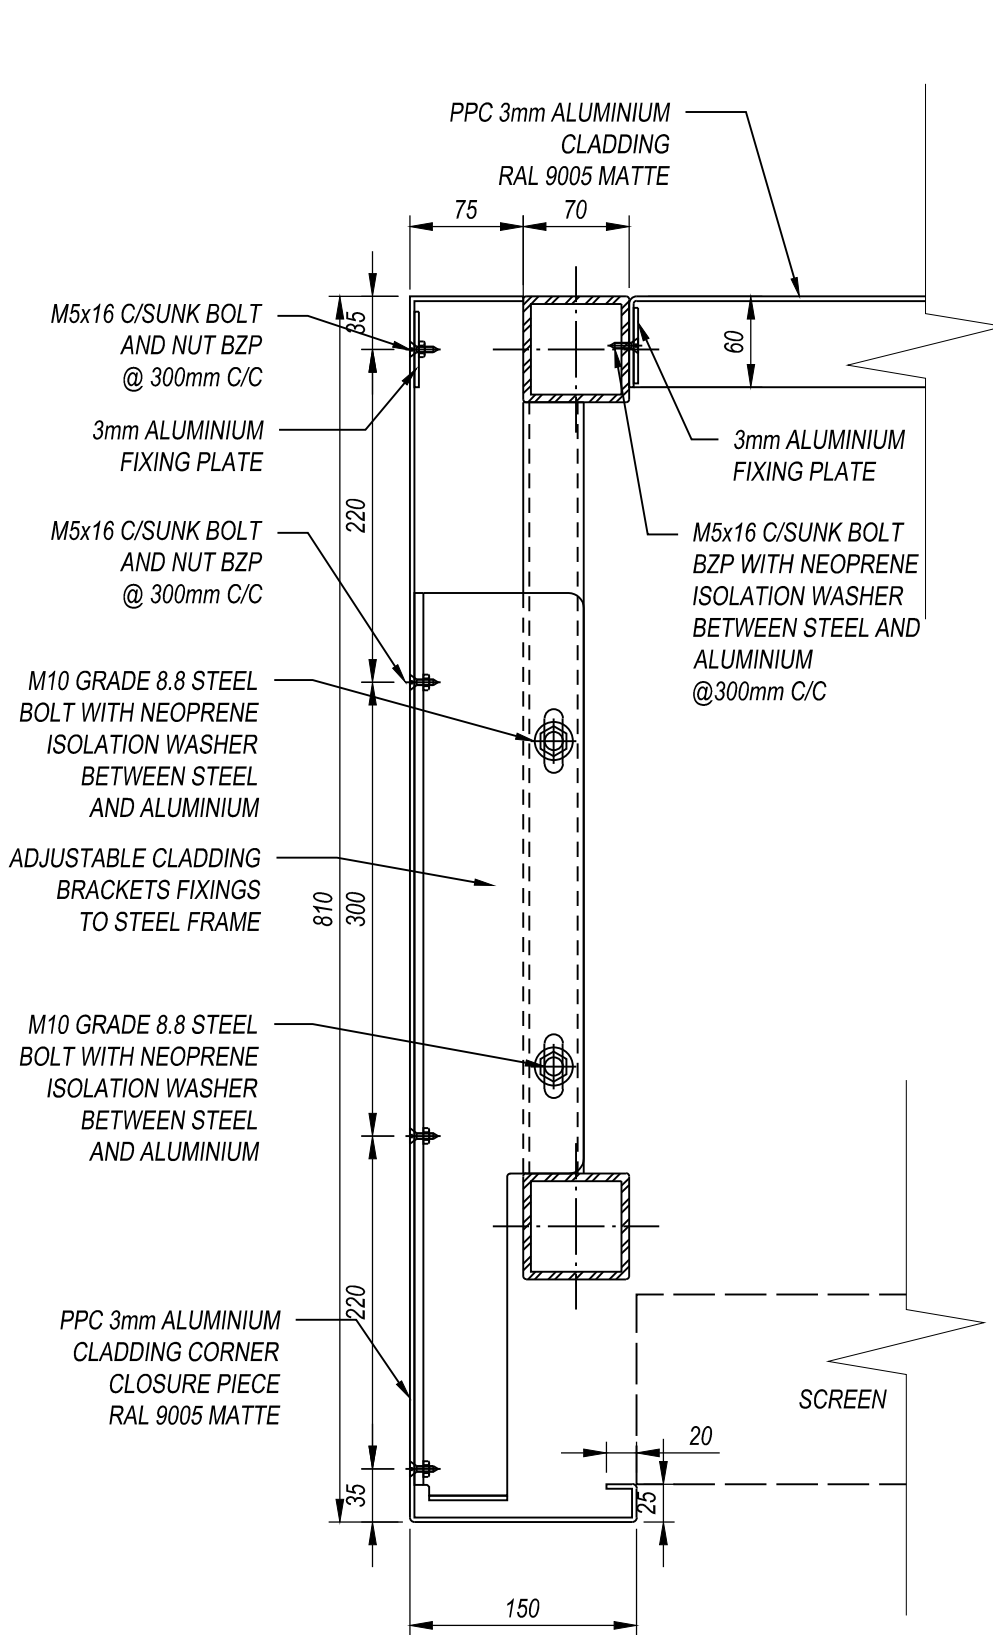


DETAIL 1
SCALE 1:5

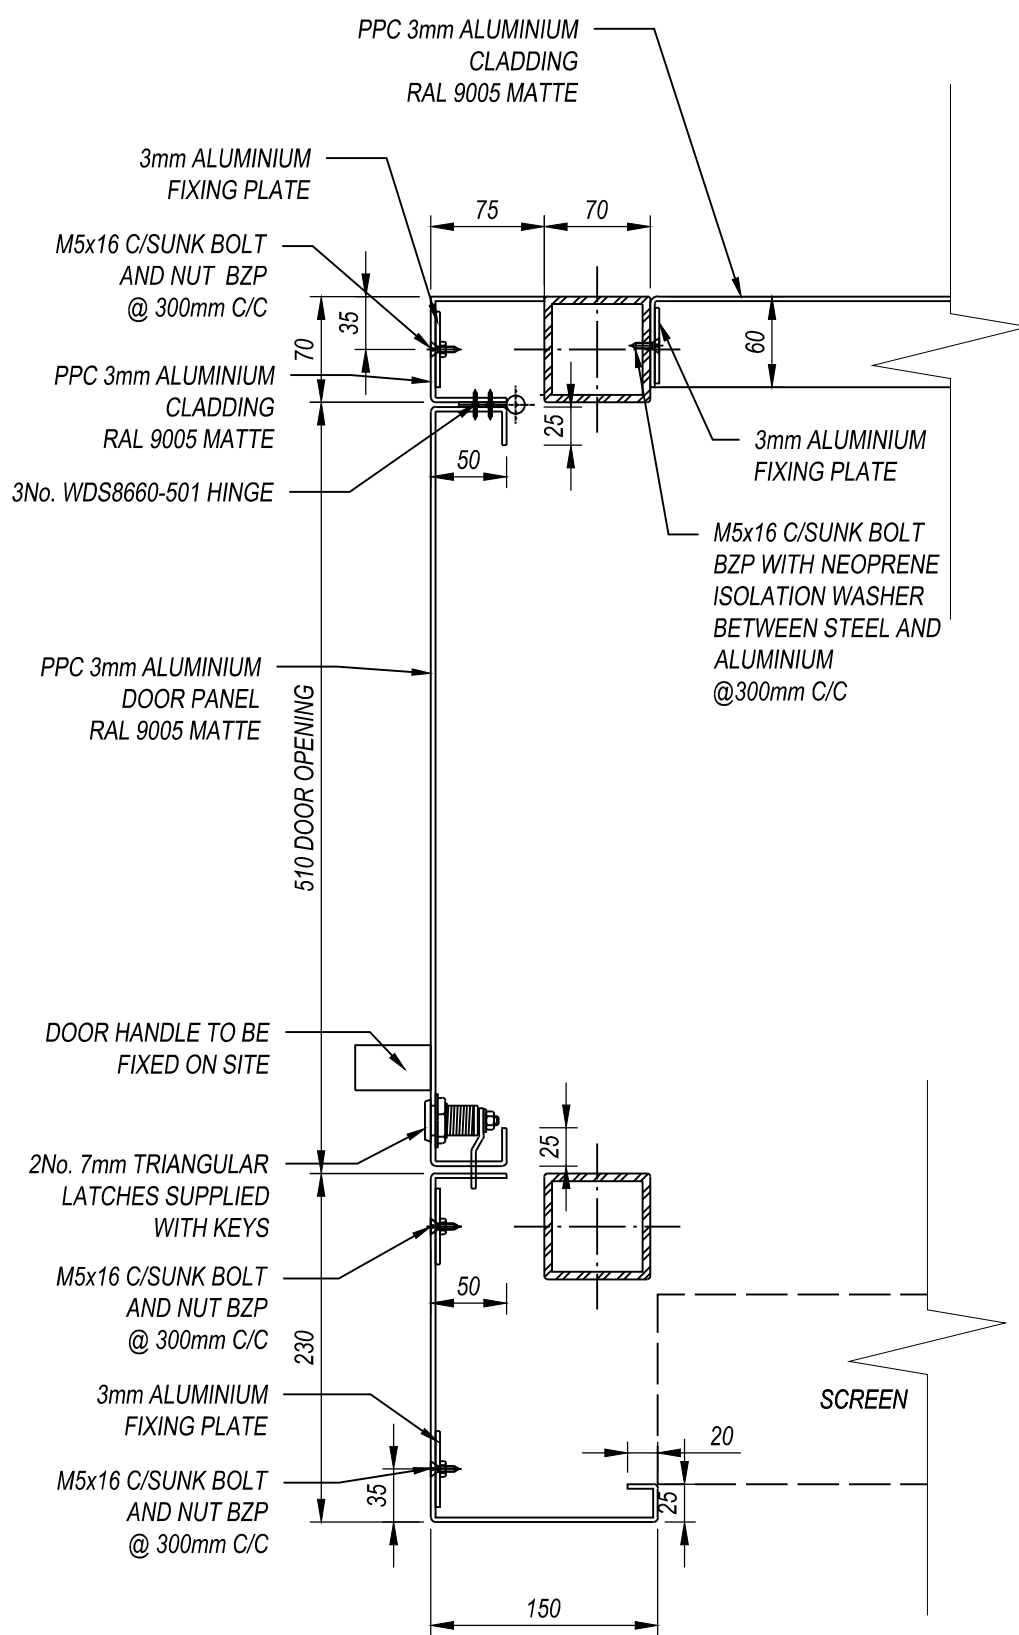


DETAIL 2
SCALE 1:5

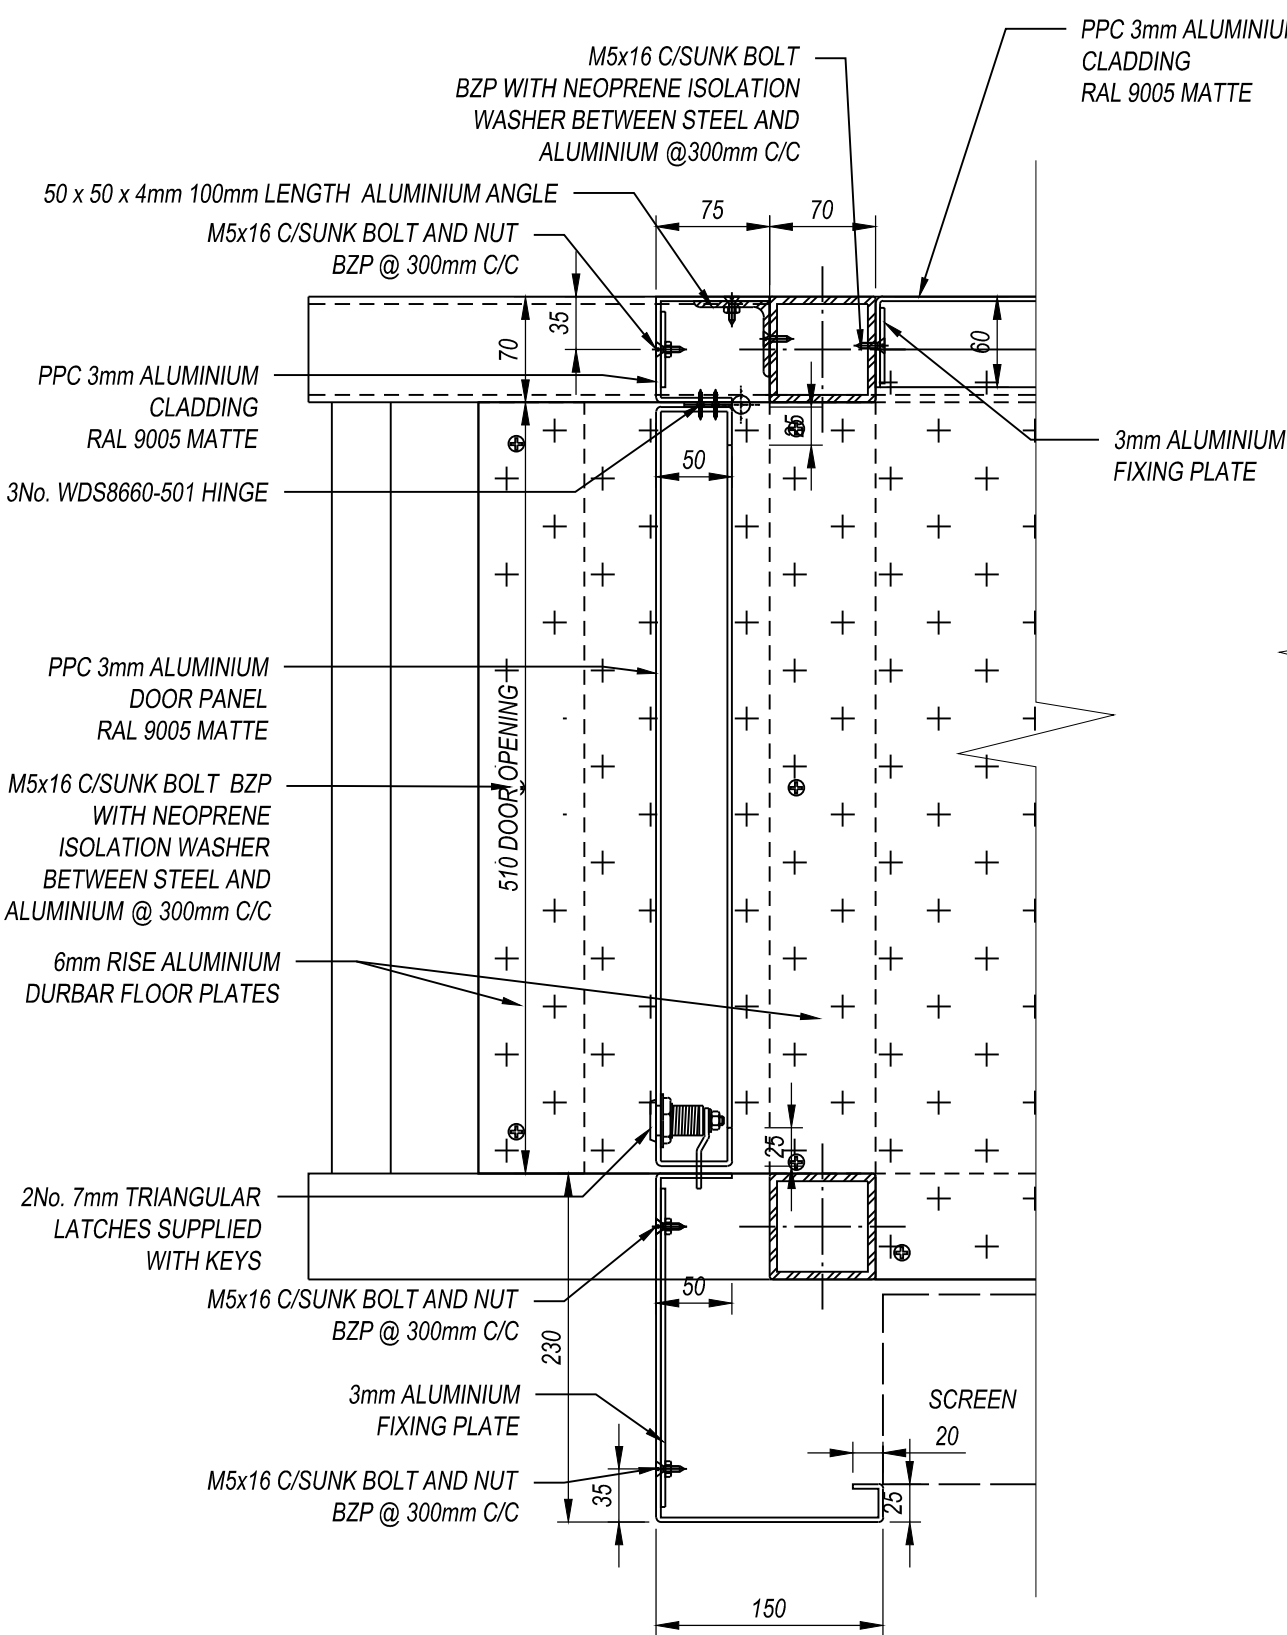


DETAIL 3
SCALE 1:5

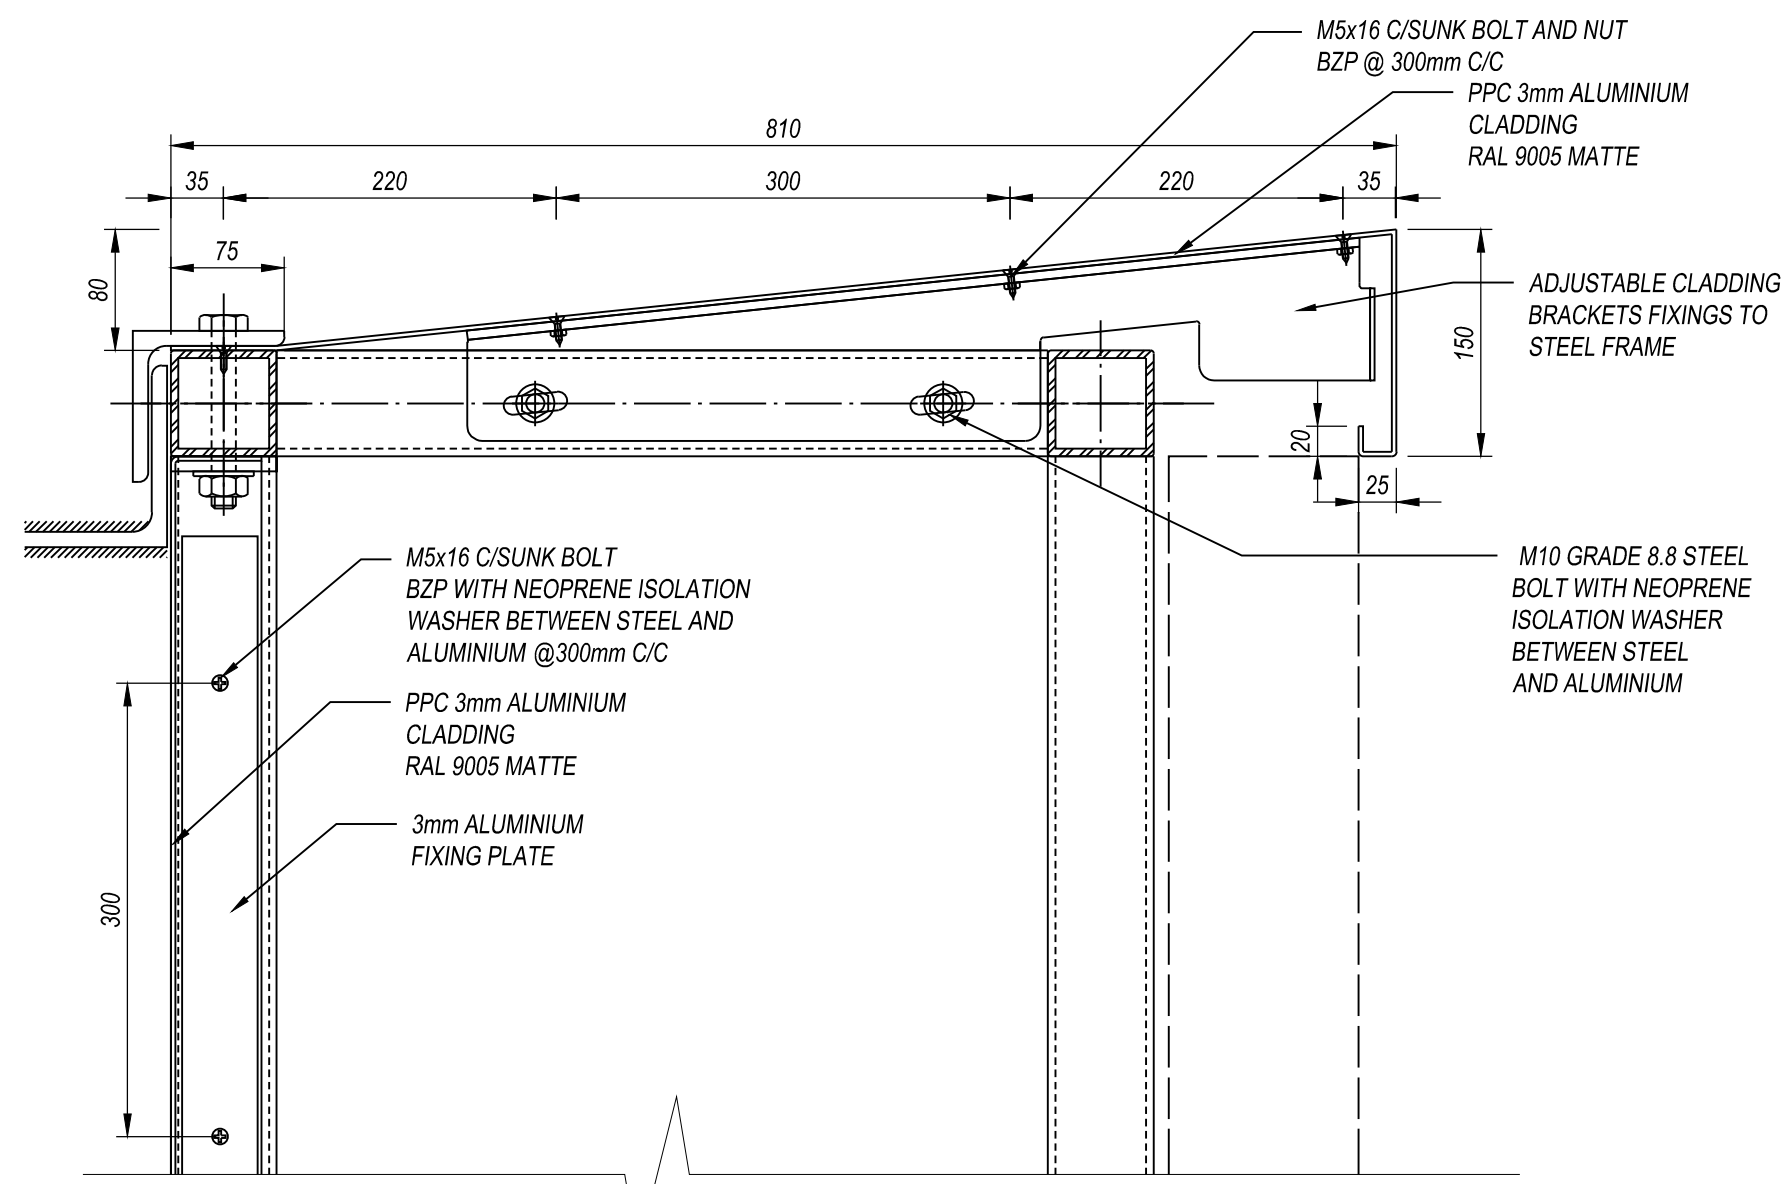

DETAIL 4
SCALE 1:5

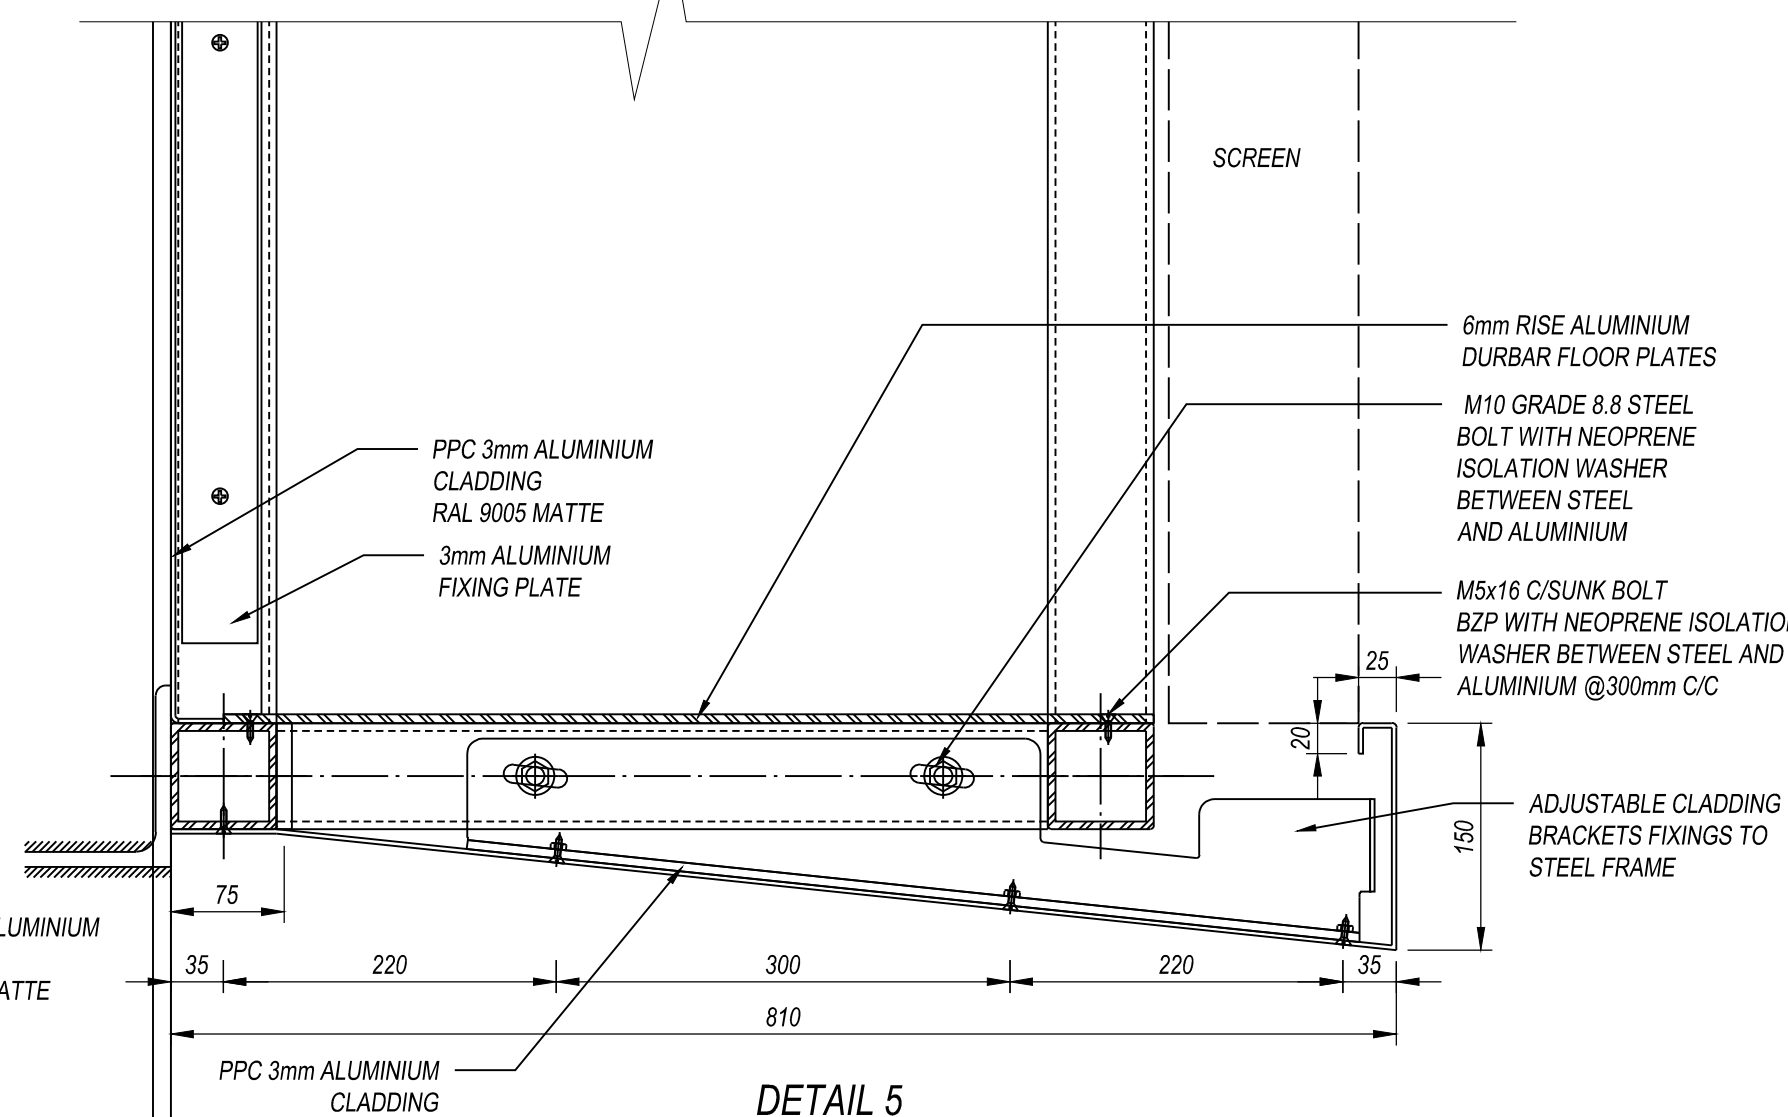

DETAIL 5
SCALE 1:5

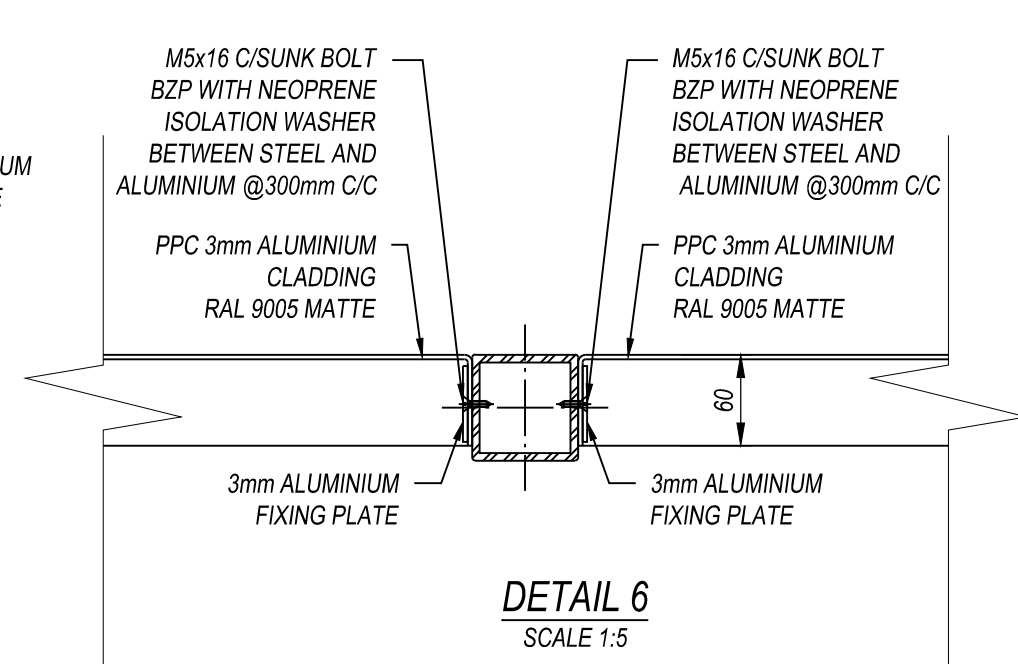

DETAIL 6
SCALE 1:5

COLOUR CODE:	
BLACK -	EXISTING OR UNCHANGED
BLUE -	MODIFIED OR TO BE MOVED
RED -	NEW, PROPOSED ALUMINIUM CLADDING ELEMENTS
GREEN -	REDUNDANT OR TO BE REMOVED
ORANGE -	THIRD PARTY / BY OTHERS
GREY -	OS/SURVEY DATA
PINK -	PROPOSED STEEL FRAME

Z01	08/10/25	MJ	AS BUILT
C01	27/09/24	YN	APPROVED FOR CONSTRUCTION
P01	09/08/24	WF	FIRST ISSUE
REV	DATE	BY	DESCRIPTION



CLIENT	BYER & BUTLER
--------	---------------

PROJECT TITLE	WALES & WESTERN DIGITAL ADVERTISING BOARDS
---------------	--

DRAWING TITLE	Y2130401199901 DIGITAL BOARD CLADDING SECTIONS AND DETAILS
---------------	--

DRAWING STATUS		AS BUILT	
DRAWING No.		3174-VED-XX-XX-DWG-ST-005006	REV Z01
DATE		SCALE @ A1 AS SHOWN	
SEPT 2024			
DRAWN	CHECKED	VEDA JOB No.	
WF	YN	3714	