THIS DRAWING IS COPYRIGHT
Contractor must take site sizes

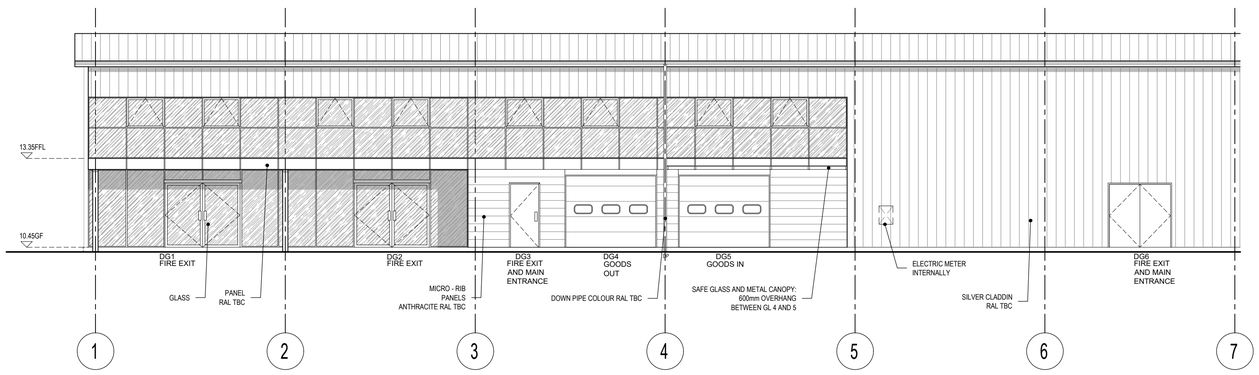


**PROPOSED**
SOUTH ELEVATION
SCALE 1:100

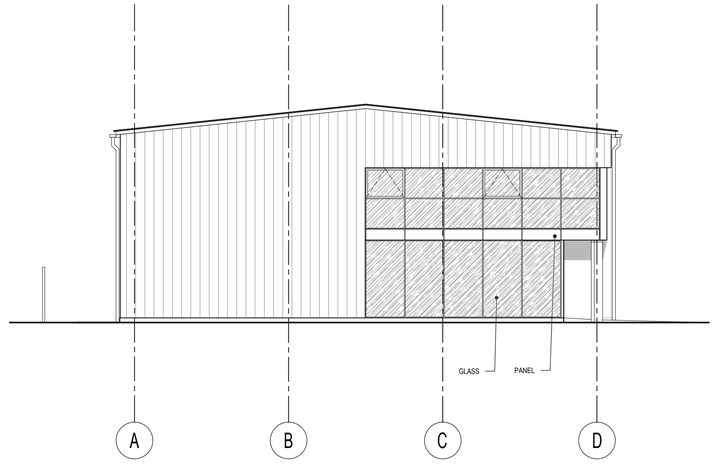


**PROPOSED**
WEST ELEVATION
SCALE 1:100

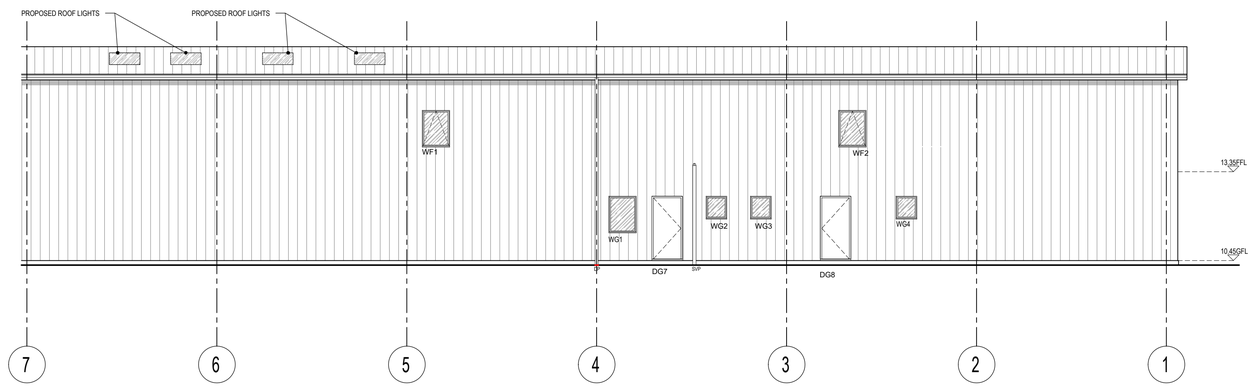


**PROPOSED**
NORTH ELEVATION
SCALE 1:100

0 1m 2m 3m 4m 5m 6m
Scale bar (1:100)

STRUCTURAL ALUMINIUM GLAZED SCREENS WITH DOORS,WINDOWS AND FIXED INFILL PANELS :

OVERALL U VALUE OF 1.3 W/m2K OR BETTER.

GLASS TO SOUTH AND WEST ELEVATION TO PREVENT OVERHEATING TO BE TINTED WITH ANTI-SUN COATING.

RAL COLOURS TO BE CONFIRMED BY CLIENT:

SILVER WALL CLADDING: RAL TBA
MICRO-RIB PANNELS: ANTHRACITE RAL TBA
WINDOWS: ANTHRACITE RAL TBA
DOORS AND DOOR FLASHINGS: ANTHRACITE RAL TBA
CURTAIN WALL: ANTHRACITE RAL TBA
FASCIA AND BARGE BOARD: TO MATCH EXISTING RAL TBA
RAINWATER GOODS: RAL TBA

ALL FINISHES TO BE MATT.

**For construction notes refer to drawing 4010-01 and 4010-02**

| Rev. | Date | | Init |
|---|---|---|---|
| E | 26.07.23 | AS BUILT ISSUE | EK |
| D | 19.01.23 | REVISED TO COMMENTS AFTER MEETING WITH CONTEMPO,CURTIS AND SALISBURY GLASS AT GAIGER'S OFFICE. FLOOR SLAB REVISED TO S.ENGINEER SPECIFICATION. | EK |
| C | 13.01.23 | REVISED TO GAIGER'S COMMENTS. | EK |
| B | 09.01.23 | PRELIMINARY BUILDING REGULATION NOTES PROVIDED | EK |
| A | 15.12.22 | REVISED TO CLIENT'S COMMENTS | EK |

CLIENT
CONTEMPO LTD

PROJECT
REINSTATEMENT OF FIRE DAMAGED BUILDING, CRUSADER PARK
ROMAN WAY WARMINSTER

DRAWING
ELEVATIONS

| DRAWN: | Date: | Scale: |
|---|---|---|
| EK | 08/12/2022 | 1:100 @ A1 |
| Drawing number: 4010-04 | | Rev. E |

**DOLMAN**
ARCHITECTURAL DESIGNERS BUILDING SURVEYORS
COST CONSULTANTS CDM PRINCIPAL DESIGNERS
Sussex House
Bath Road
Devizes
Wiltshire SN10 2AF
Tel: 01380 729456
Web: www.dolmansurveyors.co.uk
Email: info@dolmansurveyors.co.uk